



O.D.O.T. DISTRICT 2 SURVEY OFFICE (USE ONLY)

PERSONNEL	REFERENCE NO. <u>47</u>	SHEET <u>44</u> OF <u>45</u>
NOTES <u>HUSS</u>	DATE <u>06-19-97</u>	ROUTE <u>SR 199</u>
H.C. <u>CORDES</u>	WEATHER <u>CLOUDY</u>	COUNTY <u>WOOD</u>
R.C. <u>VAN DUSEN</u>	TEMP. <u>70° F</u>	TOWNSHIP <u>FREEDOM</u>
		SECTION <u>29</u>
		T <u>5</u> N R <u>12</u> E

TYPE MONUMENT PK/WASHER
 ON SURFACE - ~~BELOW~~ ON
 LEFT - CL PAV'T - ~~RIGHT~~ 0.4'
11.7' TO LT EDGE PAVEMENT
 S.L.M. 782+49 ±
 Grid: Northing: 616712.854 Easting: 1694505.520

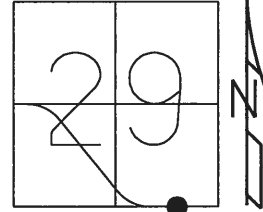

SET 5/8" IRON RODS

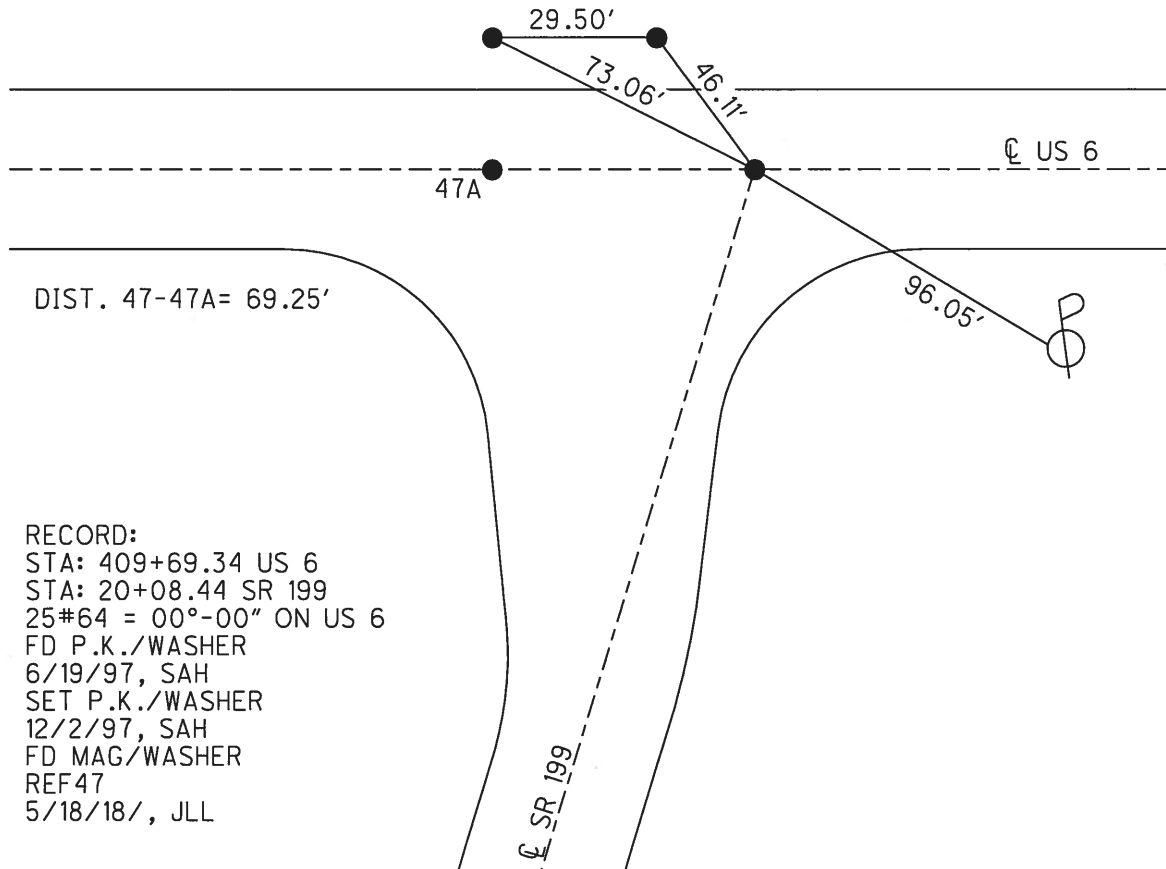

RECORD:
 STA: 409+69.34 US 6
 STA: 20+08.44 SR 199
 25#64 = 00°-00" ON US 6
 FD P.K./WASHER
 6/19/97, SAH
 SET P.K./WASHER
 12/2/97, SAH
 FD MAG/WASHER
 REF47
 5/18/18/, JLL

O.D.O.T. DISTRICT 2 SURVEY OFFICE (USE ONLY)

PERSONNEL _____

REFERENCE NO. 47

SHEET 44 OF 45

NOTES HUSS

DATE 06-19-97

ROUTE SR 199 / US 6

H.C. CORDES

WEATHER CLOUDY

COUNTY WOOD

R.C. VAN DUSEN

TEMP. 70° F

TOWNSHIP FREEDOM

SECTION 29

T 5 N R 12 E

TYPE MONUMENT PK/WASHER


ON SURFACE - ~~BELOW~~ ON

LEFT - Q PAV'T - ~~RIGHT~~ 0.4'

11.7' TO LT. EDGE PAVEMENT


S.L.M. 782+49 ±

Grid: Northing: - Easting: -

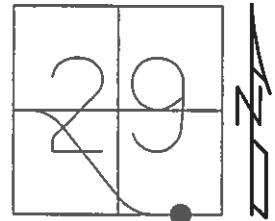

RECORD

12-02-97 SAH
SET PK/WASHER

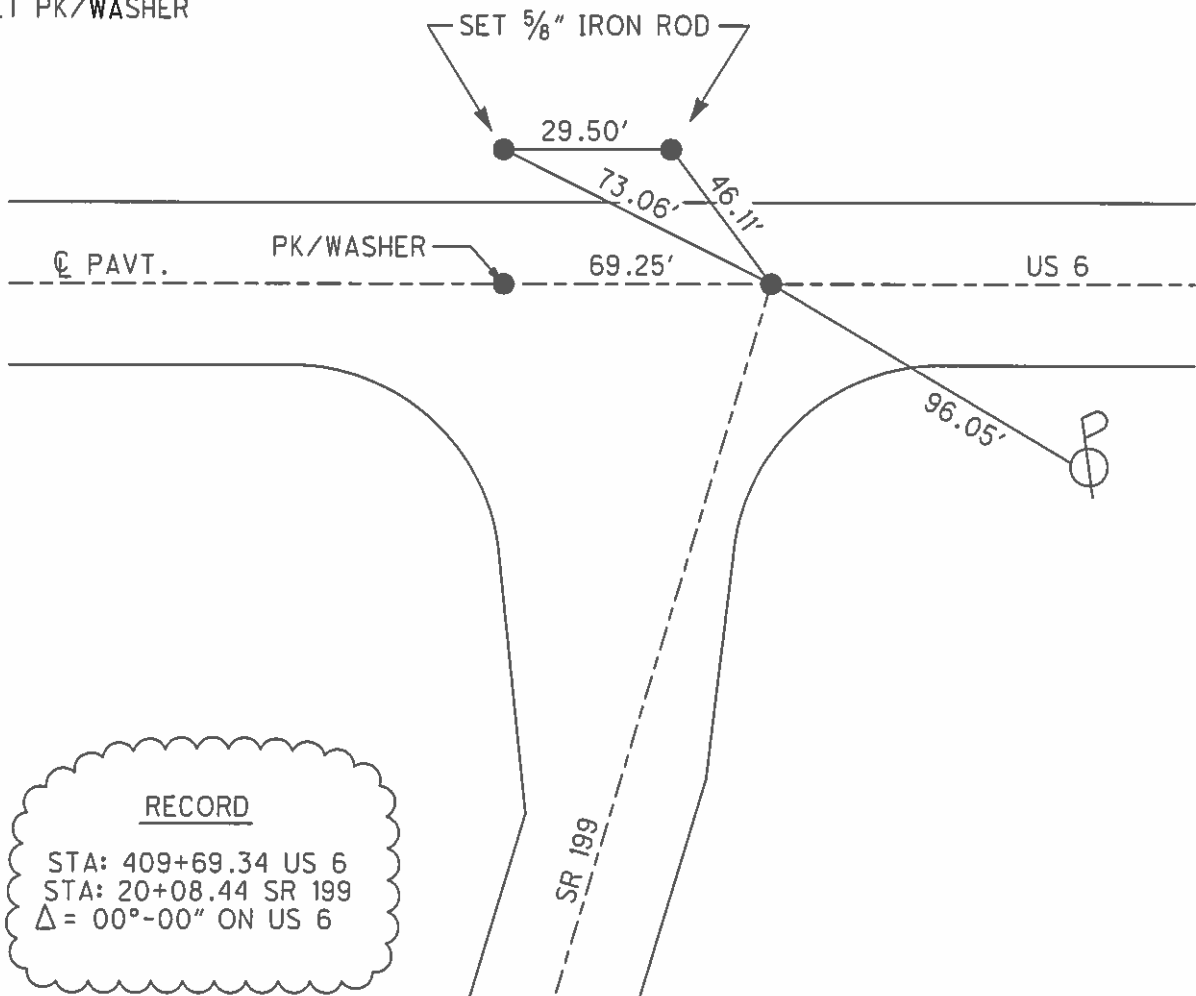

RECORD
STA: 409+69.34 US 6
STA: 20+08.44 SR 199
 $\Delta = 00^{\circ}-00''$ ON US 6