

O.D.O.T. DISTRICT 2 SURVEY OFFICE (USE ONLY)

PERSONNEL

REFERENCE NO. 47 A

SHEET 45 OF 45

NOTES HUSS

DATE 06-19-97

ROUTE SR 199 / US 6

H.C. CORDES

WEATHER CLOUDY

COUNTY WOOD

R.C. VAN DUSEN

TEMP. 70° F

TOWNSHIP FREEDOM

SECTION 29

T 5 N R 12 E

TYPE MONUMENT PK/WASHER


ON SURFACE - ~~BELOW~~ ON

~~LEFT~~ - Q PAV'T - ~~RIGHT~~ ON

12.0' TO LT. EDGE PAVEMENT


S.L.M. 782+49 ±

Grid: Northing: - Easting: -

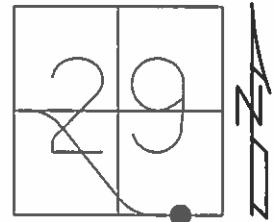

RECORD

12-02-97 SAH  
SET PK/WASHER

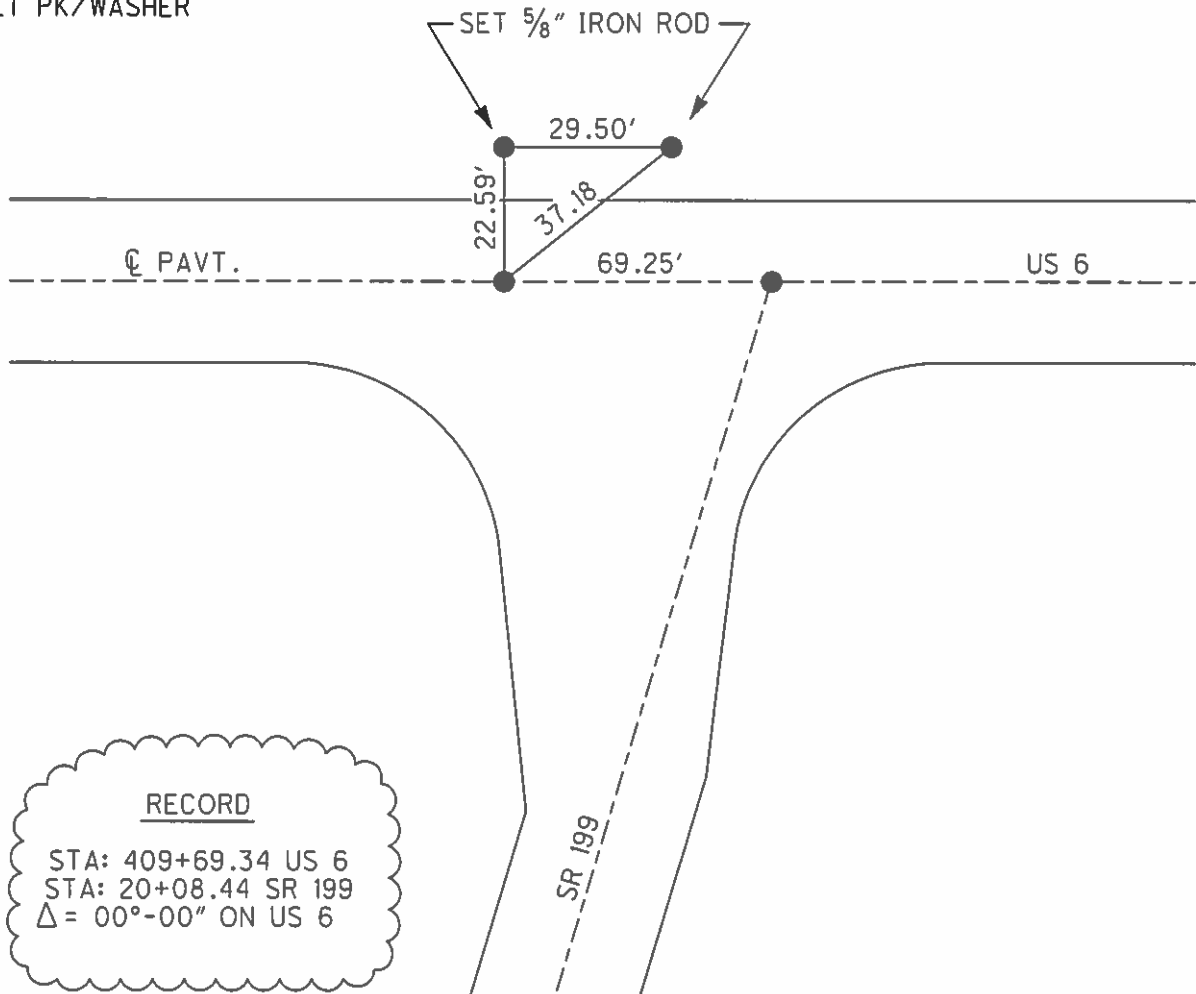

RECORD  
 STA: 409+69.34 US 6  
 STA: 20+08.44 SR 199  
 Δ = 00°-00" ON US 6