


O.D.O.T. DISTRICT 2 SURVEY OFFICE (USE ONLY)


PERSONNEL _____ REFERENCE NO. 50 SHEET 2 OF 78
 NOTES HUSS DATE 6/23/11 ROUTE SR 199
 H.C. HUSS WEATHER CLOUDY/RAIN COUNTY WOOD
 R.C. CANTERBURY TEMP. 70° TOWNSHIP FREEDOM
 DWG BY RHOADES PID R/W, NO PID SECTION 20
 T 5 N R 12 E

TYPE MONUMENT 1" IPIN
~~ON SURFACE~~ - BELOW 0.3'
 OFFSET \odot PAVEMENT 83.2' \pm : RT
 _____ TO _____ EDGE PAVEMENT
 STATION: 870+68.27

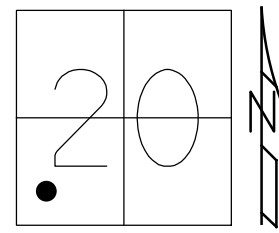

HORZ. DATUM: NAD83 2011 GEOID: NAVD88 2018
 GRID: NORTHING: 622872.917 EASTING: 1691048.277


RECORD: P.I.
 STA. 36+64.58
 $\Delta = 37^\circ 00''$
 1951
 FD 1" IPIN
 BENT SOUTHERNLY
 2/1/10, SAH
 FD 3/4" PIPE
 BENT SOUTHERNLY
 REF 50
 5/10/23, TDN

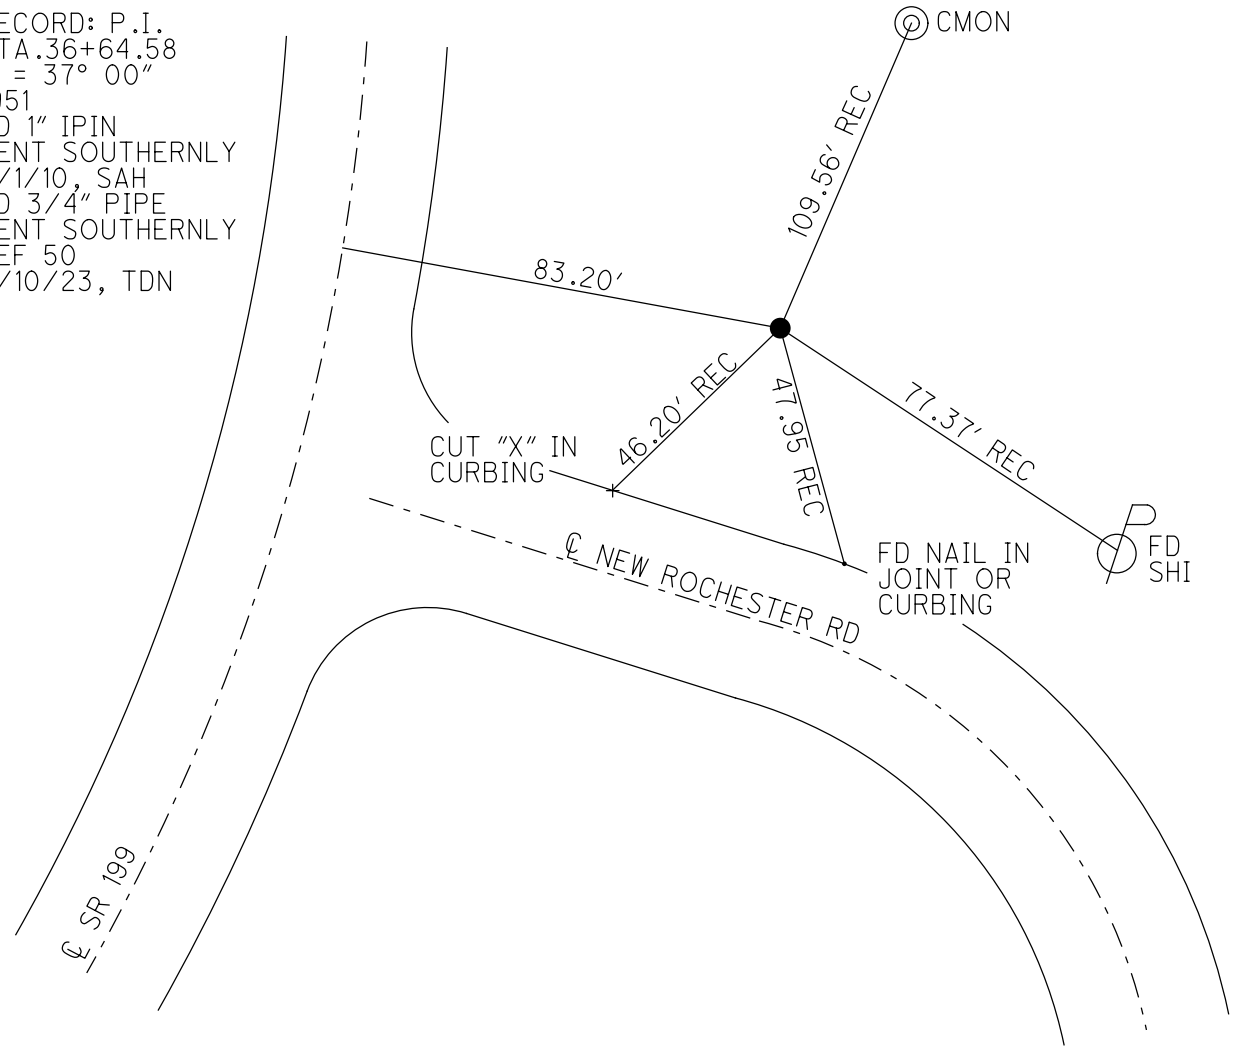


O.D.O.T. DISTRICT 2 SURVEY OFFICE (USE ONLY)

PERSONNEL _____ REFERENCE NO. 50 SHEET 2 OF 72
 NOTES HUSS DATE 6/23/11 ROUTE SR 199
 H.C. HUSS WEATHER CLOUDY/RAIN COUNTY WOOD
 R.C. CANTERBURY TEMP. 70° TOWNSHIP FREEDOM
 _____ SECTION 29
 _____ T 5 N R 12 E

TYPE MONUMENT _____ 1" IPIN
~~ON SURFACE~~ - BELOW _____ 0.3'
~~LEFT - C PAV'T~~ - RIGHT _____ 83.2'
 _____ TO _____ EDGE PAVEMENT
 S.L.M. _____ 870+68.27
 GRID: NORTHING: _____ - EASTING: _____ -

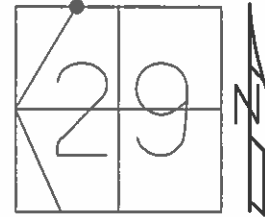

NOTE: PIPE IS BENT SOME TO THE SOUTH
 FD 1" IPIN
 2/1/10, SAH

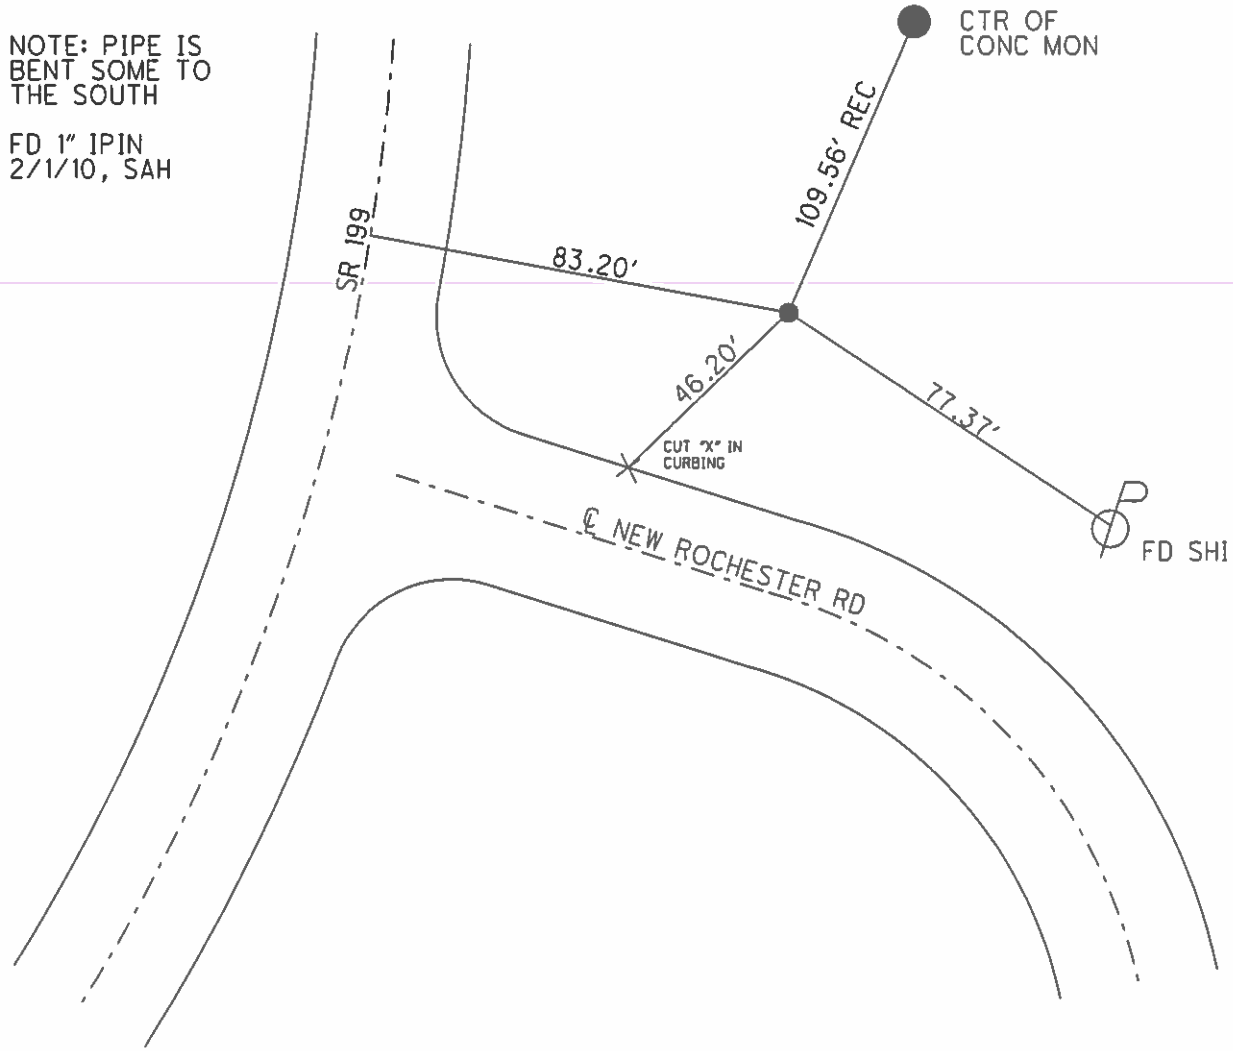

O.D.O.T. DISTRICT 2 SURVEY OFFICE

PERSONNEL

REFERENCE NO. 50

SHEET OF

NOTES BARNHISEL

H.C. SOCKMAN

R.C. HOFFMAN

DATE 7-13-87

WEATHER cloudy

TEMP. +85°

ROUTE 199

COUNTY WOOD

TOWNSHIP Freedom

SECTION 29

T 5 R 12 E


TYPE MONUMENT 1" IRON ROD

ON SURFACE - BELOW 2"


LEFT - & PAV'T. - RIGHT 83.2

— TO — EDGE PAVEMENT OF New Rochester Rd

S.L.M. 874+38

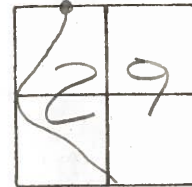

Note:
Pipe is bent
Some to the south

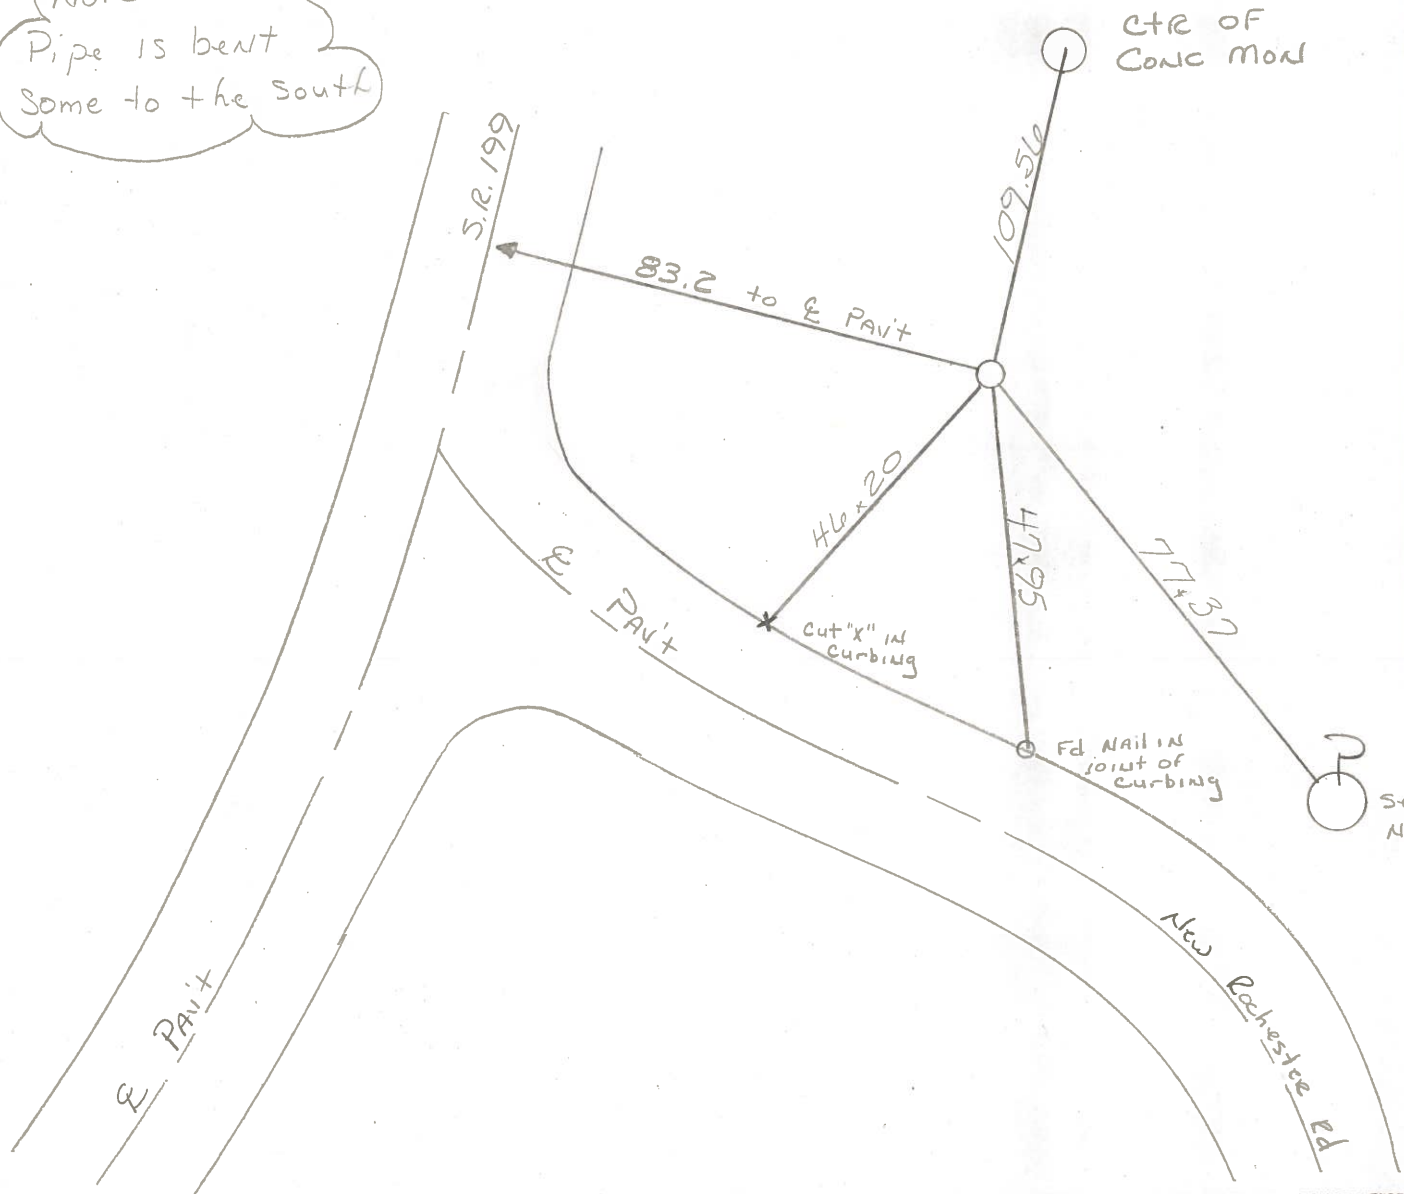

O.D.O.T. DISTRICT 2 SURVEY OFFICE

SHEET _____ OF _____

County WOOD S.R. 199

Township FREEDOM

Section 29

T N, R E

Personnel TOMSIK

NEUSER

VANYO

GRANATA

Date 12-1-71 (CHKD 8-21-73)


Weather _____

Temp. _____

20	21
29	28



50

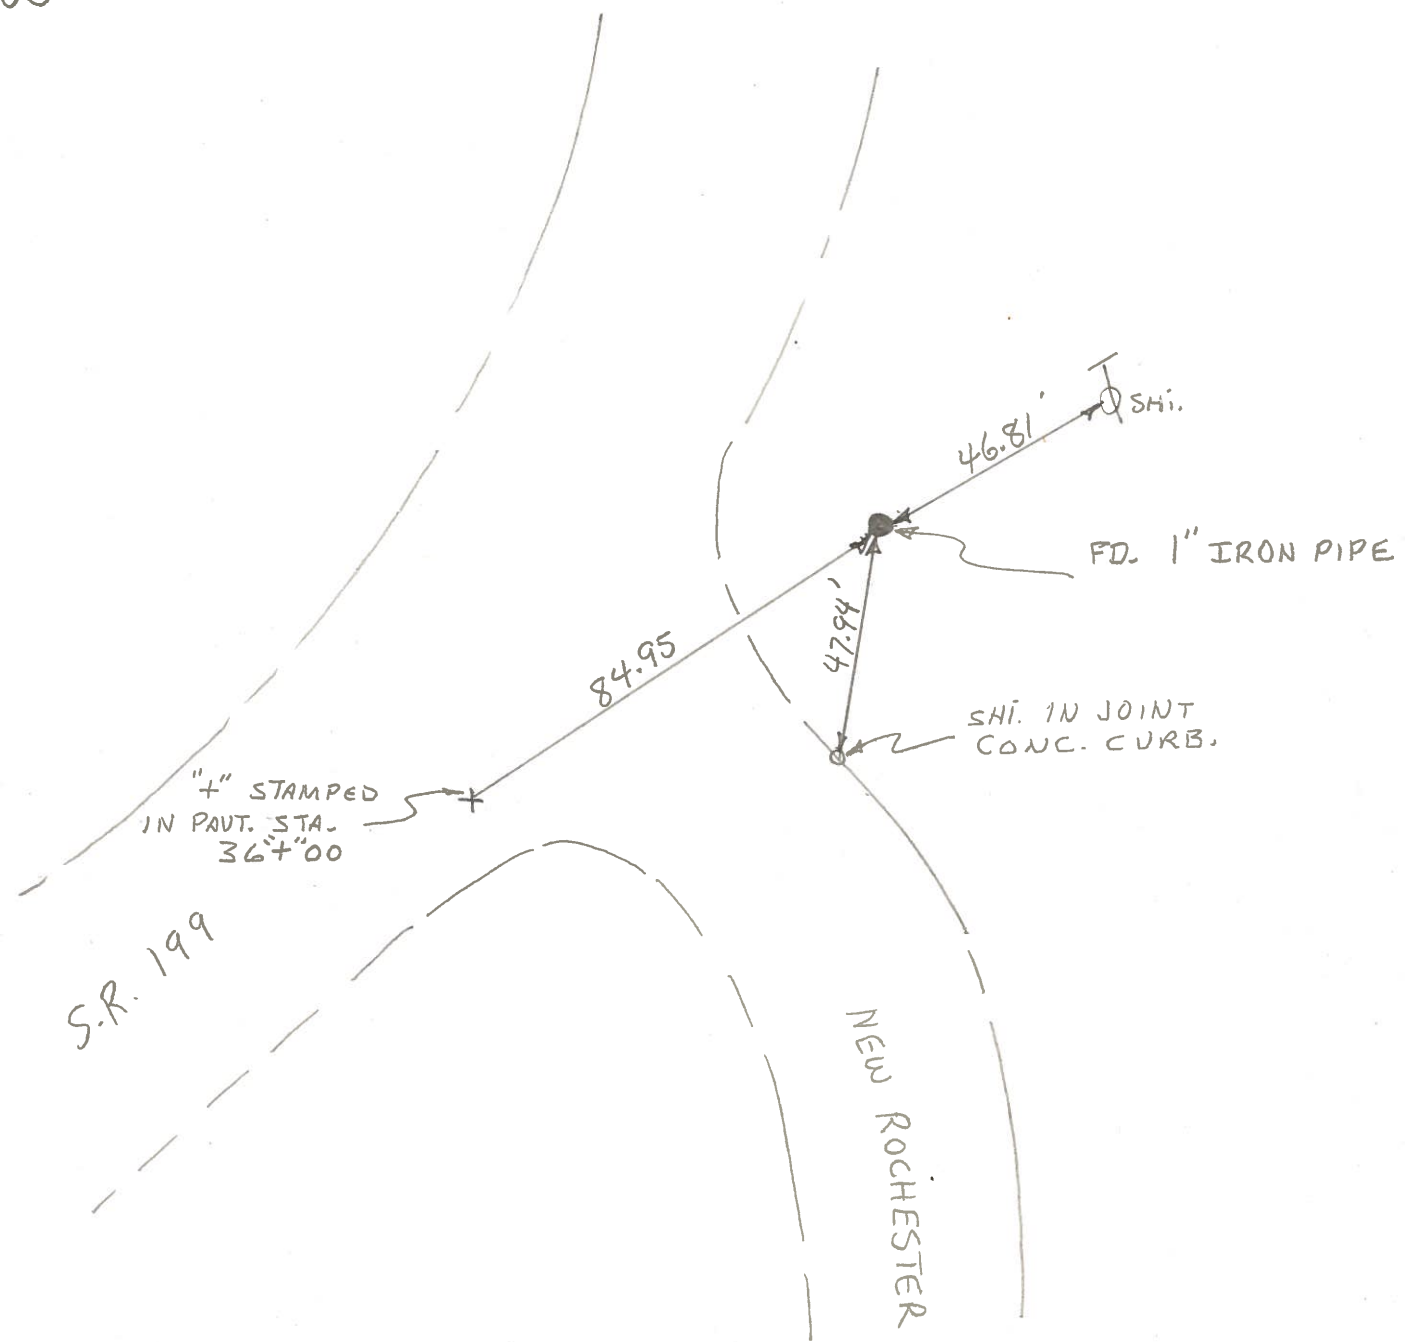

PERSONNEL	TITLE	PERSONNEL	TITLE	COUNTY	DATE
TOMSIK				WOOD	12-1-71
NEUSER				S. R. 199	CHECKED 8-21-73
VANYO					WEATHER
GRANATA				SEC.	TEMP.

DESCRIPTION	LEFT	CENTER LINE	RIGHT	JOB NO.
-------------	------	-------------	-------	---------

