

O.D.O.T. DISTRICT 2 SURVEY OFFICE (USE ONLY)

PERSONNEL _____ REFERENCE NO. 50 B SHEET 4 OF 78
 NOTES HUSS DATE 6/23/11 ROUTE SR 199
 H.C. HUSS WEATHER CLOUDY/RAIN COUNTY WOOD
 R.C. CANTERBURY TEMP. 70° TOWNSHIP FREEDOM
 DWG BY NIESE PID 107613 SECTION 20
 T 5 N R 12 E

TYPE MONUMENT SM.R.R.SPIKE

ON SURFACE - ~~BELOW~~ ON

OFFSET 0.6' RT : ~~LT~~

10.2' TO RT EDGE PAVEMENT



STATION: 880+56.14

HORZ.DATUM: NAD83(2011)

GEOID: NAVD88 2012A

GRID: NORTHING: 623846.266

EASTING: 1690798.916

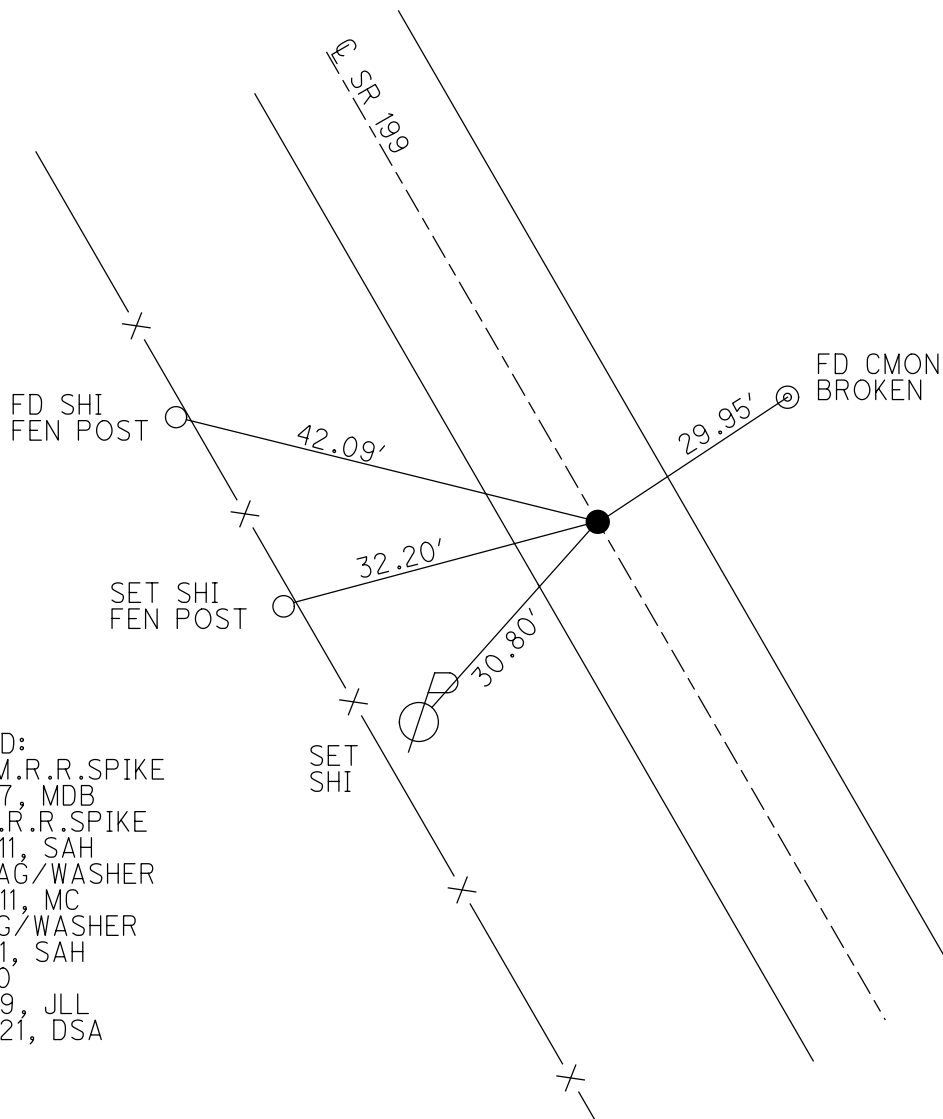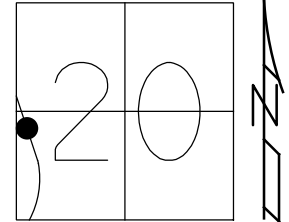


RECORD:
 SET SM.R.R.SPIKE
 9/4/87, MDB
 FD SM.R.R.SPIKE
 6/23/11, SAH
 SET MAG/WASHER
 11/23/11, MC
 FD MAG/WASHER
 12/7/11, SAH
 REFB50
 8/13/19, JLL
 11/23/21, DSA

O.D.O.T. DISTRICT 2 SURVEY OFFICE (USE ONLY)


PERSONNEL _____ REFERENCE NO. 50 B SHEET 4 OF 72

NOTES HUSS DATE 6/23/11 ROUTE SR 199
 H.C. HUSS WEATHER CLOUDY/RAIN COUNTY WOOD
 R.C. CANTERBURY TEMP. 70° TOWNSHIP FREEDOM
 _____ SECTION 20
 _____ T 5 N R 12 E

TYPE MONUMENT SM SPIKE
 ON SURFACE - ~~BELOW~~ ON
~~LEFT - C PAV'T~~ - RIGHT 0.6'
10.2' TO RT EDGE PAVEMENT
 S.L.M. 880+56.14

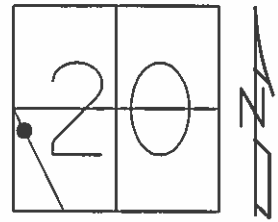

GRID: NORTHING: 623846.295 EASTING: 1690798.871

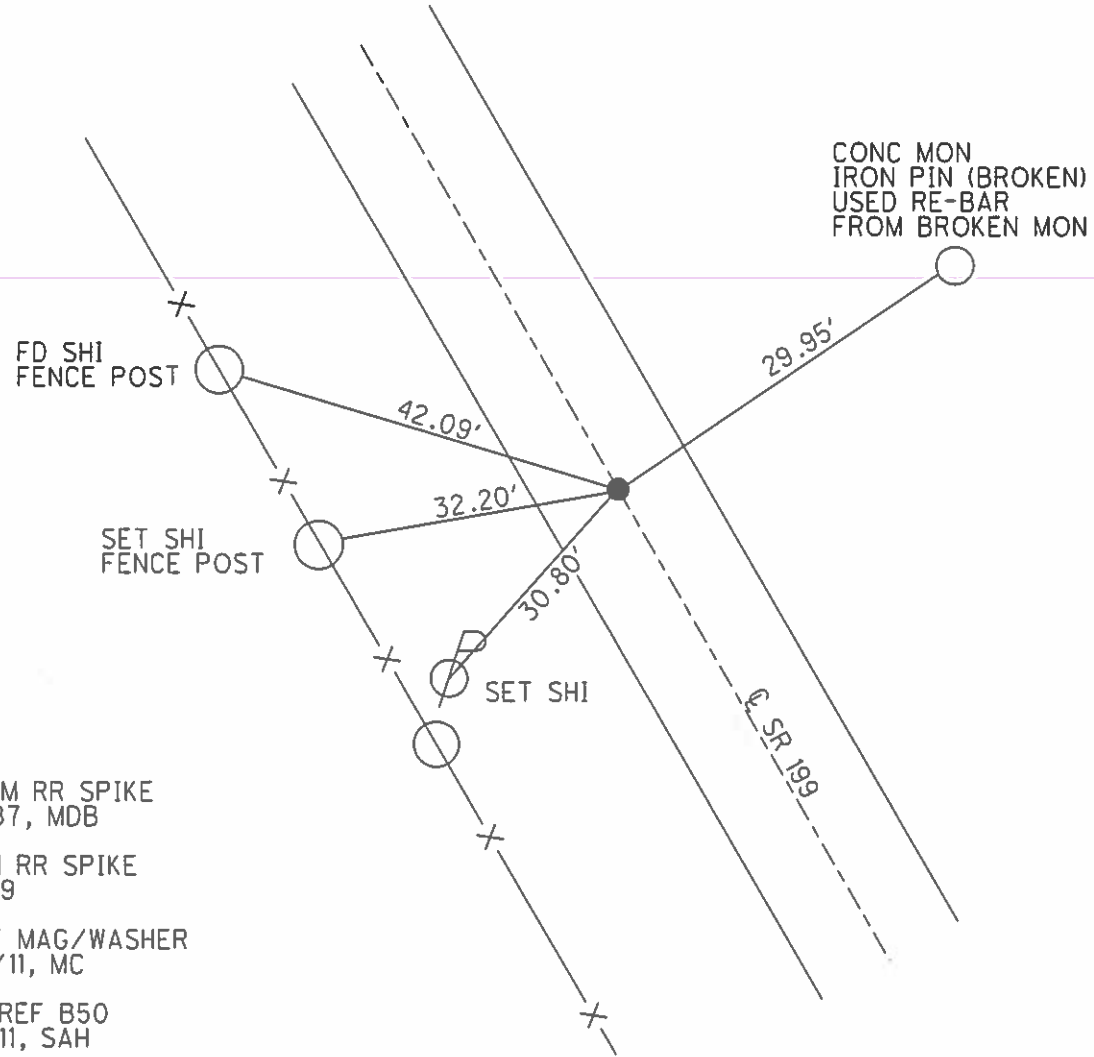

SET SM RR SPIKE
 9/4/87, MDB
 FD SM RR SPIKE
 2/1/09
 RESET MAG/WASHER
 11/23/11, MC
 GPS, REF B50
 12/7/11, SAH

O.D.O.T. DISTRICT 2 SURVEY OFFICE

PERSONNEL

REFERENCE NO. 50-B

SHEET OF

NOTES BARNHISEL

H.C. SOCKMAN

R.C. HOFFMAN

DATE 7-13-87

WEATHER CLOUDY

TEMP. +85°

ROUTE 199

COUNTY WOOD

TOWNSHIP FREEDOM

SECTION 20

T5 N R 12 E



TYPE MONUMENT P.K. SHANK

ON SURFACE - BELOW 2"

LEFT - 0 PAV'T. - RIGHT .6

10.5 TO RT EDGE PAVEMENT

S.L.M. 884 + 26

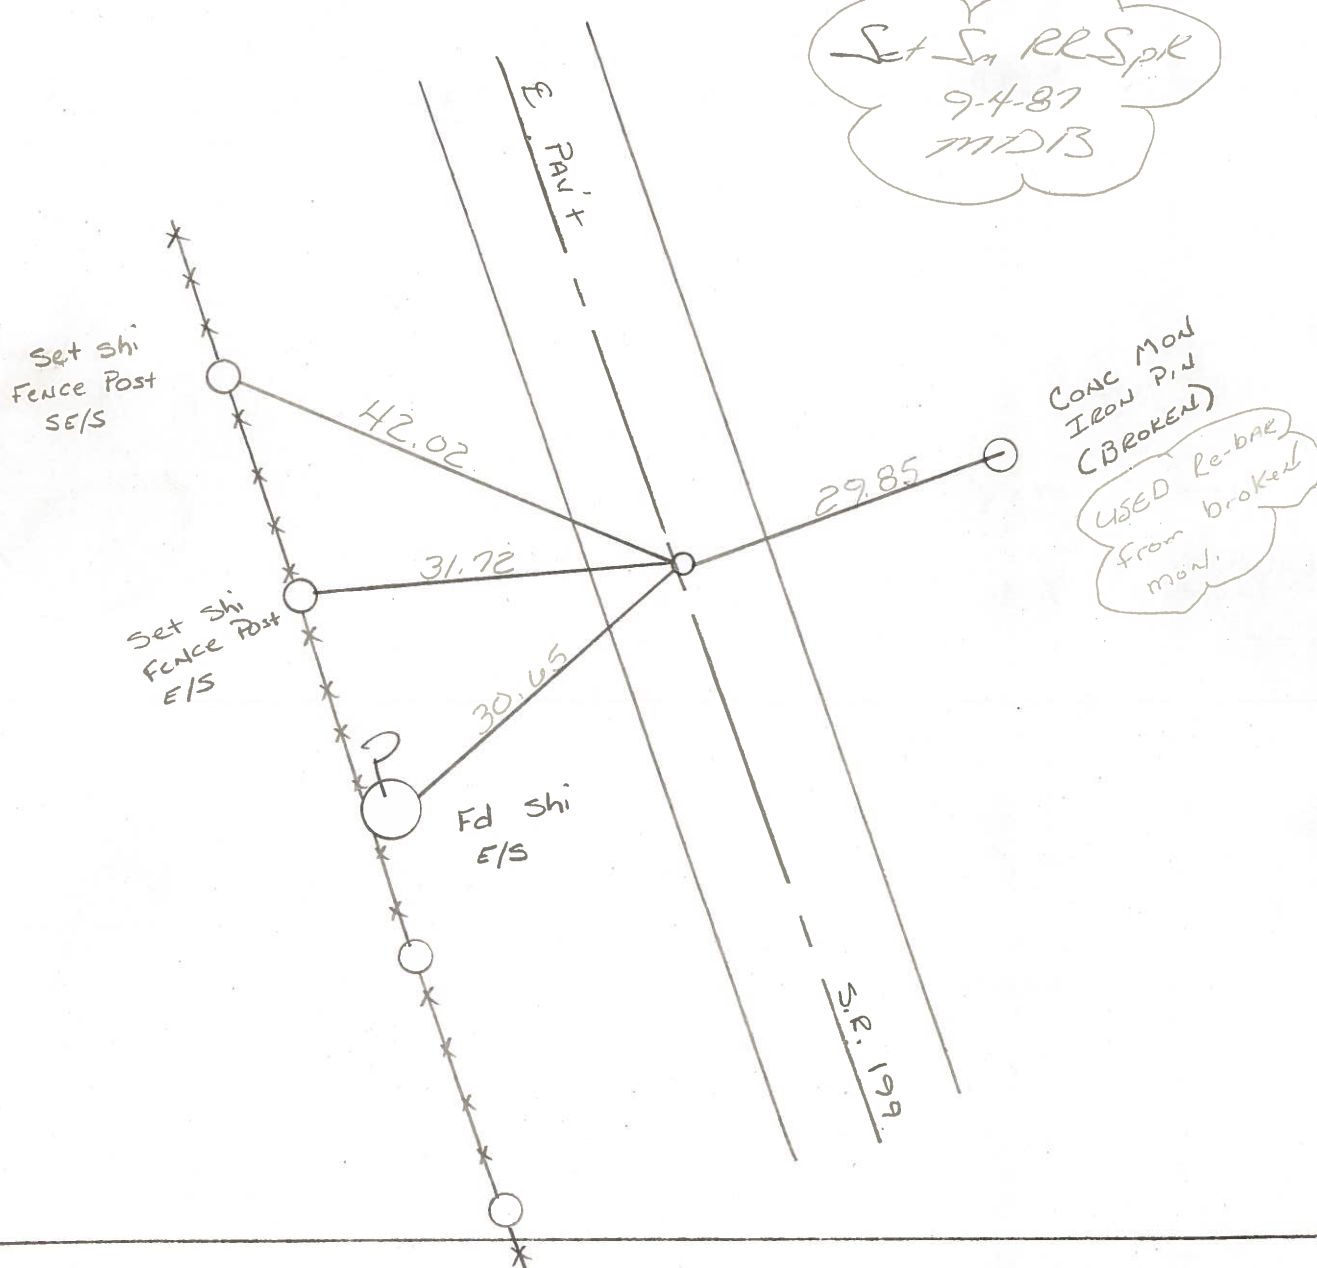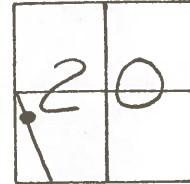

County WOOD S.R. 199

Township FREEDOM

Section 20

T N, R E

Personnel TOM SIK

NEUSER

VANYO

GRANATA

Date 1-26-72


Weather _____

Temp. 10°



#50-B

POINT IS LOCATED APPROX. 1050' N. OF INTER. OF S.R.#199 & NEW ROCHESTER RD.

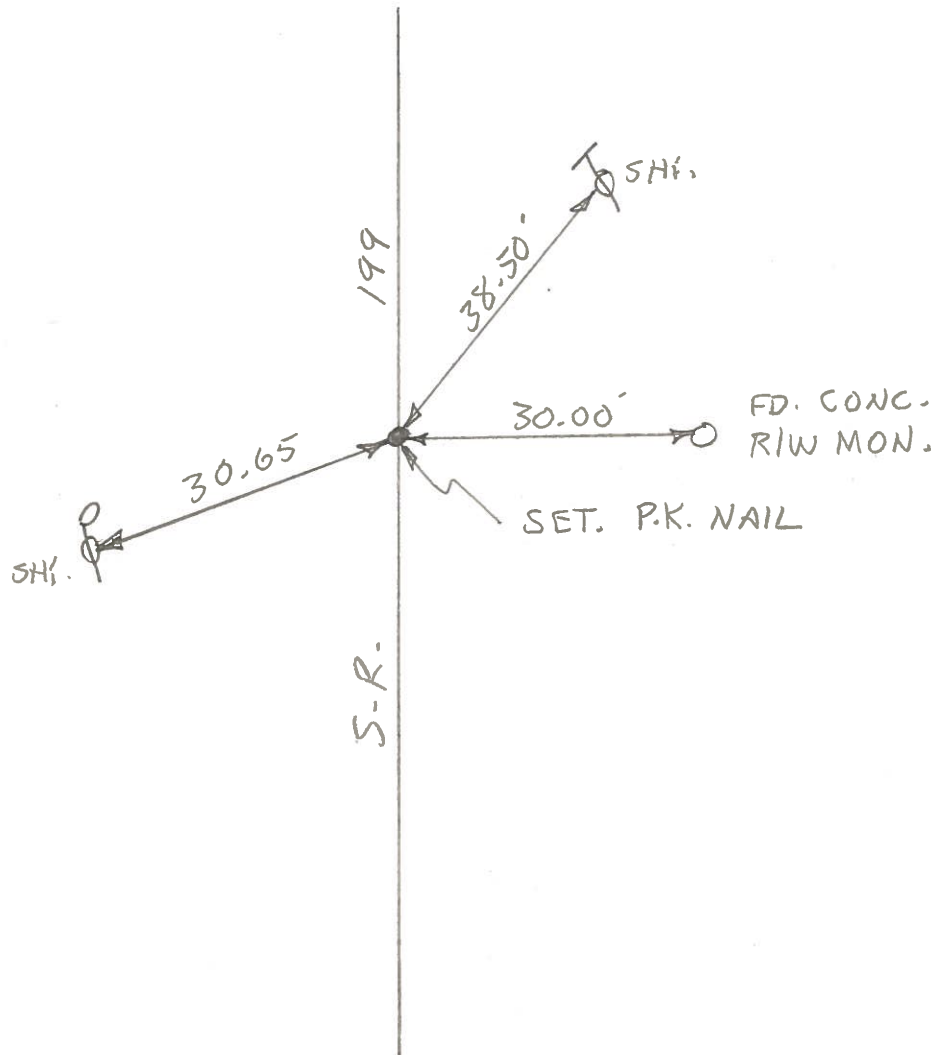

PERSONNEL	TITLE	PERSONNEL	TITLE	COUNTY	DATE
Jowski				Wood	JAN. 26, 1972
Neuser				S. R. #199	WEATHER
Vanyo				SEC.	TEMP. 10°
Granata					

DESCRIPTION Ref. Mon. JOB NO. _____

