



O.D.O.T. DISTRICT 2 SURVEY OFFICE (USE ONLY)

PERSONNEL _____ REFERENCE NO. 50 C SHEET 5 OF 72
 NOTES HUSS DATE 6/23/11 ROUTE SR 199
 H.C. HUSS WEATHER CLOUDY/RAIN COUNTY WOOD
 R.C. CANTERBURY TEMP. 70° TOWNSHIP FREEDOM
 SECTION 20
 T 5 N R 12 E

TYPE MONUMENT 5/8" IPIPE
 ON SURFACE - ~~BELOW~~ ON
~~LEFT - C PAV'T~~ - RIGHT 7.8', 117' W OF C
6.0' TO LT EDGE PAVEMENT
 S.L.M. 888+86.67

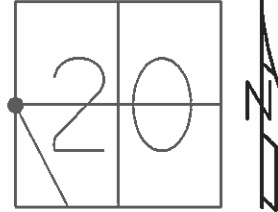

GRID: NORTHING: _____ - EASTING: _____

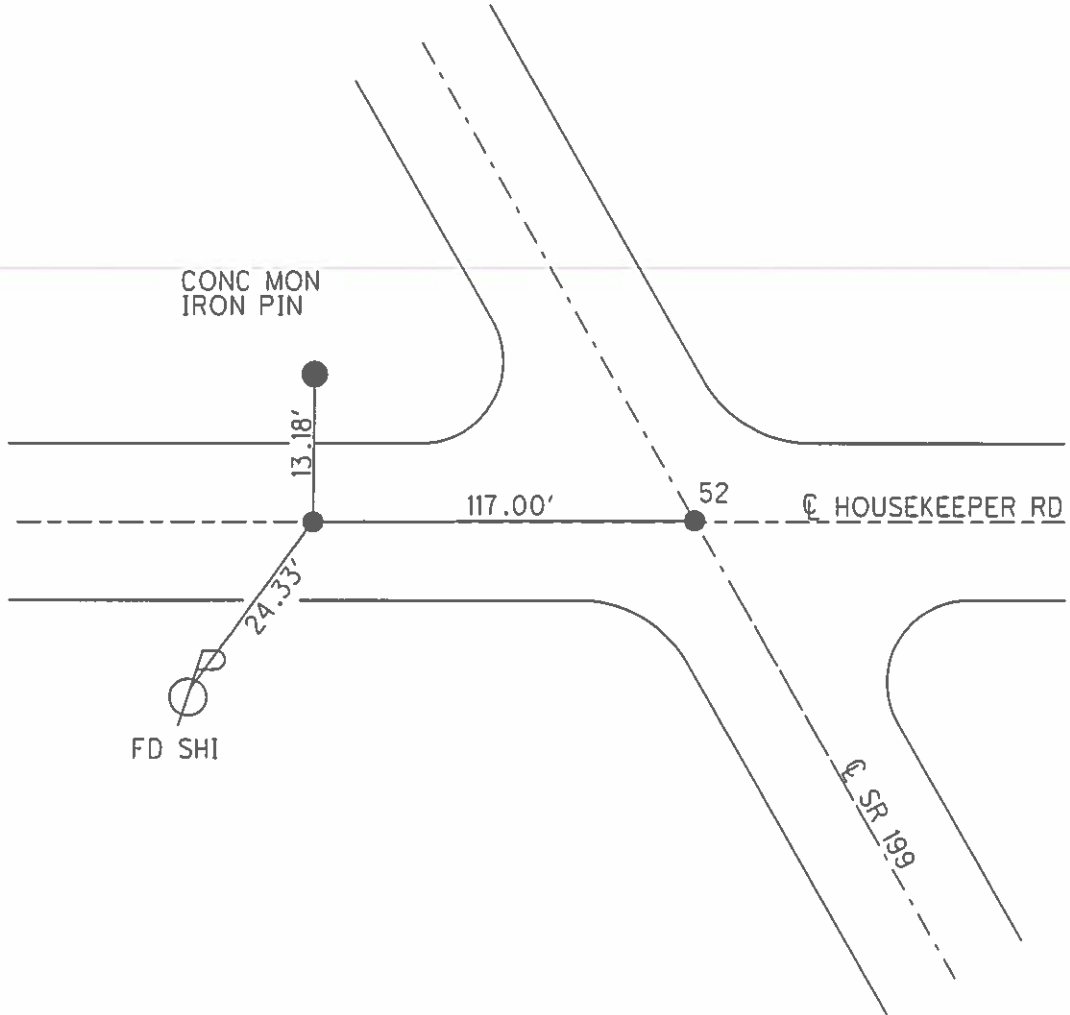

O.D.O.T. DISTRICT 2 SURVEY OFFICE

PERSONNEL

REFERENCE NO. 52

SHEET OF

NOTES BARNHISEL

H.C. SOCKMALL

R.C. HOFFMAN

DATE 7-13-87

WEATHER CLOUDY

TEMP. +85°

ROUTE 199

COUNTY WOOD

TOWNSHIP FREEDOM - Webster

SECTION 20

T 5 N R 12 E

TYPE MONUMENT 5/8" RE-BAR



ON SURFACE - ~~BELOW~~ yes

LEFT - ~~E~~ PAV'T. - RIGHT 7.8 to Rt Ed

G.O. TO Lt EDGE PAVEMENT

S.L.M. 117' West of E 199 on HouseKeeper Rd

50c

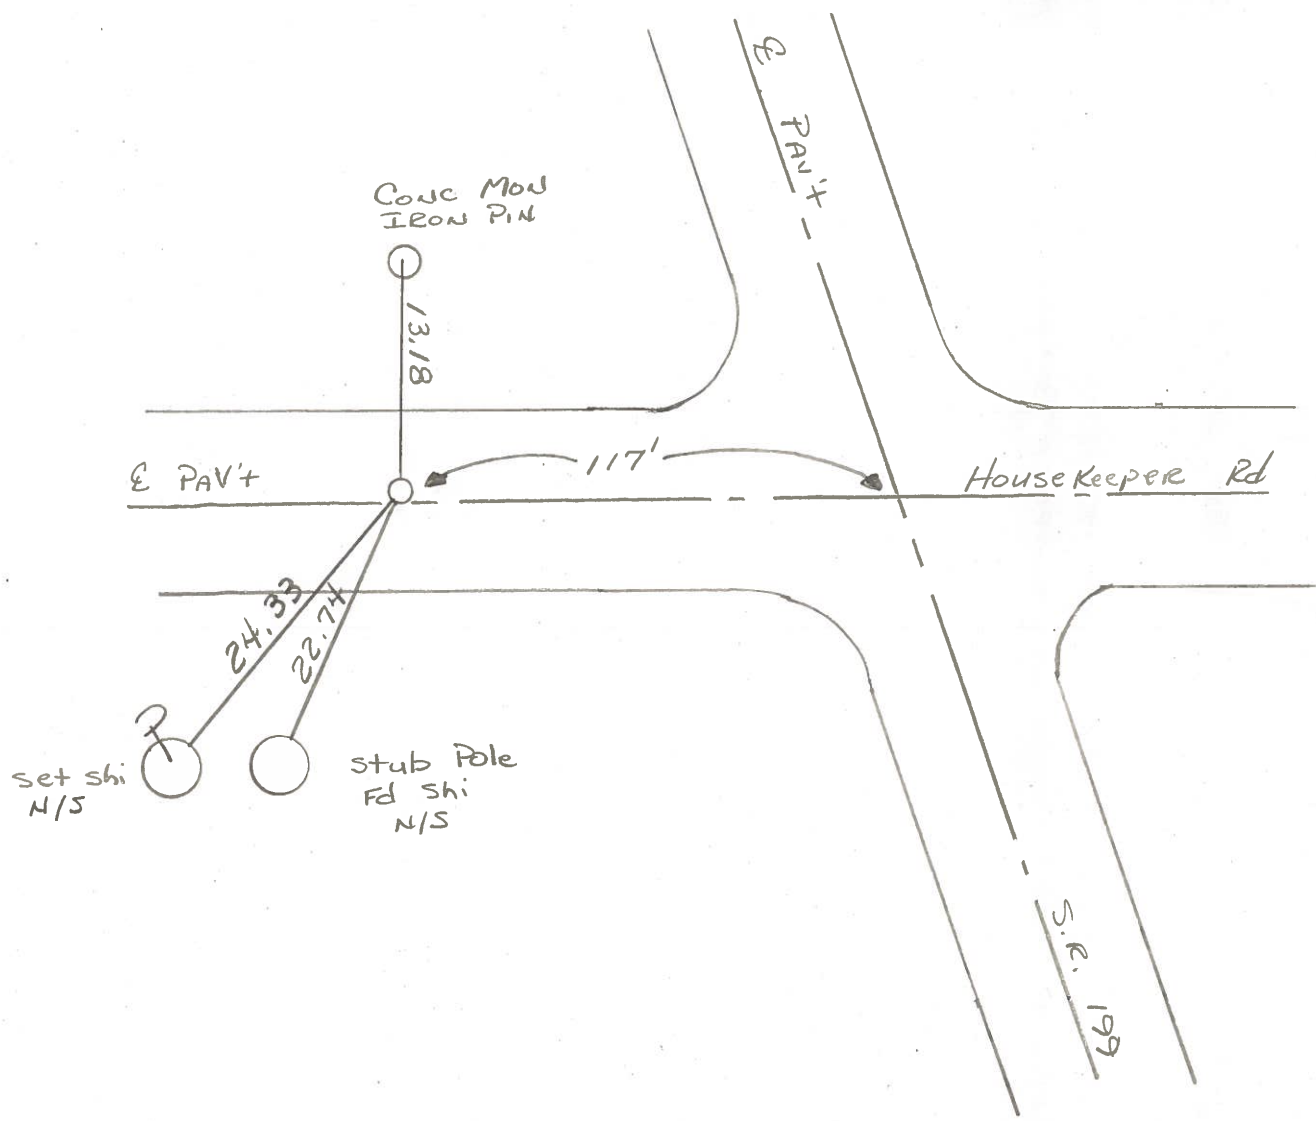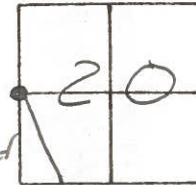

County WOOD S.R. 199

Township FREEDOM

Section 19

T N, R E

Personnel TOMSIK

NEUSER

VANYO

GRANATA

Date 2-28-72

Weather _____


Temp. _____

19	20
30	29

500



#52

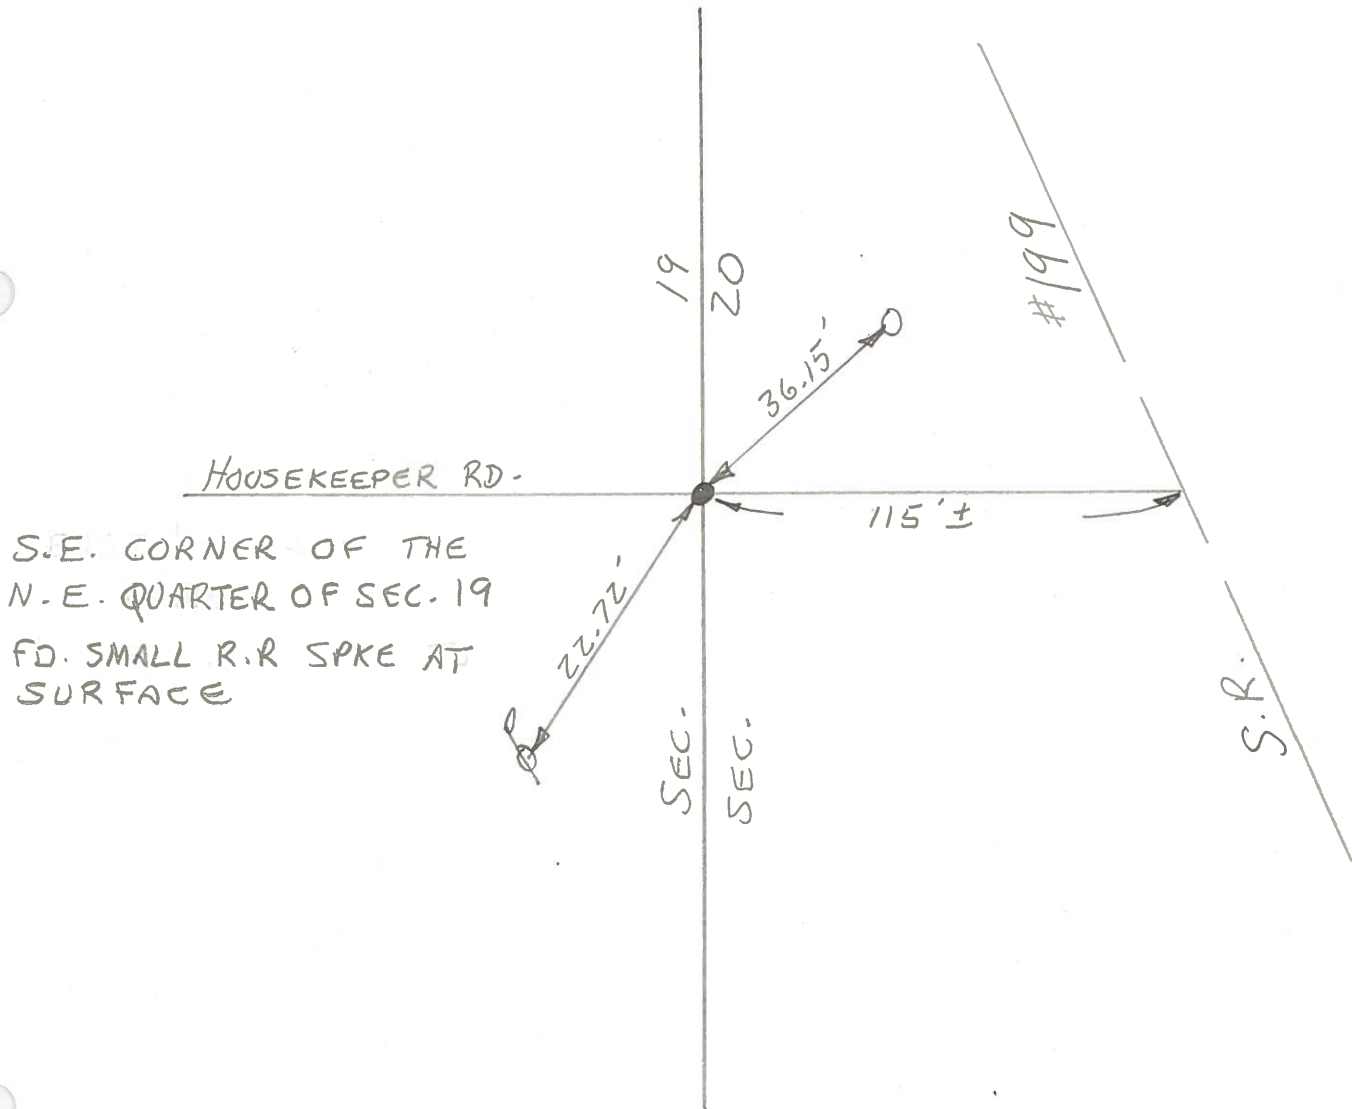

PERSONNEL	TITLE	PERSONNEL	TITLE	COUNTY	DATE	WEATHER	TEMP.
Tomsic				Wood	Feb. 28, 1972		
Neuser				S. R. 199			
Vanyo							
Granata							

DESCRIPTION Ref. Mon. LEFT CENTER LINE RIGHT JOB NO. _____

