

O.D.O.T. DISTRICT 2 SURVEY OFFICE (USE ONLY)

PERSONNEL

REFERENCE NO. 52 A

SHEET 7 OF 78

NOTES TOMSIK
 H.C. NEUSER
 R.C. VANYO
GRANATA

DATE 2/28/72
 WEATHER FAIR
 TEMP. 39°

ROUTE SR 199
 COUNTY WOOD
 TOWNSHIP FREEDOM
 SECTION 17

DWG BY NIESE PID _____

T 5 N R 12 E

TYPE MONUMENT P.K./WASHER

ON SURFACE - BELOW _____

OFFSET ϕ PAVEMENT _____ LT : RT

_____ TO _____ EDGE PAVEMENT


STATION: _____

HORZ. DATUM: _____


GEOID: _____

GRID: NORTHING: _____

EASTING: _____

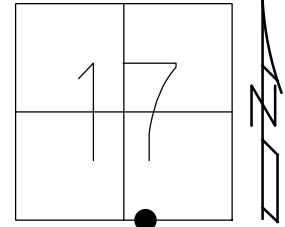


RECORD:
 FD P.K./WASHER
 2/28/72, TOMSIK
 2/1/10, SAH

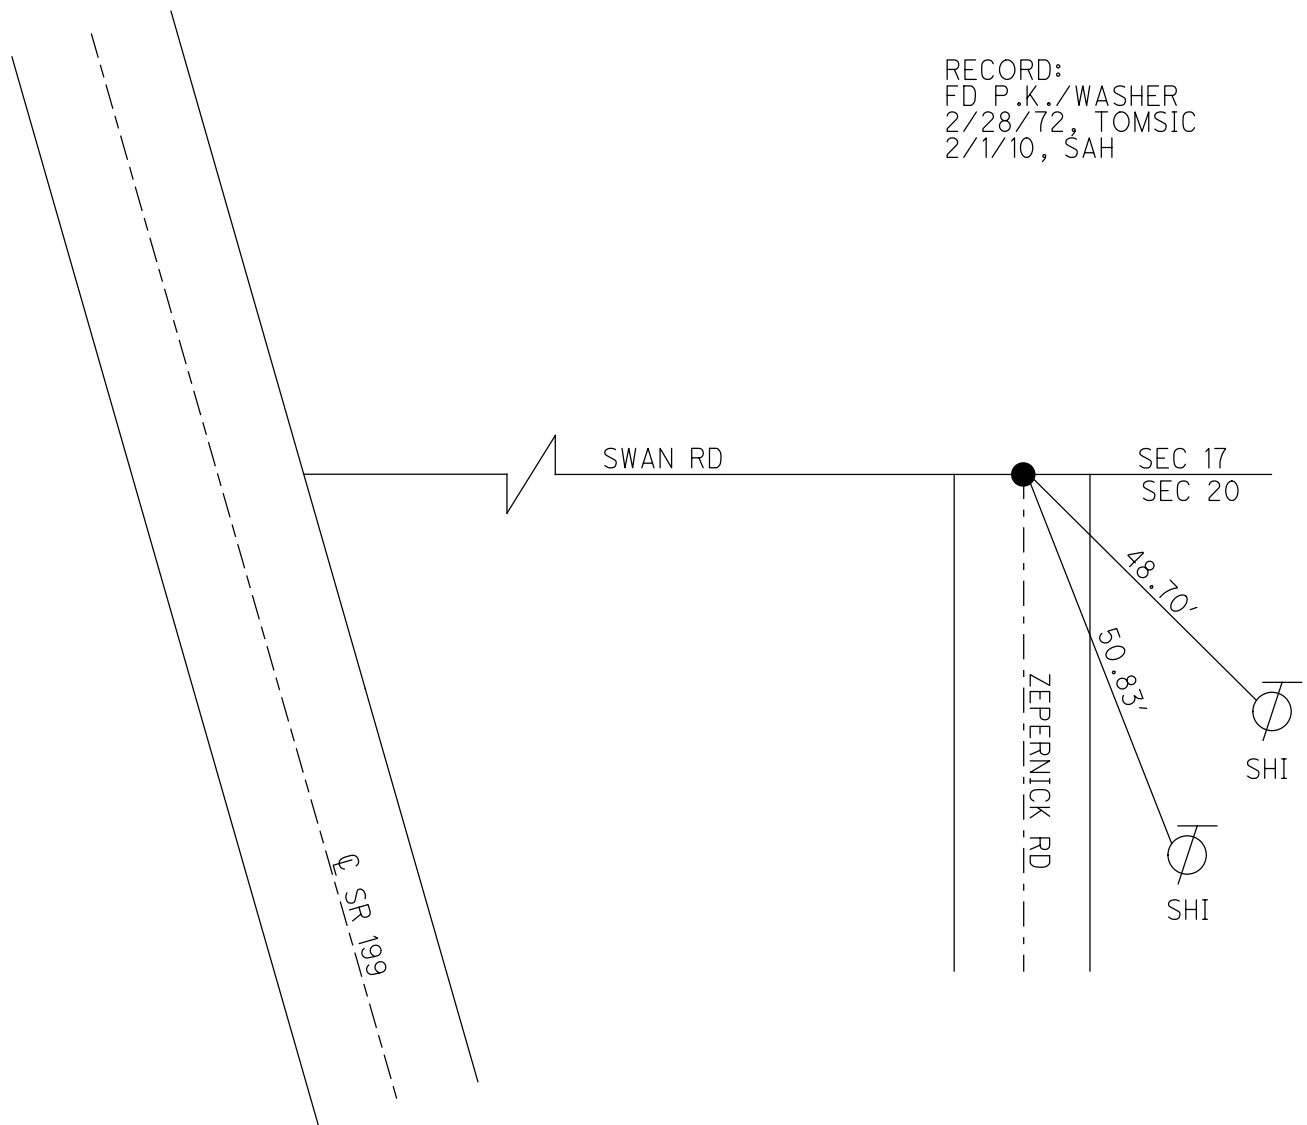


O.D.O.T. DISTRICT 2 SURVEY OFFICE (USE ONLY)

PERSONNEL _____ REFERENCE NO. 52 A SHEET 7 OF 72
 NOTES TOMSIK DATE 2/28/72 ROUTE SR 199
 H.C. NEUSER WEATHER FAIR COUNTY WOOD
 R.C. VANYO TEMP. 39° TOWNSHIP FREEDOM
GRANATA SECTION 17
 T 5 N R 12 E

TYPE MONUMENT _____ PK/WASHER _____
 ON SURFACE - BELOW _____
 LEFT - \odot PAV'T - RIGHT _____
 _____ TO _____ EDGE PAVEMENT
 S.L.M. _____
 GRID: NORTHING: _____ EASTING: _____

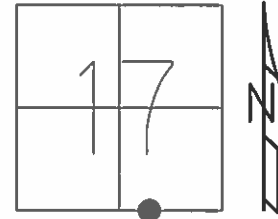

FD 2/1/10, SAH

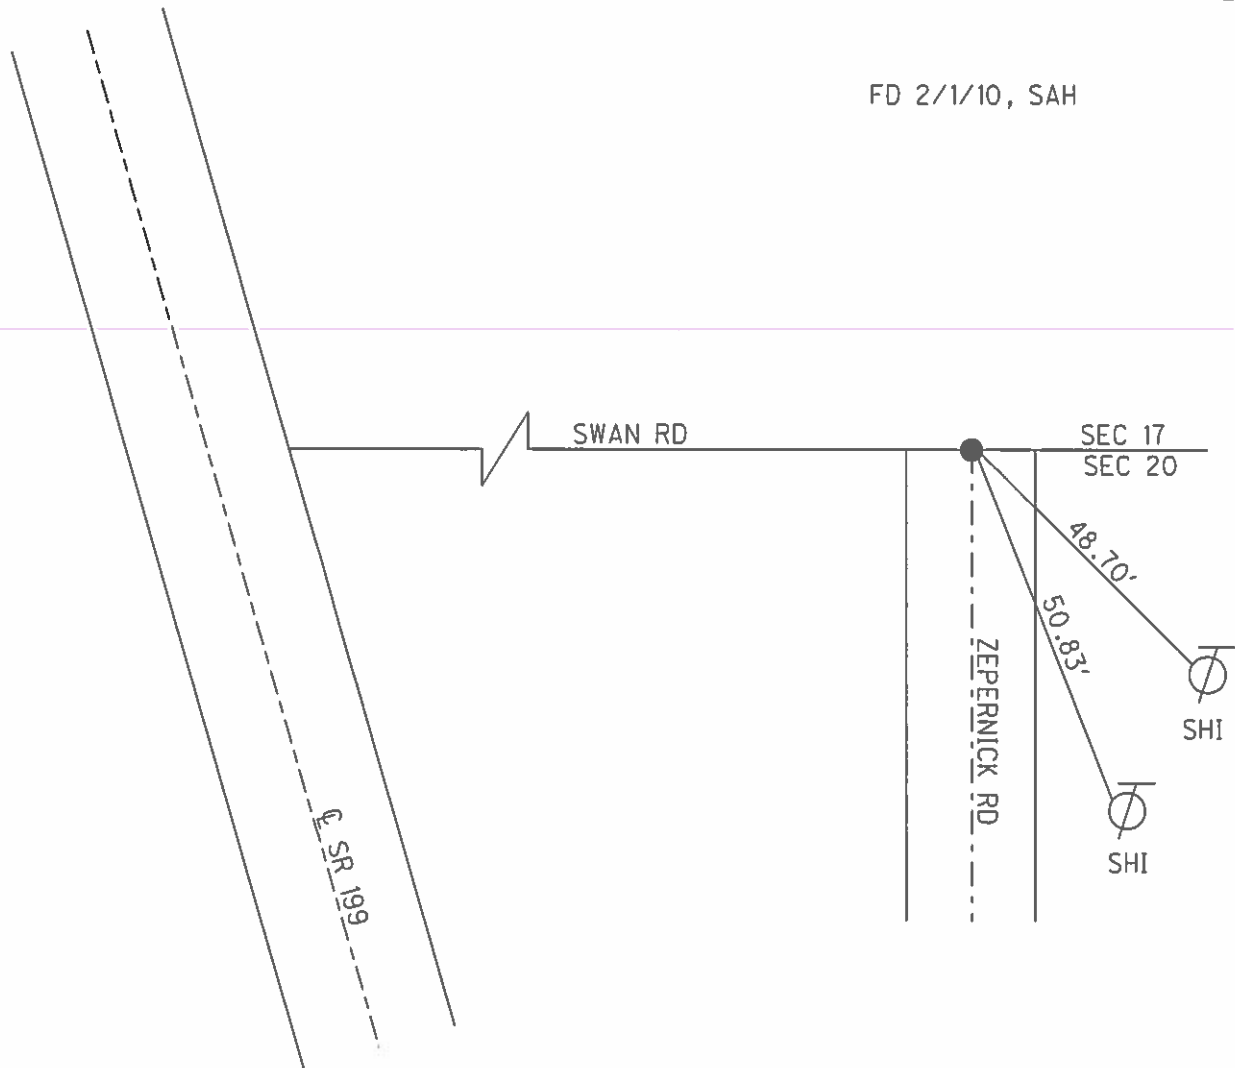

County WOOD S.R. 199

Date 2-28-72

Township FREEDOM

Weather _____

Section 20

Temp. _____

T N, R E

Personnel TOMSIK

18	17
19	20




NEUSER

VANYO

GRANATA

52-A

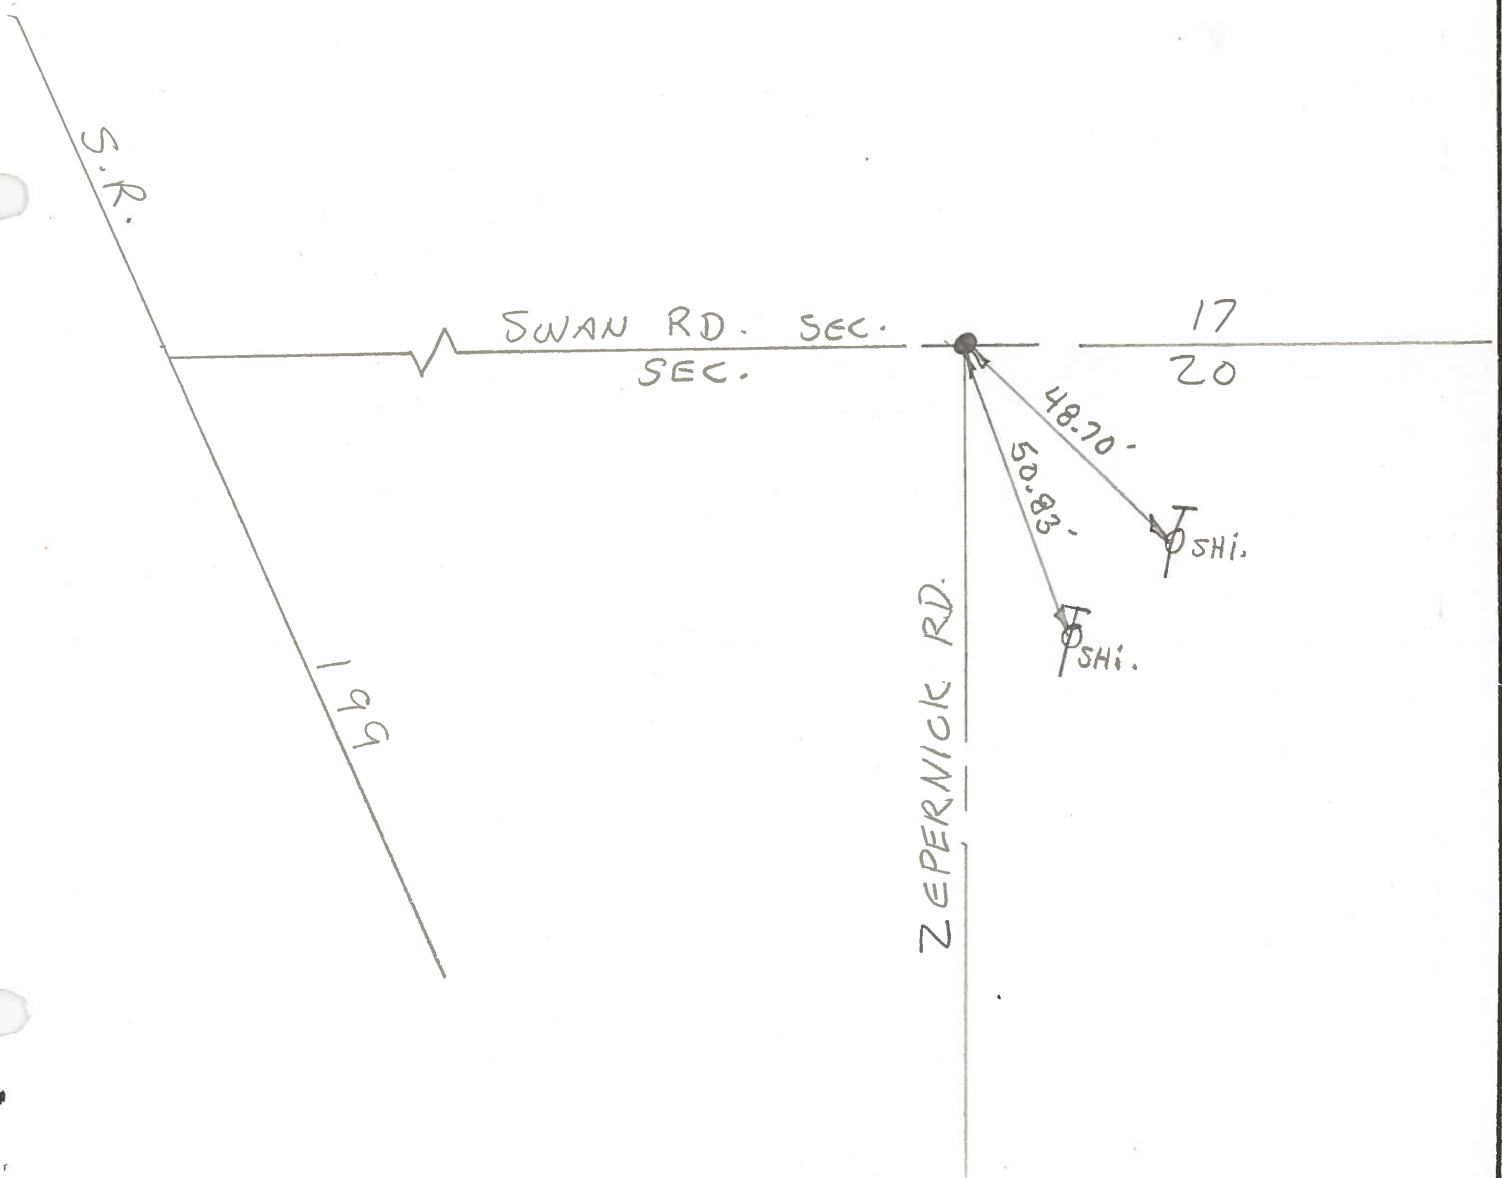

PERSONNEL	TITLE	PERSONNEL	TITLE	COUNTY	DATE	WEATHER	TEMP.
Tomsic				Wood	Feb. 28, 1972		
Neuser				S. R. 199			
Vanyo							
Granata				SEC.			

DESCRIPTION Ref. Mon. LEFT CENTER LINE RIGHT JOB NO. _____

