

O.D.O.T. DISTRICT 2 SURVEY OFFICE (USE ONLY)

PERSONNEL

REFERENCE NO. 54

SHEET 12 OF 78

NOTES NIESE

DATE 8/26/21

ROUTE SR 199

H.C. AUBLE

WEATHER SUNNY

COUNTY WOOD

R.C. NIESE

TEMP. 79°

TOWNSHIP WEBSTER

DWG BY NIESE PID 107613

SECTION 18

T 5 N R 12 E

TYPE MONUMENT MAG/WASHER

ON SURFACE - ~~BELOW~~ ON

OFFSET C PAVEMENT 0.4' LT : ~~RT~~

9.2' TO LT EDGE PAVEMENT



STATION: 930+64.15

HORZ.DATUM: NAD83(2011)

GEOID: NAVD88 2012A

GRID: NORTHING: 628698.391

EASTING: 1689559.441

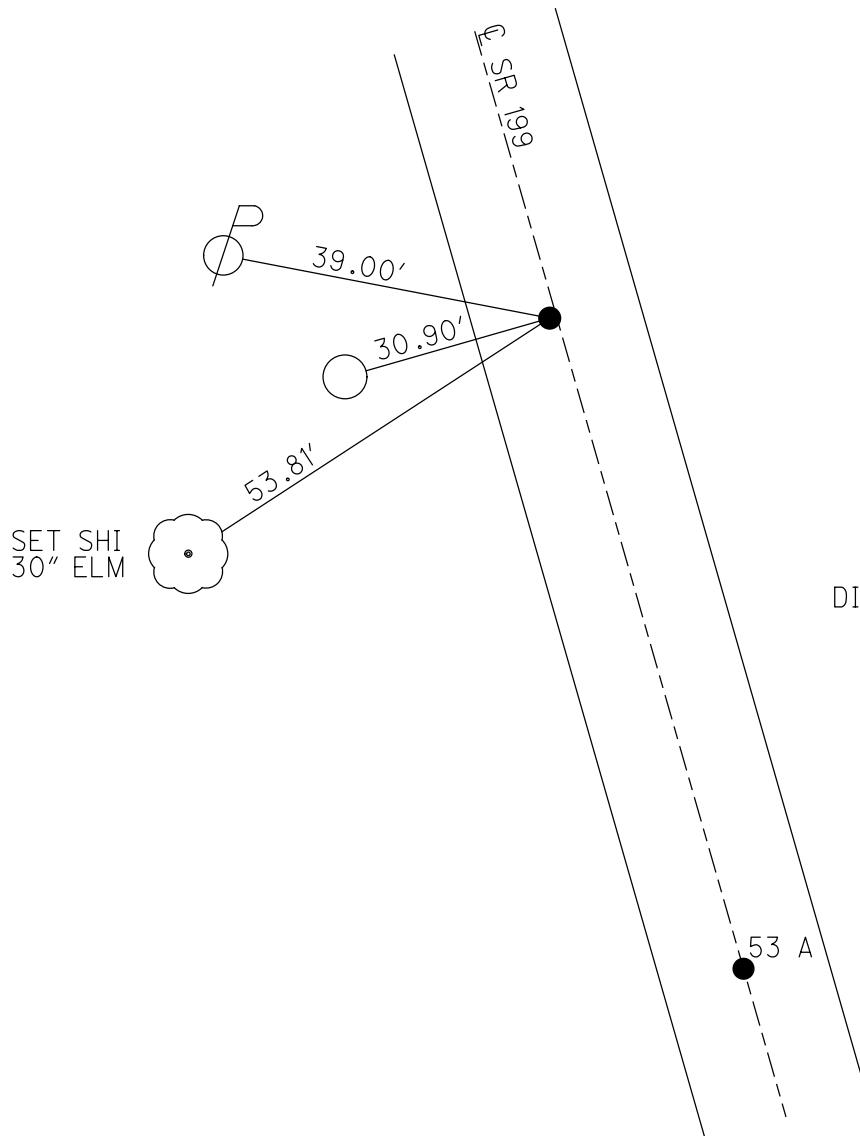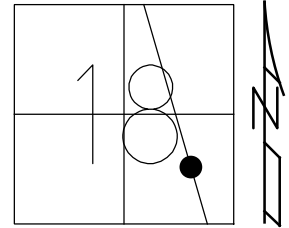



RECORD:
 POINT SET BY OTHERS
 SET SM.R.R.SPIKE
 9/4/87, MDB
 FD SM.R.R.SPIKE
 2/1/10
 6/23/11, SAH
 SET MAG/WASHER
 9/1/11, SAH
 FD MAG/WASHER
 12/7/11, SAH
 REF54
 8/7/19, JLL
 8/26/21, DSA
 11/23/21, DSA

DIST. 53A-54=134.69' REC

O.D.O.T. DISTRICT 2 SURVEY OFFICE (USE ONLY)

PERSONNEL _____ REFERENCE NO. 54 SHEET 11 OF 72
 NOTES HUSS DATE 6/23/11 ROUTE SR 199
 H.C. HUSS WEATHER CLOUDY/RAIN COUNTY WOOD
 R.C. CANTERBURY TEMP. 70° TOWNSHIP WEBSTER
 _____ SECTION 18
 _____ T 5 N R 12 E

TYPE MONUMENT SM RR SPIKE
 ON SURFACE - ~~BELOW~~ ON
 LEFT - ~~C PAV'T~~ - ~~RIGHT~~ 0.4'
9.2' TO LT EDGE PAVEMENT
 S.L.M. 930+64.15
 GRID: NORTHING: 628698.412 EASTING: 1689559.413

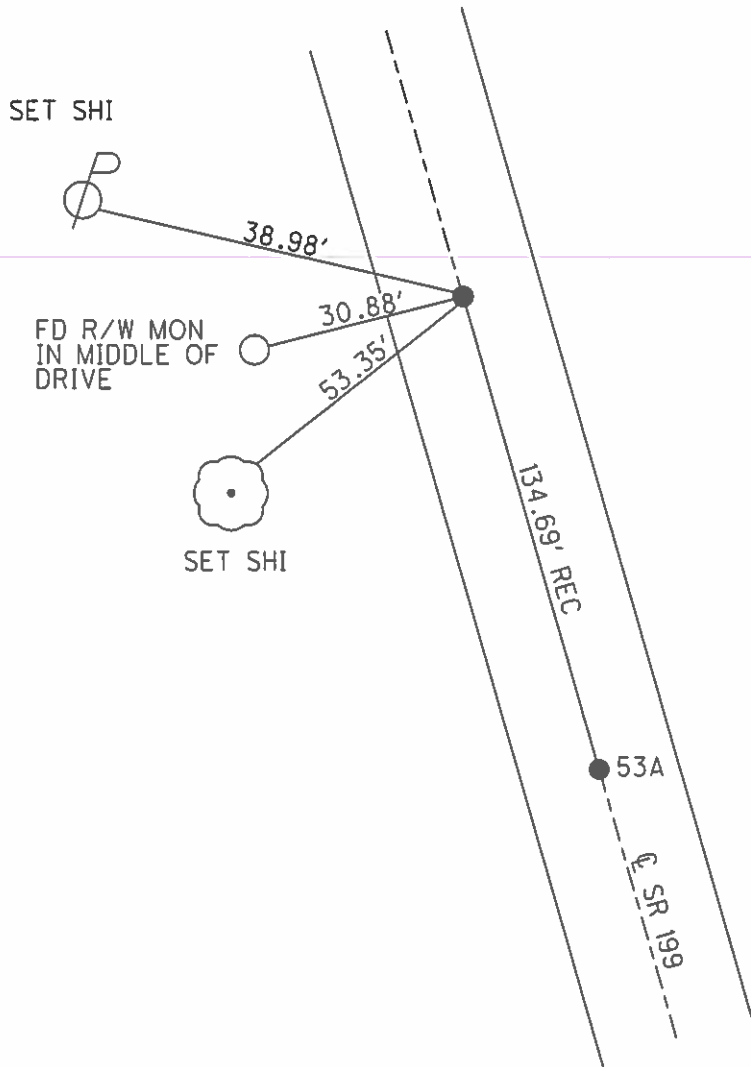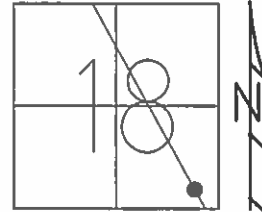

NOTE: POINT SET BY OTHERS
 SET SM RR SPIKE 9/4/87, MDB
 FD SM RR SPIKE 2/01/10
 SET MAG/WASHER 9/01/11, SAH
 GPS, REF 54 12/7/11, SAH
 1470' N OF SWAN RD

O.D.O.T. DISTRICT 2 SURVEY OFFICE

PERSONNEL _____

REFERENCE NO. _____

SHEET _____ OF _____

NOTES BARNHISEL

H.C. SOCKMAN

R.C. HOFFMAN

DATE 7-13-87

WEATHER Partly cloudy

TEMP. +85°

ROUTE 199

COUNTY WOOD

TOWNSHIP Webster

SECTION 18

T. 5 N. R. 12 E


TYPE MONUMENT P.K. NAILS

ON SURFACE - BELOW yes

LEFT - ☉ PAV'T. - RIGHT .4


PT A 9.0
PT B 9.2 TO LT EDGE PAVEMENT

S.L.M. 919 + 80 921 + 15

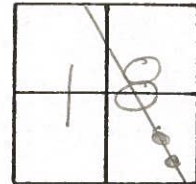

Note: Points Set by others

Set Sm RR Spk's
9-4-87
in DB

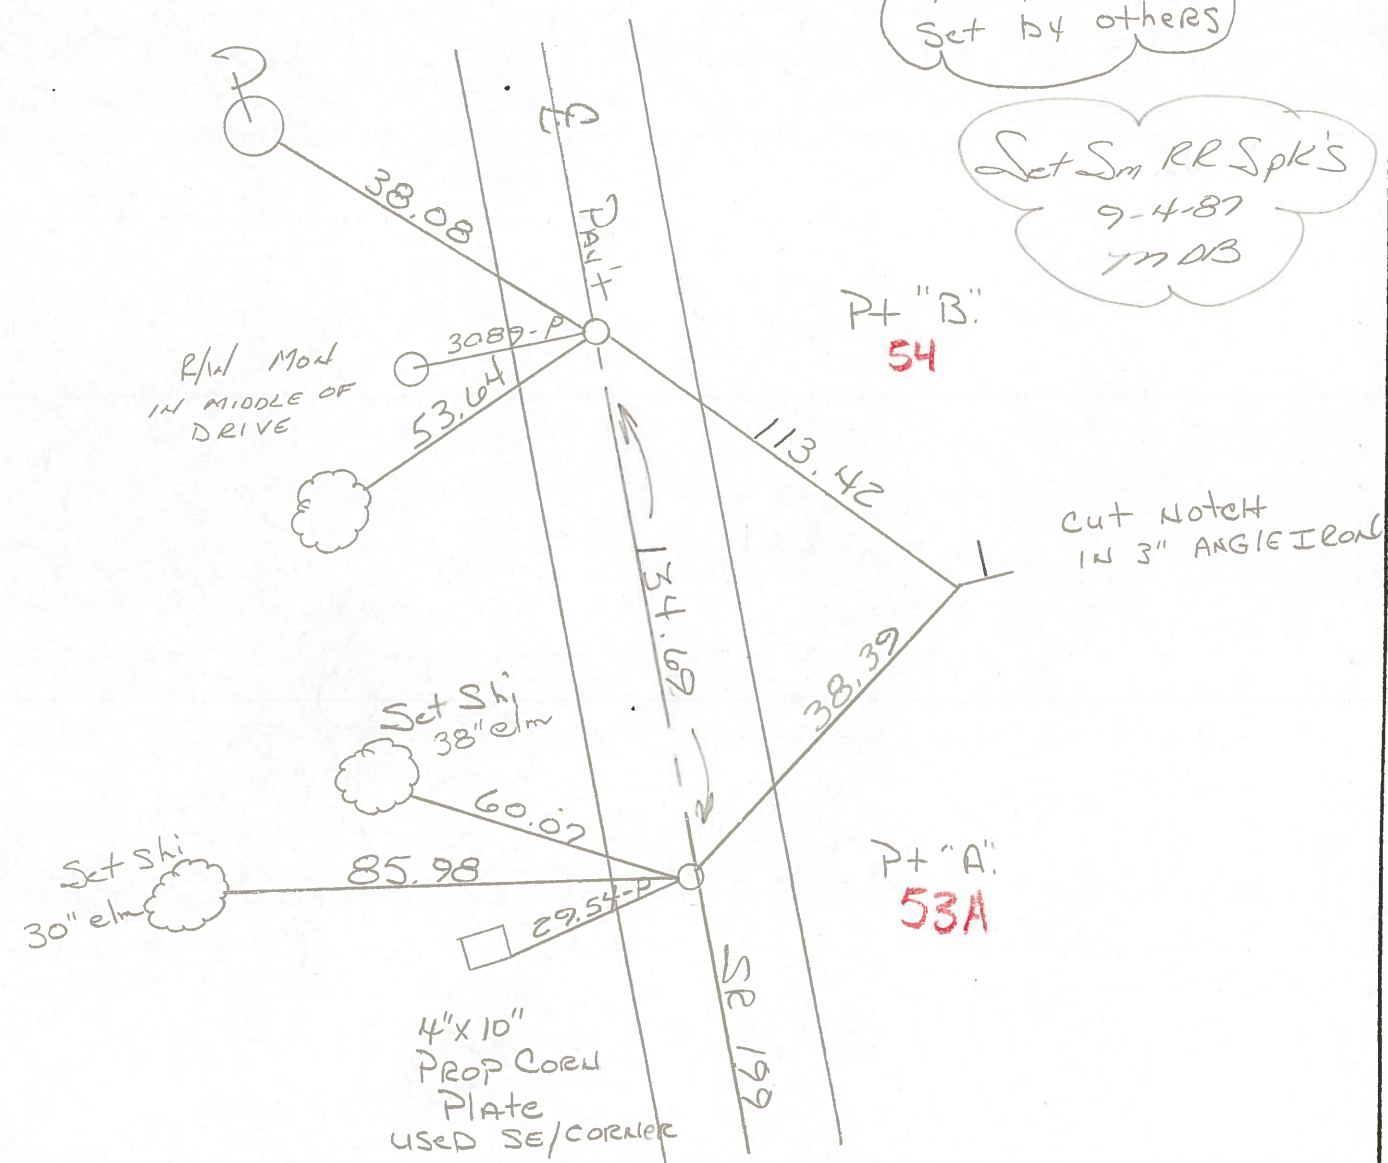

County WOOD S.R. 199

Township WEBSTER

Section 18

T N, R E

Personnel TOMSIK

NEUSER

VANYO

GRANATA

Date 12-8-71


Weather _____

Temp. _____

12	7
13	18



54 1470'± N. OF SWAN RD.

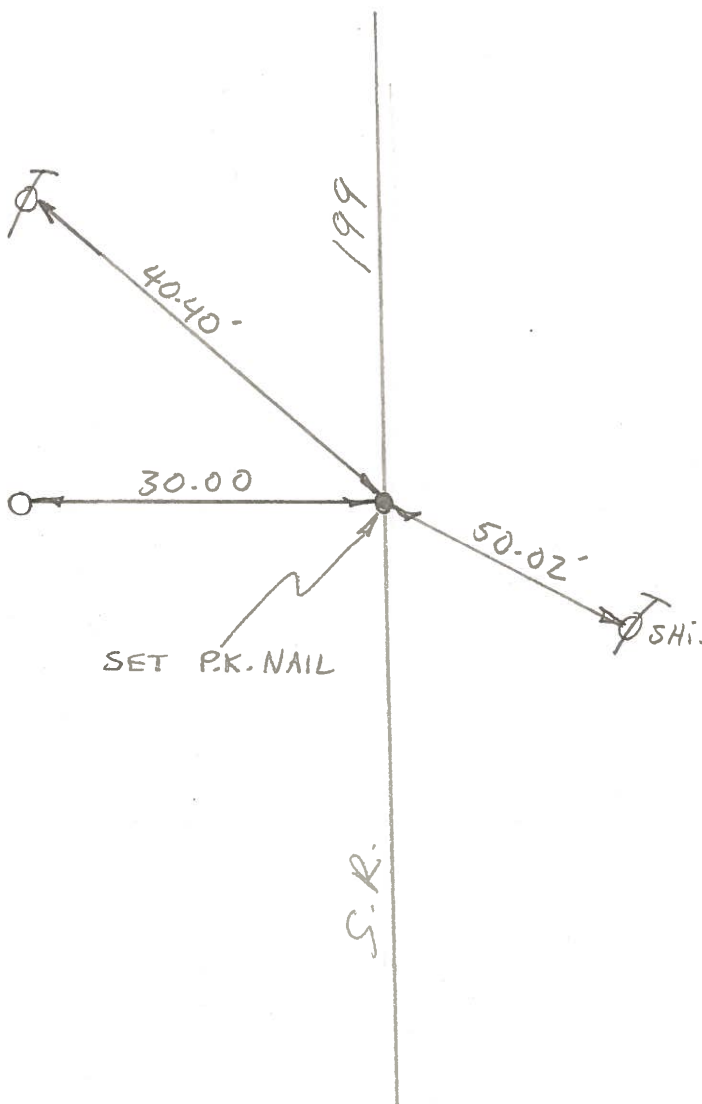

PERSONNEL	TITLE	PERSONNEL	TITLE
TOMSIK			
NEUSER			
VANYO			
GRANATA			

COUNTY WOOD DATE NOV. 8-1971
 S. R. 199 WEATHER _____
 SEC. _____ TEMP. _____

DESCRIPTION _____ LEFT _____ CENTER LINE _____ RIGHT _____ JOB NO. _____

