

O.D.O.T. DISTRICT 2 SURVEY OFFICE (USE ONLY)

PERSONNEL

REFERENCE NO. CL1

NOTES BARRIERE
H.C. BARRIERE
R.C. TOMASI


DATE 7/22/26
WEATHER CLEAR
TEMP. 80°

ROUTE SR 199
COUNTY WOOD
TOWNSHIP WEBSTER
SECTION 23

DWG BY BARRIERE PID 121971

T 6 N R 11 E

TYPE MONUMENT MAG
ON SURFACE - BELOW ON
OFFSET $\oslash$ PAVEMENT 1' RT

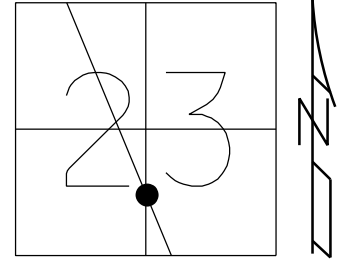

STATION: _____

HORIZ.DATUM: NAD83 (2011)

GEOID: _____

GRID: NORTHING: _____

EASTING: _____

LDP: NORTHING: 476520.929

EASTING: 188563.967

RECORD: FD MAG 4" DOWN
CL1
7/22/26, JAB

NOTE: 'CL1' IS 265.05' (GPS) FROM REF61 (MAG)

