

O.D.O.T. DISTRICT 2 SURVEY OFFICE (USE ONLY)

PERSONNEL

REFERENCE NO. 65 A

SHEET 56 OF 75

NOTES AUBLE

DATE 4-23-18

ROUTE SR 199

H.C. LEU

WEATHER SUNNY

COUNTY WOOD

R.C. AUBLE

TEMP. 57°

TOWNSHIP PERRYSBURG

SECTION 28

DWG BY AUBLE

PID 101221

T 6 N R 11 E

TYPE MONUMENT MAG/WASHER

ON SURFACE - ~~BELOW~~ ON

OFFSET ☉ PAVEMENT 1.3' LT : ~~RT~~

8.6' TO LT EDGE PAVEMENT



STATION: 1358+03

HORIZ.DATUM: NAD83 (2011)

GEOID: 2012A

GRID: NORTHING: 667964.612

EASTING: 1671049.787

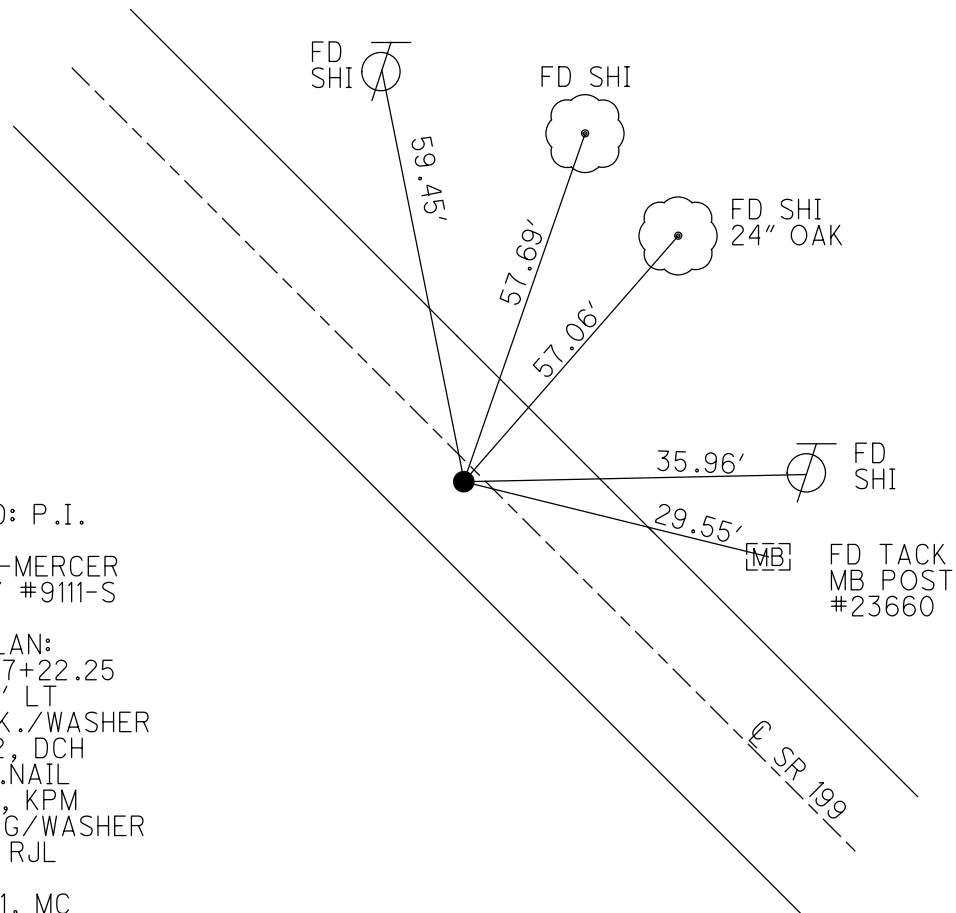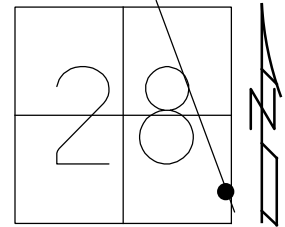


RECORD: P.I.
 SET BY
 ASKING-MERCER
 SURVEY #9111-S
 2-14-91
 1926 PLAN:
 STA.207+22.25
 $\Delta = 0^{\circ}11'$ LT
 SET P.K./WASHER
 8/9/02, DCH
 FD P.K.NAIL
 7/21/11, KPM
 SET MAG/WASHER
 9/1/11, RJL
 REFA65
 12/16/11, MC
 FD MAG/WASHER
 REFA65
 4/23/18
 6-3-19, JLL

O.D.O.T. DISTRICT 2 SURVEY OFFICE (USE ONLY)


PERSONNEL _____ REFERENCE NO. 65 A SHEET 55 OF 72
 NOTES MOSER DATE 7/21/11 ROUTE SR 199
 H.C. MOSER WEATHER SUNNY COUNTY WOOD
 R.C. HARBAUGH TEMP. 90° TOWNSHIP PERRYSBURG
 _____ SECTION 28

T 6 N R 11 E
 TWP 4 USR

TYPE MONUMENT _____ PK _____
 ON SURFACE - ~~BELOW~~ _____ ON _____
 LEFT - ~~C PAV'T~~ - RIGHT _____ 1.3'
 8.6' TO LT EDGE PAVEMENT
 S.L.M. _____ 1358+03

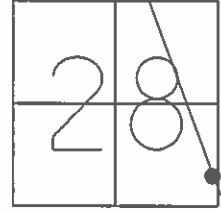

GRID: NORTHING: 667964.585 EASTING: 1671049.724

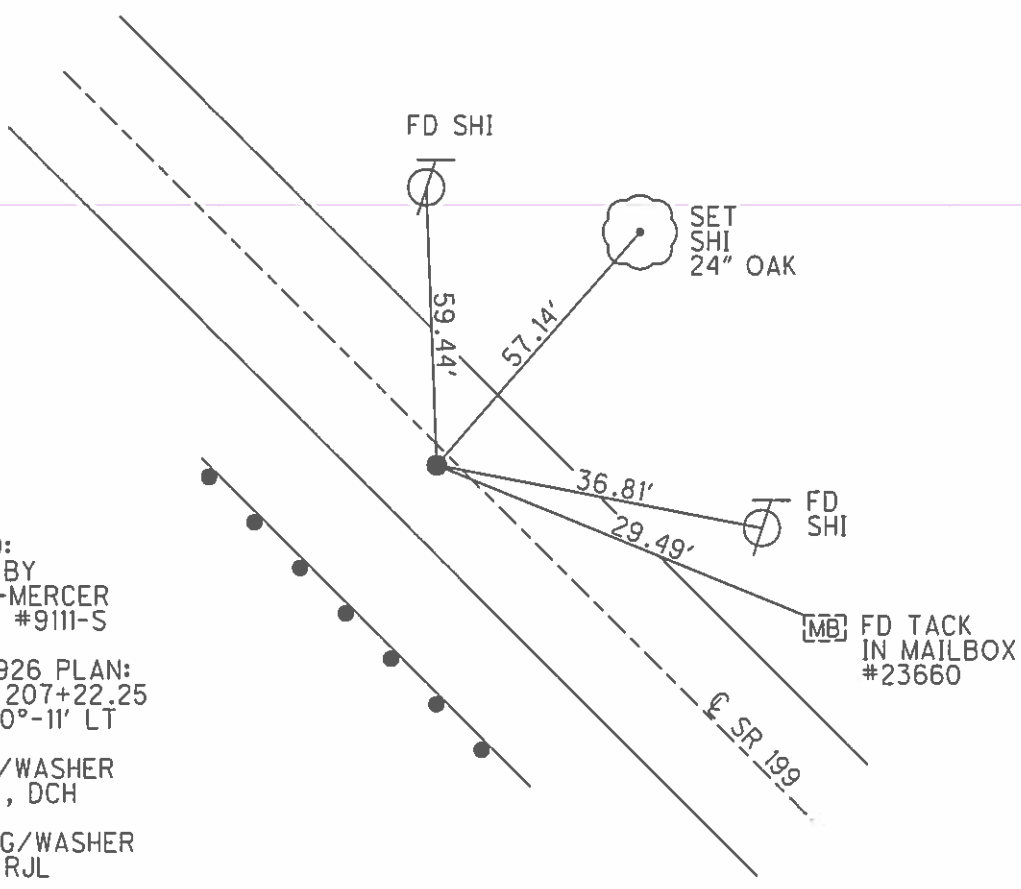

RECORD:
 PI SET BY
 ASKING-MERCER
 SURVEY #9111-S
 2-14-91
 FROM 1926 PLAN:
 PI STA 207+22.25
 DELTA=0°-11' LT

 SET PK/WASHER
 8/9/02, DCH

 SET MAG/WASHER
 9/1/11, RJL

 FINAL GPS
 REFA65, 12/16/11
 MC

O.D.O.T. DISTRICT 2 SURVEY OFFICE

PERSONNEL

REFERENCE NO. 65A

SHEET 34 OF 45


NOTES MOSER
 H.C. HOMAN
 R.C. ROUSOS
 CANTERBURY

DATE 4-6-02
 WEATHER SUNNY
 TEMP. +35°

ROUTE S.R. 199
 COUNTY WOOD
 TOWNSHIP PERRYSBURG
 SECTION 28


T 6 N R 11 E
 TWP 4 U.S.R.

TYPE MONUMENT P.K.
 ON SURFACE - ~~BELOW~~ YES
 LEFT - ~~Q~~ PAV'T - ~~RIGHT~~ 1.2' LT.
8' TO LT. EDGE PAVEMENT
 S.L.M. 1358+03

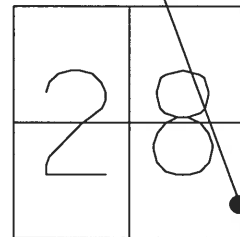

SET PK NAIL &
 WASHER 8-9-02
 D.C.H.

RECORD:
 P.I. SET BY
 ASKING-MERCER
 SURVEY #9111-S
 2-14-91
 FROM 1926 PLAN:
 P.I. STA. 207+22.25
 DELTA=0°-11' LT.

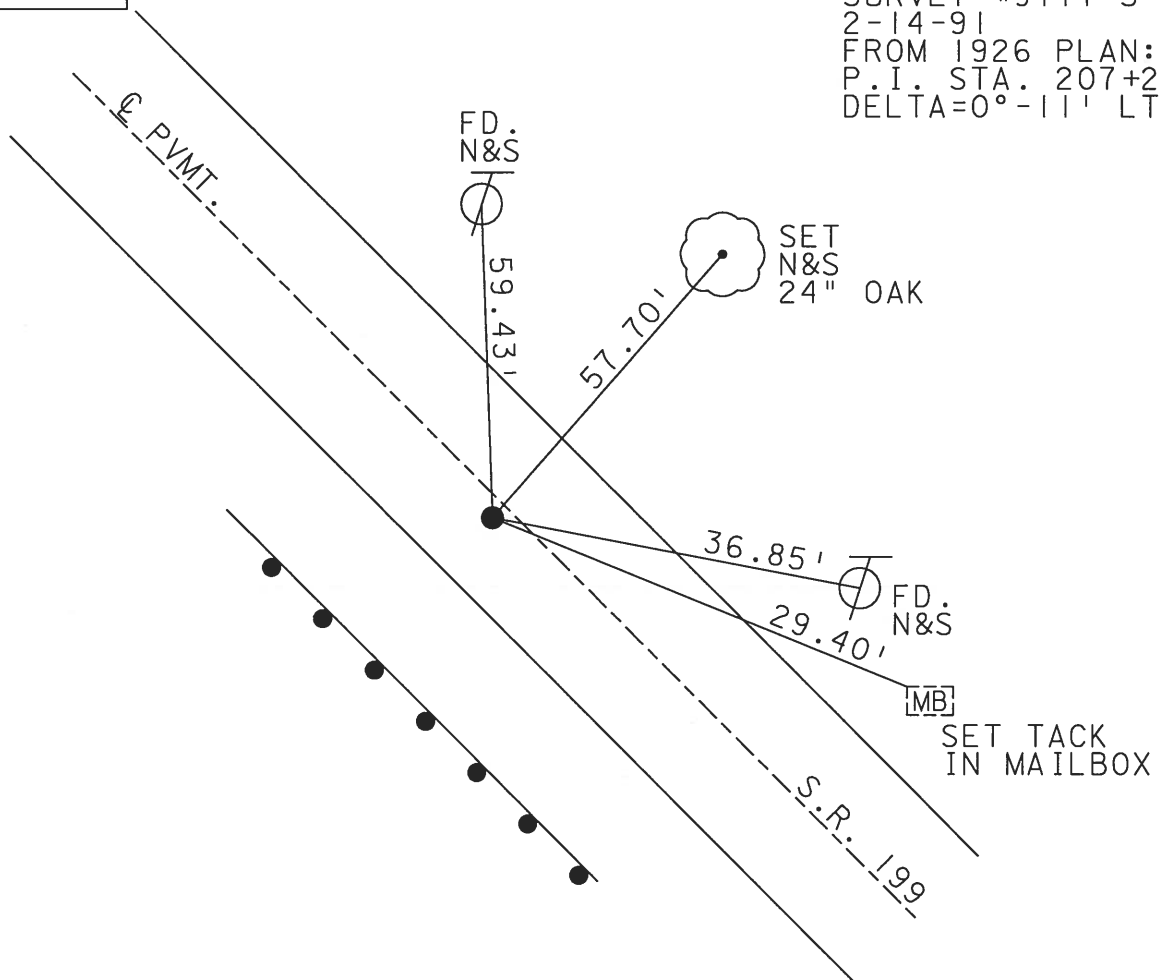

O.D.O.T. DISTRICT 2 SURVEY OFFICE

PERSONNEL _____

REFERENCE NO. 65-A SHEET _____ OF _____

NOTES HOFFMAN

H.C. LOEHRLE

R.C. BARANISEL

DATE 3-8-91

WEATHER CLEAR

TEMP. 35°

ROUTE SR 199


COUNTY WOOD

TOWNSHIP PERRYSBURG

SECTION 28

T6 N R 11 E

TWP. 4 U.S.R.

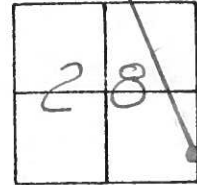

TYPE MONUMENT P.I.

ON SURFACE - BELOW YES

LEFT-~~C~~PAV'T. - RIGHT 1.2'

0.3 TO LT EDGE PAVEMENT

S.L.M. 1358+03

P.I. SET BY ASKING-MERCER SURVEY #9111-S 2-14-91

FROM 1926 PLAN:

P.I. STA 207+22.25

X LEFT = 0°-11'

