

O.D.O.T. DISTRICT 2 SURVEY OFFICE (USE ONLY)

PERSONNEL

REFERENCE NO. 66

SHEET 57 OF 75

NOTES AUBLE DATE 4-23-18  
 H.C. LEU WEATHER SUNNY  
 R.C. AUBLE TEMP. 58°

ROUTE SR 199  
 COUNTY WOOD  
 TOWNSHIP PERRYSBURG  
 SECTION 28  
 T 6 N R 11 E

DWG BY AUBLE PID 101221

TYPE MONUMENT MAG/WASHER

ON SURFACE - ~~BELOW~~ ON

OFFSET  $\varnothing$  PAVEMENT 0.3' LT : ~~RT~~

10' TO LT EDGE PAVEMENT


STATION: 1378+16

HORZ.DATUM: NAD83 (2011)


GEOID: 2012A

GRID: NORTHING: 669767.464

EASTING: 1670161.073

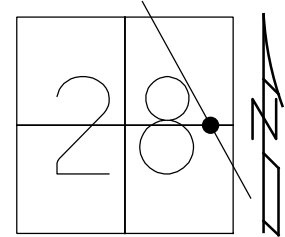


RECORD:  
 SET P.K./WASHER  
 8/9/02, DCH  
 FD P.K./WASHER  
 7/21/11, KPM  
 SET MAG/WASHER  
 9/9/11, RJL  
 REF66  
 12/16/11, MC  
 FD MAG/WASHER  
 REF66  
 4/23/18  
 6-3-19, JLL

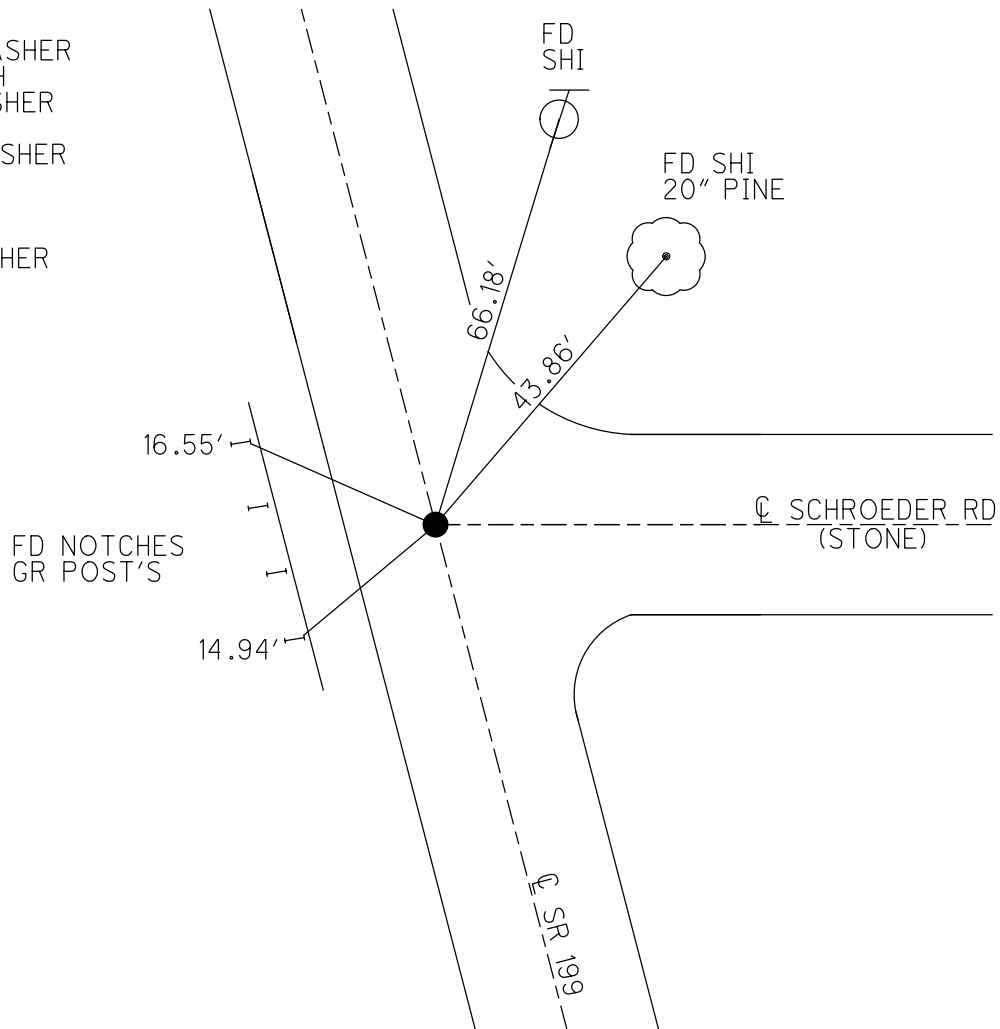


**O.D.O.T. DISTRICT 2 SURVEY OFFICE (USE ONLY)**

PERSONNEL \_\_\_\_\_ REFERENCE NO. 66 SHEET 56 OF 72  
 NOTES MOSE DATE 7/21/11 ROUTE SR 199  
 H.C. MOSE WEATHER SUNNY COUNTY WOOD  
 R.C. HARBAUGH TEMP. 90° TOWNSHIP PERRYSBURG  
 \_\_\_\_\_ SECTION 28  
 \_\_\_\_\_ T 6 N R 11 E

TYPE MONUMENT \_\_\_\_\_ PK/WASHER \_\_\_\_\_  
 ON SURFACE - ~~BELOW~~ \_\_\_\_\_ ON \_\_\_\_\_  
 LEFT - ☉ PAV'T - RIGHT 0.8'  
10' TO LT EDGE PAVEMENT  
 S.L.M. 1378+16

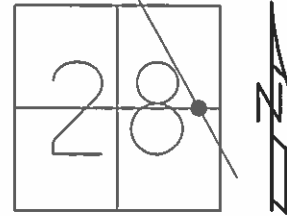

GRID: NORTHING: 669767.551 EASTING: 1670161.025

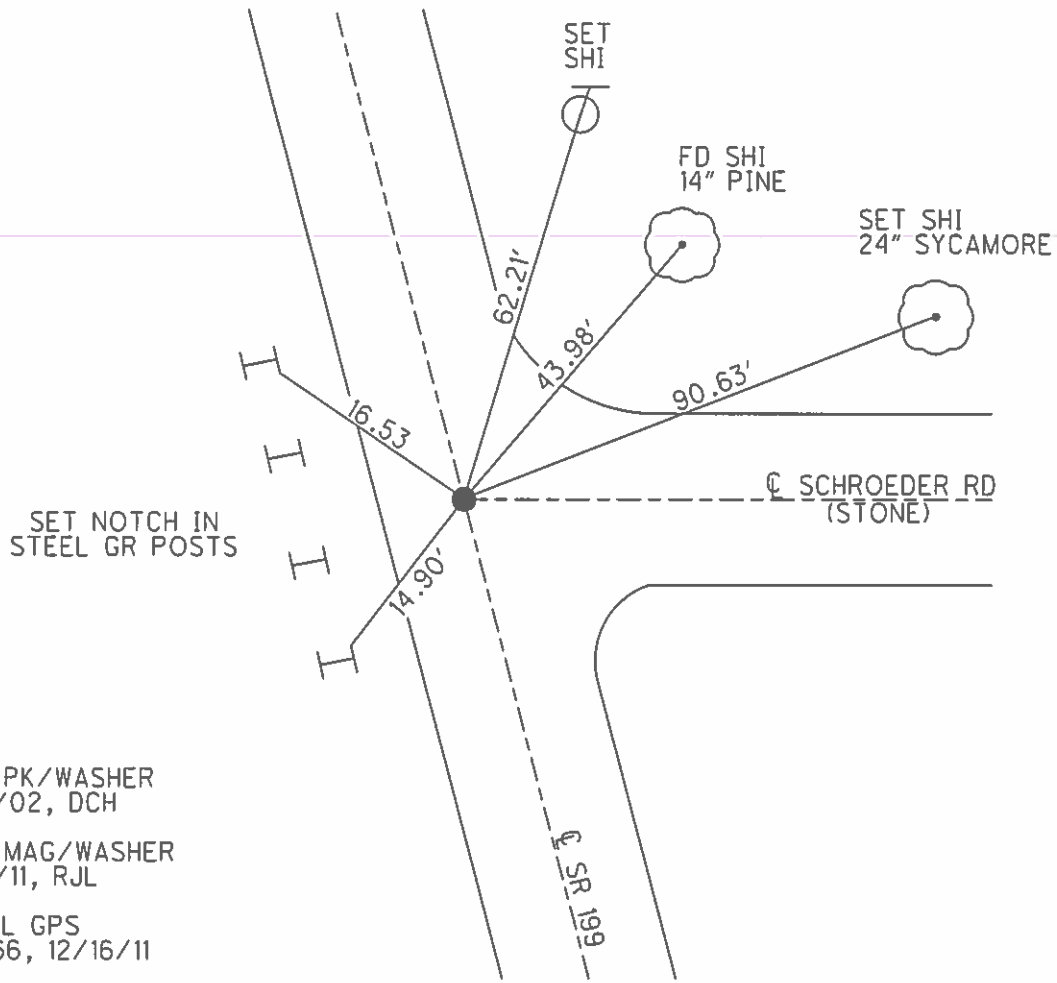

O.D.O.T. DISTRICT 2 SURVEY OFFICE

PERSONNEL

REFERENCE NO. 66

SHEET 35 OF 45

NOTES MOSER

DATE 4-6-02

ROUTE 199

H.C. HOMAN

WEATHER SUNNY

COUNTY WOOD

R.C. ROUSOS

TEMP. +35°

TOWNSHIP PERRYSBURG

CANTERBURY

SECTION 28

T 6 N R 11 E


TYPE MONUMENT PK & WASHER

ON SURFACE - ~~BELOW~~ YES


~~LEFT -~~ Q PAV'T - ~~RIGHT~~ ON

10' TO LT. EDGE PAVEMENT

S.L.M. 1378+16

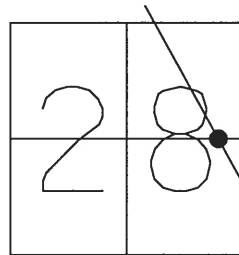

SET PK & WASHER  
8-09-02  
D.C.H.

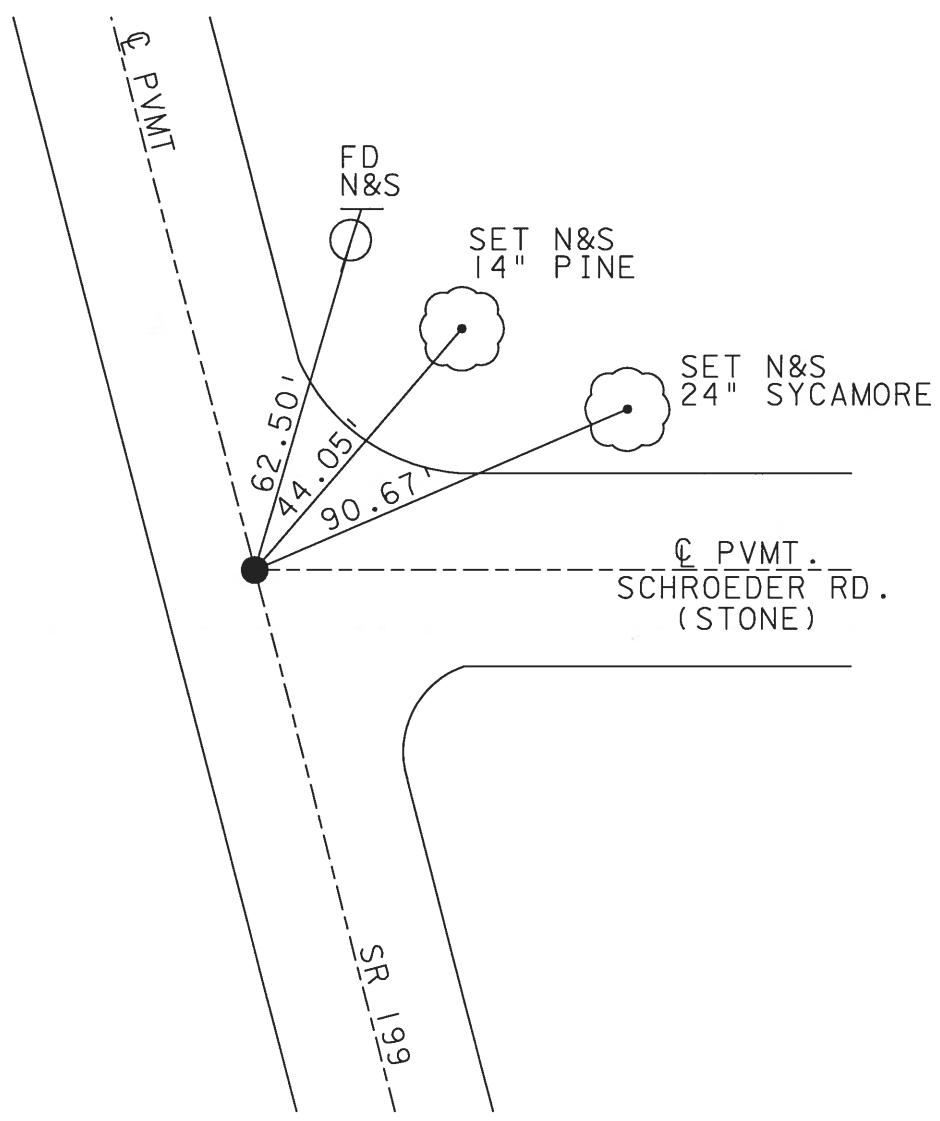

# O.D.O.T. DISTRICT 2 SURVEY OFFICE

PERSONNEL \_\_\_\_\_

REFERENCE NO. 66

SHEET 8 OF 21

NOTES D. CURTIS

H.C. J. HOUSEHOLDER

DATE 9-8-88

ROUTE S.R. #199

R.C. \_\_\_\_\_

WEATHER MILD

COUNTY WOOD

\_\_\_\_\_

TEMP. 70° ±

TOWNSHIP PERRYBURG

\_\_\_\_\_

SECTION 28

T \_\_\_\_\_ R \_\_\_\_\_


TYPE MONUMENT P.K. NAIL IN WASHER

ON SURFACE - BELOW SURFACE


LEFT - ☉ PAV'T. - RIGHT \_\_\_\_\_

\_\_\_\_\_ TO \_\_\_\_\_ EDGE PAVEMENT

S.L.M. 1378 + 16

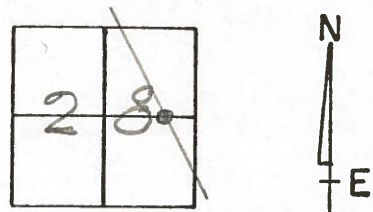

SET P.K. NAIL TO SURFACE  
5-18-90  
DJC.

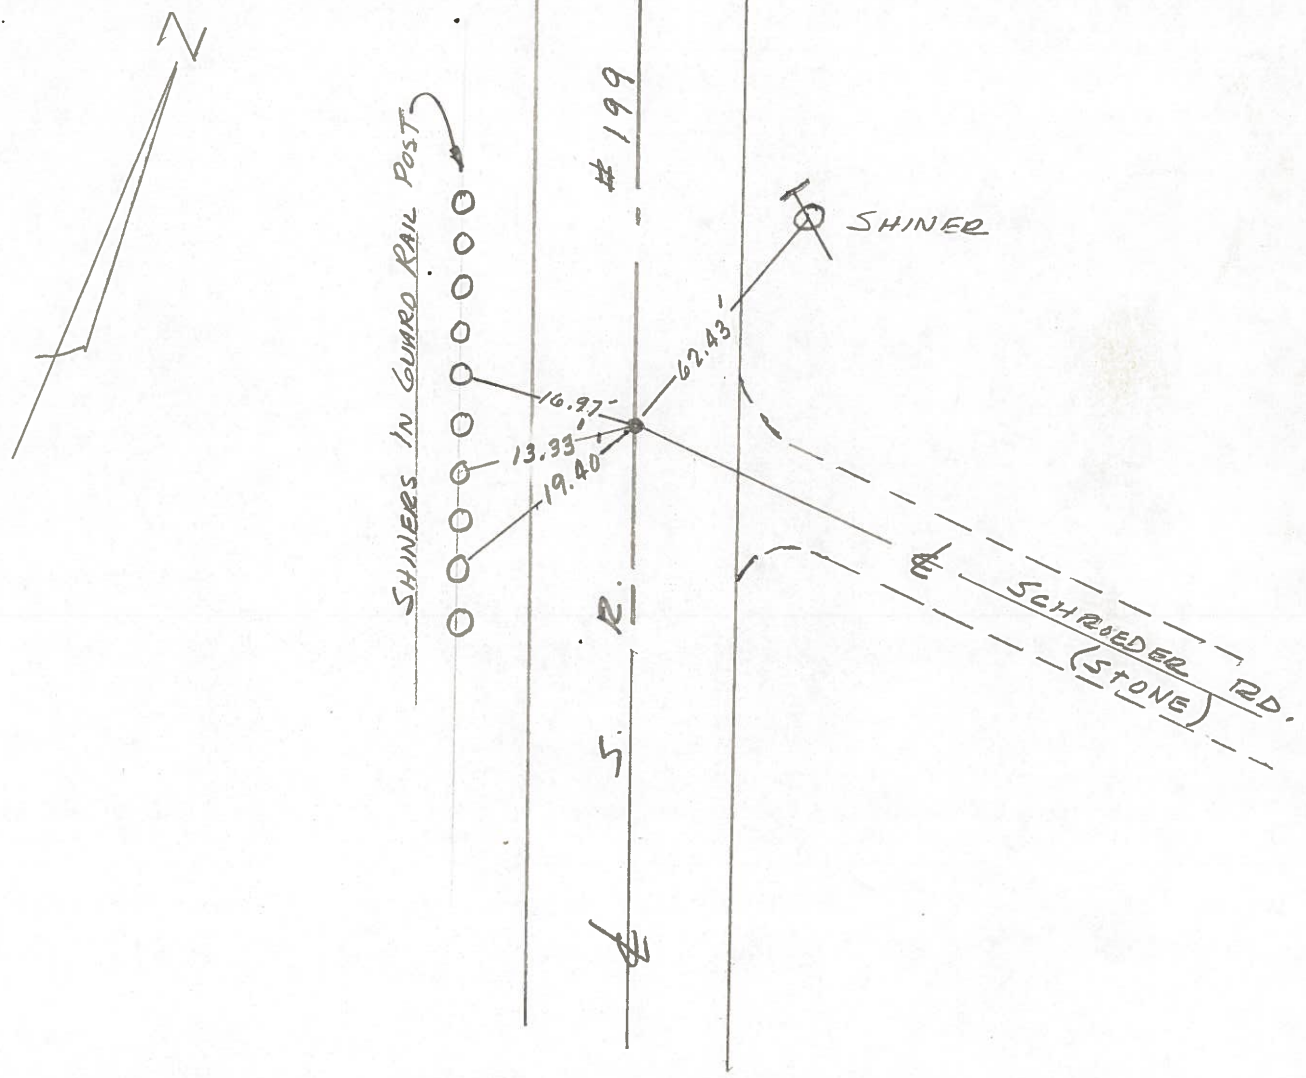

QD.O.T. DISTRICT 2 SURVEY OFFICE

SHEET \_\_\_\_\_ OF \_\_\_\_\_

County WOOD S.R. 199

Date 1-5-83

Township PERRYSBURG

Weather CLOUDY

Section 28

Temp. +36°

T6N, R1E U.S.R.


Personnel HOFFMAN

LOERLE

HOUSEHOLDER

BARNHISEL

#66

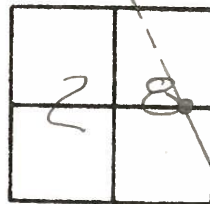

Fd Nail @ surface; ORIGIN UNKNOWN

SLM 1378+10

0.7 LT OF & PAUT SR199  
9.0 TO WIER

SET P.K./WASHER  
7-22-83 M.D.B.

