

O.D.O.T. DISTRICT 2 SURVEY OFFICE (USE ONLY)

PERSONNEL

REFERENCE NO. 66 B

SHEET 59 OF 75

NOTES LEU
 H.C. LEU
 R.C. AUBLE

DATE 4-23-18
 WEATHER SUNNY
 TEMP. 65°

ROUTE SR 199
 COUNTY WOOD
 TOWNSHIP PERRYSBURG
 SECTION 28
 T 6 N R 11 E

DWG BY AUBLE PID 101221

TYPE MONUMENT MAG SHANK

ON SURFACE - ~~BELOW~~ ON

OFFSET Q PAVEMENT 6.9' LT : ~~RT~~

- TO - EDGE PAVEMENT


STATION: 1408+64

HORZ.DATUM: NAD83 (2011)

GEOID: 2012A


GRID: NORTHING: 672483.737

EASTING: 1668802.092

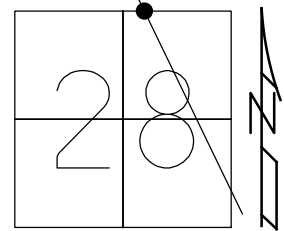

RECORD:
 SET P.K./WASHER
 7/26/02, DCH
 FD SM.R.R.SPIKE
 7/21/11, KPM
 SET MAG/WASHER
 9/9/11, RJL
 REFD67
 12/16/11, MC
 FD MAG SHANK
 REFB66
 4/23/18, JLL
 SET MAG/WASHER
 6-3-19, JLL


DIST.
 67-66B= 4.51'
 66B-66A= 48.21'
 66A-67= 52.73'

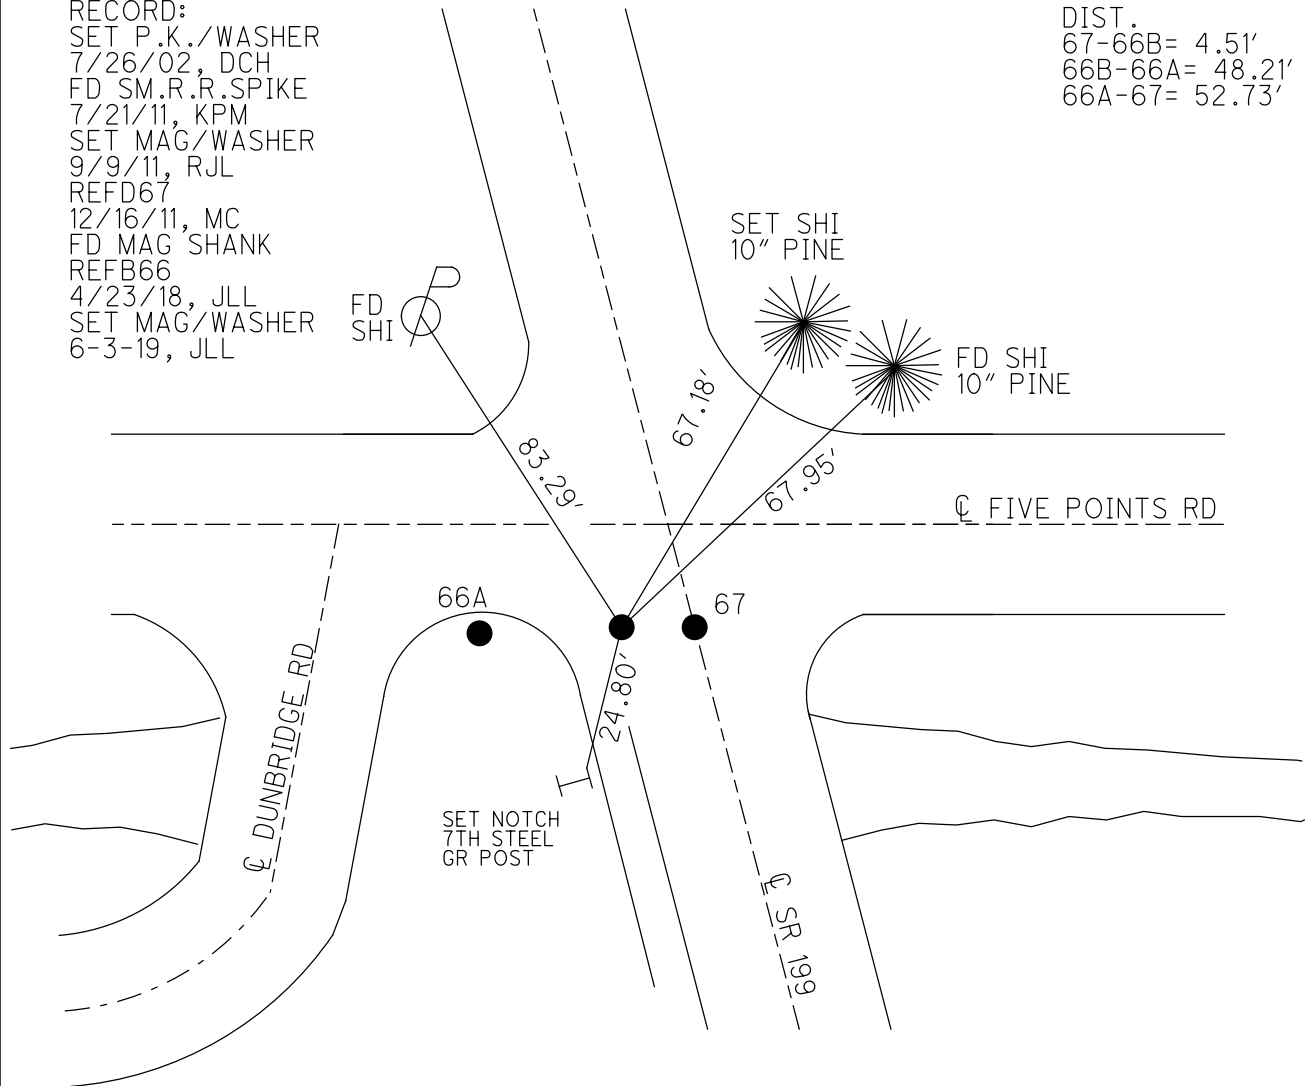

O.D.O.T. DISTRICT 2 SURVEY OFFICE (USE ONLY)

PERSONNEL _____ REFERENCE NO. 66 B SHEET 58 OF 72
 NOTES MOSER DATE 7/21/11 ROUTE SR 199
 H.C. MOSER WEATHER SUNNY COUNTY WOOD
 R.C. HARBAUGH TEMP. 90° TOWNSHIP PERRYSBURG
 _____ SECTION 28
 _____ T 6 N R 11 E

TYPE MONUMENT _____ SM RR SPIKE _____
 ON SURFACE - ~~BELOW~~ _____ ON _____
 LEFT - ~~C PAV'T~~ - RIGHT _____ 6.9' _____
 _____ TO _____ EDGE PAVEMENT _____
 S.L.M. _____ 1408+64 _____

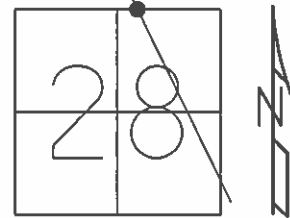


GRID: NORTHING: 672483.700 EASTING: 1668802.057

DISTANCE BETWEEN:
 67-66B: 4.53'
 66B-66A: 48.20'

SET PK/WASHER
 7/26/02, DCH

SET MAG/WASHER
 9/9/11, RJL

FINAL GPS
 REFD67, 12/16/11
 MC

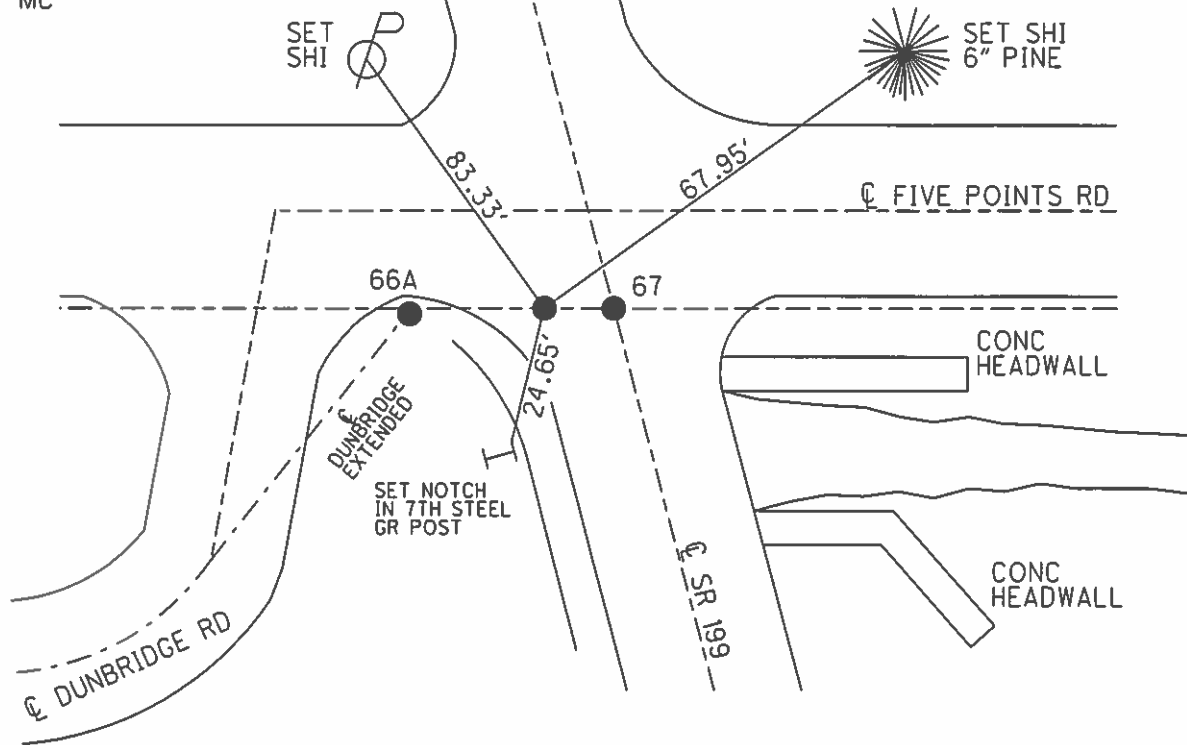

O.D.O.T. DISTRICT 2 SURVEY OFFICE

PERSONNEL

REFERENCE NO. 67


SHEET 36 OF 45

NOTES MOSER
 H.C. HOMAN
 R.C. ROUSOS
 CANTERBURY

DATE 4-6-02
 WEATHER SUNNY
 TEMP. +36°

ROUTE 199
 COUNTY WOOD
 TOWNSHIP PERRYSBURG
 SECTION 28
 T 6 N R 11 E


TYPE MONUMENT SEE BELOW
 ON SURFACE - ~~BELOW~~ YES
 LEFT - ϕ PAV'T - RIGHT SEE BELOW
 TO EDGE PAVEMENT
 S.L.M. 1408+64

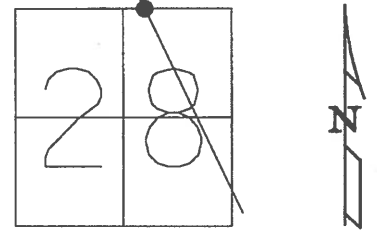

TYPE MONUMENTS:
 PT'S "A" & "B":
 SM RR SPK'S

 PT "C":
 LG RR SPK
 2' S OF S EDGE PVMT
 DISTANCE BETWEEN:
 "A" - "B": 4.53'
 "B" - "C": 48.20'

SET P.K.'S & WASHERS.
 AT PTS. "A" & "B"
 7-26-02 D.C.H.
 PT. "C" IS BENT
 1-12-01 D.C.H.

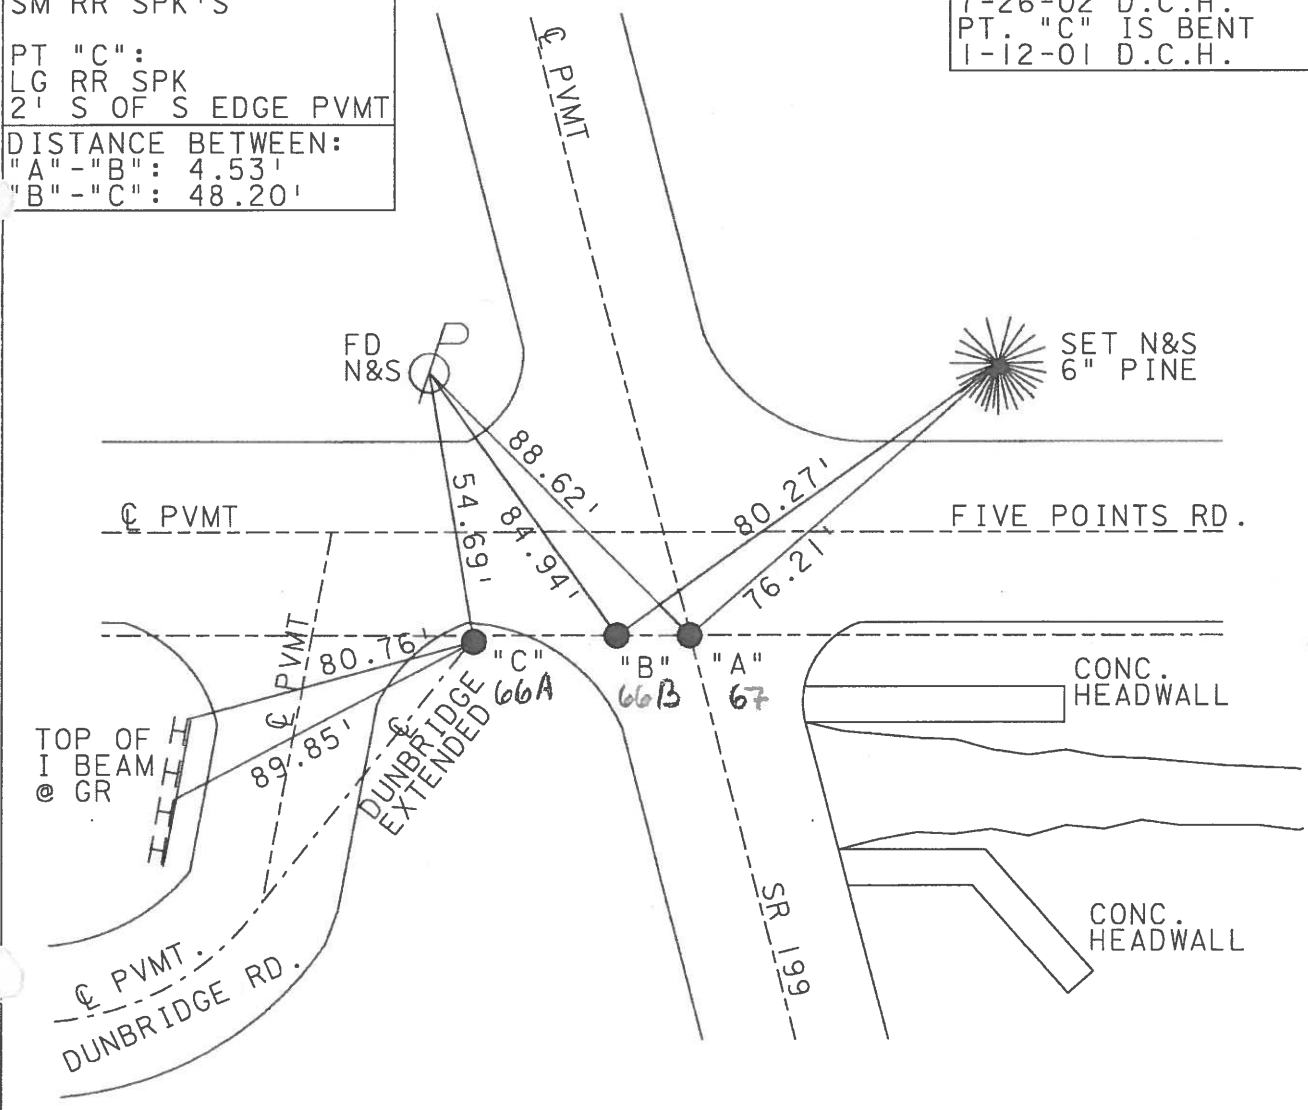

O.D.O.T. DISTRICT 2 SURVEY OFFICE

PERSONNEL _____

REFERENCE NO. 67

SHEET 9 OF 21

NOTES D. CURTIS

H.C. J. HOUSEHOLDER

DATE 9-8-88

ROUTE S.E. #199

R.C. _____

WEATHER MILD

COUNTY WOOD

TEMP. 75^o±

TOWNSHIP PERRYBURG

SECTION 28

T _____ R _____


TYPE MONUMENT Ⓐ & Ⓑ - Sm. R.R. Spks
Ⓒ - 2' S. OF S. EDGE PAVT. - LG. R.R. Spk.

ON SURFACE - BELOW SURFACE


LEFT- & PAVT. - RIGHT _____

TO _____ EDGE PAVEMENT

S.L.M. _____

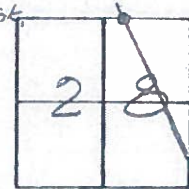

SET SM. R.R. SPKS TO SURFACE
 AT PTS. Ⓐ & Ⓑ
 5-18-90 *DJC.*
 Point B = Ref 68-A

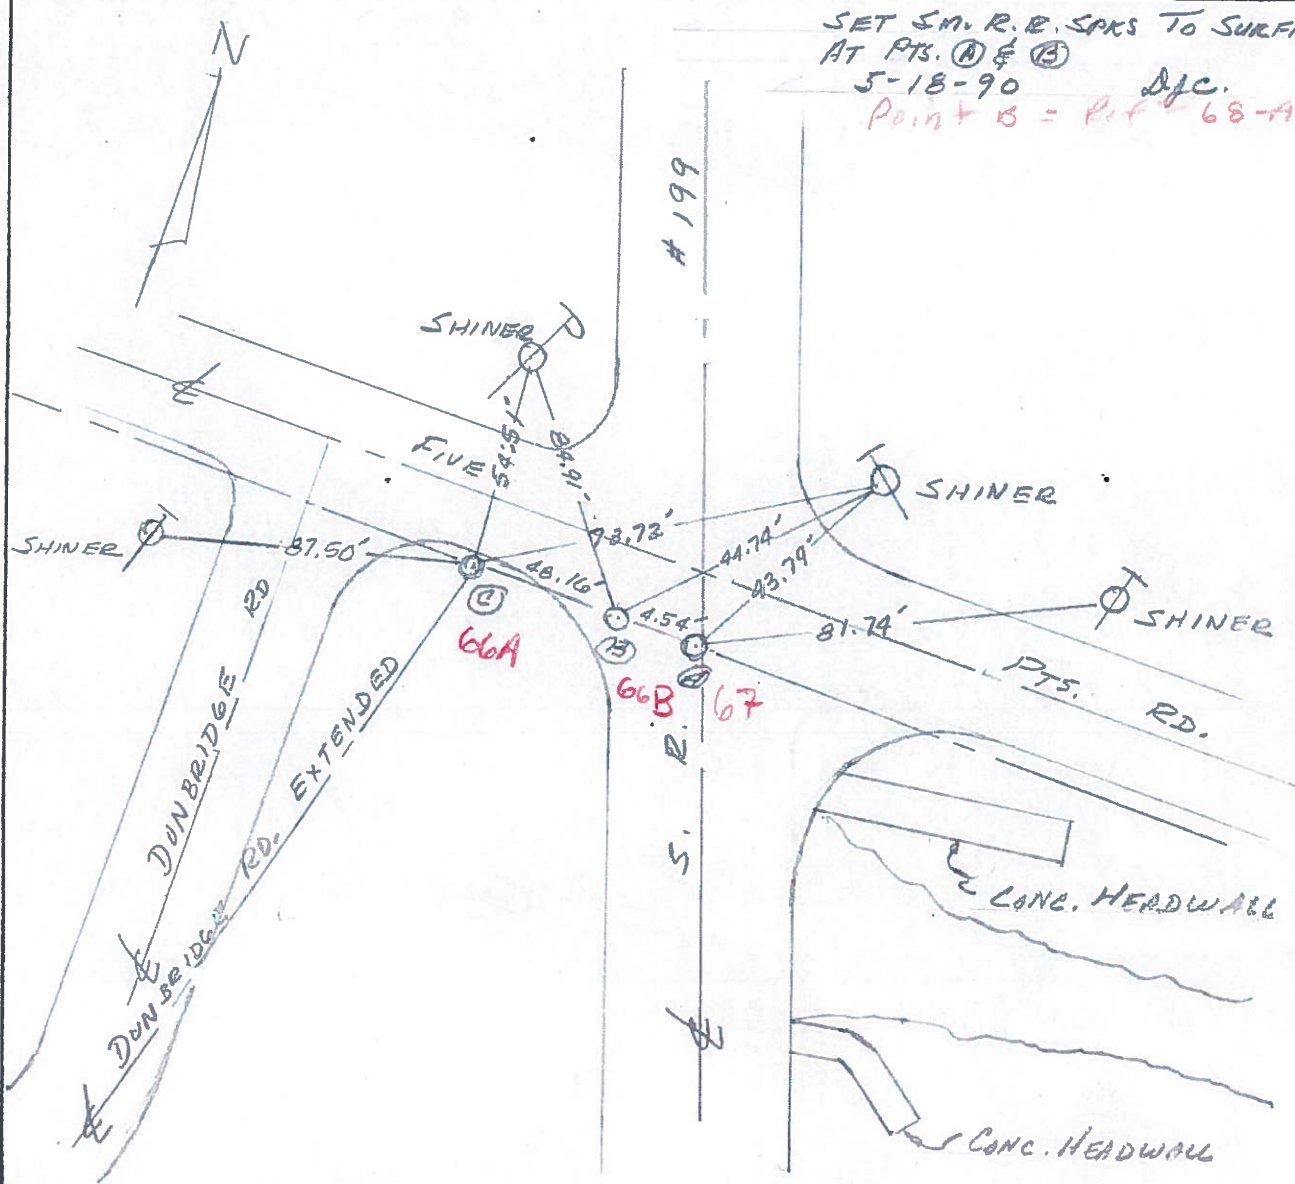

County Wood S.R. 199

Township Perrysburg

Section 28 T-4 U.S.R.S.

T6N, R E

Personnel Hoffman

Loehrke

Barnhisel


68A

67

Date 11-14-84


Weather P. Clear

Temp. 40°

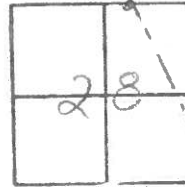

Set Nail & Shiner
8' Lt. of & Paint SR 199

S.L.M. 1407+ 42.50

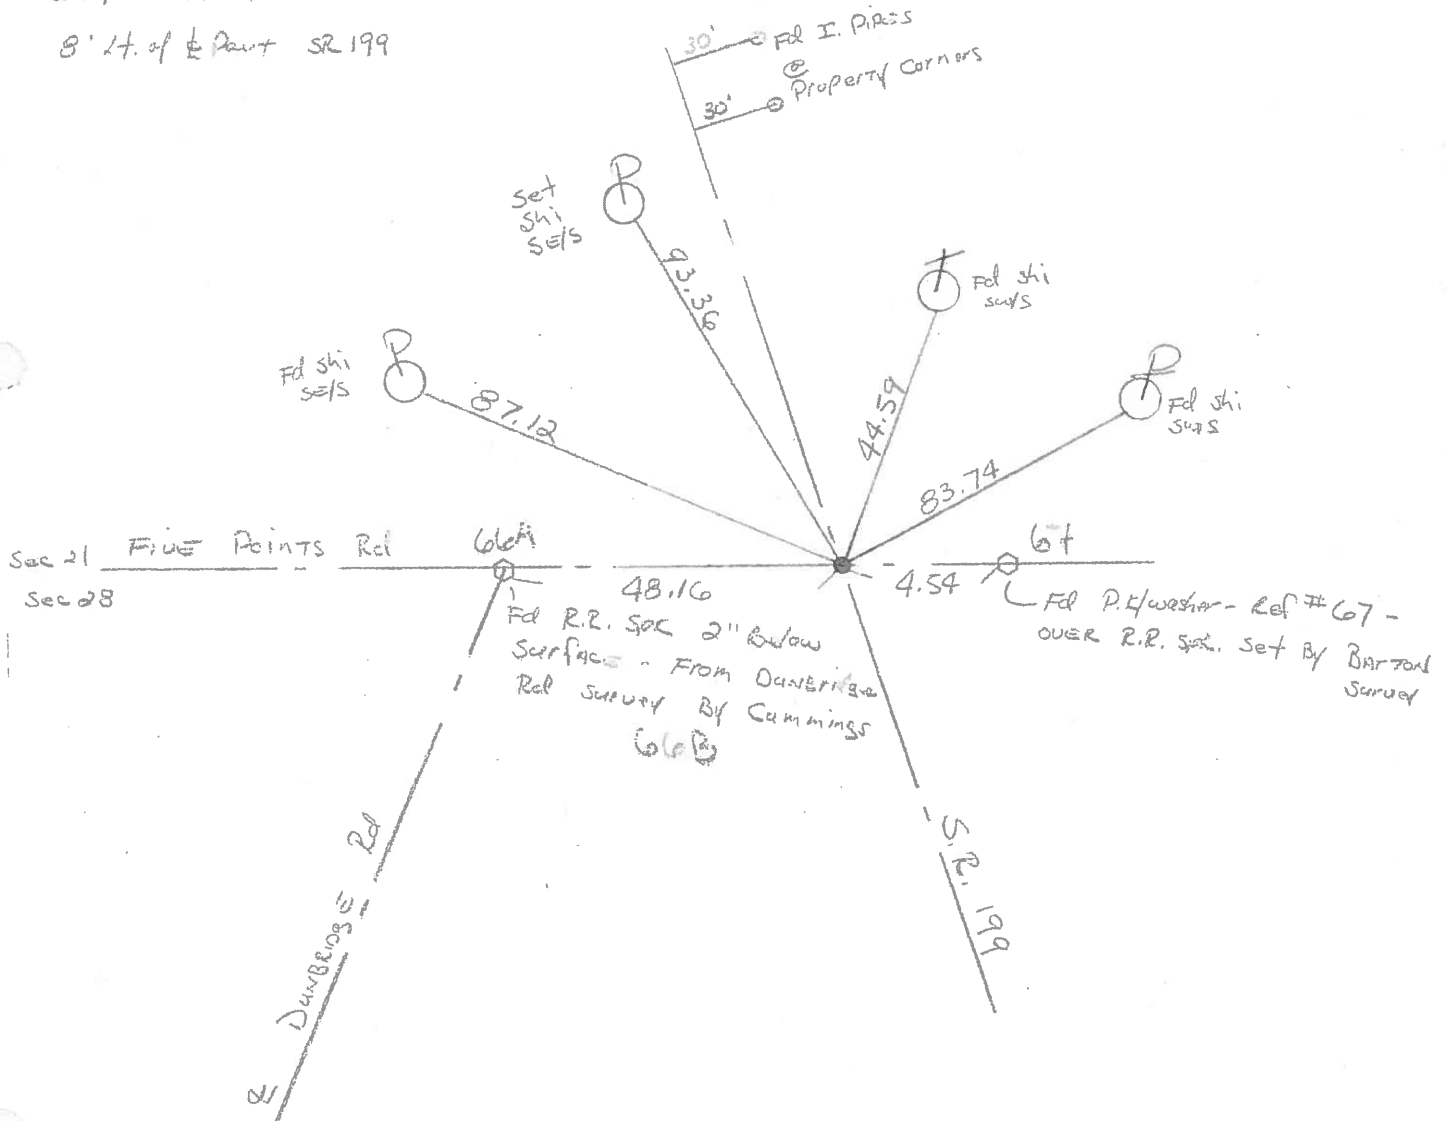

PERSONNEL	TITLE	PERSONNEL	TITLE
Tomsic			
Neuser			
Vanya			
Granata			

COUNTY Wood DATE Feb. 28, 1972

S. R. #199 WEATHER ☁

SEC. _____ TEMP. _____

DESCRIPTION Ref. Mon. JOB NO. _____

