

O.D.O.T. DISTRICT 2 SURVEY OFFICE (USE ONLY)

PERSONNEL

REFERENCE NO. 67

SHEET 60 OF 75

NOTES LEU

DATE 4-23-18

ROUTE SR 199

H.C. LEU

WEATHER SUNNY

COUNTY WOOD

R.C. AUBLE

TEMP. 65°

TOWNSHIP PERRYSBURG

SECTION 28

DWG BY AUBLE PID 101221

T 6 N R 11 E

TYPE MONUMENT MAG/WASHER

ON SURFACE - ~~BELOW~~ ON

OFFSET \odot PAVEMENT 2.7' LT : ~~RT~~

- TO - EDGE PAVEMENT


STATION: 1408+64

HORIZ.DATUM: NAD83 (2011)

GEOID: 2012A


GRID: NORTHING: 672483.603

EASTING: 1668806.582

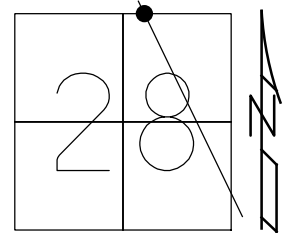

RECORD:
 SET P.K./WASHER
 7/26/02, DCH
 FD SM.R.R.SPIKE
 7/21/11, KPM
 SET MAG/WASHER
 9/9/11, RJL
 REFD67
 12/16/11, MC
 FD MAG/WASHER
 REF67
 4/23/18
 6-3-19, JLL

DIST.
 67-66B= 4.51'
 66B-66A= 48.21'
 66A-67= 52.73'

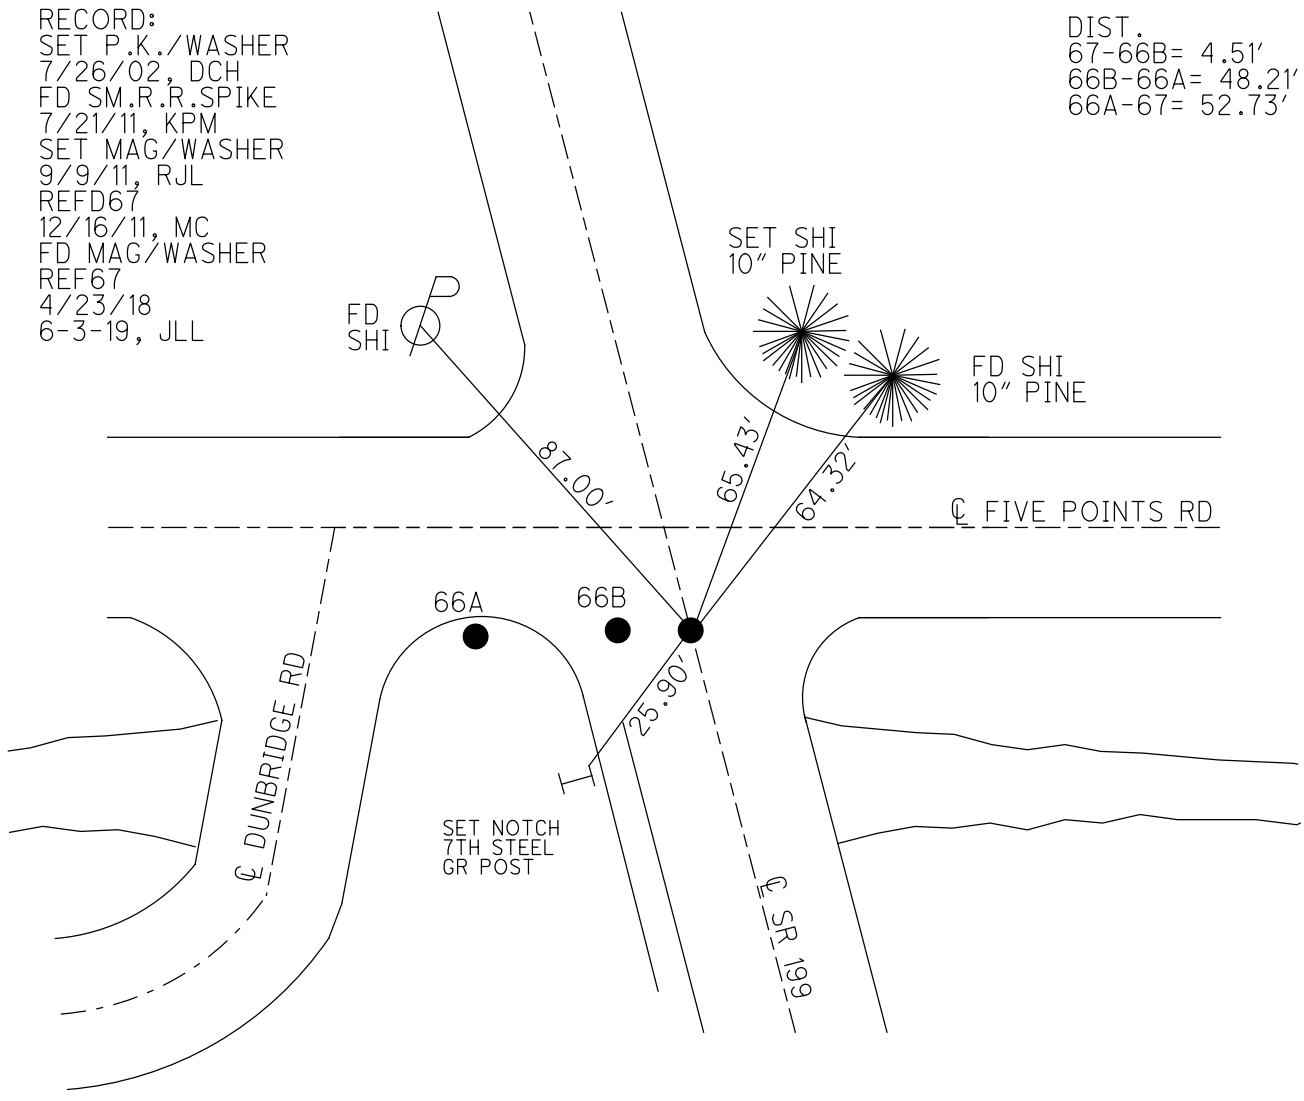


O.D.O.T. DISTRICT 2 SURVEY OFFICE (USE ONLY)

PERSONNEL _____ REFERENCE NO. 67 SHEET 59 OF 72

NOTES MOSER DATE 7/21/11 ROUTE SR 199
 H.C. MOSER WEATHER SUNNY COUNTY WOOD
 R.C. HARBAUGH TEMP. 90° TOWNSHIP PERRYSBURG
 _____ SECTION 28
 _____ T 6 N R 11 E

TYPE MONUMENT _____ SM RR SPIKE _____
 ON SURFACE - ~~BELOW~~ _____ ON _____
 LEFT - ~~PAV'T~~ - RIGHT 2.7'
 _____ TO _____ EDGE PAVEMENT
 S.L.M. 1408+64

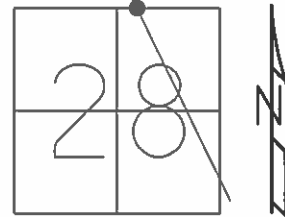


GRID: NORTHING: 672483.597 EASTING: 1668806.555

DISTANCE BETWEEN:
 67-66B: 4.53'
 66B-66A: 48.20'

SET PK/WASHER
 7/26/02, DCH

SET MAG/WASHER
 9/9/11, RJL

FINAL GPS
 REF67, 12/16/11
 MC

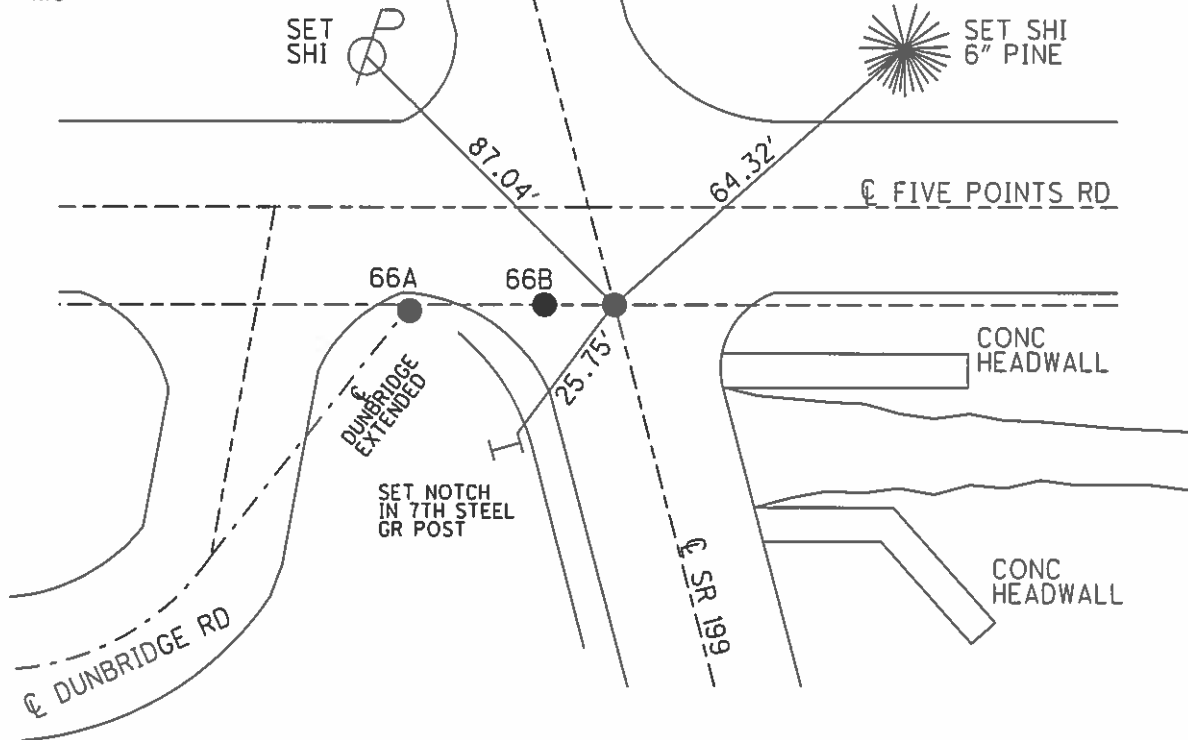

O.D.O.T. DISTRICT 2 SURVEY OFFICE

PERSONNEL

REFERENCE NO. 67


SHEET 30 OF 45

NOTES _____ MOSER _____
 H.C. _____ HOMAN _____
 R.C. _____ ROUSOS _____
 _____ CANTERBURY _____

DATE 4-6-02
 WEATHER SUNNY
 TEMP. +36°

ROUTE 199
 COUNTY WOOD
 TOWNSHIP PERRYSBURG
 SECTION 28
T 6 N R 11 E


TYPE MONUMENT _____ SEE BELOW
 ON SURFACE - ~~BELOW~~ _____ YES
 LEFT - ☉ PAV'T - RIGHT _____ SEE BELOW
 _____ TO _____ EDGE PAVEMENT
 S.L.M. _____ 1408+64

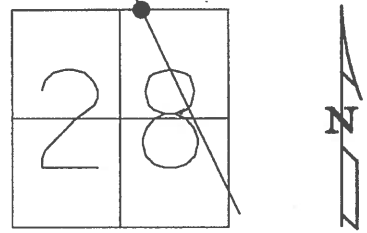

TYPE MONUMENTS:
 PT'S "A" & "B":
 SM RR SPK'S

 PT "C":
 LG RR SPK
 2' S OF S EDGE PVMT
 DISTANCE BETWEEN:
 "A"-"B": 4.53'
 "B"-"C": 48.20'

SET P.K.'S & WASHERS
 AT PTS. "A" & "B"
 7-26-02 D.C.H.
 PT. "C" IS BENT
 1-12-01 D.C.H.

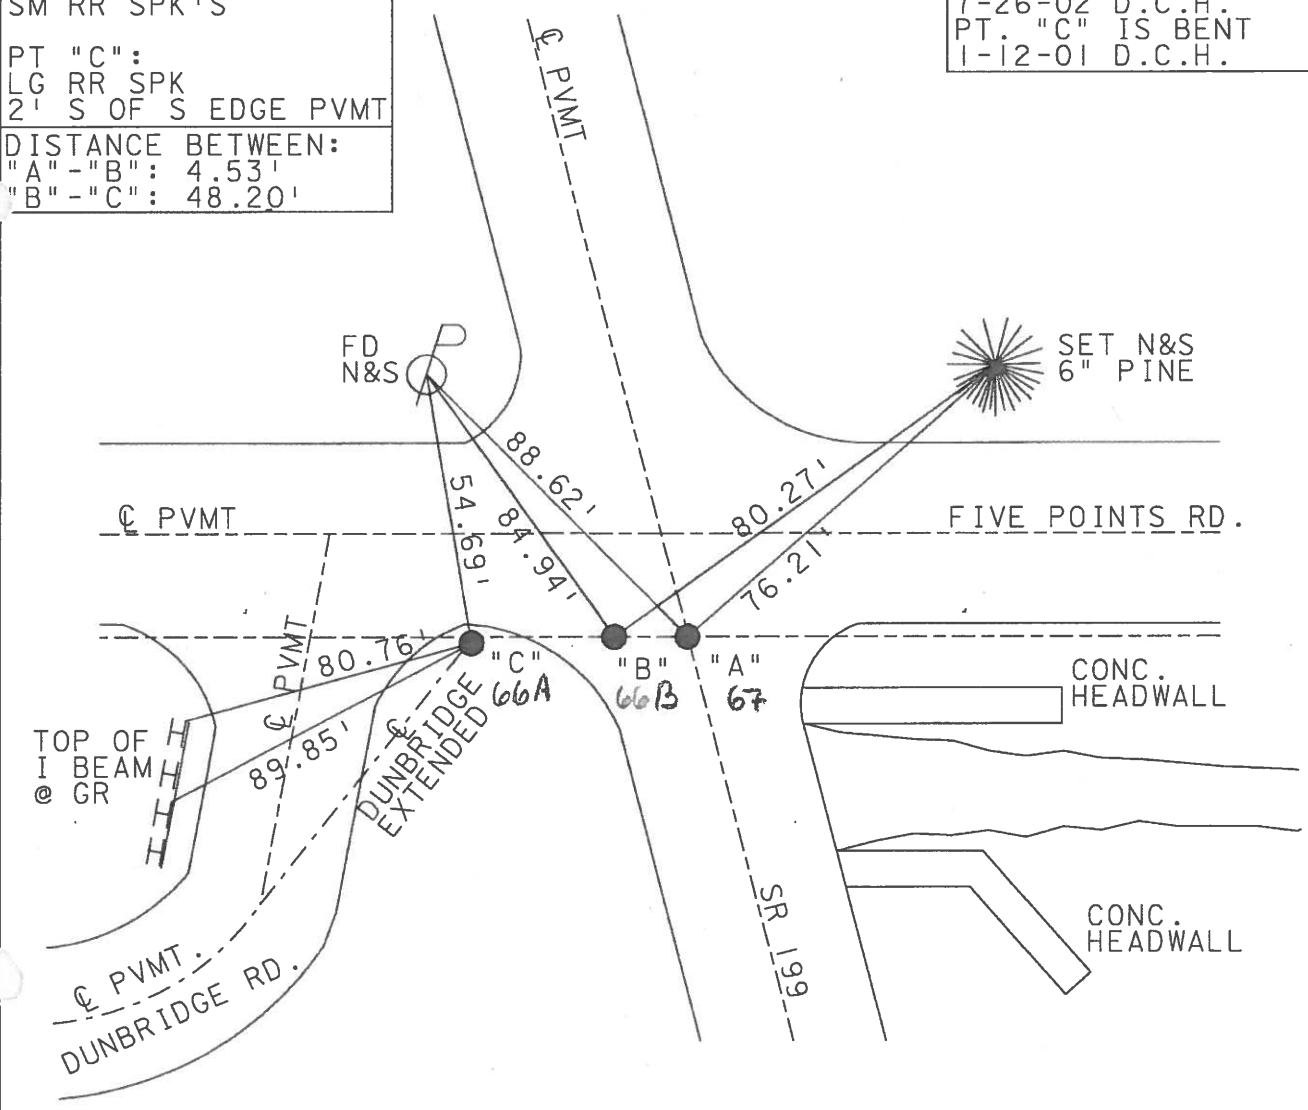

O.D.O.T. DISTRICT 2 SURVEY OFFICE

PERSONNEL _____

REFERENCE NO. 67

SHEET 9 OF 21

NOTES D. CURTIS

H.C. J. HOUSEHOLDER

DATE 9-8-88

ROUTE S.E. #199

R.C. _____

WEATHER MILD

COUNTY WOOD

TEMP. 75°±

TOWNSHIP PERRYBURG

SECTION 28

T _____ R _____


TYPE MONUMENT Ⓐ & Ⓑ - Sm. R.R. Spks
Ⓒ - 2' S. OF S. EDGE PAVT. - LG. R.R. Spk

ON SURFACE - BELOW SURFACE


LEFT- & PAVT. - RIGHT _____

_____ TO _____ EDGE PAVEMENT

S.L.M. _____

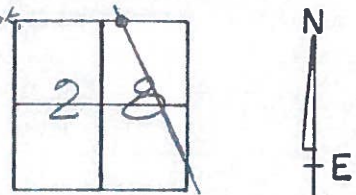

SET SM. R.R. SPKS TO SURFACE
 AT PTS. Ⓐ & Ⓑ
 5-18-90 DJC.
 Point B = P.F. 68-A

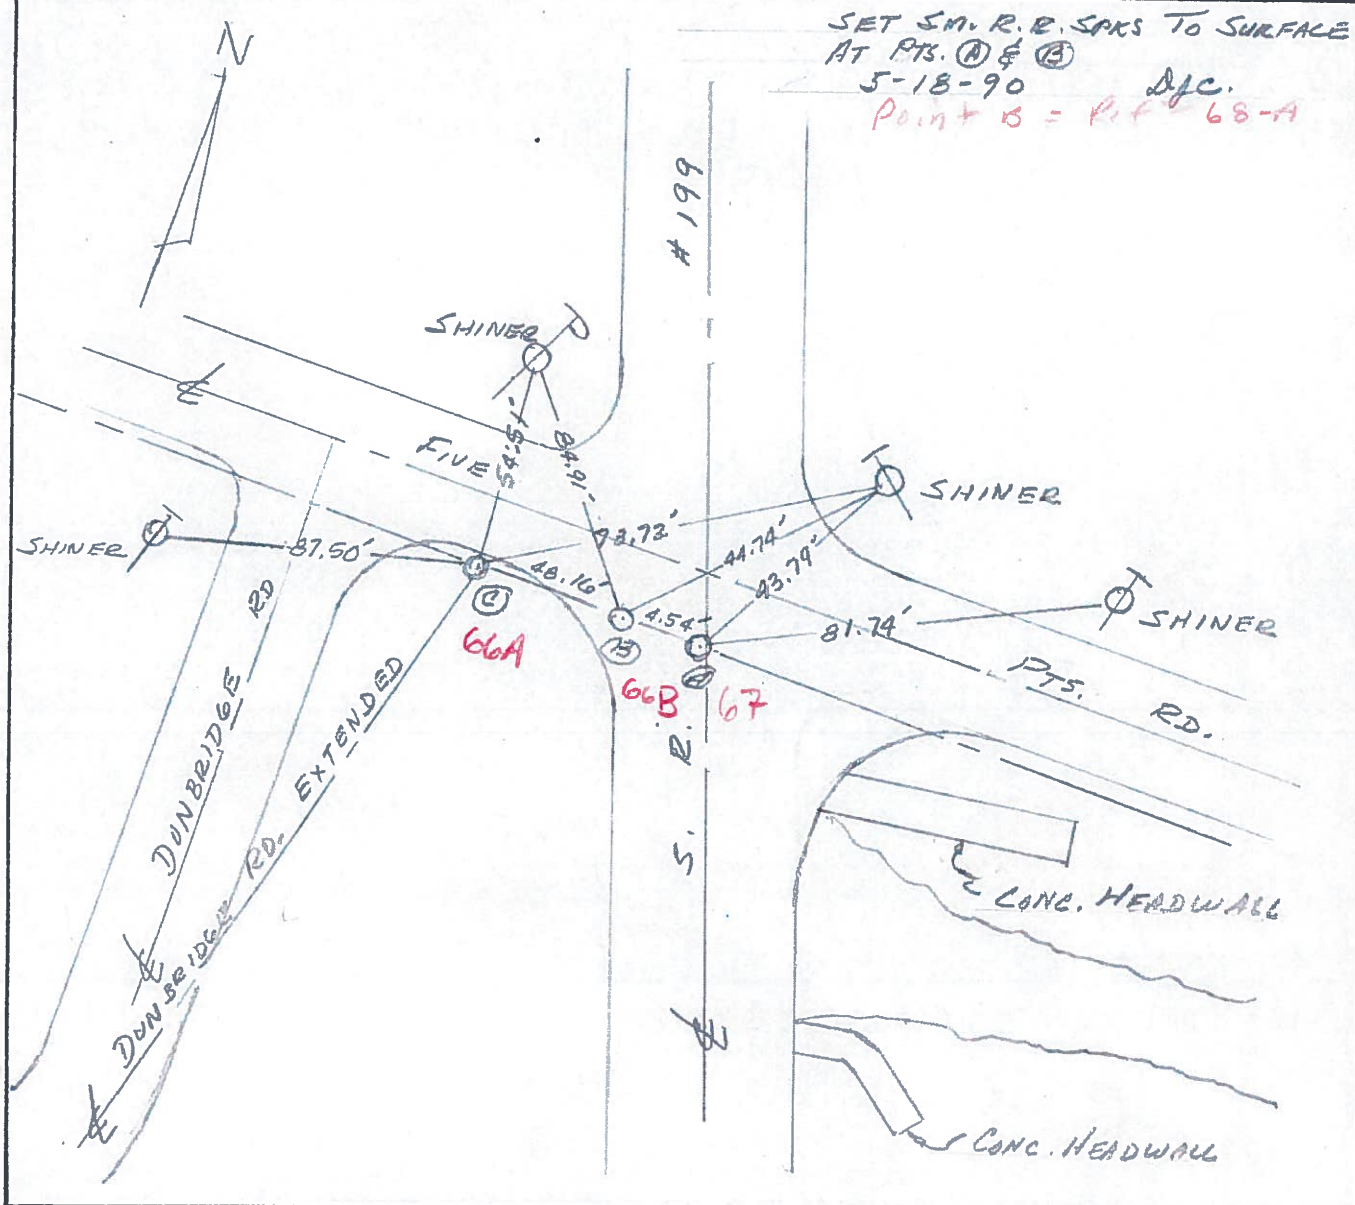

County Wood S.R. 199

Township Perrysburg

Section 28 T-4 U.S.R.S.

T6N, R_E

Personnel Hoffman

Lostrick

Barnhisel


68A

67

Date 11-14-84


Weather P. Clear

Temp. 40°

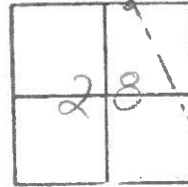

Set Nail & Shiner
8' Lt. of E Part SR 199

S.L.M. 1407+ 42.50

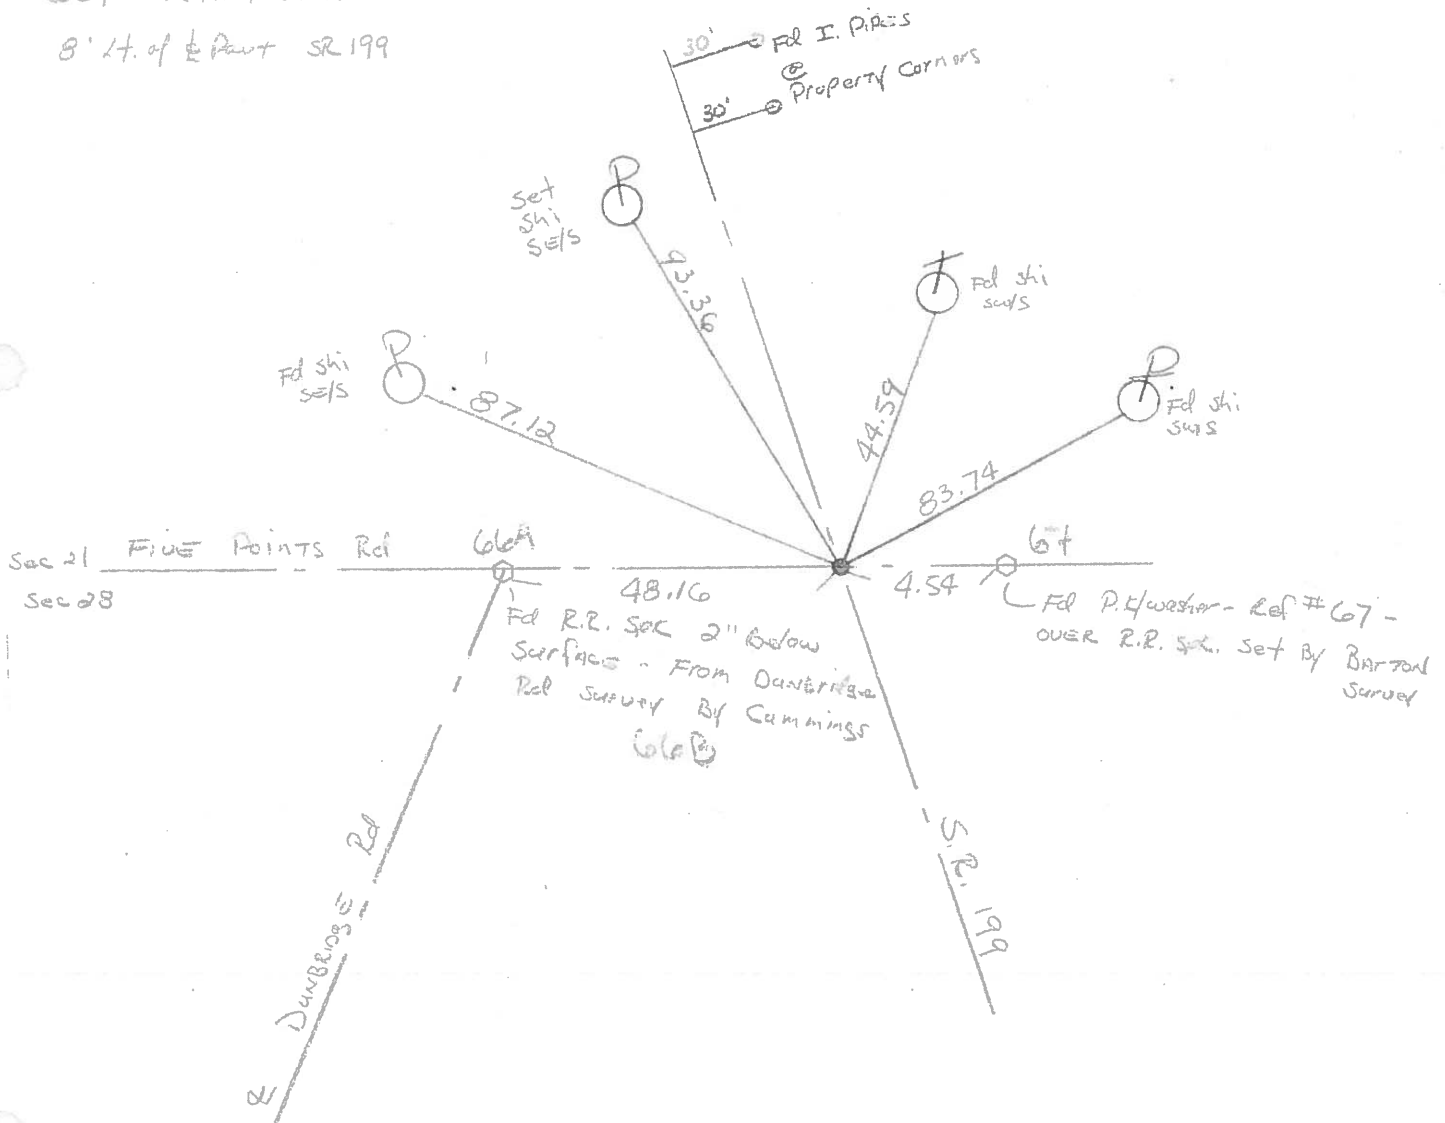

Q.D.O.T. DISTRICT 2 SURVEY OFFICE

SHEET _____ OF _____

County Wood S.R. 199

Date 1-5-83

Township Perrysburg

Weather Cloudy


Section 28-21

Temp. +36°

T6N, RE U.S.R.

Personnel HOFFMAN
LOEMKE
HOUSEHOLDER
BARNHISEL

#67

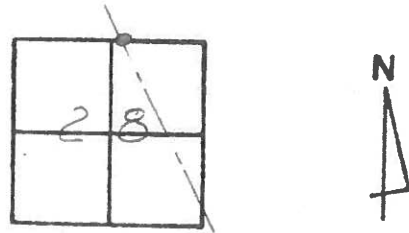

Fd R.R. SPK @ SURFACE
 3.8' LT. of & PAUT SR 199
 12.5' South of & PAUT 5 POINTS Rd.

SLM 1408+46

