

O.D.O.T. DISTRICT 2 SURVEY OFFICE (USE ONLY)

PERSONNEL

REFERENCE NO. 68

SHEET 64 OF 75

NOTES AUBLE

DATE 4-23-18

ROUTE SR 199

H.C. LEU

WEATHER SUNNY

COUNTY WOOD

R.C. AUBLE

TEMP. 68°

TOWNSHIP PERRYSBURG

DWG BY AUBLE PID 101221

SECTION 21

T 6 N R 11 E

TYPE MONUMENT MAG/WASHER

~~ON SURFACE~~ - BELOW 1.5"

OFFSET C PAVEMENT ON ~~LT~~ : ~~RT~~

6.2' TO LT EDGE PAVEMENT



STATION: 1438+50

HORZ.DATUM: NAD83 (2011)

GEOID: 2012A

GRID: NORTHING: 675159.468

EASTING: 1667453.176

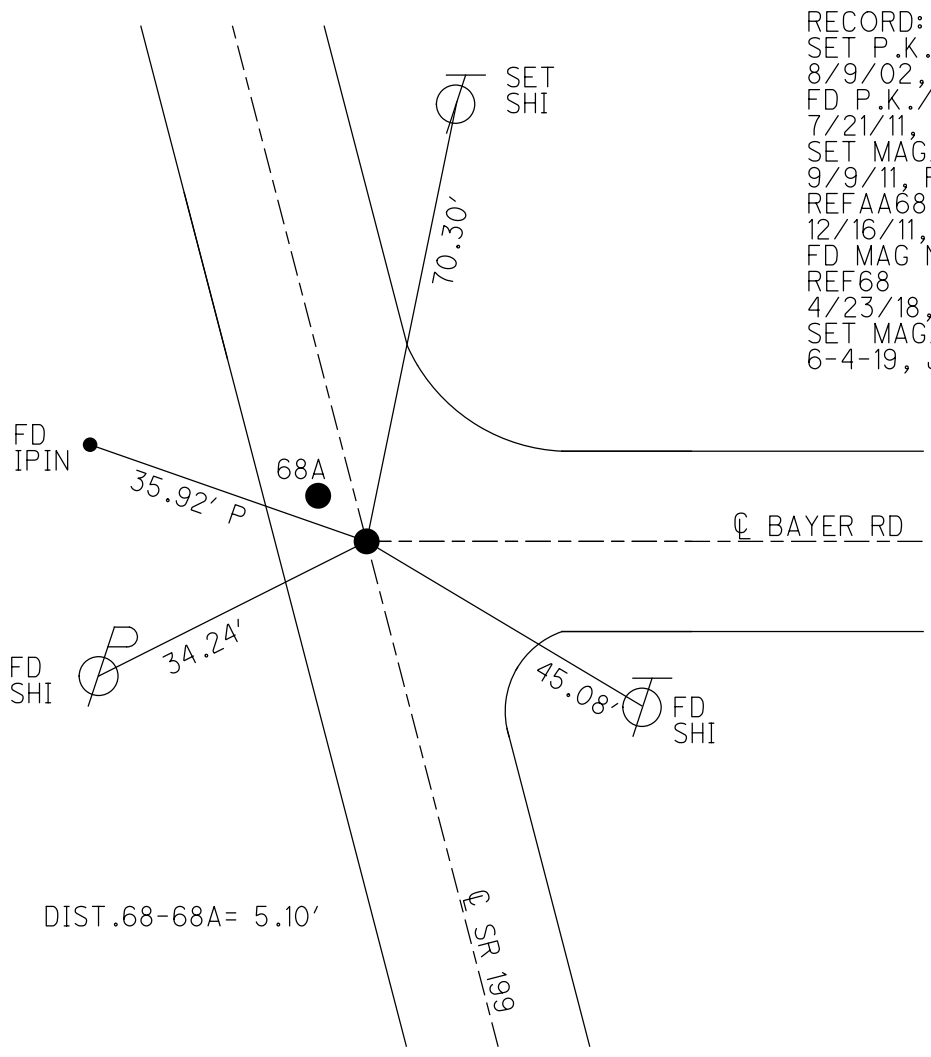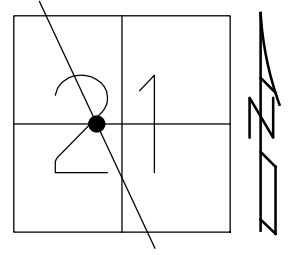


RECORD:
 SET P.K./WASHER
 8/9/02, DCH
 FD P.K./WASHER
 7/21/11, KPM
 SET MAG/WASHER
 9/9/11, RJL
 REFAA68
 12/16/11, MC
 FD MAG NAIL
 REF68
 4/23/18, JLL
 SET MAG/WASHER
 6-4-19, JLL


O.D.O.T. DISTRICT 2 SURVEY OFFICE (USE ONLY)

PERSONNEL _____ REFERENCE NO. 68 SHEET 63 OF 72
 NOTES MOSE DATE 7/21/11 ROUTE SR 199
 H.C. MOSE WEATHER SUNNY COUNTY WOOD
 R.C. HARBAUGH TEMP. 85° TOWNSHIP PERRYSBURG
 SECTION 28
T 6 N R 11 E

TYPE MONUMENT _____ PK/WASHER _____
 ON SURFACE - ~~BELOW~~ _____ ON _____
~~LEFT~~ - ☉ PAV'T - ~~RIGHT~~ _____ ON _____
9.7' TO LT EDGE PAVEMENT
 S.L.M. _____ 1438+50

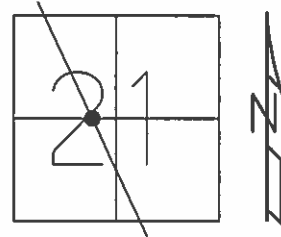

GRID: NORTHING: 675159.443 EASTING: 1667453.100

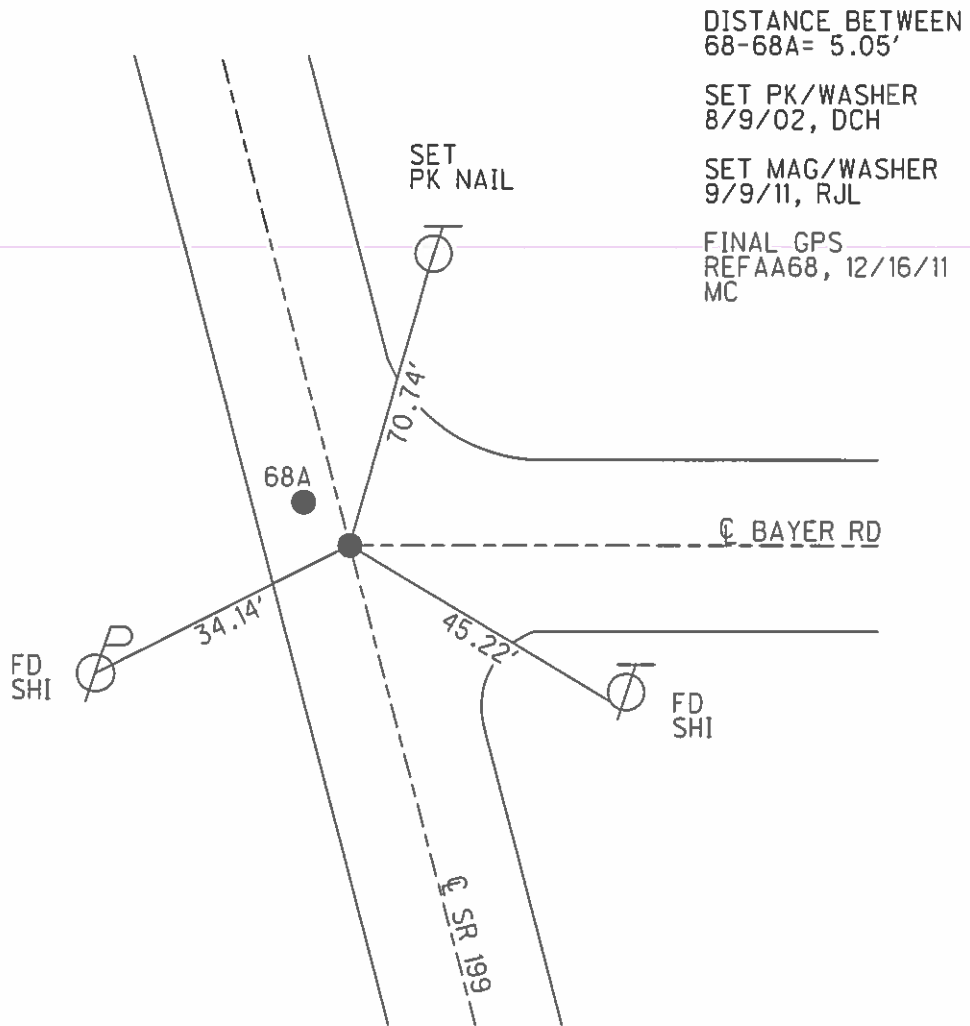

O.D.O.T. DISTRICT 2 SURVEY OFFICE

PERSONNEL

REFERENCE NO. 68

SHEET 40 OF 45

NOTES MOSER

DATE 4-6-02

ROUTE 199

H.C. HOMAN

WEATHER SUNNY

COUNTY WOOD

R.C. ROUSOS

TEMP. +36°

TOWNSHIP PERRYSBURG

 CANTERBURY

SECTION 28

T 6 N R 11 E


TYPE MONUMENT PK'S & WASHERS

ON SURFACE - ~~BELOW~~ YES


LEFT - PAV'T - RIGHT "A" ON C'S

 TO EDGE PAVEMENT

S.L.M. "A" 1438+50, "B" 1438+54

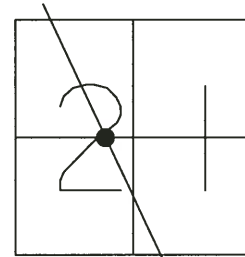

SET MAG NAILS
& WASHERS
8-09-02
D.C.H.

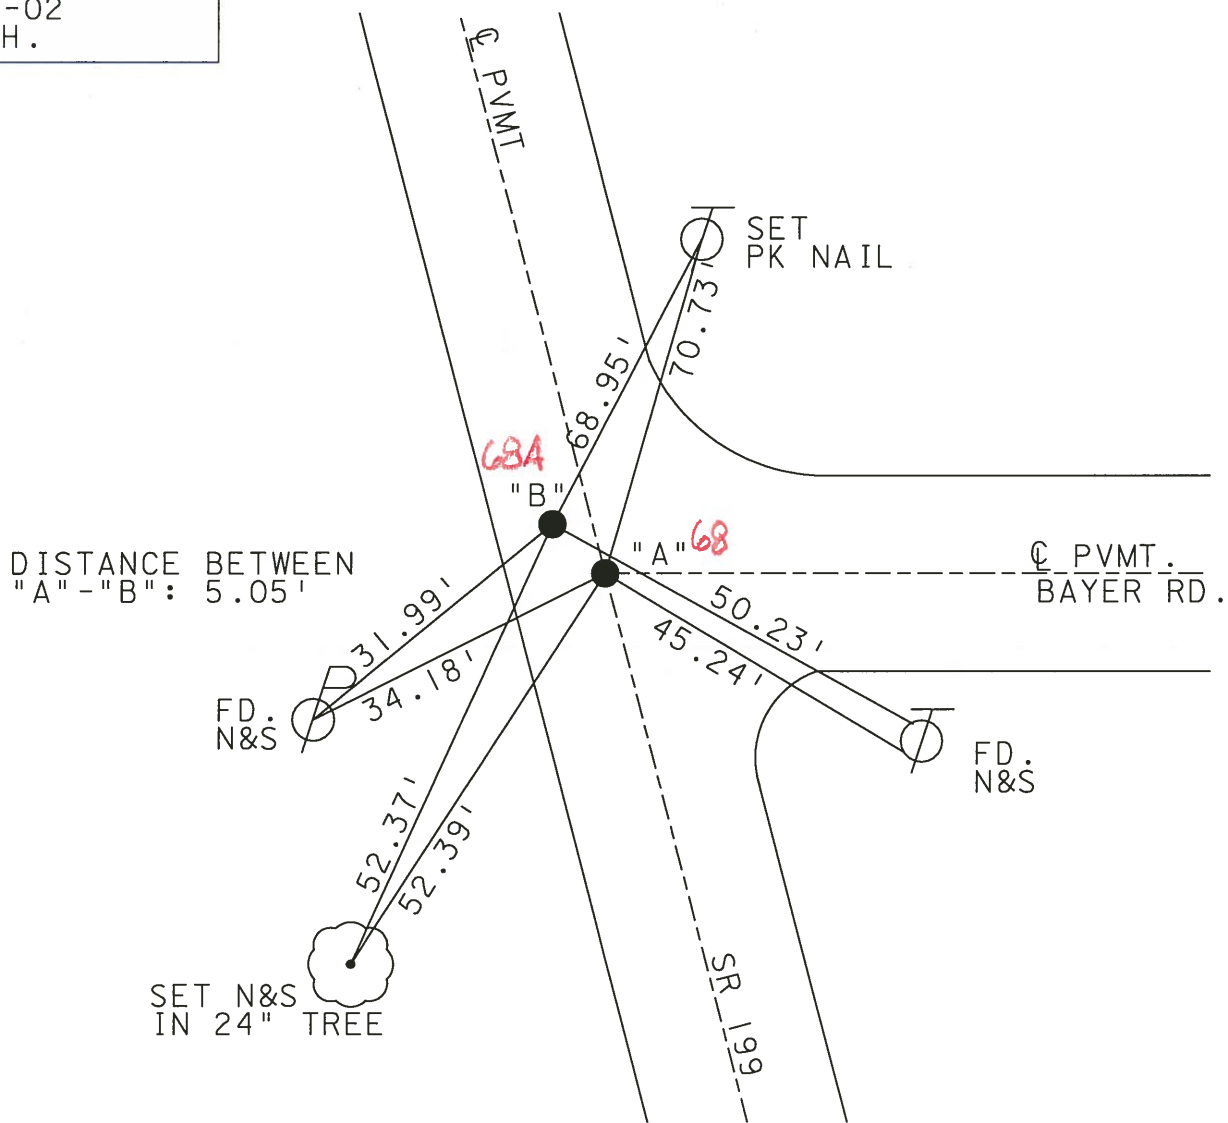

O.D.O.T. DISTRICT 2 SURVEY OFFICE

PERSONNEL _____

REFERENCE NO. 68

SHEET 13 OF 21

NOTES D. CURTIS

H.C. J. HOUSEHOLDER

DATE 9-8-88

ROUTE S.R. #199

R.C. _____

WEATHER MILD

COUNTY WOOD

TEMP. 75°±

TOWNSHIP PERRYSBURG

SECTION 21

T _____ R _____


TYPE MONUMENT P.K. NAILS IN WASHERS

ON SURFACE - BELOW SURFACE

LEFT- & PAV'T. - RIGHT _____



TO _____ EDGE PAVEMENT

S.L.M. Ⓐ 1438+50, Ⓑ 1438+54

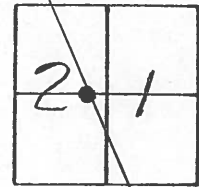

SET P.K. NAILS TO SURFACE AT
PTS. Ⓐ & Ⓑ

5-18-90 D/C.

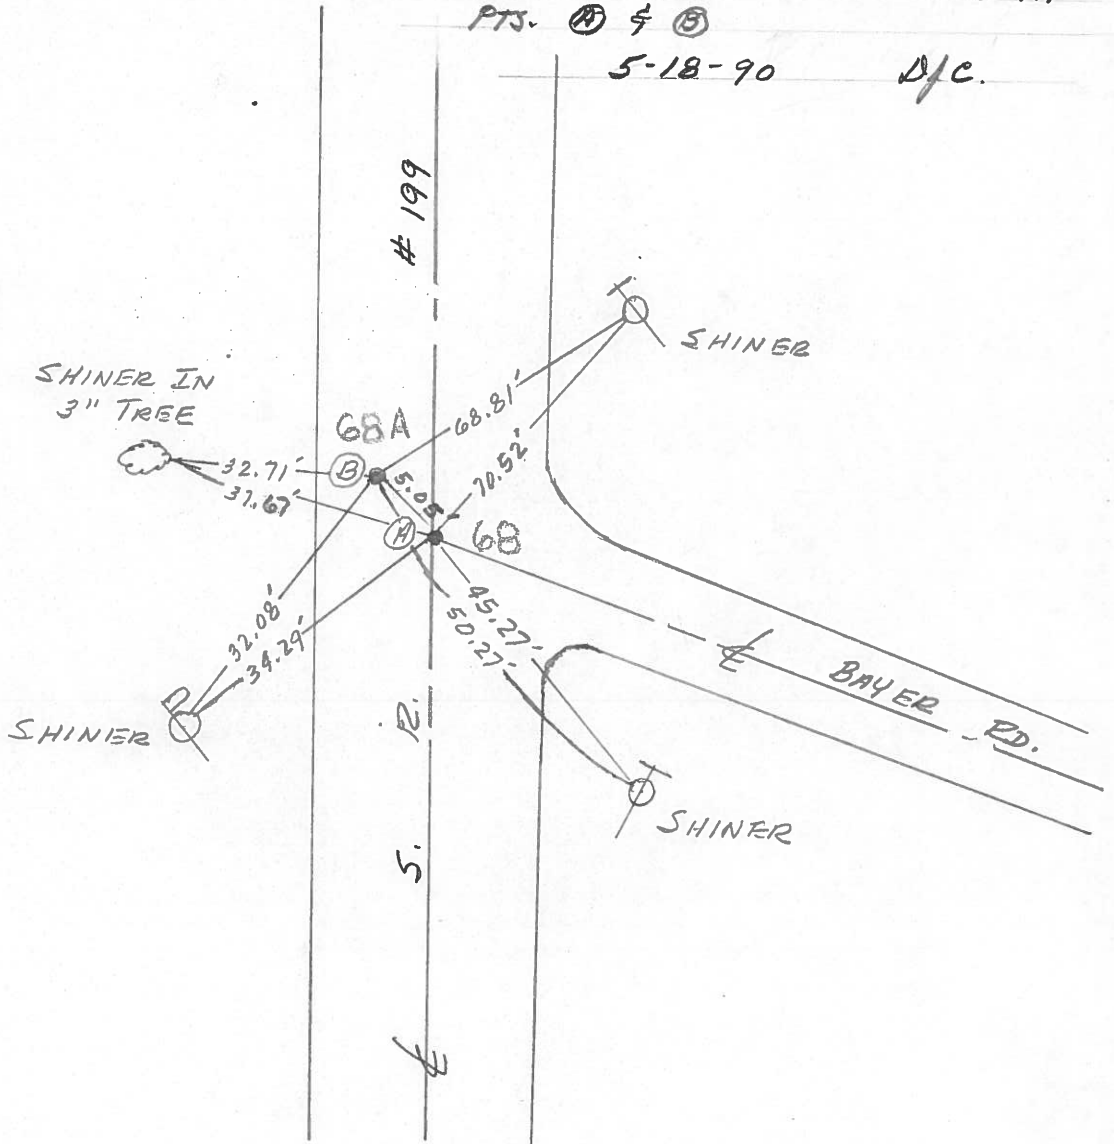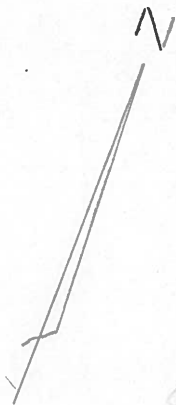

QD.O.T. DISTRICT 2 SURVEY OFFICE

SHEET _____ OF _____

County Wood S.R. 199

Date 1-5-83

Township PERRYBURG

Weather Cloudy

Section 21

Temp. +36°

T6N, RESR


Personnel HOFFMAN

LOEHRKE

HOUSEHOLDER

BARNHISEL

#68

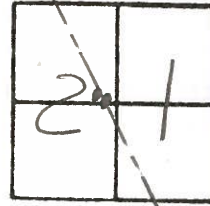


PT "A" Fd P.K. 1" Below surface
ON & PAUT SR199 & BAYER Rd.

S.L.M. 1438+45

Record: 126+81.5
P.I. STA.

SET P.K./WASHER
@ BOTH POINTS
7-22-83 M.D.B.

Set shi
E/S 3"

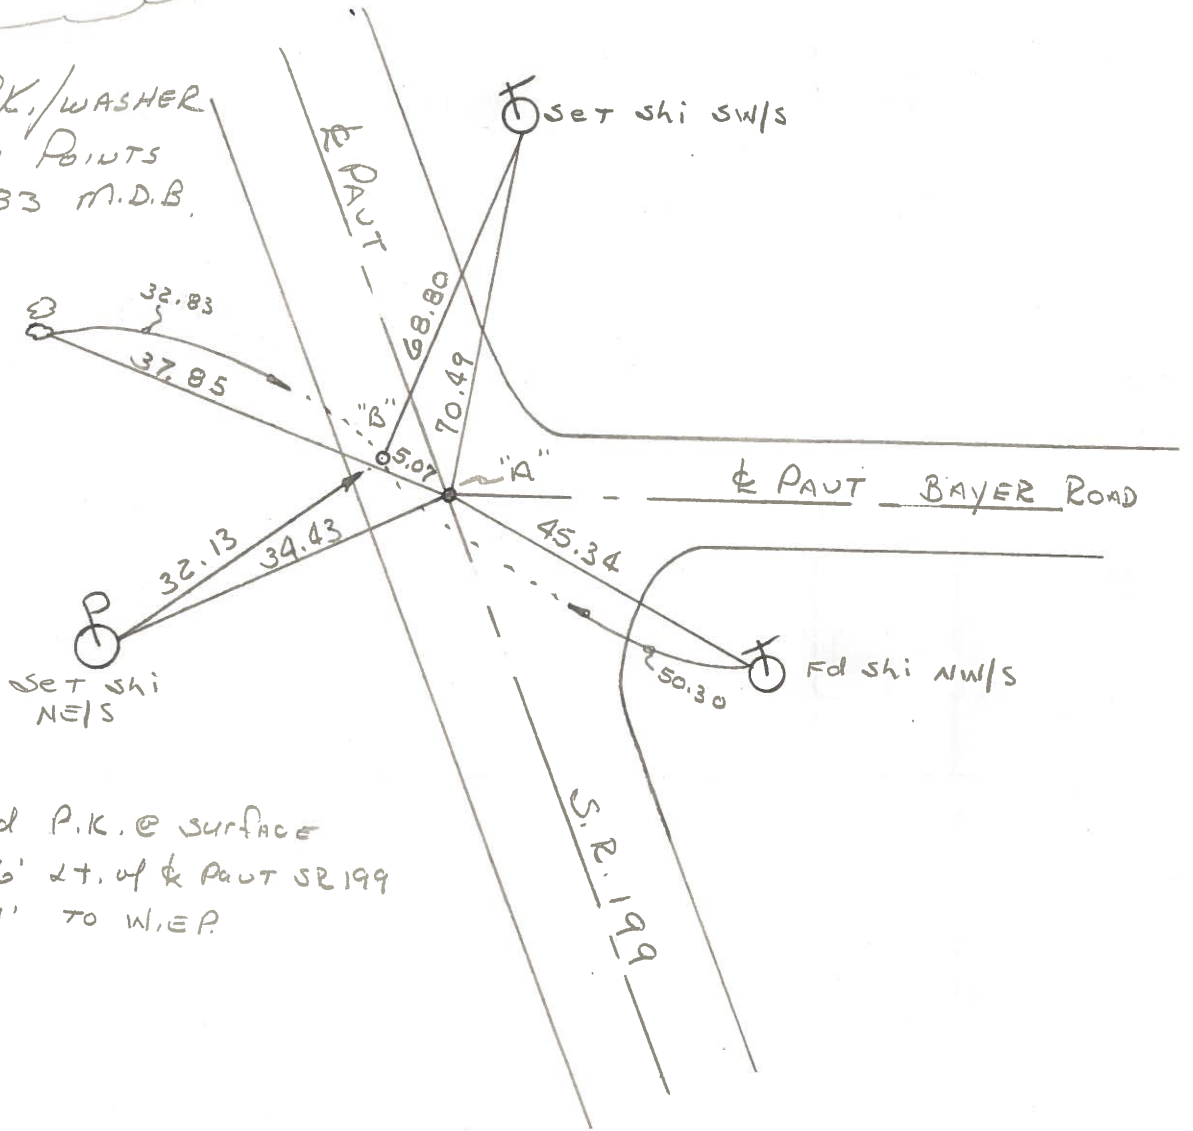

PT. "B" Fd P.K. @ surface
3.6' Lt. of & PAUT SR199
5.9' TO W.I.P.

68A

OD.O.T. DISTRICT 2 SURVEY OFFICE

SHEET _____ OF _____

County WOOD S.R. 199

Date SEPT. 23 - 1971

Township PERRYSBURG

Weather _____

Section 21

Temp. _____


T N, R E

Personnel TOMJIC
NEUSER
VANYO
GRANATA
CURTIS

17	16
20	21



68

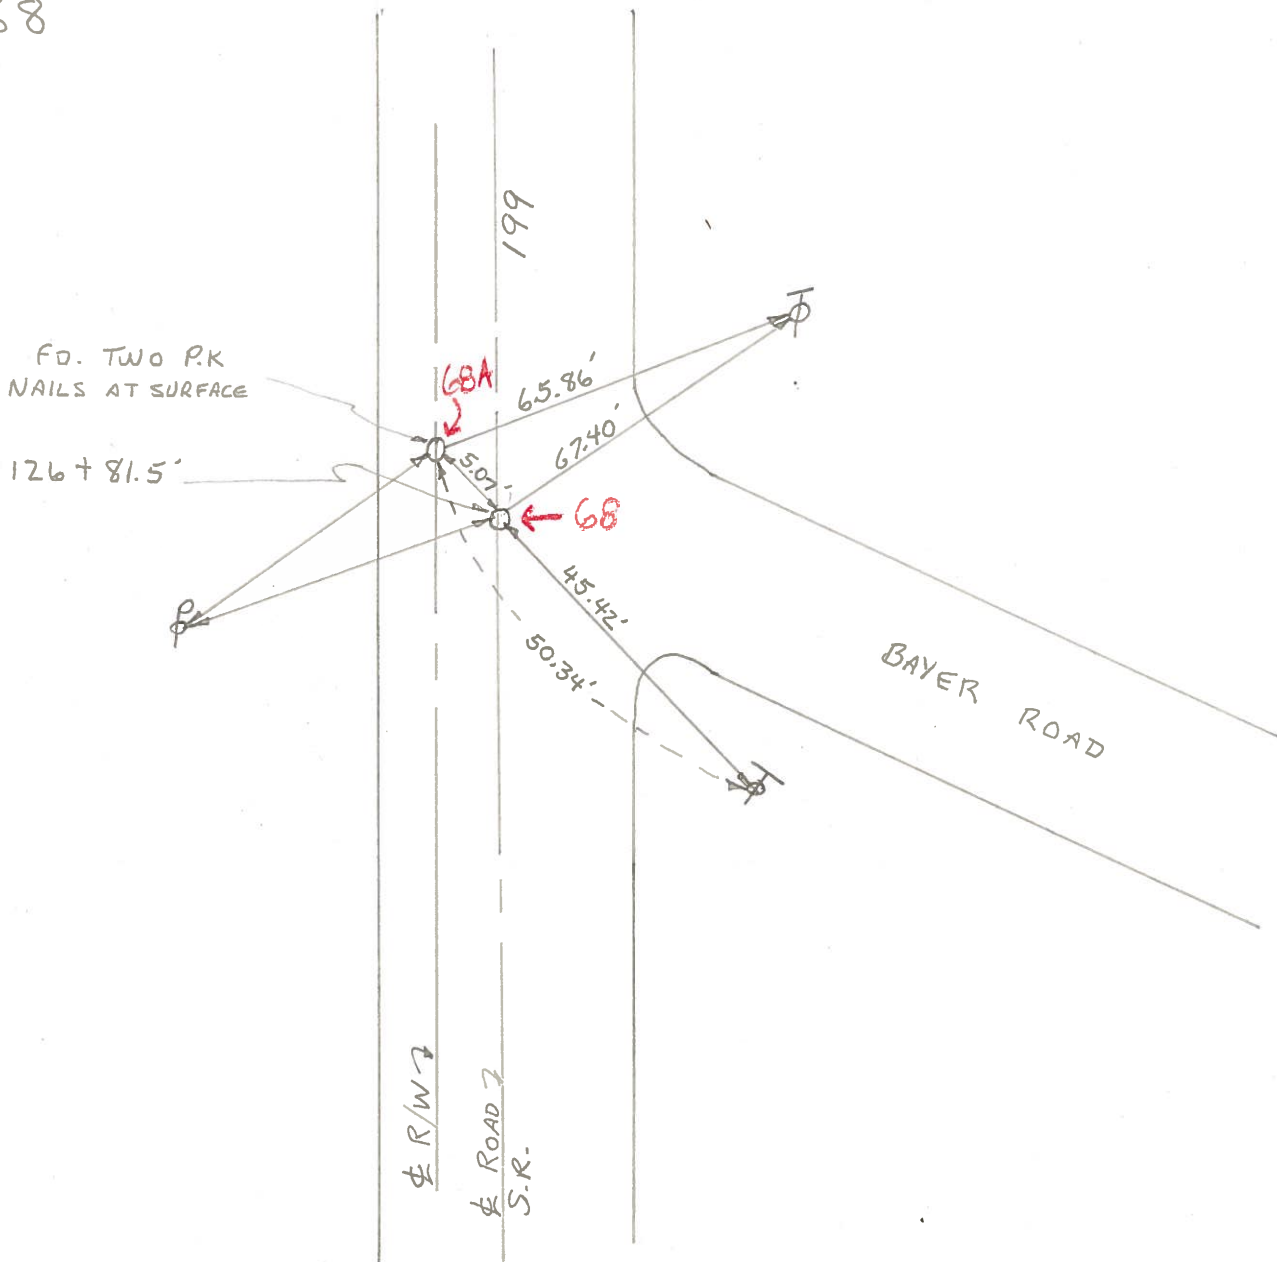

PERSONNEL	TITLE	PERSONNEL	TITLE
Tomsic		Curtis	
Neuser			
Vanyo			
Granata			

COUNTY Wood DATE Sept. 23, 1971

S. R. #99 WEATHER _____

SEC. _____ TEMP. _____

DESCRIPTION Ref. Mon. JOB NO. _____

