

O.D.O.T. DISTRICT 2 SURVEY OFFICE (USE ONLY)

PERSONNEL

REFERENCE NO. 68 C

SHEET 68 OF 75

NOTES AUBLE

DATE 4-25-18

ROUTE SR 199

H.C. LEU

WEATHER CLOUDY

COUNTY WOOD

R.C. AUBLE

TEMP. 62°

TOWNSHIP PERRYSBURG

SECTION 21

DWG BY AUBLE

PID 101221

T 6 N R 11 E

TYPE MONUMENT MONBOX W/ 1 1/2" IPIN

ON SURFACE - ~~BELOW~~ ON

OFFSET \varnothing PAVEMENT 1.7' LT : ~~RT~~

- TO - EDGE PAVEMENT


STATION: 1468+50

HORZ.DATUM: NAD83 (2011)


GEOID: 2012A

GRID: NORTHING: 677847.306

EASTING: 1666120.875

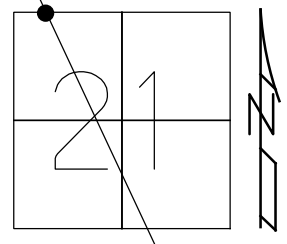


RECORD:
 SET P.K./WASHER
 8/9/02, DCH
 FD P.K./WASHER
 7/21/11, KPM
 SET MAG/WASHER
 9/9/11, RJL
 REFC68
 12/16/11, MC
 FD MONBOX
 W/ 1 1/2" IPIN
 REFC68
 4-25-18, JLL

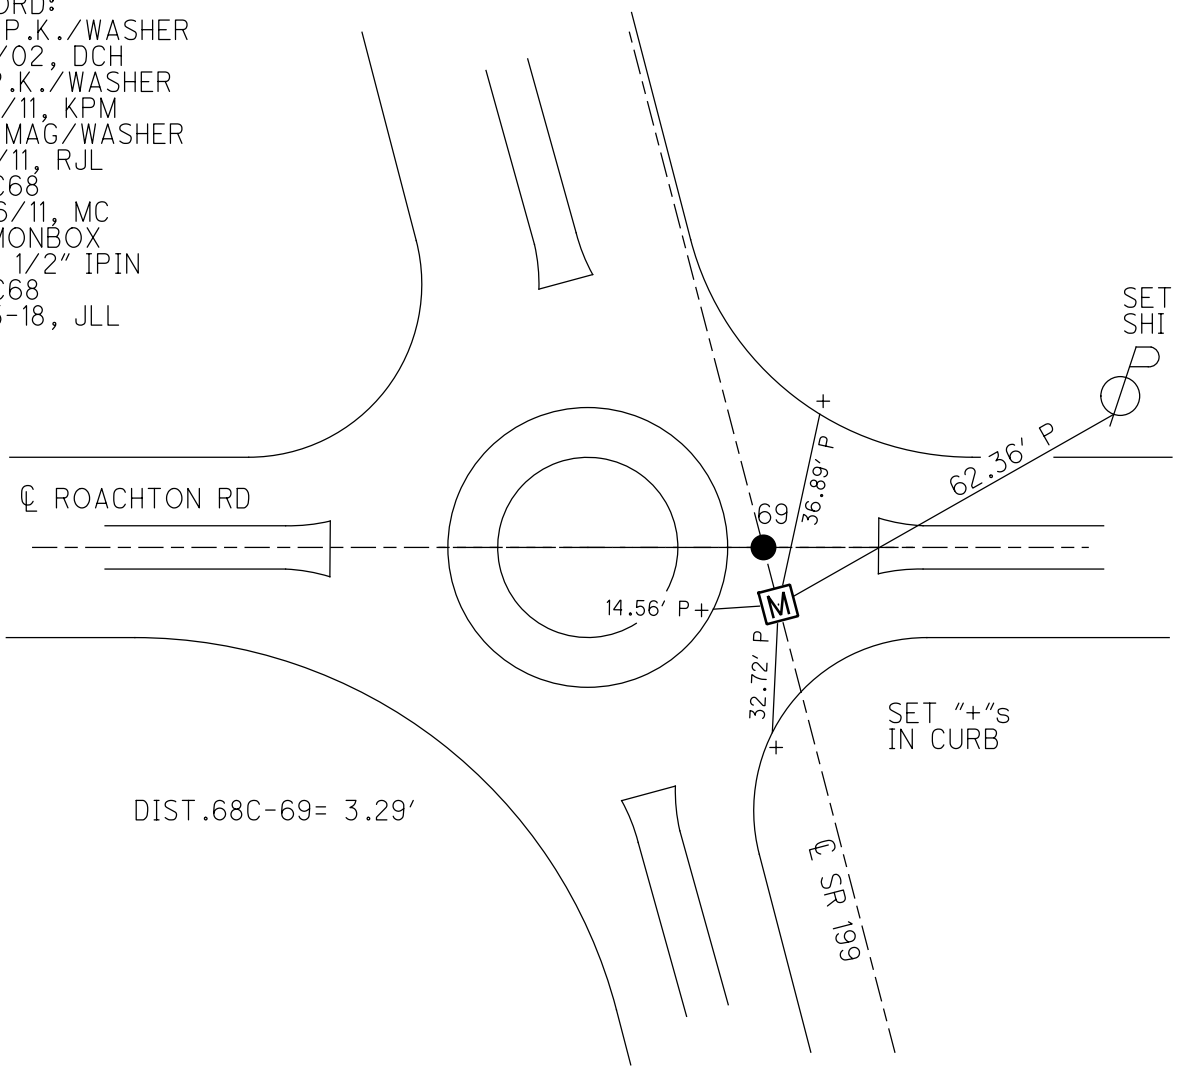


O.D.O.T. DISTRICT 2 SURVEY OFFICE (USE ONLY)

PERSONNEL _____ REFERENCE NO. 68 C SHEET 66 OF 72
 NOTES MOSER DATE 7/21/11 ROUTE SR 199
 H.C. MOSER WEATHER SUNNY COUNTY WOOD
 R.C. HARBAUGH TEMP. 85° TOWNSHIP PERRYSBURG
 _____ SECTION 21
 _____ T 6 N R 11 E

TYPE MONUMENT PK/WASHER
 ON SURFACE - ~~BELOW~~ ON
 LEFT - ~~C PAV'T~~ - ~~RIGHT~~ 1.7'
 TO EDGE PAVEMENT
 S.L.M. 1468+50

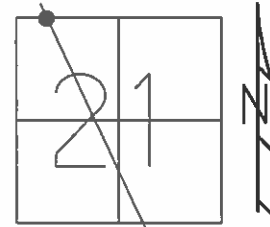

GRID: NORTHING: 677847.262 EASTING: 1666120.740

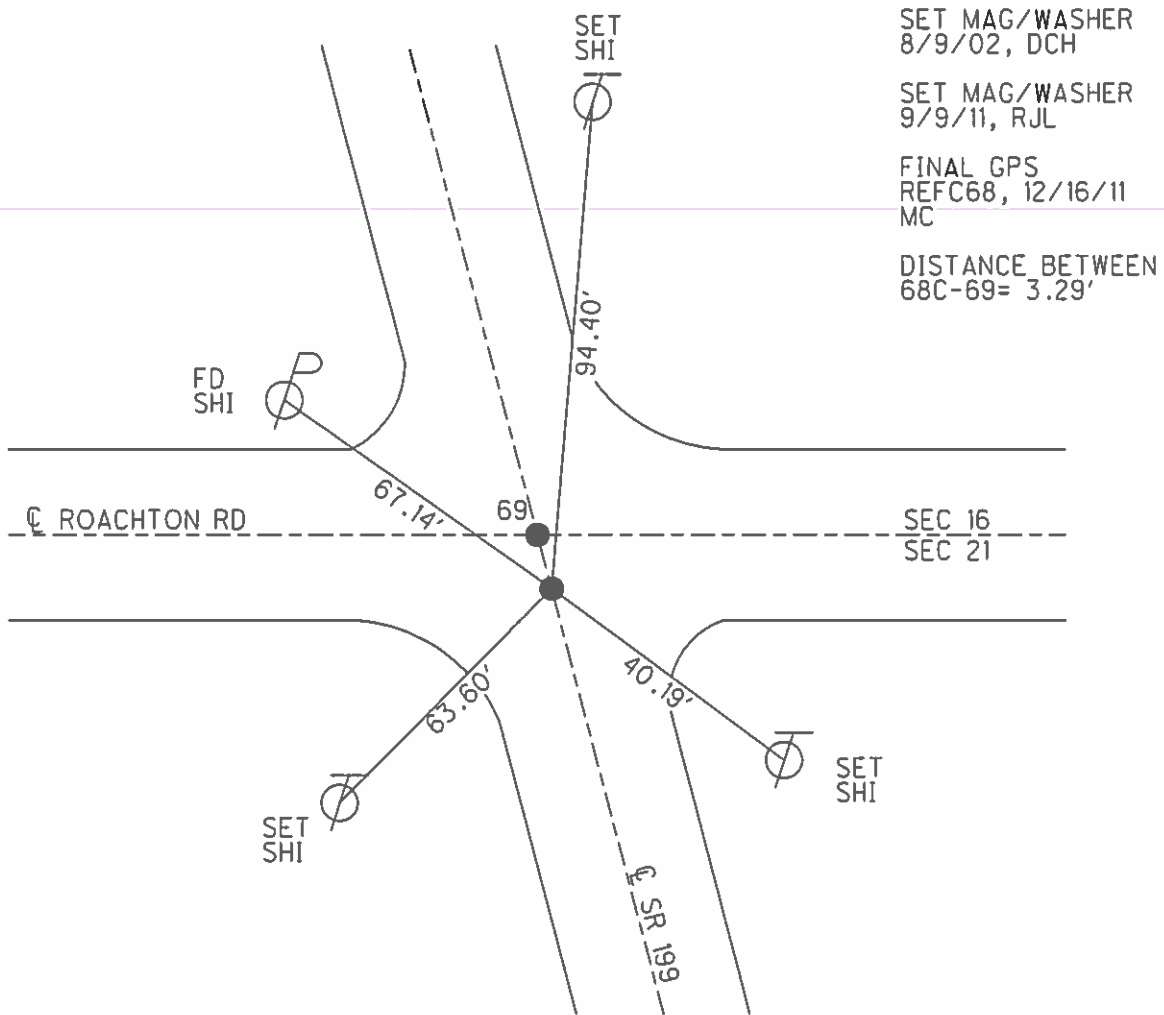

O.D.O.T. DISTRICT 2 SURVEY OFFICE


PERSONNEL

NOTES _____ MOSER _____
 H.C. _____ HOMAN _____
 R.C. _____ ROUSOS _____
 _____ CANTERBURY _____


REFERENCE NO. 68C
 &69
 DATE 4-6-02
 WEATHER SUNNY
 TEMP. +40°

SHEET 42 OF 45
 ROUTE 199
 COUNTY WOOD
 TOWNSHIP PERRYSBURG
 SECTION 21
T 6 N R 11 E

TYPE MONUMENT PK'S & WASHER'S
 ON SURFACE - ~~BELOW~~ _____ YES _____
~~LEFT - Q~~ PAV'T - ~~RIGHT~~ _____ YES _____
 _____ TO _____ EDGE PAVEMENT
 S.L.M. "A" 1468+50, "B" 1468+54

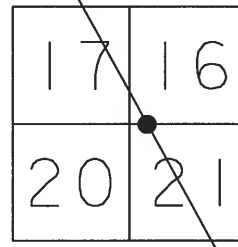

SET MAG NAILS
 & WASHERS
 8-9-02
 D.C.H.

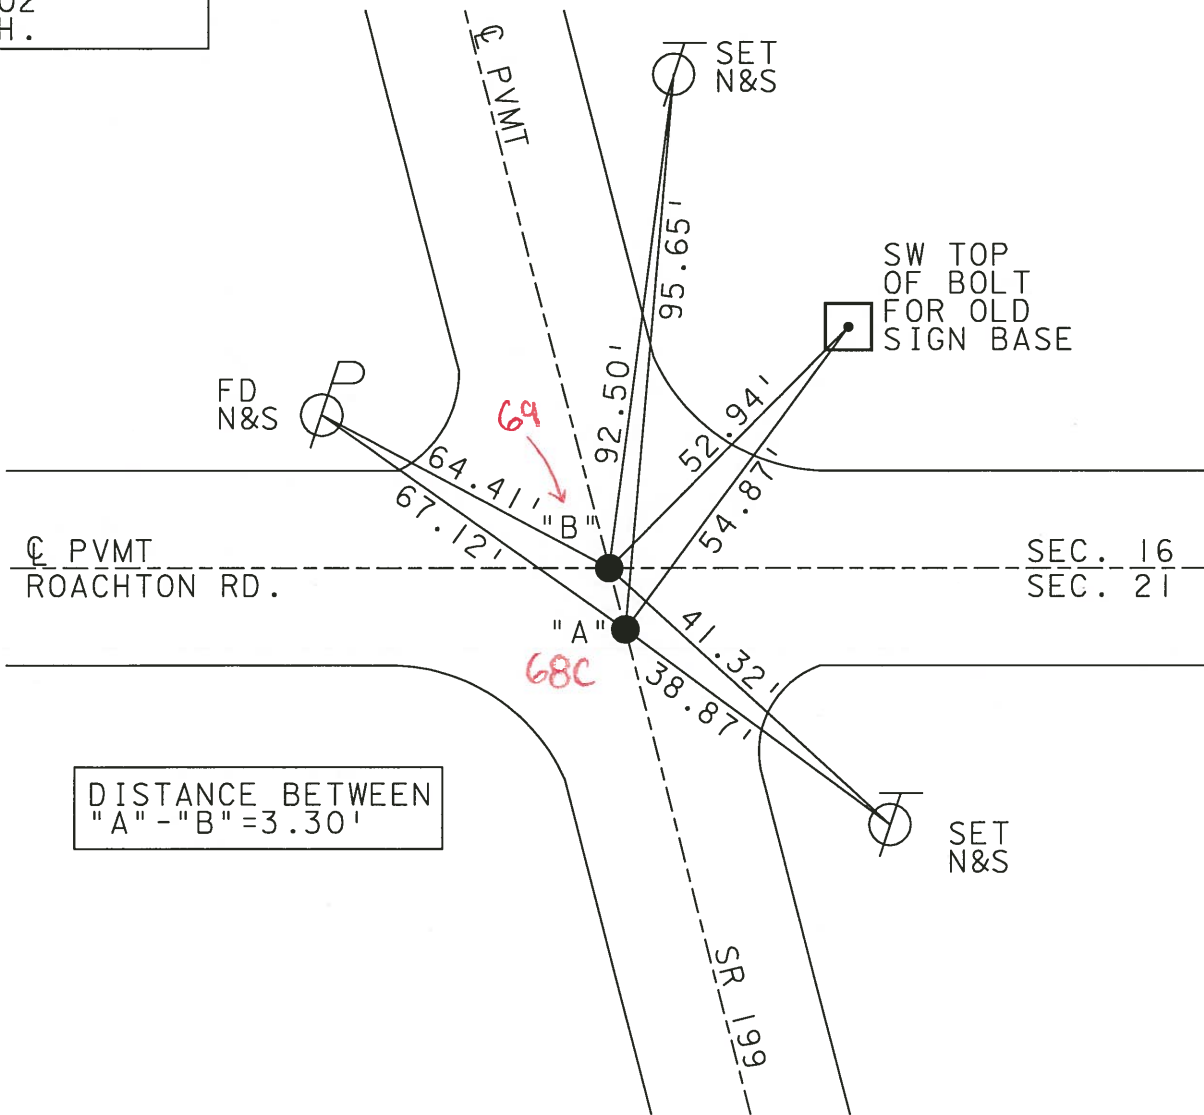

DISTANCE BETWEEN
 "A" - "B" = 3.30'

O.D.O.T. DISTRICT 2 SURVEY OFFICE

PERSONNEL _____

REFERENCE NO. 68-C
669

SHEET 15 OF 21

NOTES D. CURTIS

H.C. J. HOUSEHOLDER DATE 9-9-88

R.C. _____ WEATHER MILD

_____ TEMP. 75°±

ROUTE S.R. #199

COUNTY WOOD

TOWNSHIP PERRYSBURG

SECTION 21

T _____ R _____



TYPE MONUMENT P.K. NAIL IN WASHERS

ON SURFACE - BELOW SURFACE

LEFT- & PAW'T. - RIGHT _____

_____ TO _____ EDGE PAVEMENT

S.L.M. (A) 1468+50, (B) 1468+54

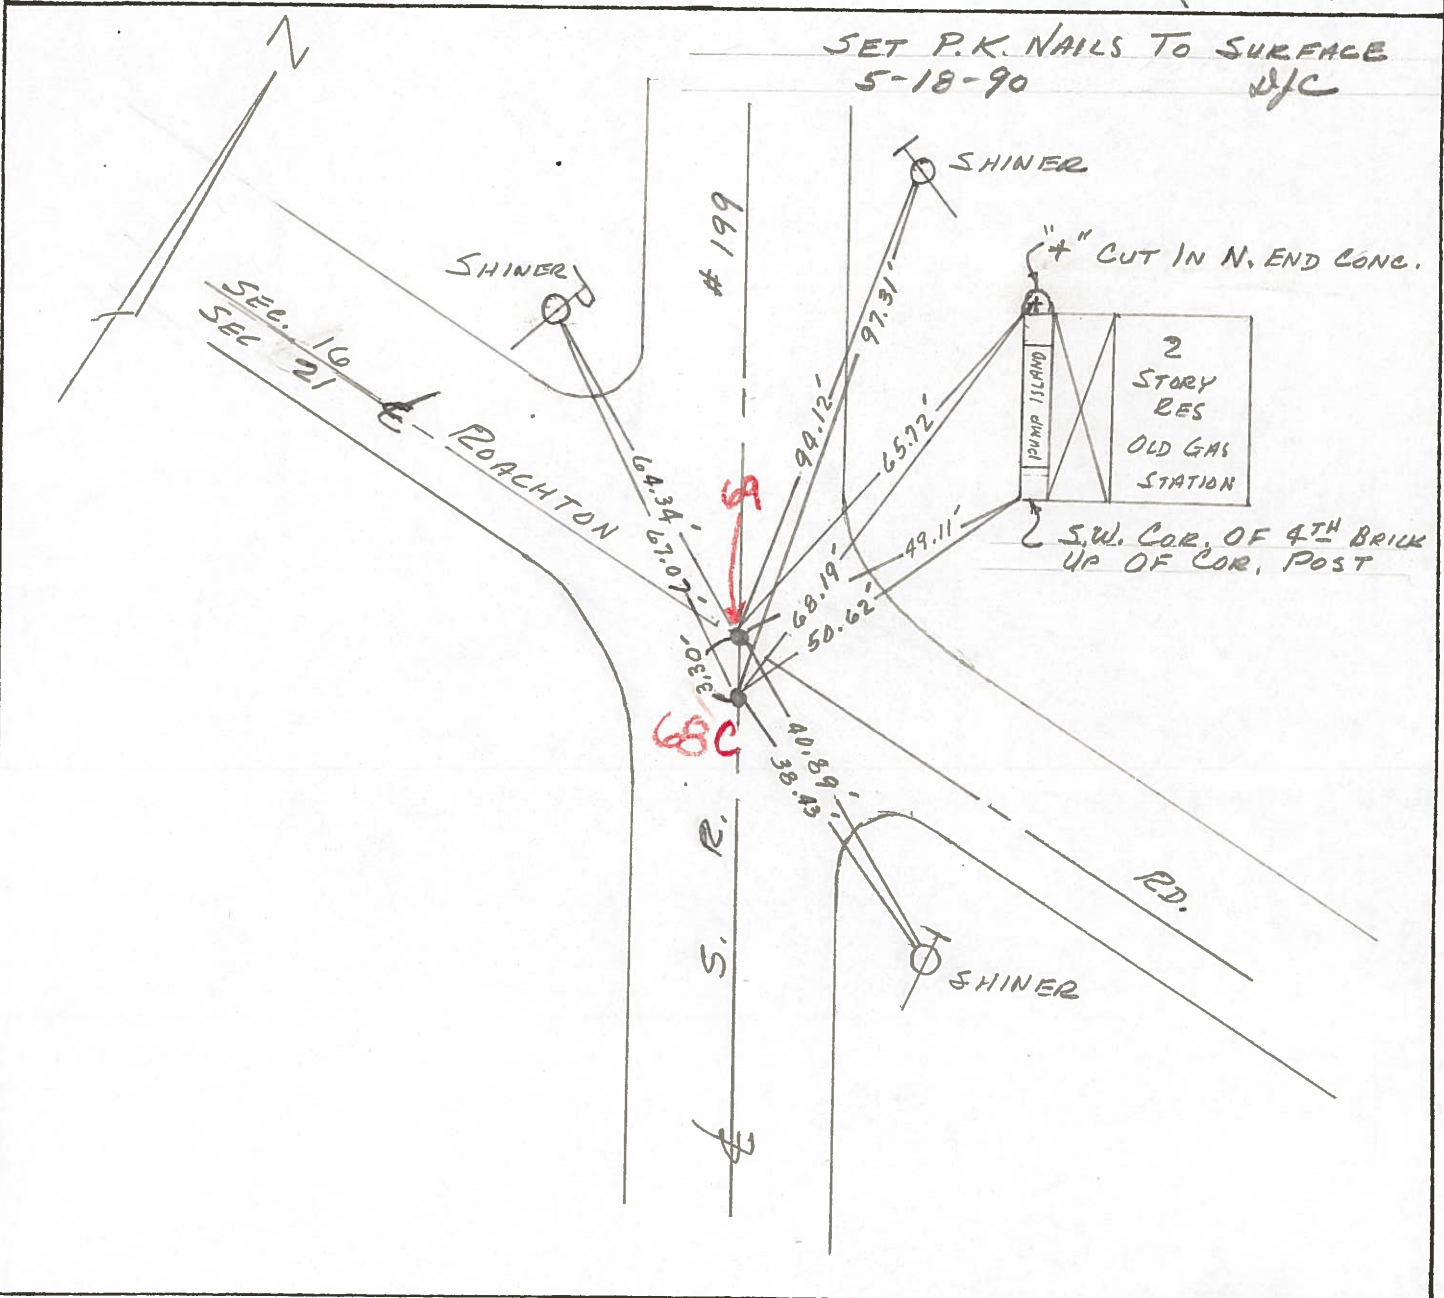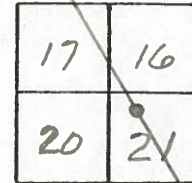

Q.D.O.T. DISTRICT 2 SURVEY OFFICE

SHEET _____ OF _____

County WOOD S.R. 199

Township Perrysburg

Section _____

T4N, R E U.S.R.

Personnel HOFFMAN

HOUSEHOLDER

LOEHRKE


BARNHISEL

#68-C

Date 12-27-82

Weather RAIN

Temp. +40°

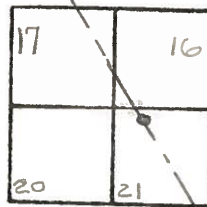

Fd P.K. / WASHER 4" Below SURFACE

2.6' Lt. of & PAUT SR 199

8.4' S. of & PAUT ROACHTON

S.D.M. 1468+45

SET P.K. / WASHER
7-22-83 M.D.B.

Record: 1925 PLAN
P.I. 96+77.0
Δ = 0°-05' RT

