



O.D.O.T. DISTRICT 2 SURVEY OFFICE (USE ONLY)

PERSONNEL _____ REFERENCE NO. 69 SHEET 69 OF 75
 NOTES MOSER DATE 7-21-11 ROUTE SR 199
 H.C. MOSER WEATHER SUNNY COUNTY WOOD
 R.C. HARBAUGH TEMP. 85° TOWNSHIP PERRYSBURG
 DWG BY AUBLE PID 101221 SECTION 21
 T 6 N R 11 E

TYPE MONUMENT P.K./WASHER
 ON SURFACE - ~~BELOW~~ ON
 OFFSET ☉ PAVEMENT 1.7' LT : ~~RT~~
- TO - EDGE PAVEMENT
 STATION: 1468+54

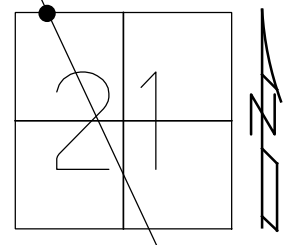


HORZ.DATUM: - GEOID: -
 GRID: NORTHING: 677850.129 EASTING: 1666119.202

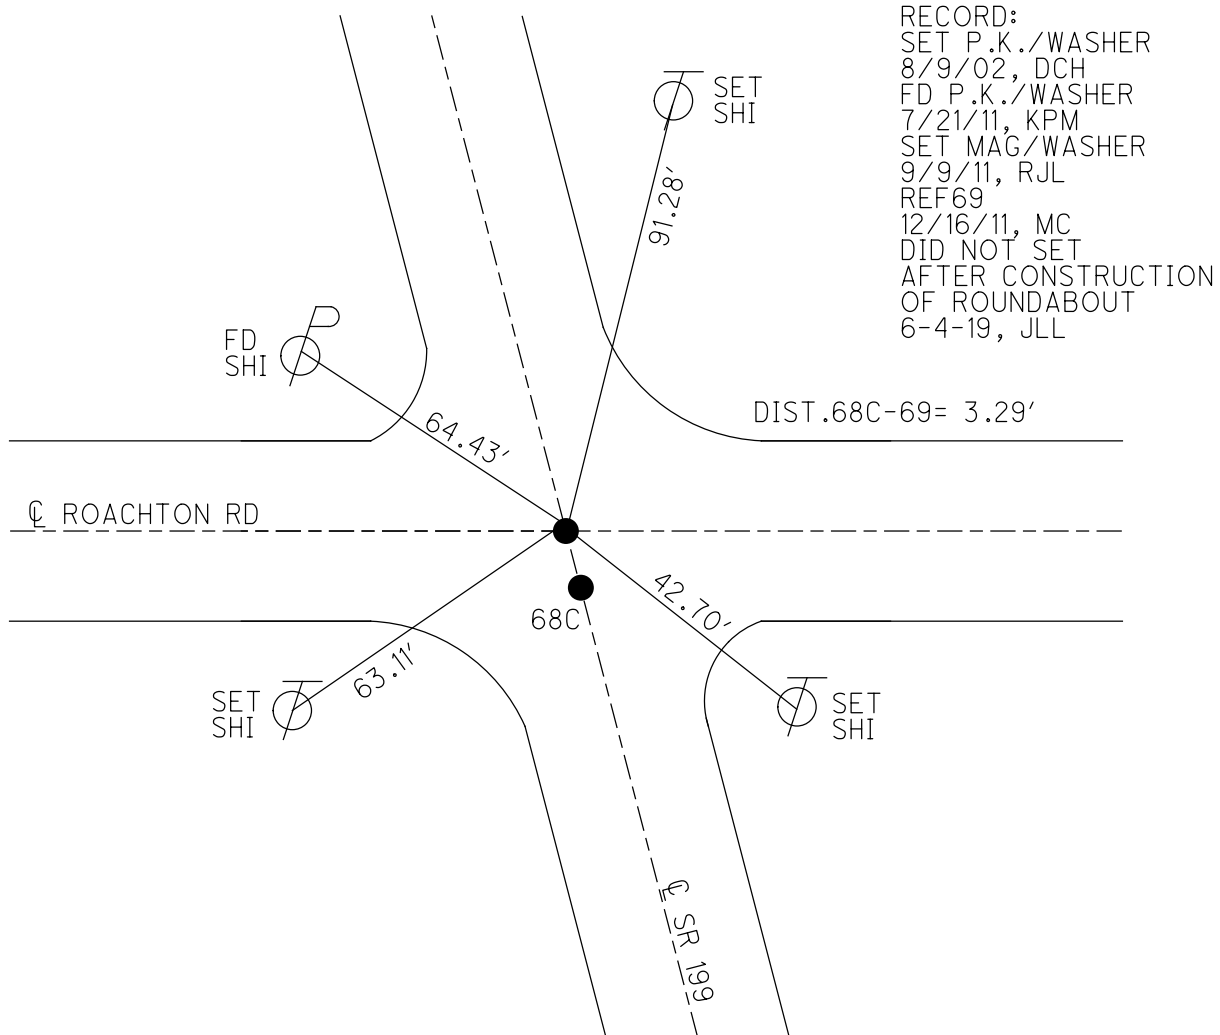


O.D.O.T. DISTRICT 2 SURVEY OFFICE (USE ONLY)

PERSONNEL _____ REFERENCE NO. 69 SHEET 67 OF 72
 NOTES MOSE DATE 7/21/11 ROUTE SR 199
 H.C. MOSE WEATHER SUNNY COUNTY WOOD
 R.C. HARBAUGH TEMP. 85° TOWNSHIP PERRYSBURG
 _____ SECTION 21
 _____ T 6 N R 11 E

TYPE MONUMENT _____ PK/WASHER _____
 ON SURFACE - ~~BELOW~~ _____ ON _____
 LEFT - ☉ PAV'T - RIGHT 1.7'
 _____ TO _____ EDGE PAVEMENT
 S.L.M. 1468+54

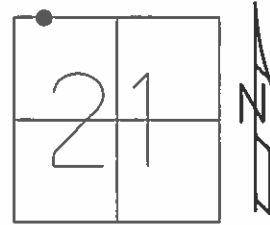

GRID: NORTHING: 677850.129 EASTING: 1666119.202

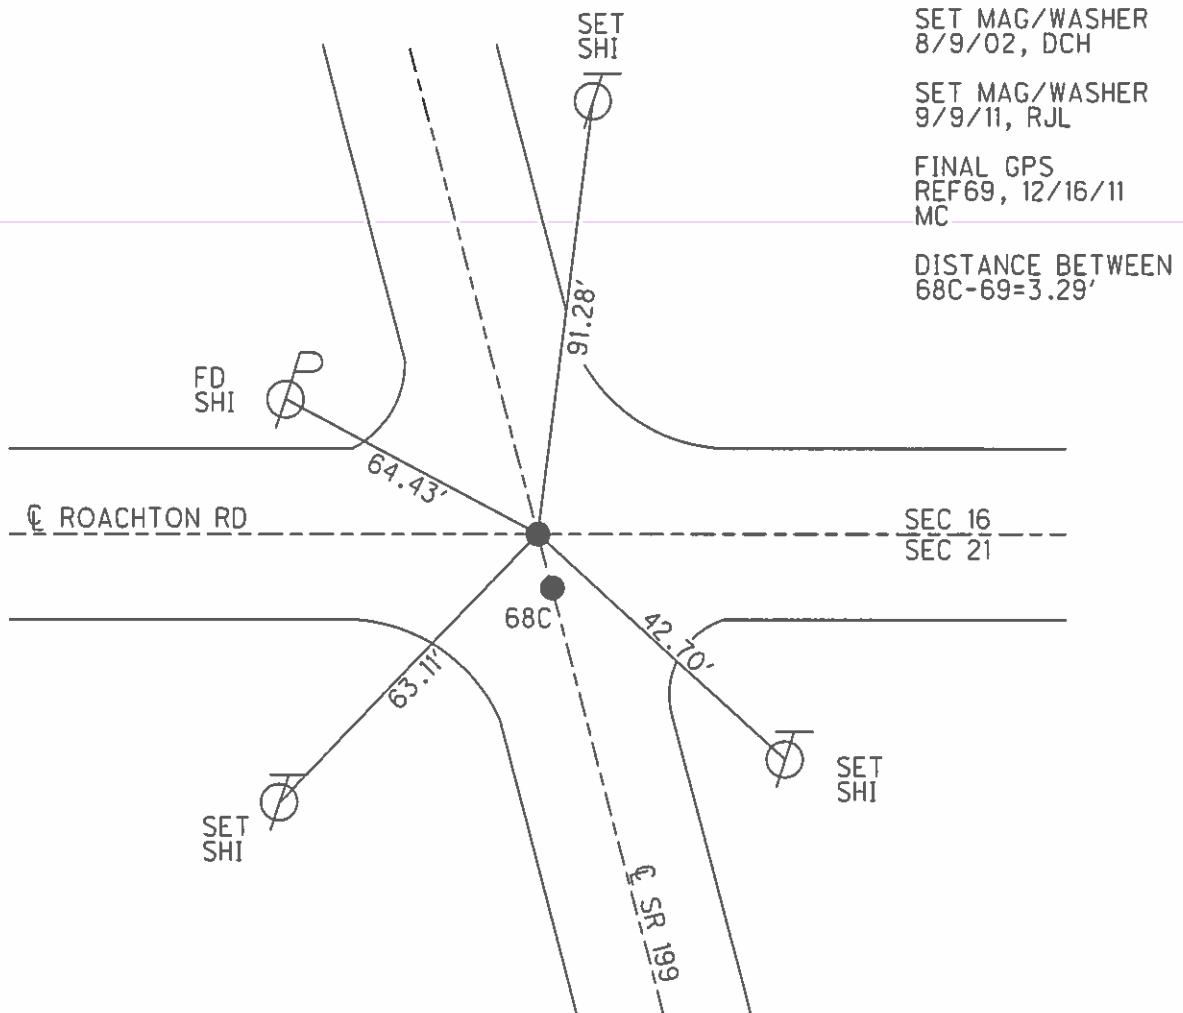

O.D.O.T. DISTRICT 2 SURVEY OFFICE

PERSONNEL

REFERENCE NO. 68C
&69


SHEET 42 OF 45

NOTES MOSER
H.C. HOMAN
R.C. ROUSOS
 CANTERBURY


DATE 4-6-02
WEATHER SUNNY
TEMP. +40°

ROUTE 199
COUNTY WOOD
TOWNSHIP PERRYSBURG
SECTION 21
 T 6 N R 11 E

TYPE MONUMENT PK'S & WASHER'S
ON SURFACE - ~~BELOW~~ YES
~~LEFT~~ - ~~PAV'T~~ - ~~RIGHT~~ YES
 TO EDGE PAVEMENT
S.L.M. "A" 1468+50, "B" 1468+54

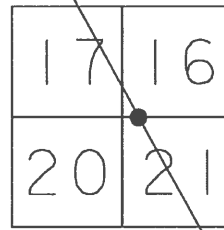

SET MAG NAILS
& WASHERS
8-9-02
D.C.H.

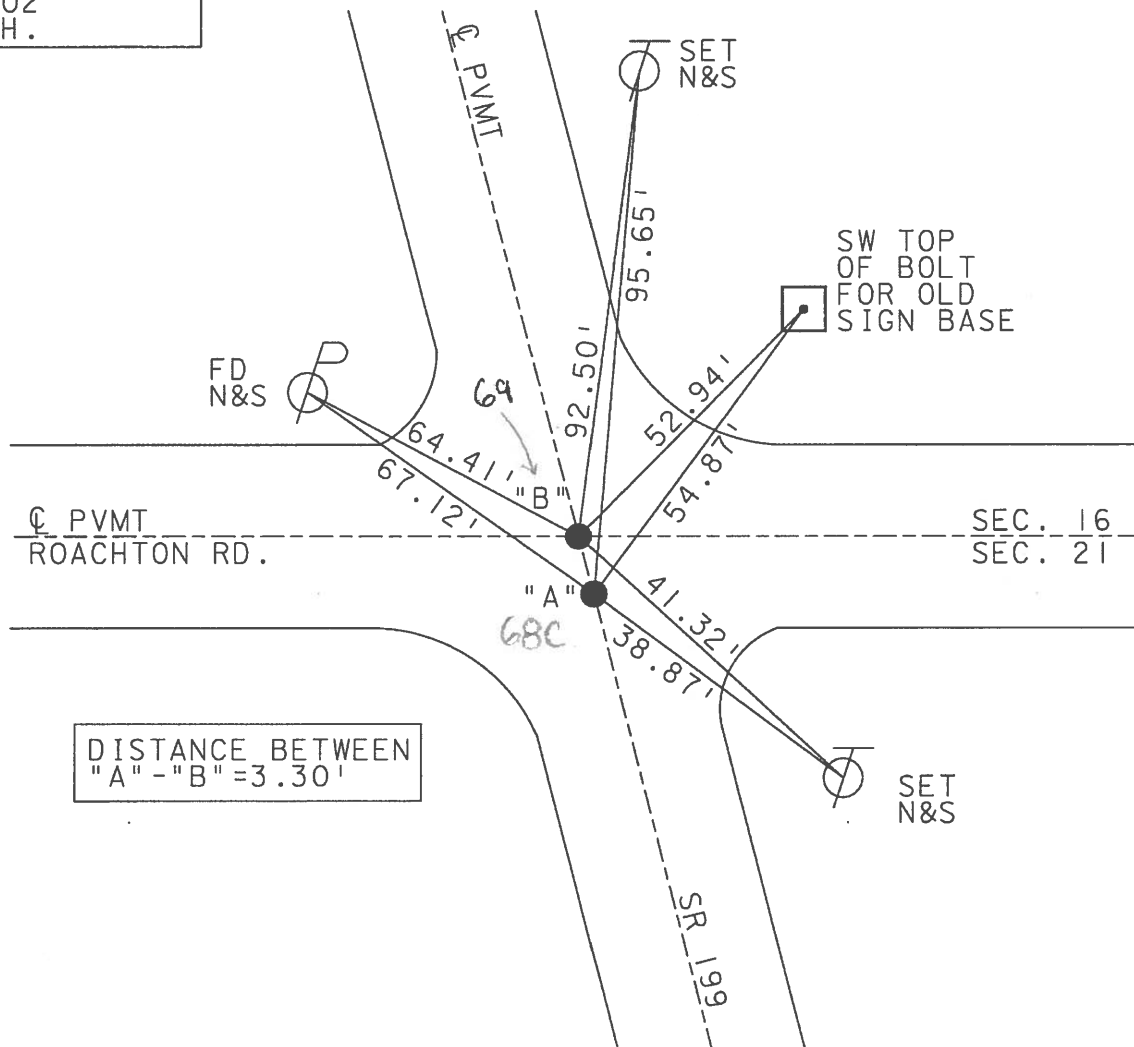

DISTANCE BETWEEN
"A" - "B" = 3.30'

O.D.O.T. DISTRICT 2 SURVEY OFFICE

PERSONNEL _____

REFERENCE NO. 68-C
669

SHEET 15 OF 21

NOTES D. CURTIS

H.C. J. HOUSEHOLDER

DATE 9-9-88

ROUTE S.R. #199

R.C. _____

WEATHER MILD

COUNTY WOOD

TEMP. 75°±

TOWNSHIP PERRYSBURG

SECTION 21

T. _____ R. _____



TYPE MONUMENT P.K. NAIL IN WASHERS

ON SURFACE - BELOW SURFACE

LEFT- & PAV'T. - RIGHT _____

TO _____ EDGE PAVEMENT

S.L.M. (A) 1468+50, (B) 1468+54

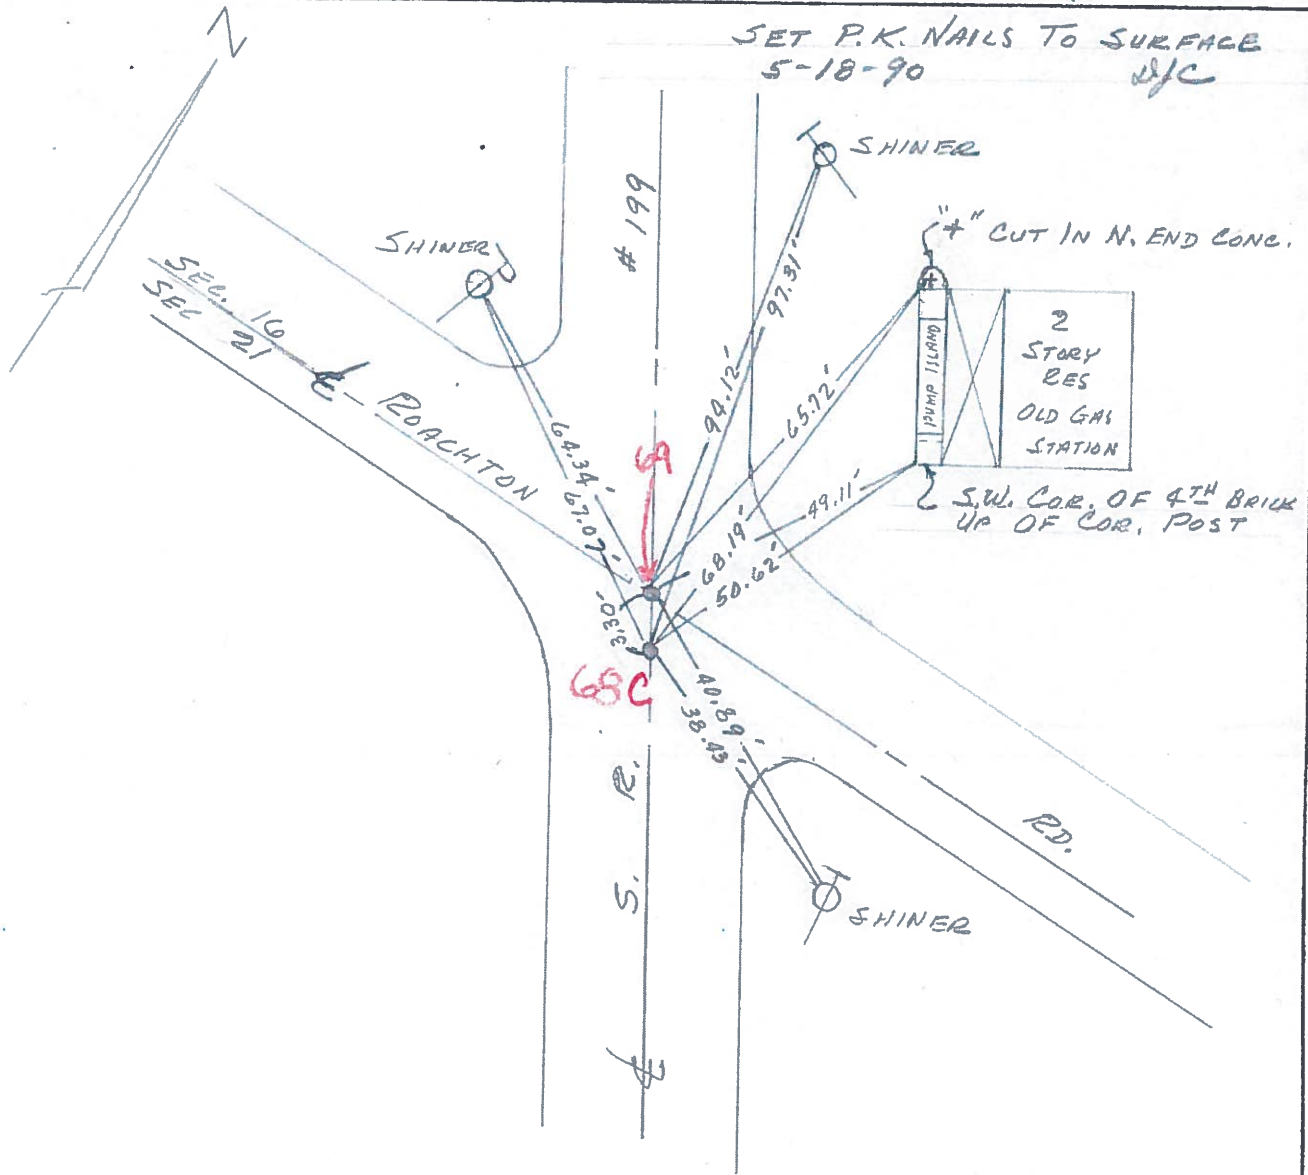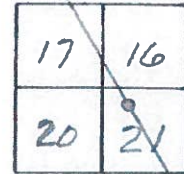

QD.O.T. DISTRICT 2 SURVEY OFFICE

SHEET _____ OF _____

County Wood S.R. 199

Date Dec 30, 82

Township Perrysburg

Weather Cloudy

Section 21

Temp. +24°

T4N, R_E U.S.R.


Personnel HOFFMAN

HOUSEHOLDER

LOERKE

BARNHISEL

#69

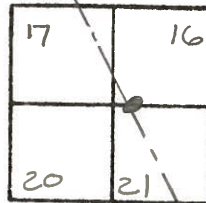

Set P.K./WASHER @ INTERSECTION of a survey SR199 & North Section line OF SECTION 21

SET P.K./WASHER
7-22-83 M.D.B.

