

County WOOD S.R. 199

Date FEB. 28 - 1972

Township PERRYS BURG

Weather \_\_\_\_\_

Section 21

Temp. \_\_\_\_\_

T N, R E

Personnel TOMSIK

NEUSER


GRANATA

VANYO

17	16
20	21



68-A

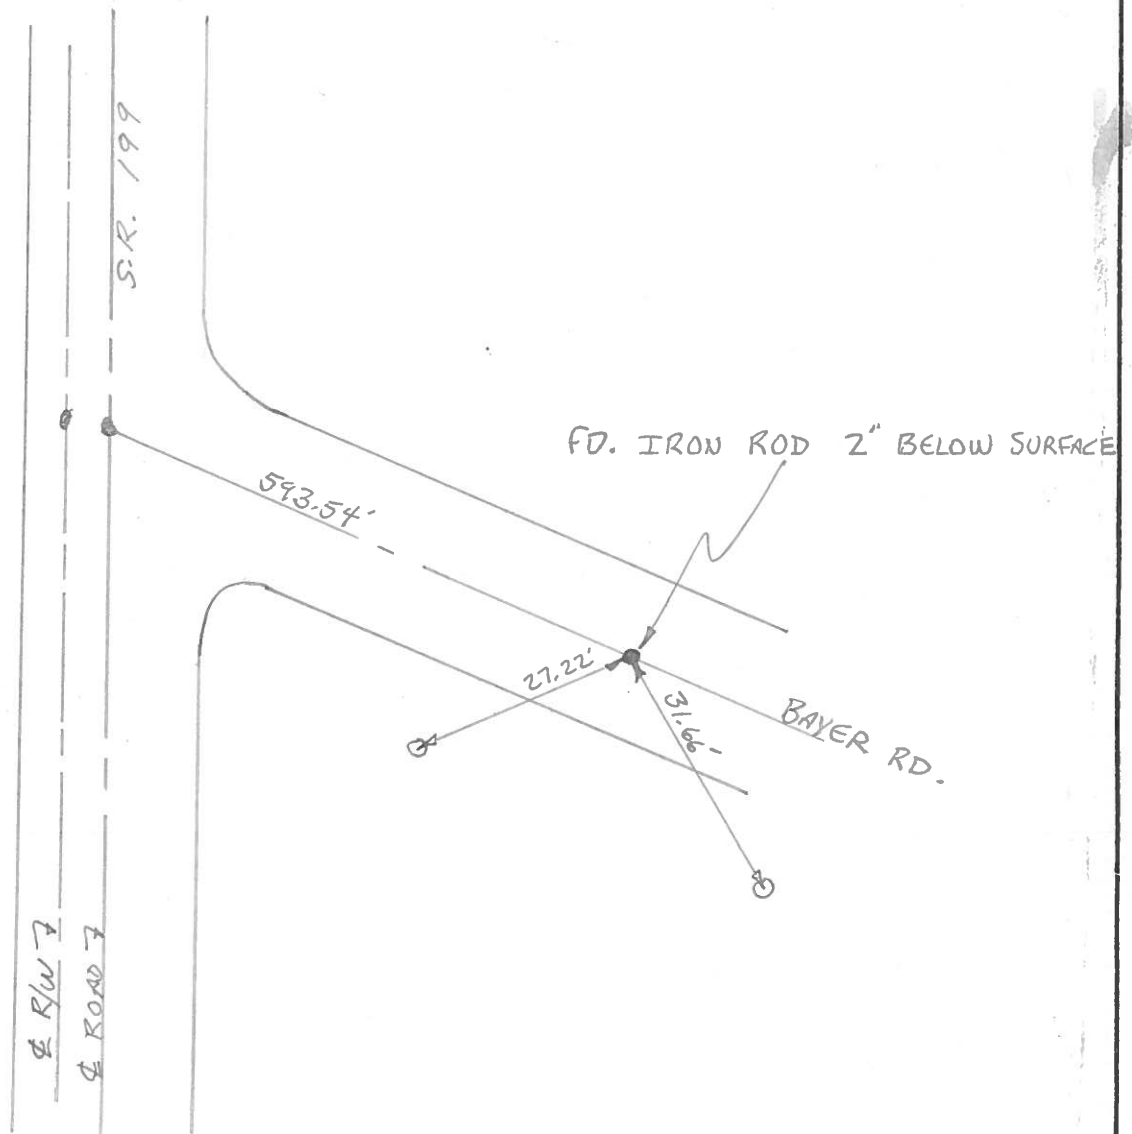

OD.O.T. DISTRICT 2 SURVEY OFFICE

SHEET

OF

County WOOD S.R. 199

Township PERRYSBURG

Section \_\_\_\_\_

T N, R E

Personnel TOM SIC

NEUSER

VANYO

GRANATA

Date SEPT. 23-1971

Weather \_\_\_\_\_

Temp. \_\_\_\_\_

17	16
20	21



67-B

