

Q.D.O.T. DISTRICT 2 SURVEY OFFICE

SHEET _____ OF _____

County Wood S.R. 199-ROACHTON

Date 12-27-82

Township Perrysburg


Weather RAIN

Section _____

Temp. +40°

T4N, RE U.S.R.

Personnel HOFFMAN

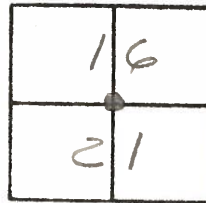


HOUSEHOLDER
LOHRKE
BARNHISEL

Fd. I. Rod @ surface

1.6' N. of ϕ PAUT

7.7' TO N.E.P.

9.8' TO S.E.P.

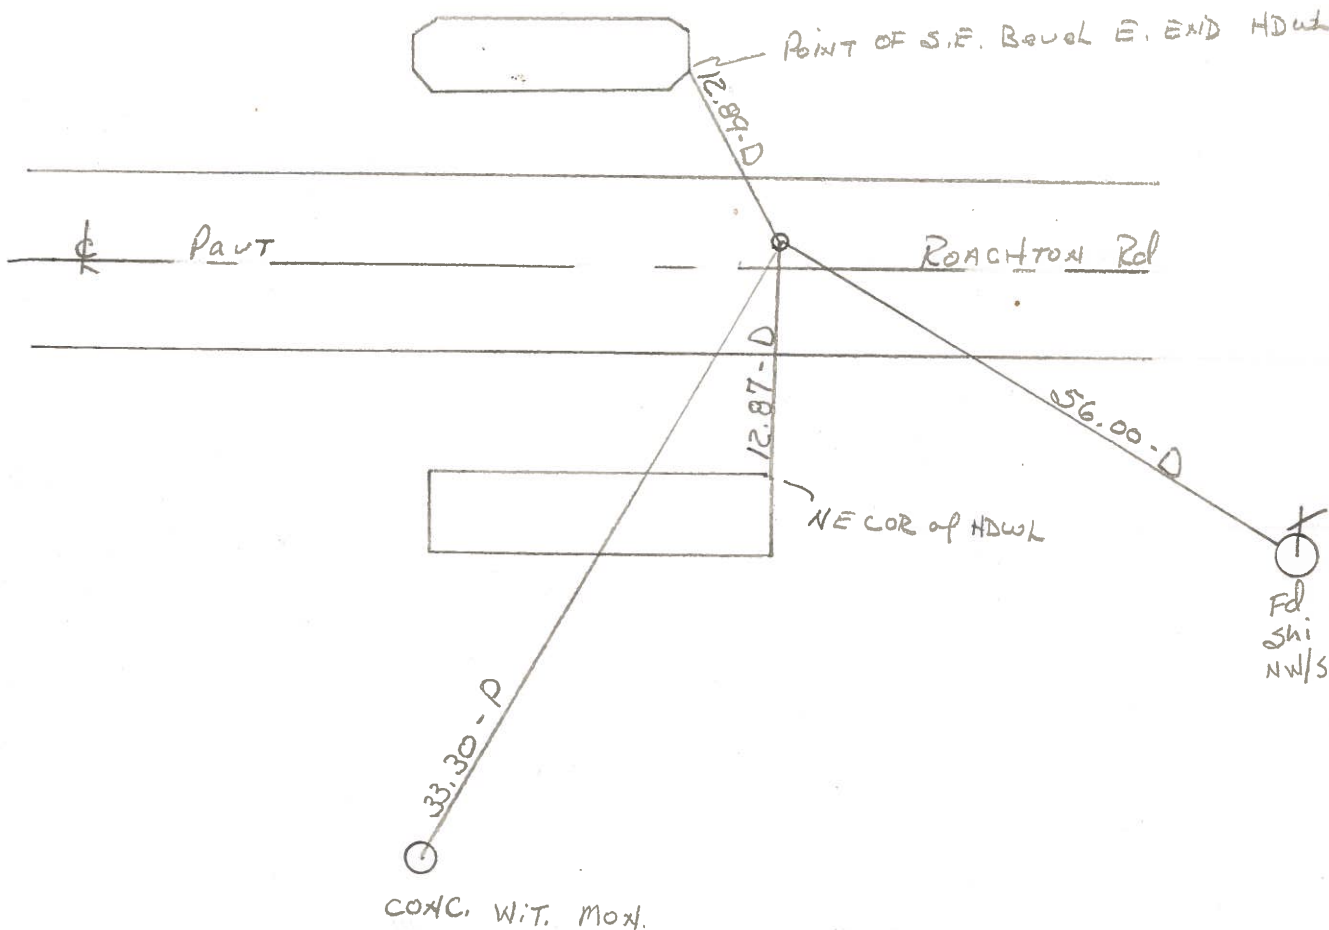

Q.D.O.T. DISTRICT 2 SURVEY OFFICE

SHEET _____ OF _____

County Wood S.R. 199 - ROACHTON

Date 12-27-82

Township Perrysburg

Weather RAIN

Section _____

Temp. +40°

T4N, RE U.S.R.

Personnel HOFFMAN

HOUSEHOLDER

LOEHRKE

BARNHISEL

17	16
20	21



Fd R.R. SPK @ surface

0.2' S. of & PAUT.

1.0' TO S.E.P.

