

O.D.O.T. DISTRICT 2 SURVEY OFFICE (USE ONLY)

PERSONNEL

REFERENCE NO. 69 A

SHEET 70 OF 75

NOTES AUBLE

DATE 4-25-18

ROUTE SR 199

H.C. LEU

WEATHER CLOUDY

COUNTY WOOD

R.C. AUBLE

TEMP. 62°

TOWNSHIP PERRYSBURG

SECTION 17

DWG BY AUBLE

PID 101221

T 6 N R 11 E

TYPE MONUMENT MAG/WASHER

ON SURFACE - ~~BELOW~~ ON

OFFSET ϕ PAVEMENT 1.5' LT : ~~RT~~

8.7' TO LT EDGE PAVEMENT


STATION: 1483+52

HORZ.DATUM: NAD83 (2011)


GEOID: 2012A

GRID: NORTHING: 679193.998

EASTING: 1665457.845

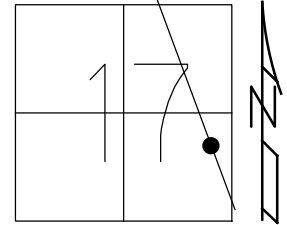

DIST.
69AA-69A= 32.29'
69AA-69AB= 75.04'

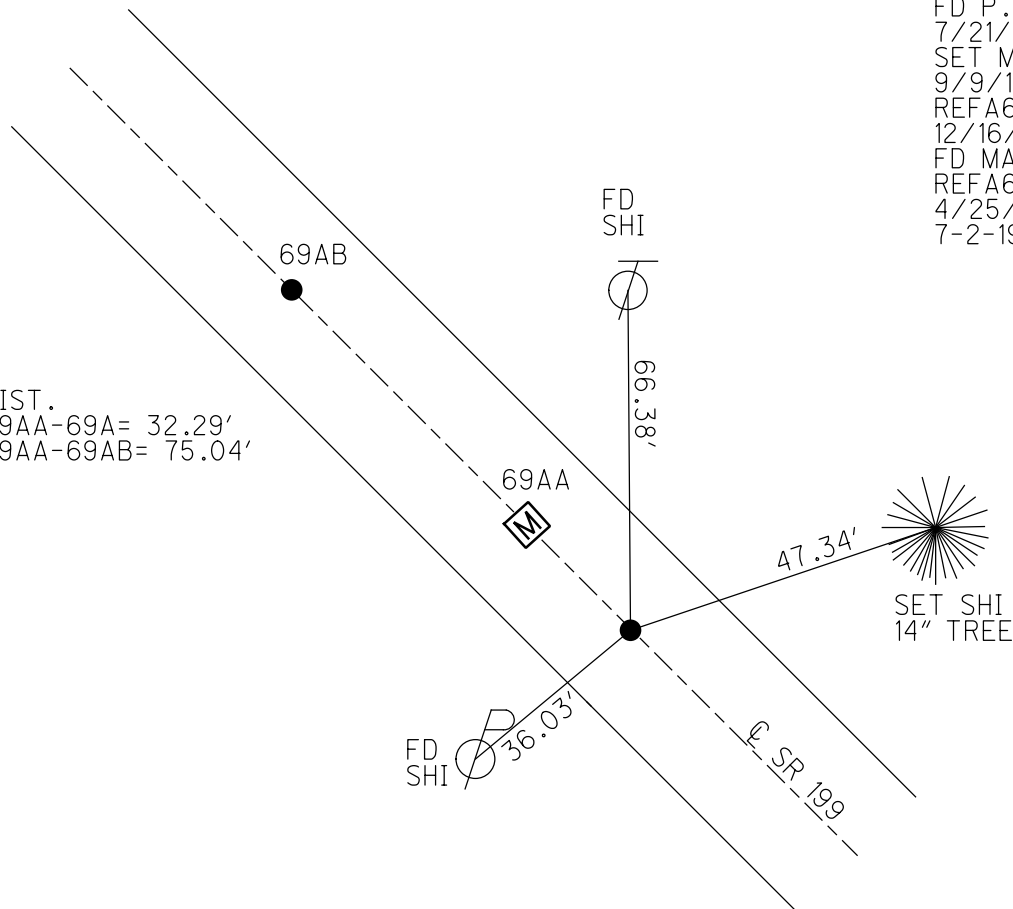


RECORD:
SET P.K./WASHER
8/9/02, DCH
FD P.K./WASHER
7/21/11, KPM
SET MAG/WASHER
9/9/11, RJL
REFA69
12/16/11, MC
FD MAG/WASHER
REFA69
4/25/18
7-2-19, JLL


O.D.O.T. DISTRICT 2 SURVEY OFFICE (USE ONLY)

PERSONNEL _____ REFERENCE NO. 69 A SHEET 68 OF 72
 NOTES MOSER DATE 7/21/11 ROUTE SR 199
 H.C. MOSER WEATHER SUNNY COUNTY WOOD
 R.C. HARBAUGH TEMP. 85° TOWNSHIP PERRYSBURG
 SECTION 17
T 6 N R 11 E

TYPE MONUMENT PK/WASHER
 ON SURFACE - ~~BELOW~~ ON
 LEFT - ~~C PAV'T~~ - ~~RIGHT~~ 1.5'
8.7' TO LT EDGE PAVEMENT
 S.L.M. 1483+52

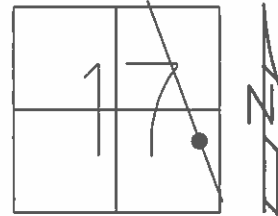

GRID: NORTHING: 679194.027 EASTING: 1665457.815

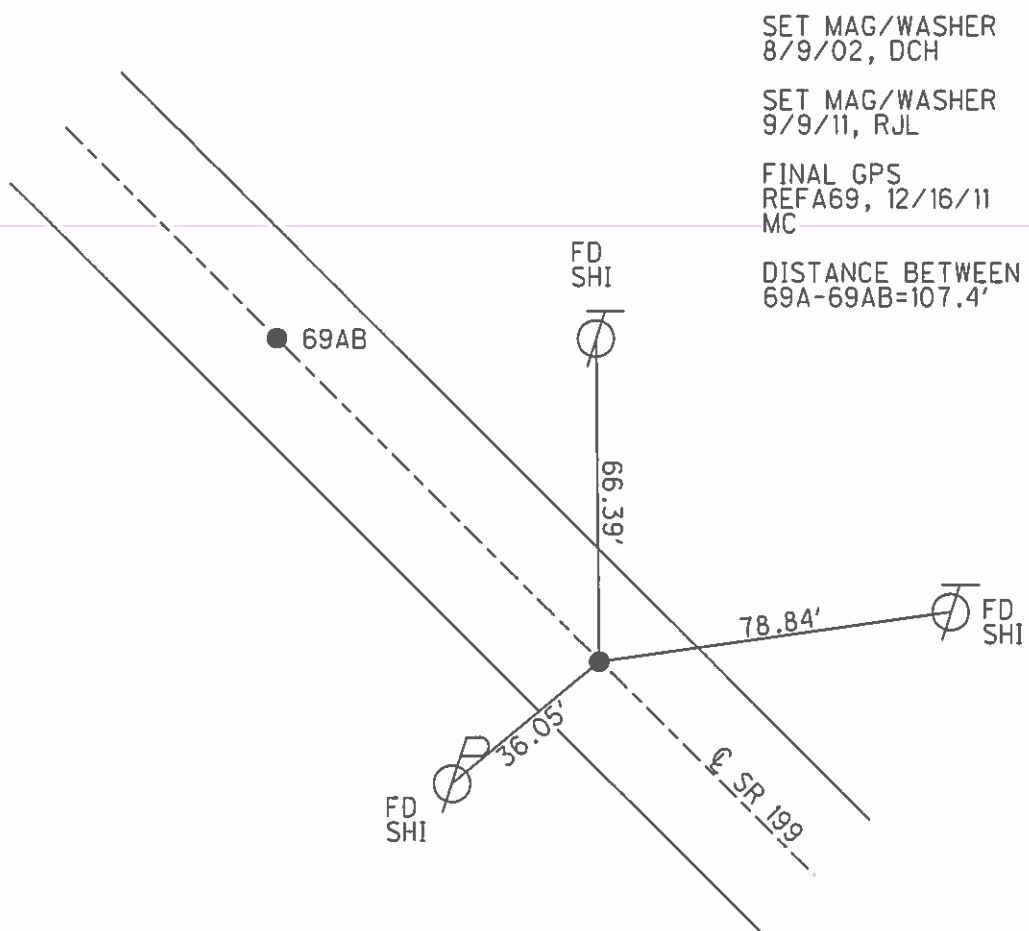

O.D.O.T. DISTRICT 2 SURVEY OFFICE

PERSONNEL

REFERENCE NO. 69A

SHEET 43 OF 45

NOTES MOSER

DATE 4-6-02

ROUTE S.R. 199

H.C. HOMAN

WEATHER SUNNY

COUNTY WOOD

R.C. ROUSOS

TEMP. +40°

TOWNSHIP PERRYSBURG

CANTERBURY

SECTION 17

T 6 N R 11 E


TYPE MONUMENT PK'S & WASHERS

ON SURFACE - ~~BELOW~~ YES


~~LEFT - C~~ PAV'T - ~~RIGHT~~ YES

TO EDGE PAVEMENT

S.L.M. "A" 1483+52 "B" 1484+60

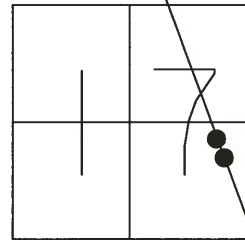

SET MAG NAILS
& WASHERS
8-9-02 D.C.H.

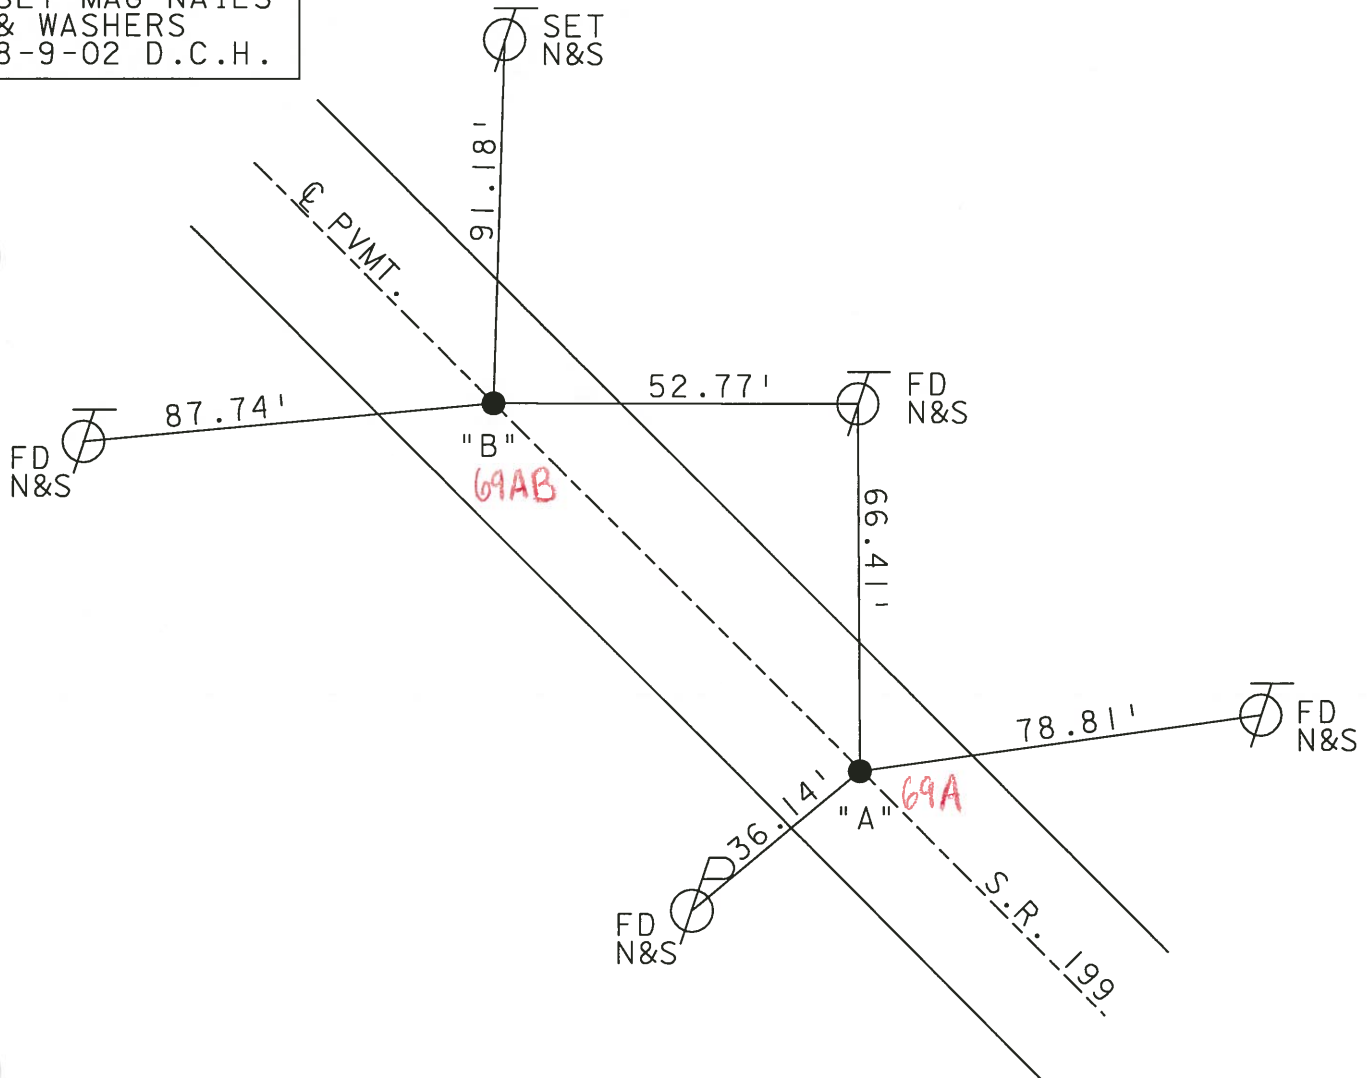

O.D.O.T. DISTRICT 2 SURVEY OFFICE

PERSONNEL _____

REFERENCE NO. 69-A

SHEET 16 OF 21

NOTES D. CURTIS

H.C. J. HOUSEHOLDER

DATE 9-9-88

ROUTE S.R. #199

R.C. _____

WEATHER MILD

COUNTY WOOD

TEMP. 75°±

TOWNSHIP PERRYSBURG

SECTION 17

T _____ R _____


TYPE MONUMENT P.K. NAILS IN WASHERS

ON SURFACE - BELOW SURFACE

LEFT- & PAV'T. - RIGHT _____


_____ TO _____ EDGE PAVEMENT

S.L.M. (A) 1483+52 (B) 1484+60

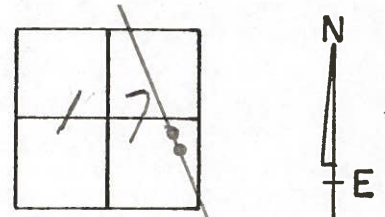

SET P.K. NAILS TO SURFACE AT PTS.

(A) & (B) 5-18-90 UJC

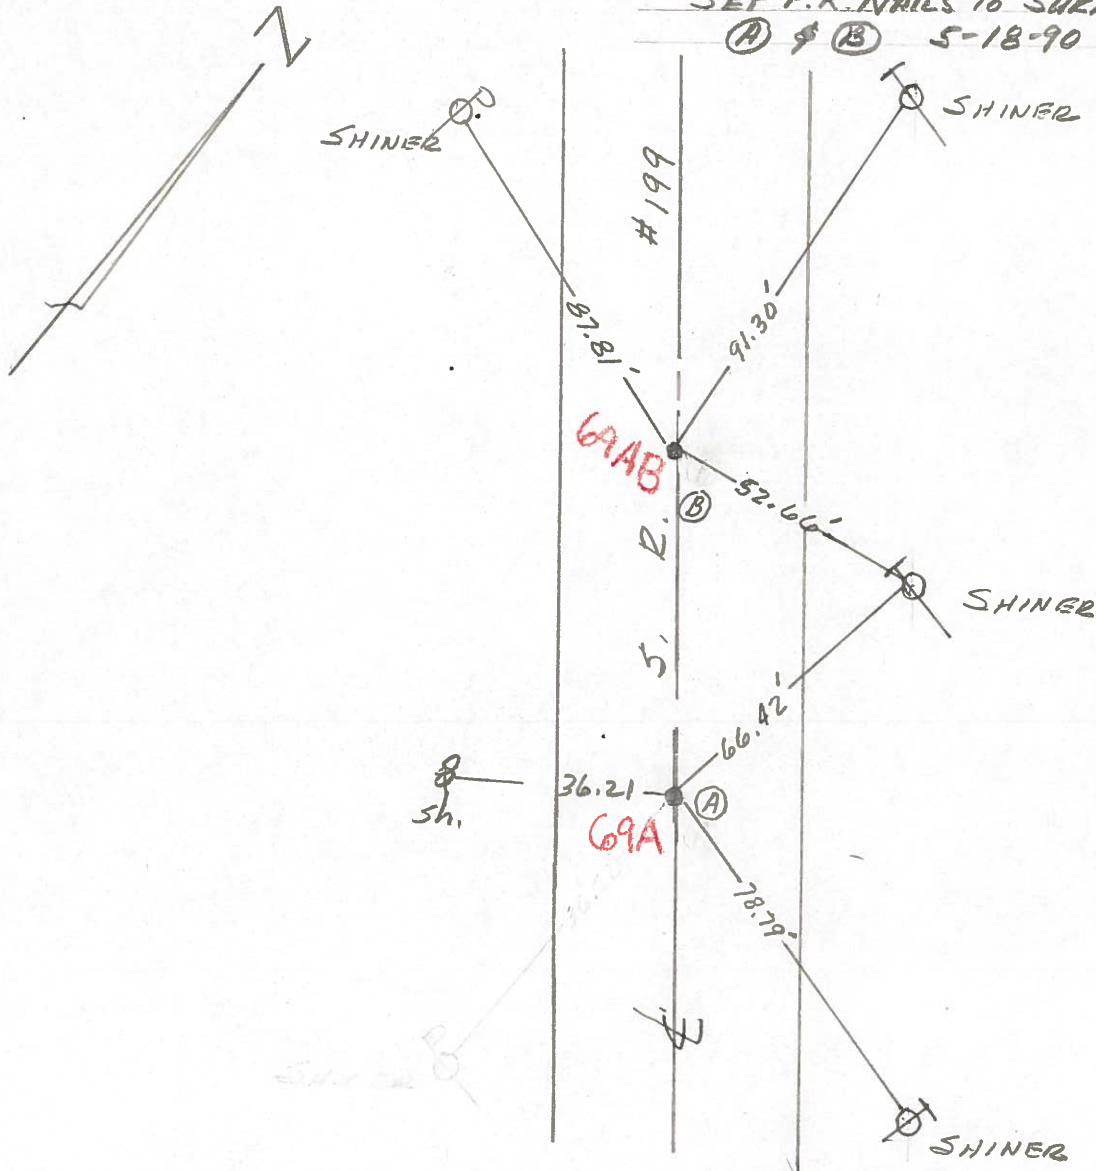

QD.O.T. DISTRICT 2 SURVEY OFFICE

SHEET _____ OF _____

County Wood S.R. 199

Date 1-5-83

Township Perrysburg

Weather Cloudy

Section 17

Temp. +36°

T6N, R EUSR


Personnel HOFFMAN

LOEHRIE

HOUSEHOLDER

BARNHISEL

#69-A

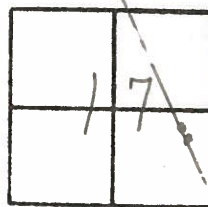

PT "A" Fd P.K. @ SURFACE


S.L.M. 1483+46

1.3' LT & PAUT

8.0' TO W.E.P.

10.7' TO E.E.P.

SET P.K./WASHER
@ BOTH POINTS
7-22-83 M.D.B.

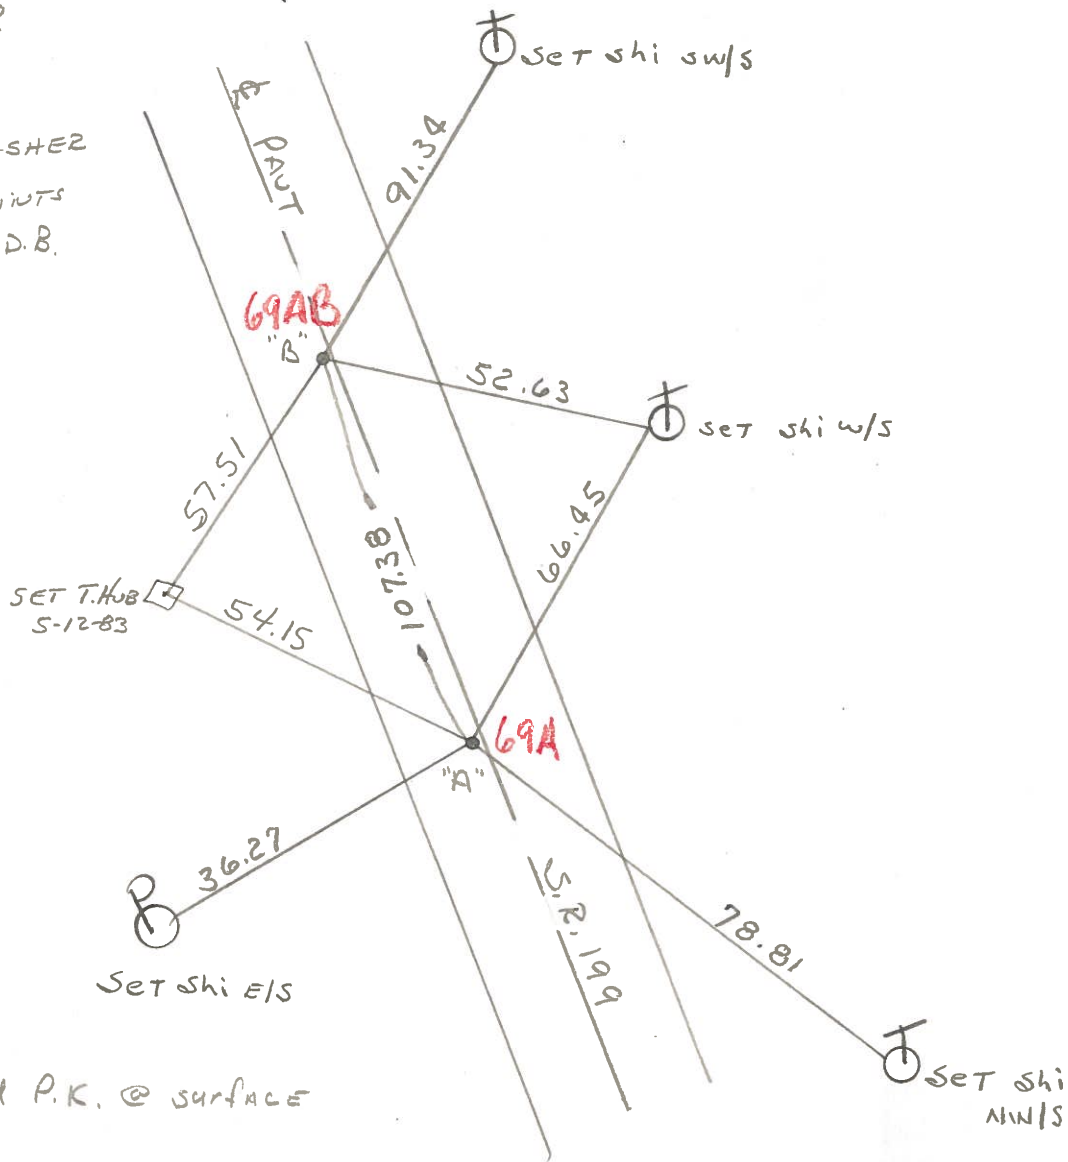

PT. "B" Fd P.K. @ SURFACE