

O.D.O.T. DISTRICT 2 SURVEY OFFICE (USE ONLY)

PERSONNEL

REFERENCE NO. 69 AB

SHEET 72 OF 75

NOTES AUBLE

DATE 4-26-18

ROUTE SR 199

H.C. LEU

WEATHER SUNNY

COUNTY WOOD

R.C. SEAMAN

TEMP. 56°

TOWNSHIP PERRYSBURG

SECTION 17

DWG BY AUBLE

PID 101221

T 6 N R 11 E

TYPE MONUMENT MAG/WASHER

ON SURFACE - ~~BELOW~~ ON

OFFSET ☉ PAVEMENT 1.4' LT : ~~RT~~

8.7' TO LT EDGE PAVEMENT



STATION: 1484+60

HORZ. DATUM: NAD83 (2011)

GEOID: 2012A

GRID: NORTHING: 679290.253

EASTING: 1665410.220

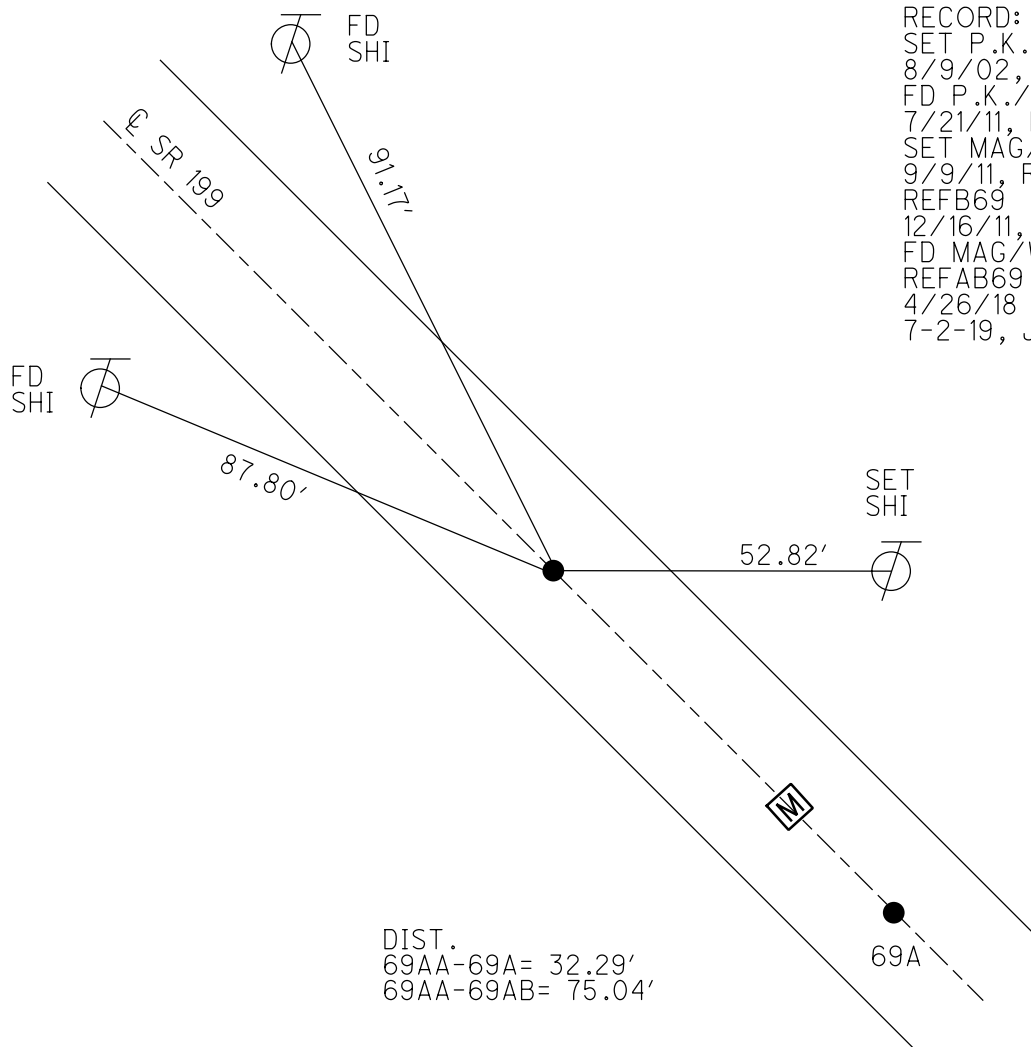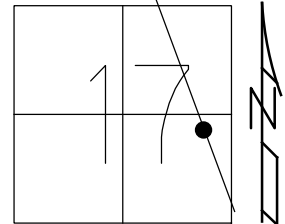


RECORD:
 SET P.K./WASHER
 8/9/02, DCH
 FD P.K./WASHER
 7/21/11, KPM
 SET MAG/WASHER
 9/9/11, RJL
 REFB69
 12/16/11, MC
 FD MAG/WASHER
 REFB69
 4/26/18
 7-2-19, JLL

DIST.
 69AA-69A= 32.29'
 69AA-69AB= 75.04'


O.D.O.T. DISTRICT 2 SURVEY OFFICE (USE ONLY)

PERSONNEL _____ REFERENCE NO. 69 AB SHEET 69 OF 72
 NOTES MOSER DATE 7/21/11 ROUTE SR 199
 H.C. MOSER WEATHER SUNNY COUNTY WOOD
 R.C. HARBAUGH TEMP. 85° TOWNSHIP PERRYSBURG
 SECTION 17
T 6 N R 11 E

TYPE MONUMENT PK/WASHER
 ON SURFACE - ~~BELOW~~ ON
 LEFT - ~~C PAV'T - RIGHT~~ 1.4'
8.7' TO LT EDGE PAVEMENT
 S.L.M. 1484+60

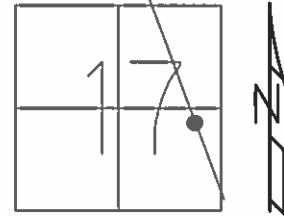

GRID: NORTHING: 679290.251 EASTING: 1665410.177

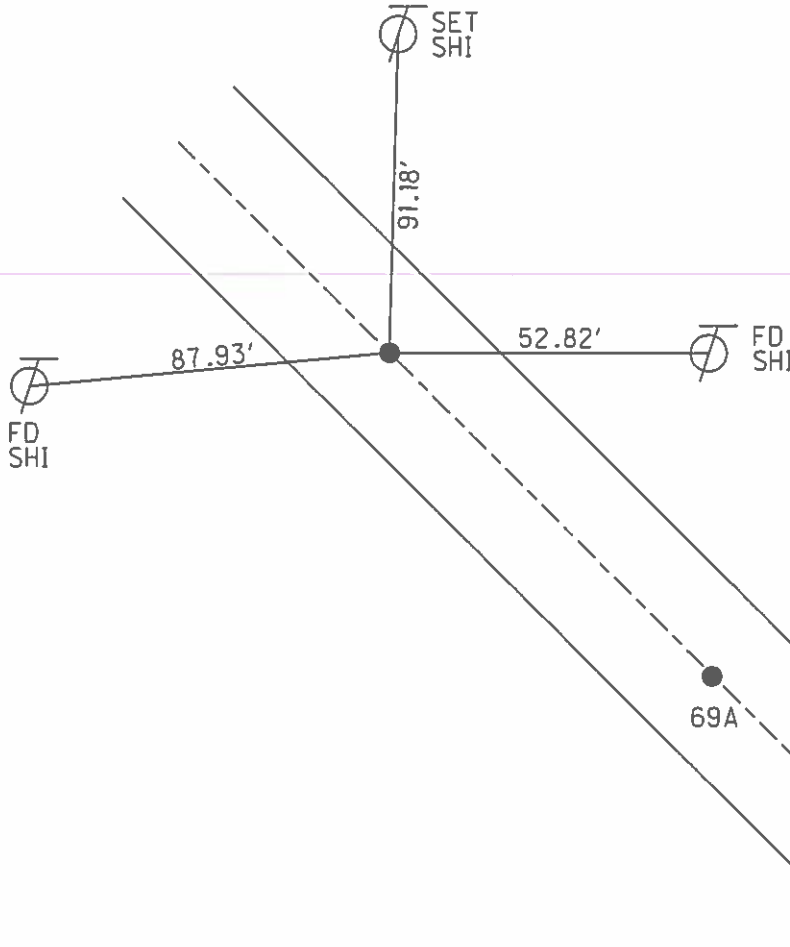

SET MAG/WASHER
8/9/02, DCH

SET MAG/WASHER
9/9/11, RJL

FINAL GPS
REFB69, 12/16/11
MC

DISTANCE BETWEEN
69A-69AB=107.4'

O.D.O.T. DISTRICT 2 SURVEY OFFICE

PERSONNEL

REFERENCE NO. 69A

SHEET 43 OF 45

NOTES MOSER

DATE 4-6-02

ROUTE S.R. 199

H.C. HOMAN

WEATHER SUNNY

COUNTY WOOD

R.C. ROUSOS

TEMP. +40°

TOWNSHIP PERRYSBURG

CANTERBURY

SECTION 17

T 6 N R 11 E


TYPE MONUMENT PK'S & WASHERS

ON SURFACE - ~~BELOW~~ YES


~~LEFT - C PAV'T - RIGHT~~ YES

TO EDGE PAVEMENT

S.L.M. "A" 1483+52 "B" 1484+60

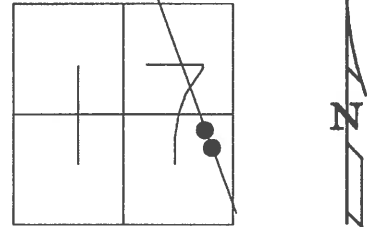

SET MAG NAILS
& WASHERS
8-9-02 D.C.H.

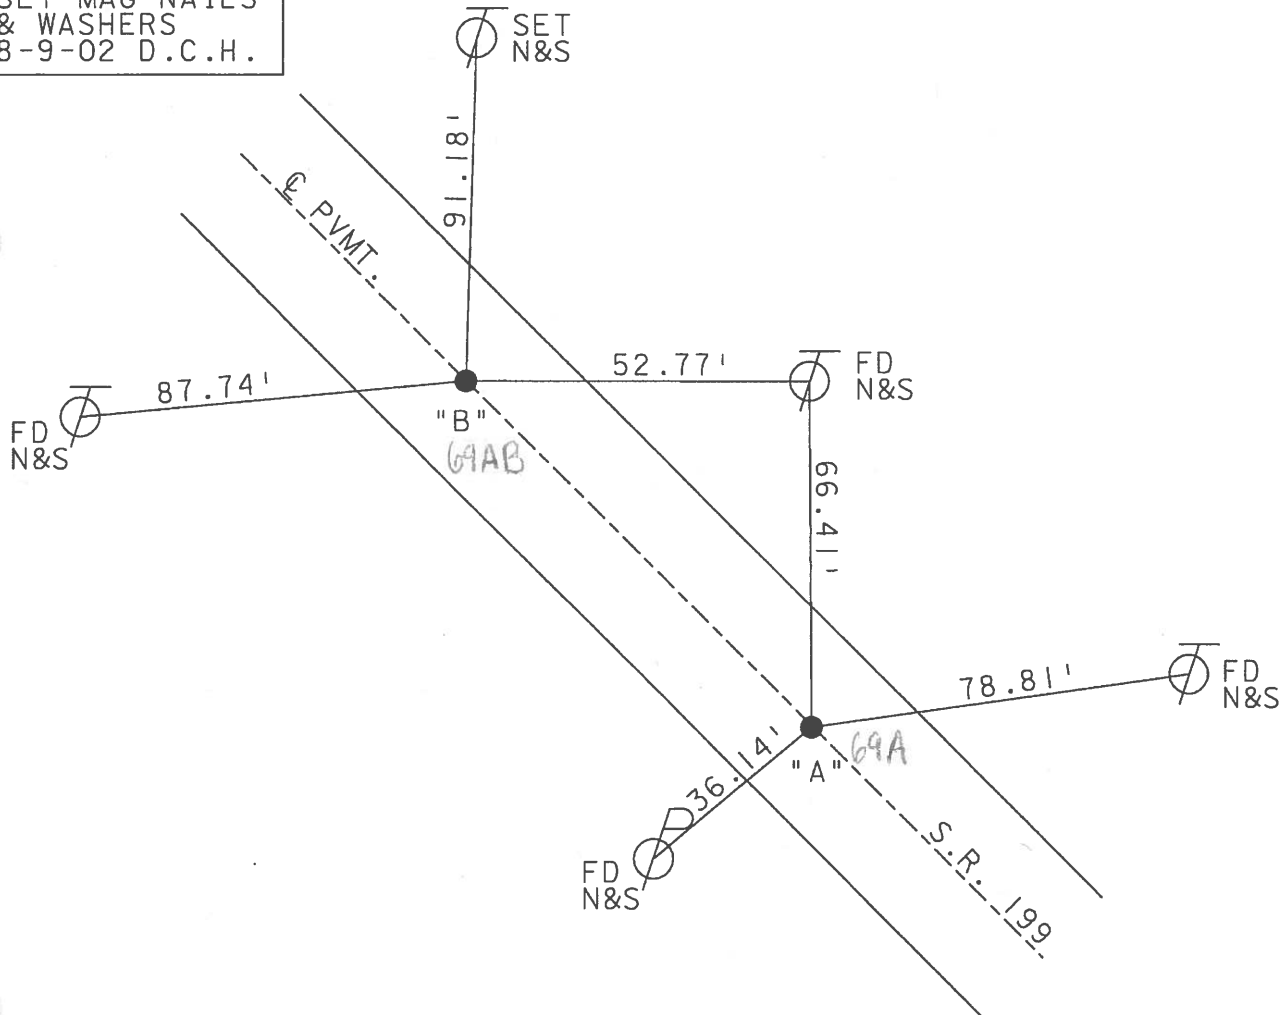

O.D.O.T. DISTRICT 2 SURVEY OFFICE

PERSONNEL _____

REFERENCE NO. 69-A

SHEET 16 OF 21

NOTES D. CURTIS

H.C. J. HOUSEHOLDER

DATE 9-9-88

ROUTE S. R. #199

R.C. _____

WEATHER MILD

COUNTY WOOD

TEMP. 75° ±

TOWNSHIP PERRUSQUEL

SECTION 17

T _____ R _____



TYPE MONUMENT P.K. NAILS IN WASHERS

ON SURFACE - BELOW SURFACE

LEFT- & PAV'T. - RIGHT _____

TO _____ EDGE PAVEMENT

S.L.M. (A) 1483+52 (B) 1484+60

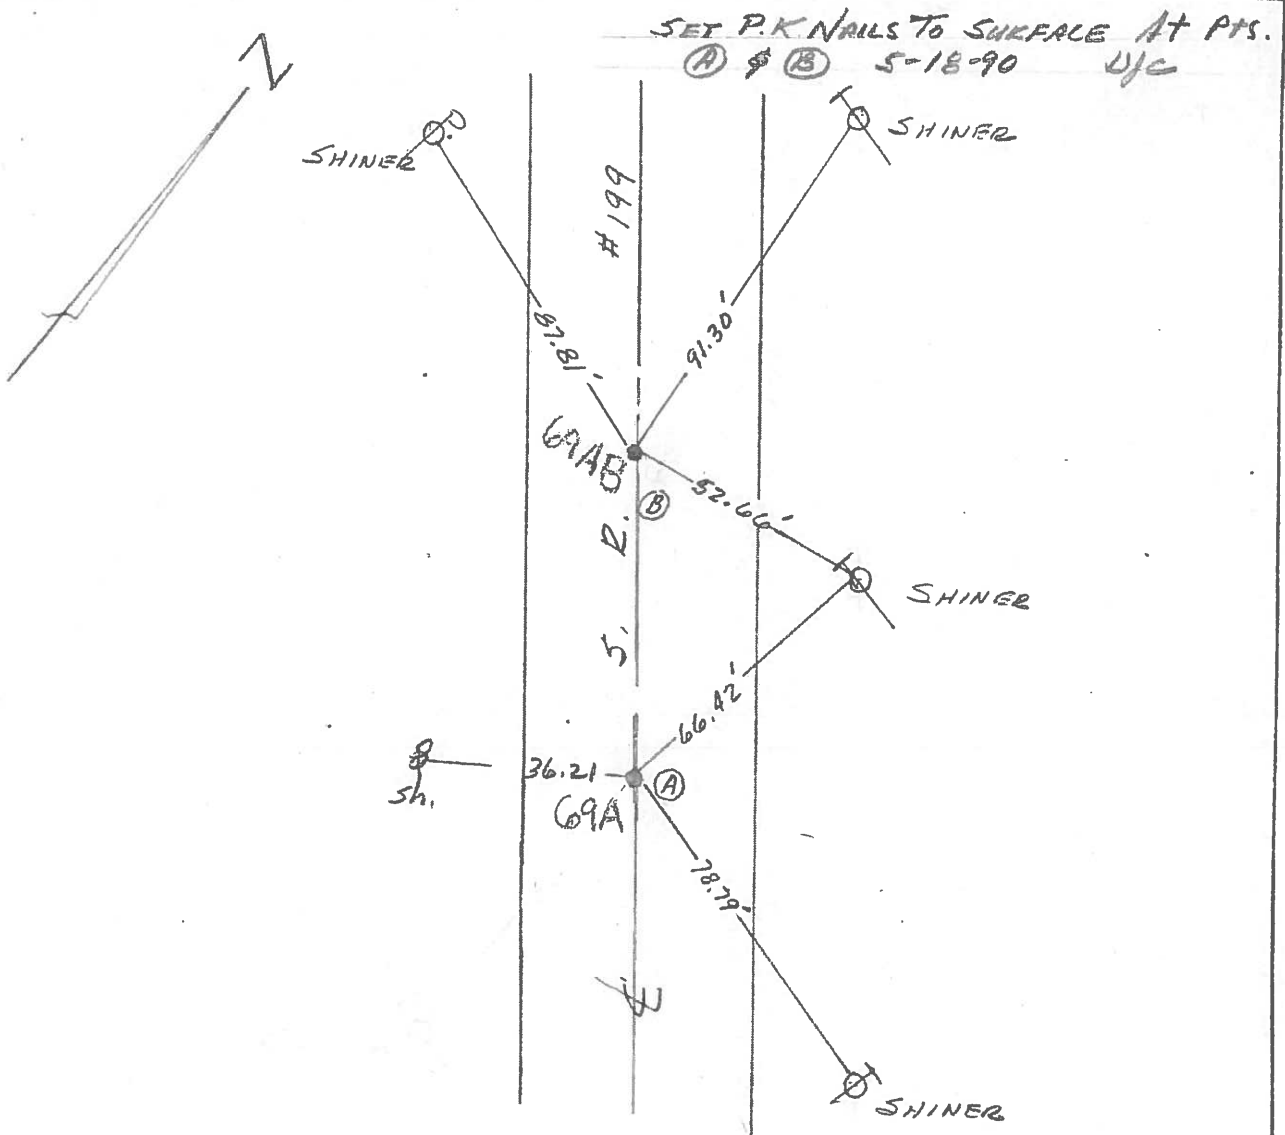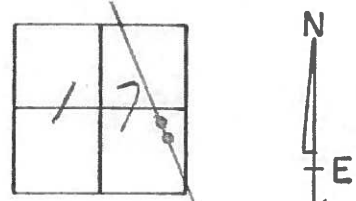

Q.D.O.T. DISTRICT 2 SURVEY OFFICE

SHEET _____ OF _____

County Wood S.R. 199

Date 1-5-83

Township Perrysburg

Weather Cloudy


Section 17

Temp. +36°

T6N, R E USR

Personnel HOFFMAN
LOEMRIG
HOUSEHOLDER
BARNHISEL


#69-A

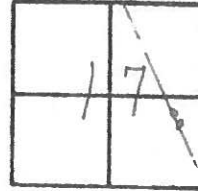

PT "A" Fd P.K. @ surface
 1.3' LT & PAUT
 8.0' TO W.E.P.
 10.7' TO E.E.P.

S.L.M. 14 B3 + 46

SET P.K./WASHER
 @ BOTH POINTS
 7-22-83 M.D.B.

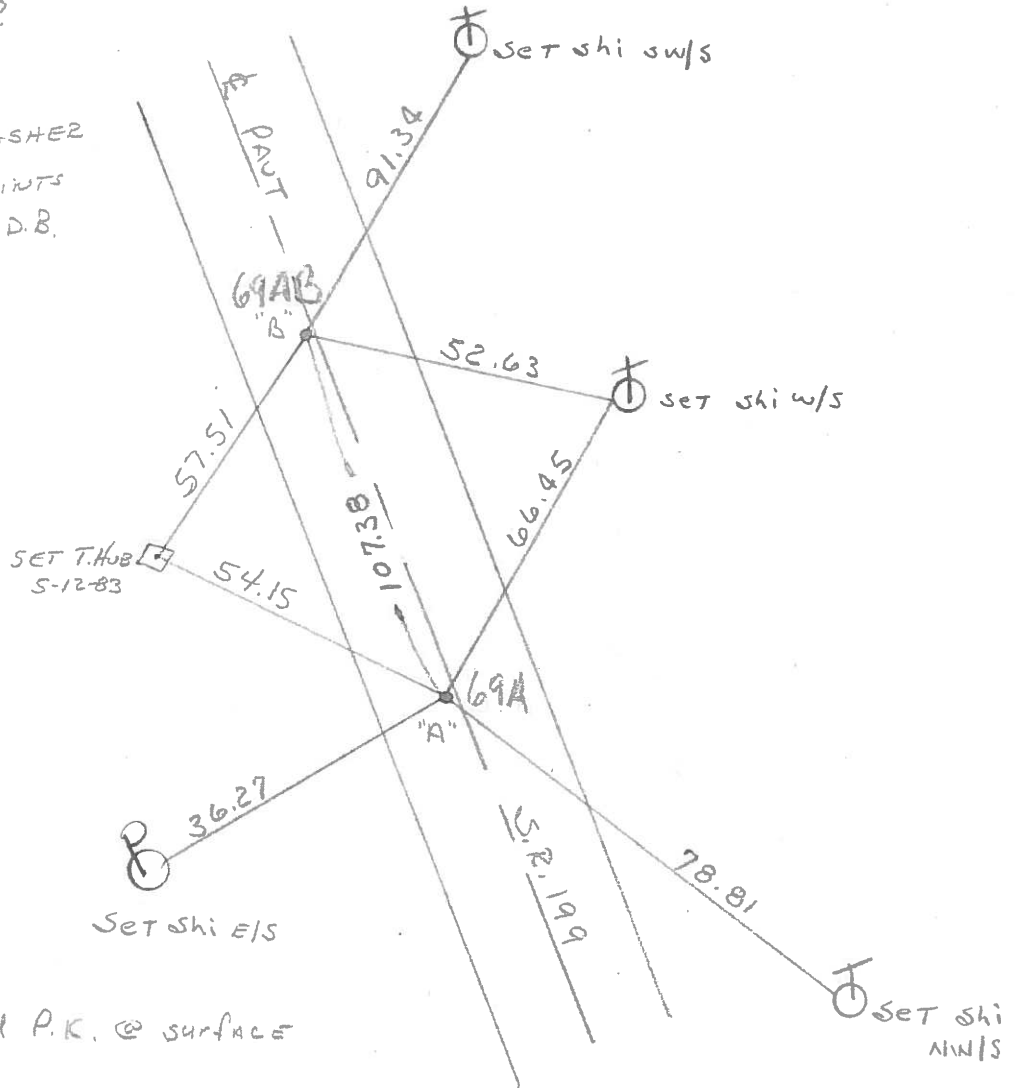

PT. "B" Fd P.K. @ surface