

O.D.O.T. DISTRICT 2 SURVEY OFFICE (USE ONLY)

PERSONNEL

REFERENCE NO. 69 B

SHEET 73 OF 75

NOTES AUBLE

DATE 4-26-18

ROUTE SR 199

H.C. LEU

WEATHER SUNNY

COUNTY WOOD

R.C. SEAMAN

TEMP. 62°

TOWNSHIP PERRYSBURG

SECTION 17

DWG BY AUBLE

PID 101221

T 6 N R 11 E

TYPE MONUMENT MAG/WASHER

ON SURFACE - ~~BELOW~~ ON

OFFSET CL PAVEMENT 0.9' LT : ~~RT~~

9.5' TO LT EDGE PAVEMENT



STATION: 1491+03

HORZ. DATUM: NAD83 (2011)

GEOID: 2012A

GRID: NORTHING: 679867.097

EASTING: 1665125.745

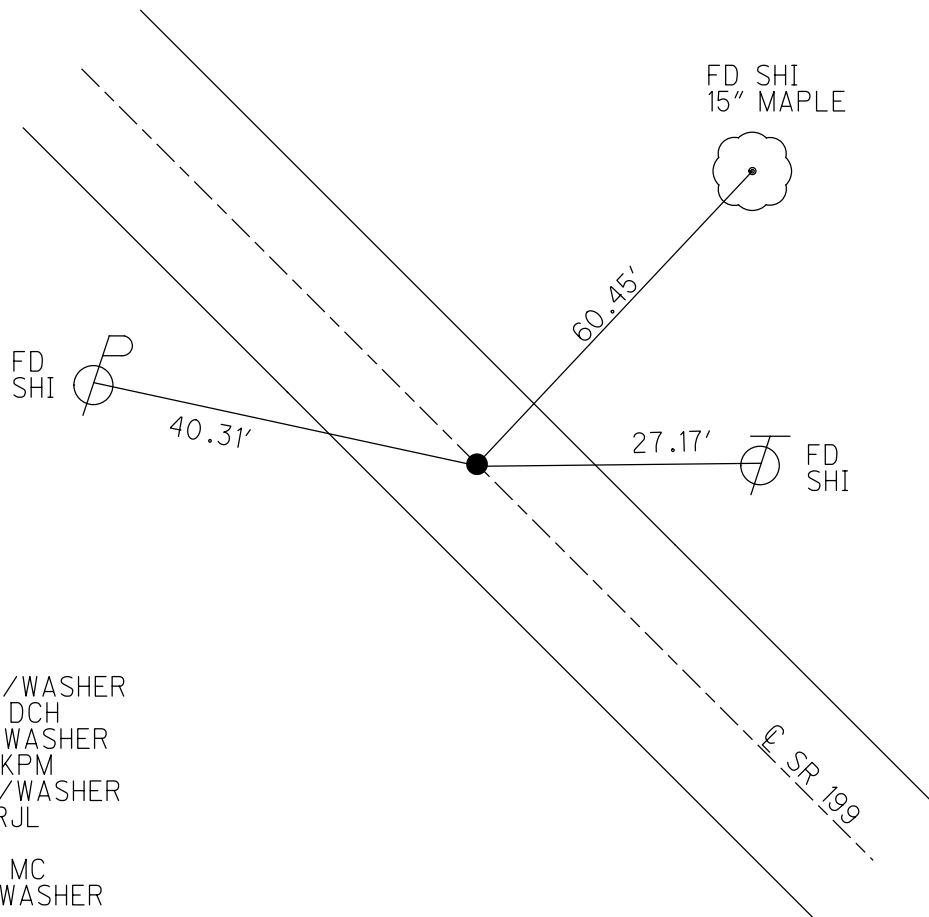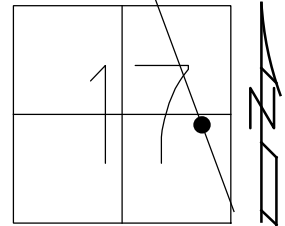


RECORD:
 SET P.K./WASHER
 8/9/02, DCH
 FD P.K./WASHER
 7/21/11, KPM
 SET MAG/WASHER
 9/9/11, RJL
 REFC69
 12/16/11, MC
 FD MAG/WASHER
 REFB69
 4/26/18
 7-2-19, JLL


O.D.O.T. DISTRICT 2 SURVEY OFFICE (USE ONLY)

PERSONNEL	REFERENCE NO.	69 B	SHEET	70 OF 72	
NOTES	MOSER	DATE	7/21/11	ROUTE	SR 199
H.C.	MOSER	WEATHER	SUNNY	COUNTY	WOOD
R.C.	HARBAUGH	TEMP.	85°	TOWNSHIP	PERRYSBURG
				SECTION	17
				T	6 N R 11 E

TYPE MONUMENT PK/WASHER
 ON SURFACE - ~~BELOW~~ ON
 LEFT - ~~C PAV'T~~ - ~~RIGHT~~ 0.9'
9.5' TO LT EDGE PAVEMENT
 S.L.M. 1491+03

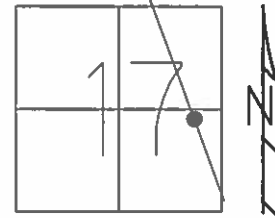

GRID: NORTHING: 679867.137 EASTING: 1665125.683

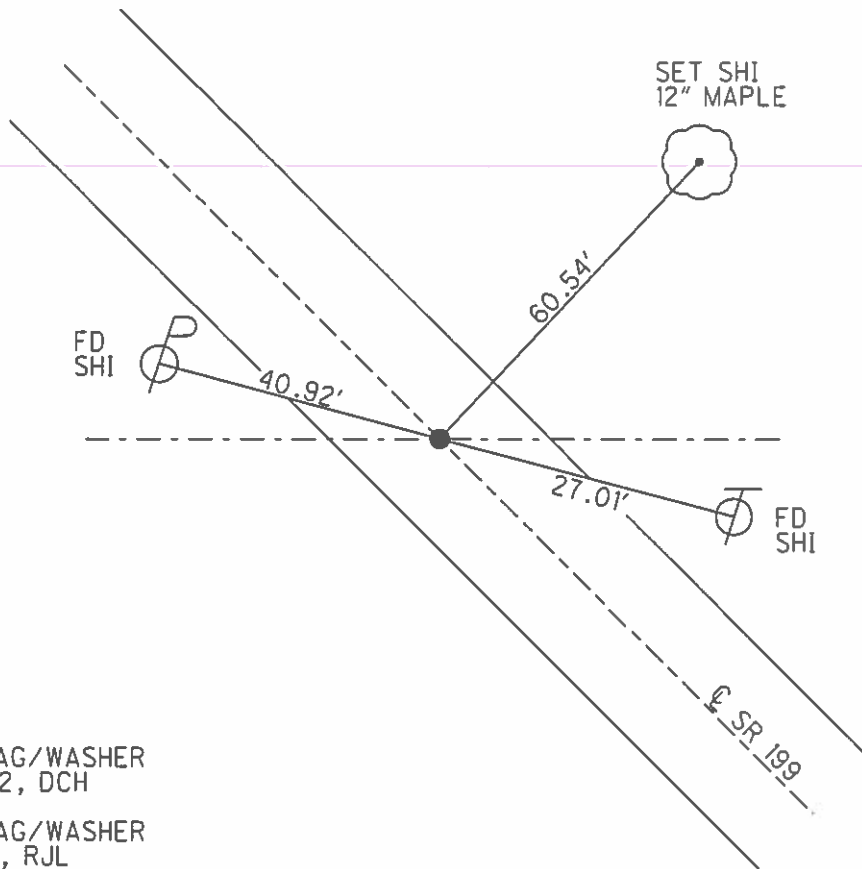

SET MAG/WASHER
8/9/02, DCH

SET MAG/WASHER
9/9/11, RJL

FINAL GPS
REFC69, 12/16/11
MC

O.D.O.T. DISTRICT 2 SURVEY OFFICE

PERSONNEL

REFERENCE NO. 69B

SHEET 44 OF 45

NOTES MOSER

DATE 4-6-02

ROUTE S.R. 199

H.C. HOMAN

WEATHER SUNNY

COUNTY WOOD

R.C. ROUSOS

TEMP. +40°

TOWNSHIP PERRYSBURG

 CANTERBURY

SECTION 17

T 6 N R 11 E


TYPE MONUMENT PK & WASHER

ON SURFACE - ~~BELOW~~ YES


~~LEFT - C~~ PAV'T - ~~RIGHT~~ YES

 TO EDGE PAVEMENT

S.L.M. 1491+03

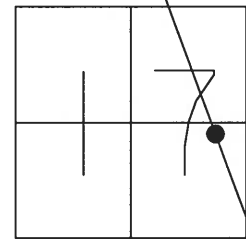

SET MAG NAIL
& WASHER
8-9-02 D.C.H.

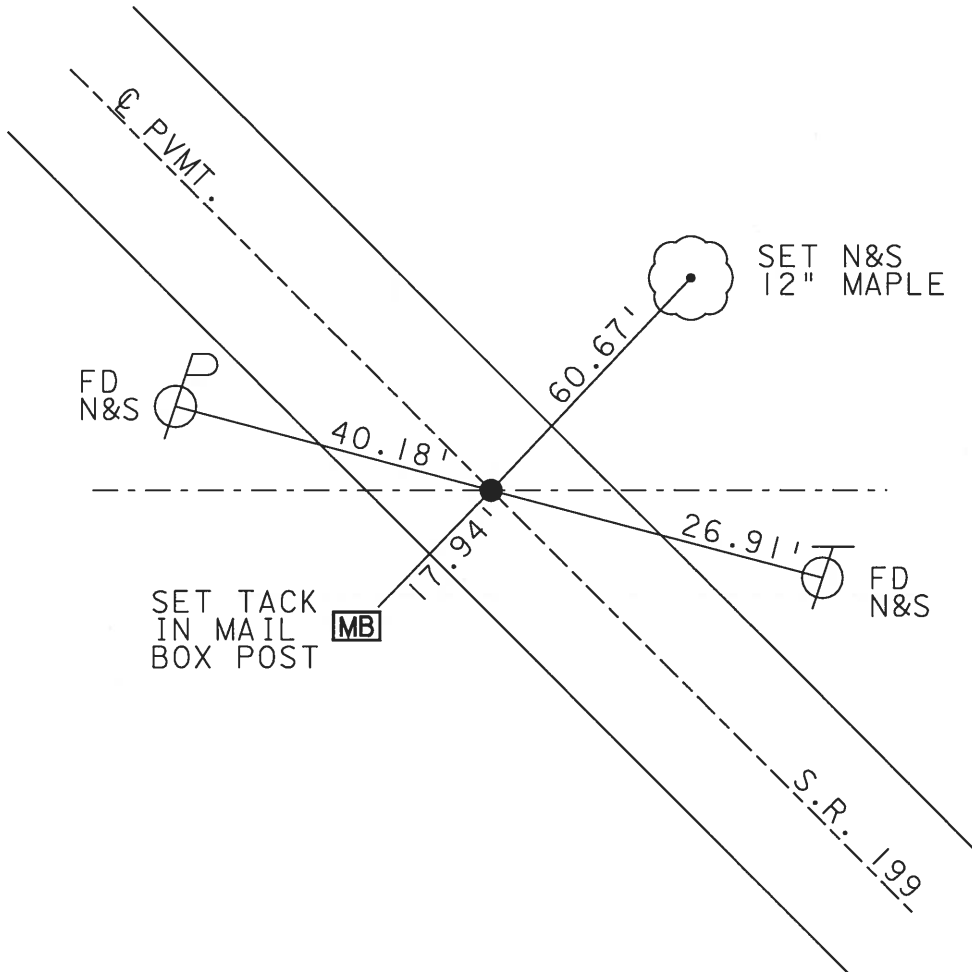

O.D.O.T. DISTRICT 2 SURVEY OFFICE

PERSONNEL

REFERENCE NO. 69-B

SHEET 17 OF 21

NOTES D. CURTIS

H.C. J. HOUSEHOLDER DATE 9-9-88

R.C. _____ WEATHER MILD

_____ TEMP. 75°±

ROUTE S.R. #199

COUNTY WOOD

TOWNSHIP PERRYSBURG

SECTION 17

T _____ R _____


TYPE MONUMENT P.K. NAIL IN WASHER

ON SURFACE - BELOW SURFACE


LEFT- & PAV'T. - RIGHT _____

_____ TO _____ EDGE PAVEMENT

S.L.M. 1491 + 03

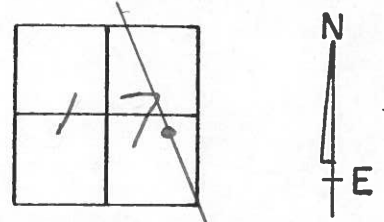

SET P.K. NAIL TO SURFACE
5-18-90 DJC

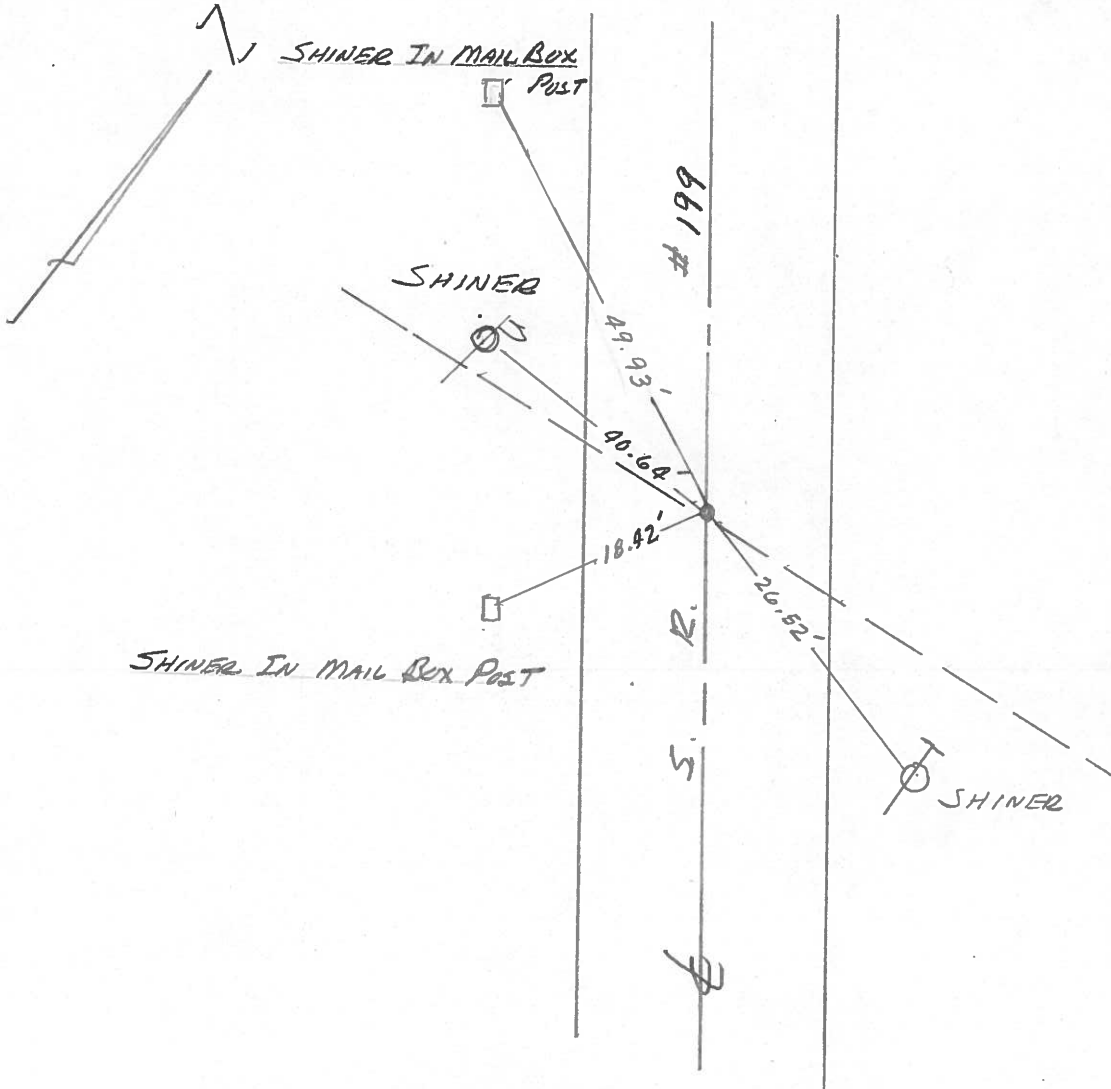

County Wood S.R. 199

Date 1-5-83

Township Perryburg

Weather Cloudy

Section 17

Temp. +36°

T6N, R E58R


Personnel HOFFMAN

LOEHRKE

HOUSEHOLDER

BARNHISEL

#69-B

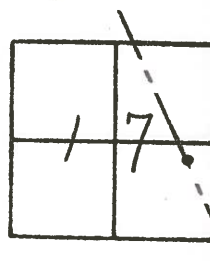

Fd P.K. @ surface
 0.7' Lt. of & PAUT
 9.2' TO W.E.P.
 9.8' TO E.E.P.

S.L.M. 1490 + 97

SET P.K./WASHER
 7-22-83 M.D.B.

"REASONS"
 SET Shi mail BOX

49.84

SET Shi
 E/S

40.30

18.35

SET Shi mailbox
 "FOX"

26.82

SET Shi NW/S

