

O.D.O.T. DISTRICT 2 SURVEY OFFICE (USE ONLY)

PERSONNEL

REFERENCE NO. 70

SHEET 74 OF 75

NOTES AUBLE DATE 4-26-18  
 H.C. LEU WEATHER SUNNY  
 R.C. SEAMAN TEMP. 62°

ROUTE SR 199  
 COUNTY WOOD  
 TOWNSHIP PERRYSBURG  
 SECTION 17  
 T 6 N R 11 E

DWG BY AUBLE PID 101221

TYPE MONUMENT MAG/WASHER

ON SURFACE - ~~BELOW~~ ON

OFFSET 5.8' LT : ~~RT~~

- TO - EDGE PAVEMENT



STATION: 1498+57

HORZ. DATUM: NAD83 (2011)

GEOID: 2012A

GRID: NORTHING: 680541.077

EASTING: 1664787.016

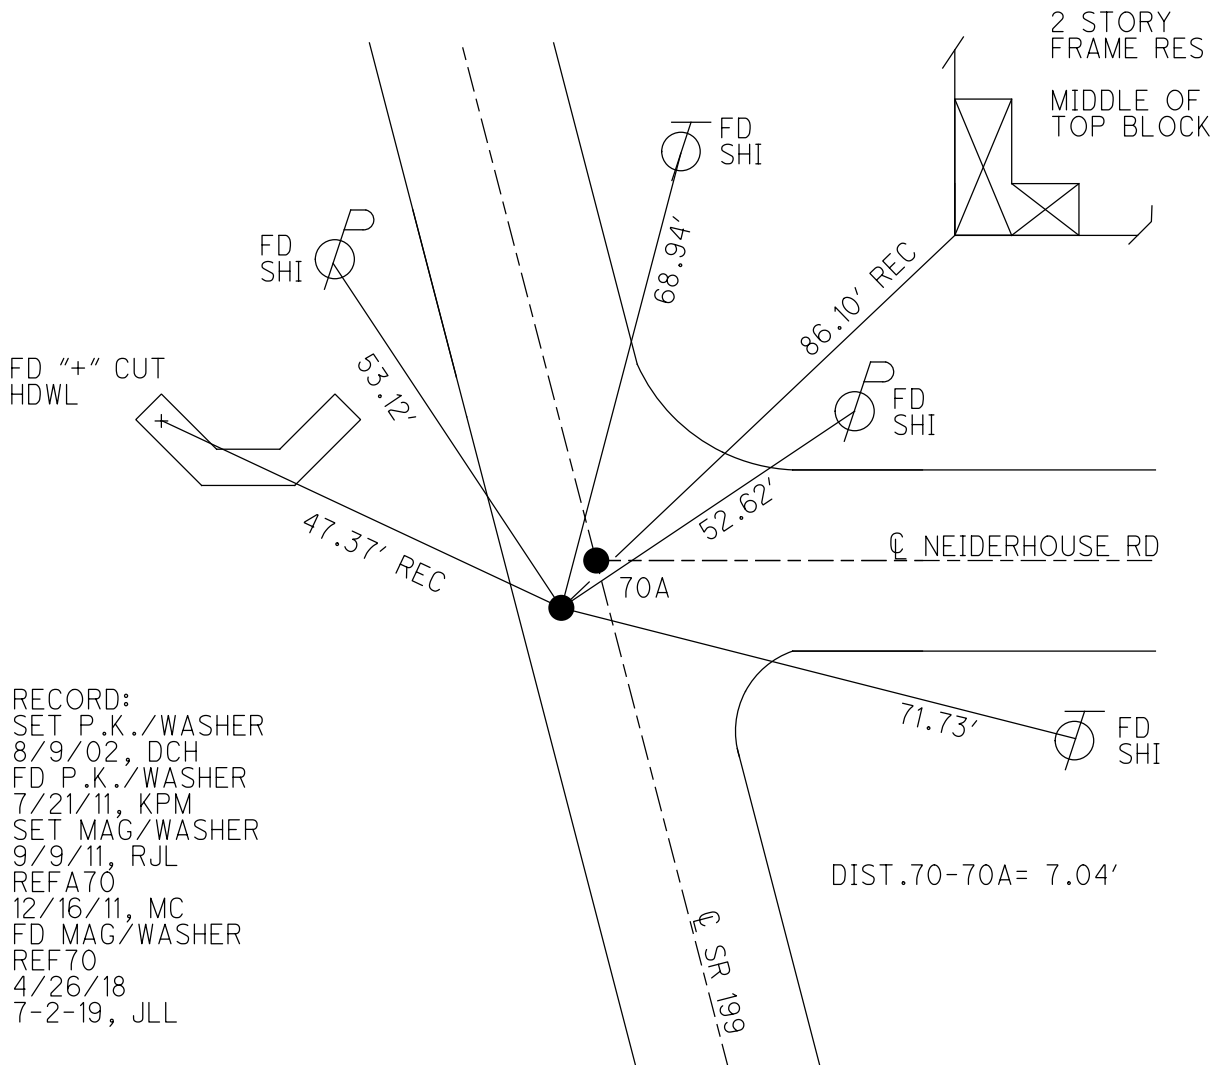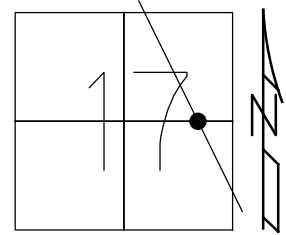


RECORD:  
 SET P.K./WASHER  
 8/9/02, DCH  
 FD P.K./WASHER  
 7/21/11, KPM  
 SET MAG/WASHER  
 9/9/11, RJL  
 REFA70  
 12/16/11, MC  
 FD MAG/WASHER  
 REF70  
 4/26/18  
 7-2-19, JLL


**O.D.O.T. DISTRICT 2 SURVEY OFFICE (USE ONLY)**

PERSONNEL \_\_\_\_\_ REFERENCE NO. 70 SHEET 71 OF 72  
 NOTES MOSE DATE 7/21/11 ROUTE SR 199  
 H.C. MOSE WEATHER SUNNY COUNTY WOOD  
 R.C. HARBAUGH TEMP. 85° TOWNSHIP PERRYSBURG  
 \_\_\_\_\_ SECTION 17  
 \_\_\_\_\_ T 6 N R 11 E

TYPE MONUMENT PK/WASHER  
 ON SURFACE - ~~BELOW~~ ON  
 LEFT - ~~C PAVT~~ - ~~RIGHT~~ 5.0'  
 \_\_\_\_\_ TO \_\_\_\_\_ EDGE PAVEMENT  
 S.L.M. 1498+57

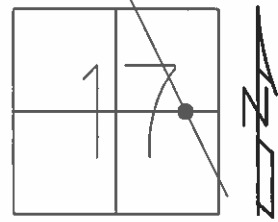

GRID: NORTHING: 680541.118 EASTING: 1664786.931

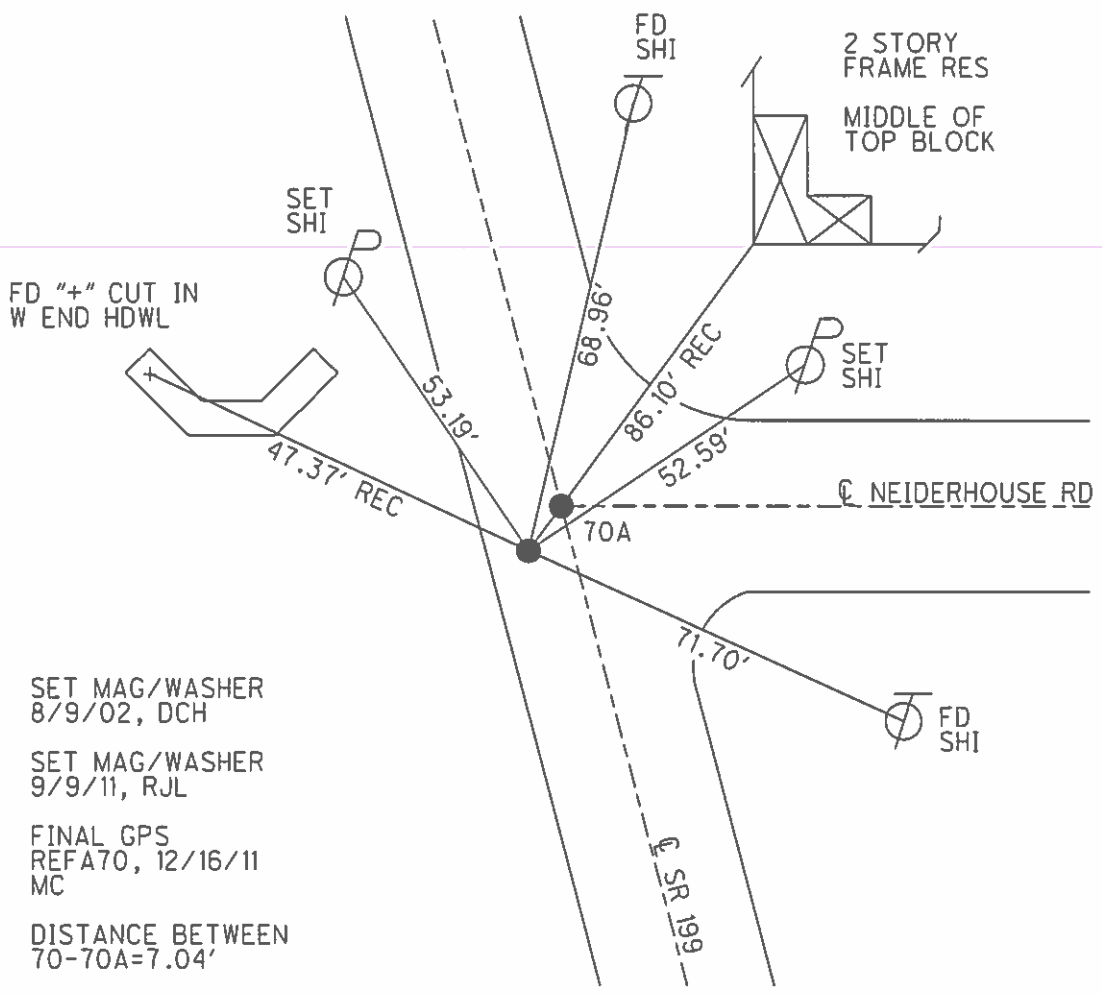

# O.D.O.T. DISTRICT 2 SURVEY OFFICE

PERSONNEL \_\_\_\_\_

REFERENCE NO. 70

SHEET 18 OF 21

NOTES D. CURTIS

H.C. J. HOUSEHOLDER

DATE 9-9-88

ROUTE S.R. #199

R.C. \_\_\_\_\_

WEATHER MILD

COUNTY WOOD

TEMP. 75°±

TOWNSHIP PERRYBURG

SECTION 17

T. \_\_\_\_\_ R. \_\_\_\_\_


TYPE MONUMENT P.K. NAILS IN WASHERS

ON SURFACE - BELOW SURFACE


LEFT-☉ PAV'T. - RIGHT \_\_\_\_\_

TO \_\_\_\_\_ EDGE PAVEMENT

S.L.M. (B) 1498+57 (A) 1498+60

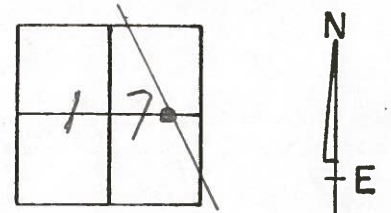

SET P.K. NAILS TO SURFACE AT PTS:  
 (A) & (B) 5-18-90 AJC

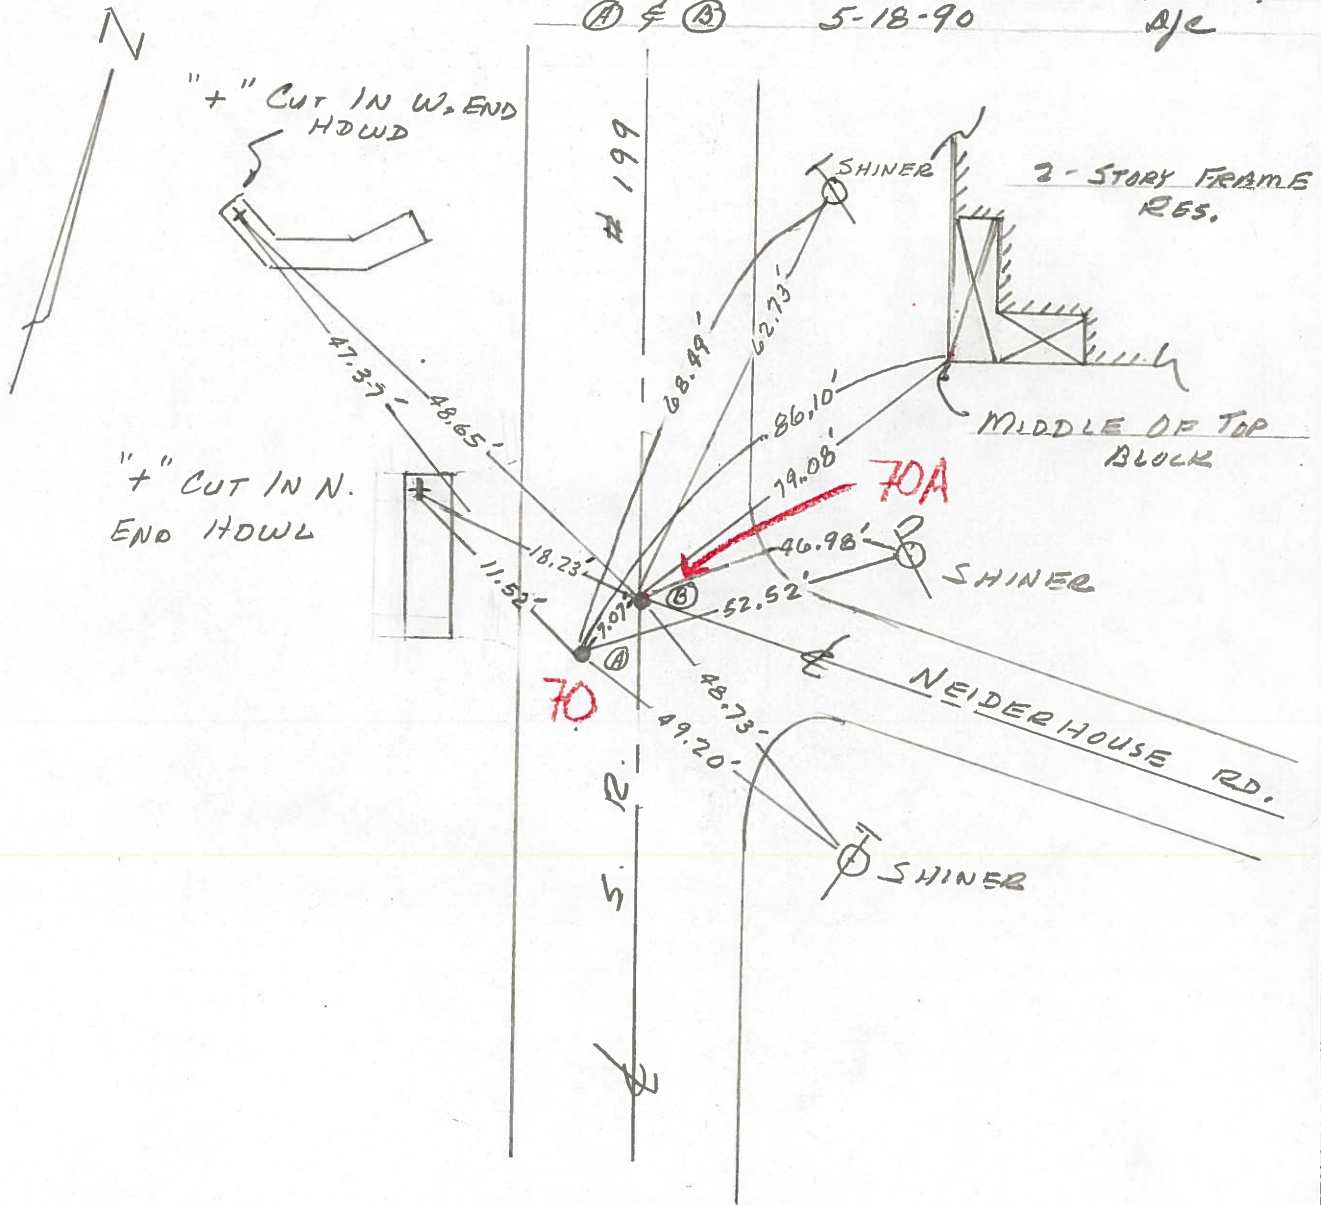



County WOOD S.R. 199

Township PERRYS BURG

Section 17

T N, R E

Personnel TOMSIK

NEUSER

VANYO

GRANATA

Date SEPT. 9 - 1971


Weather \_\_\_\_\_


Temp. \_\_\_\_\_

17	16
20	21



#70

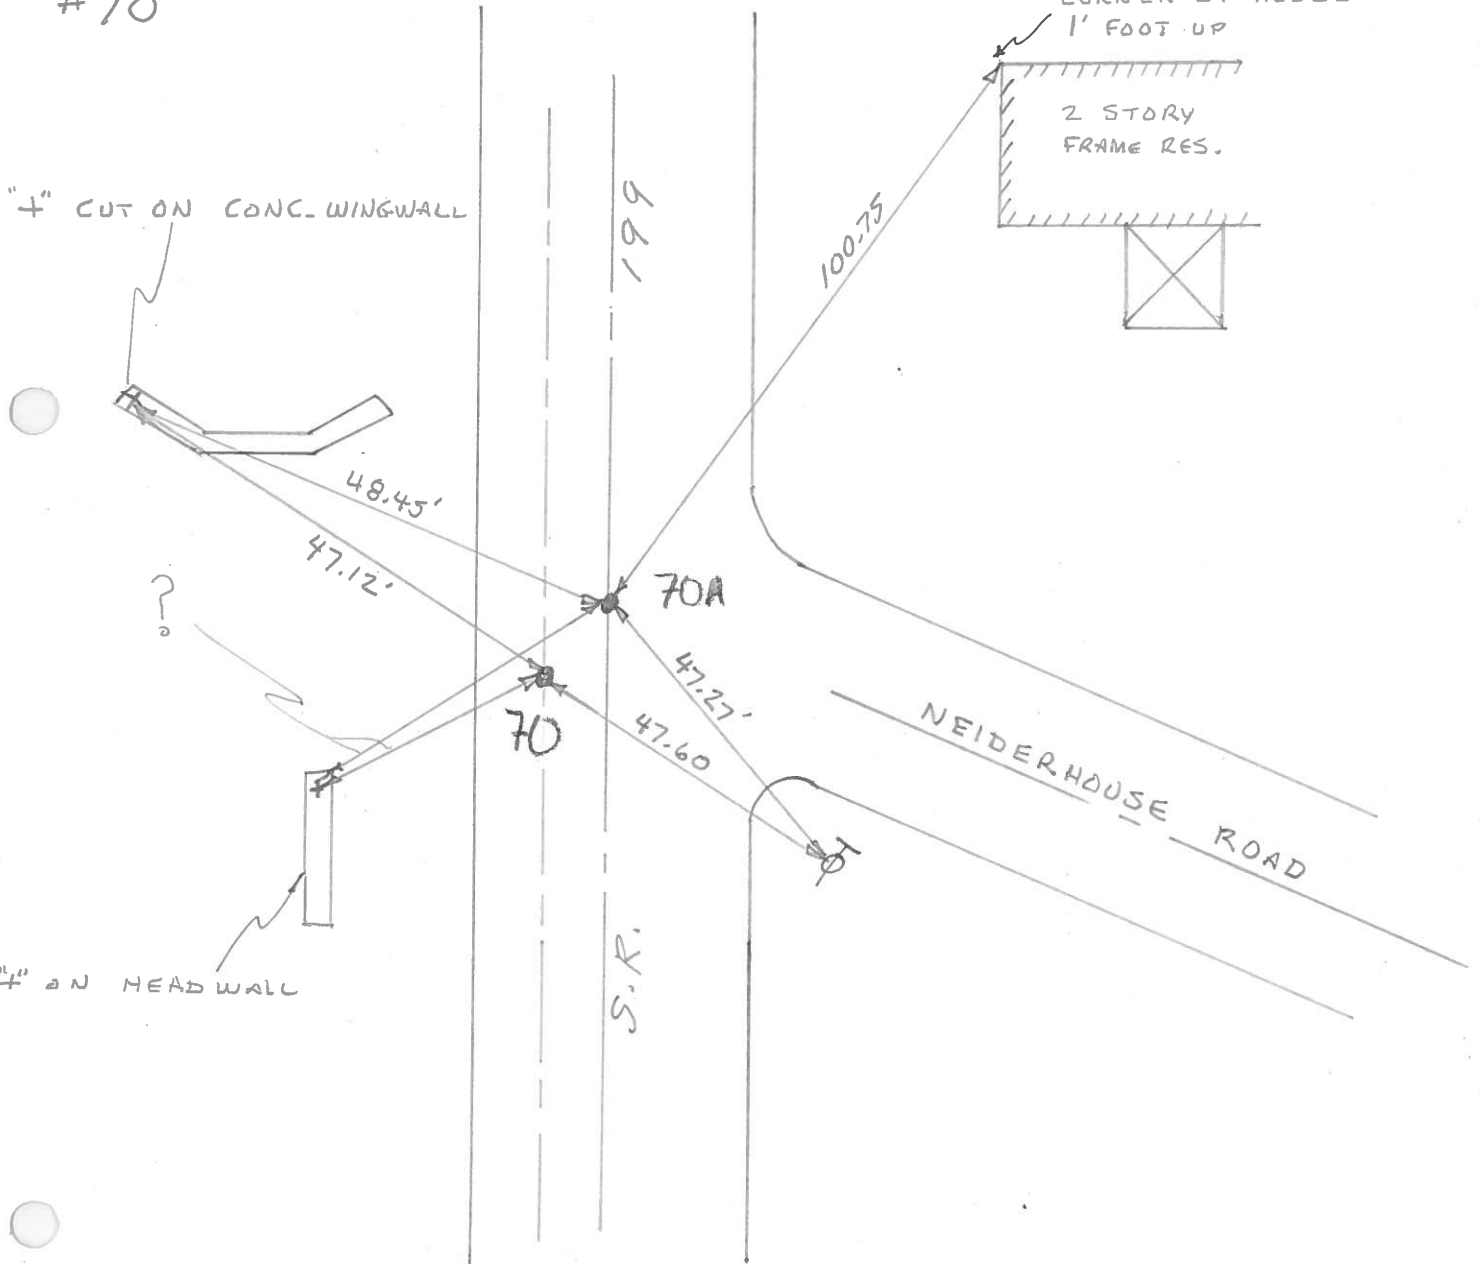

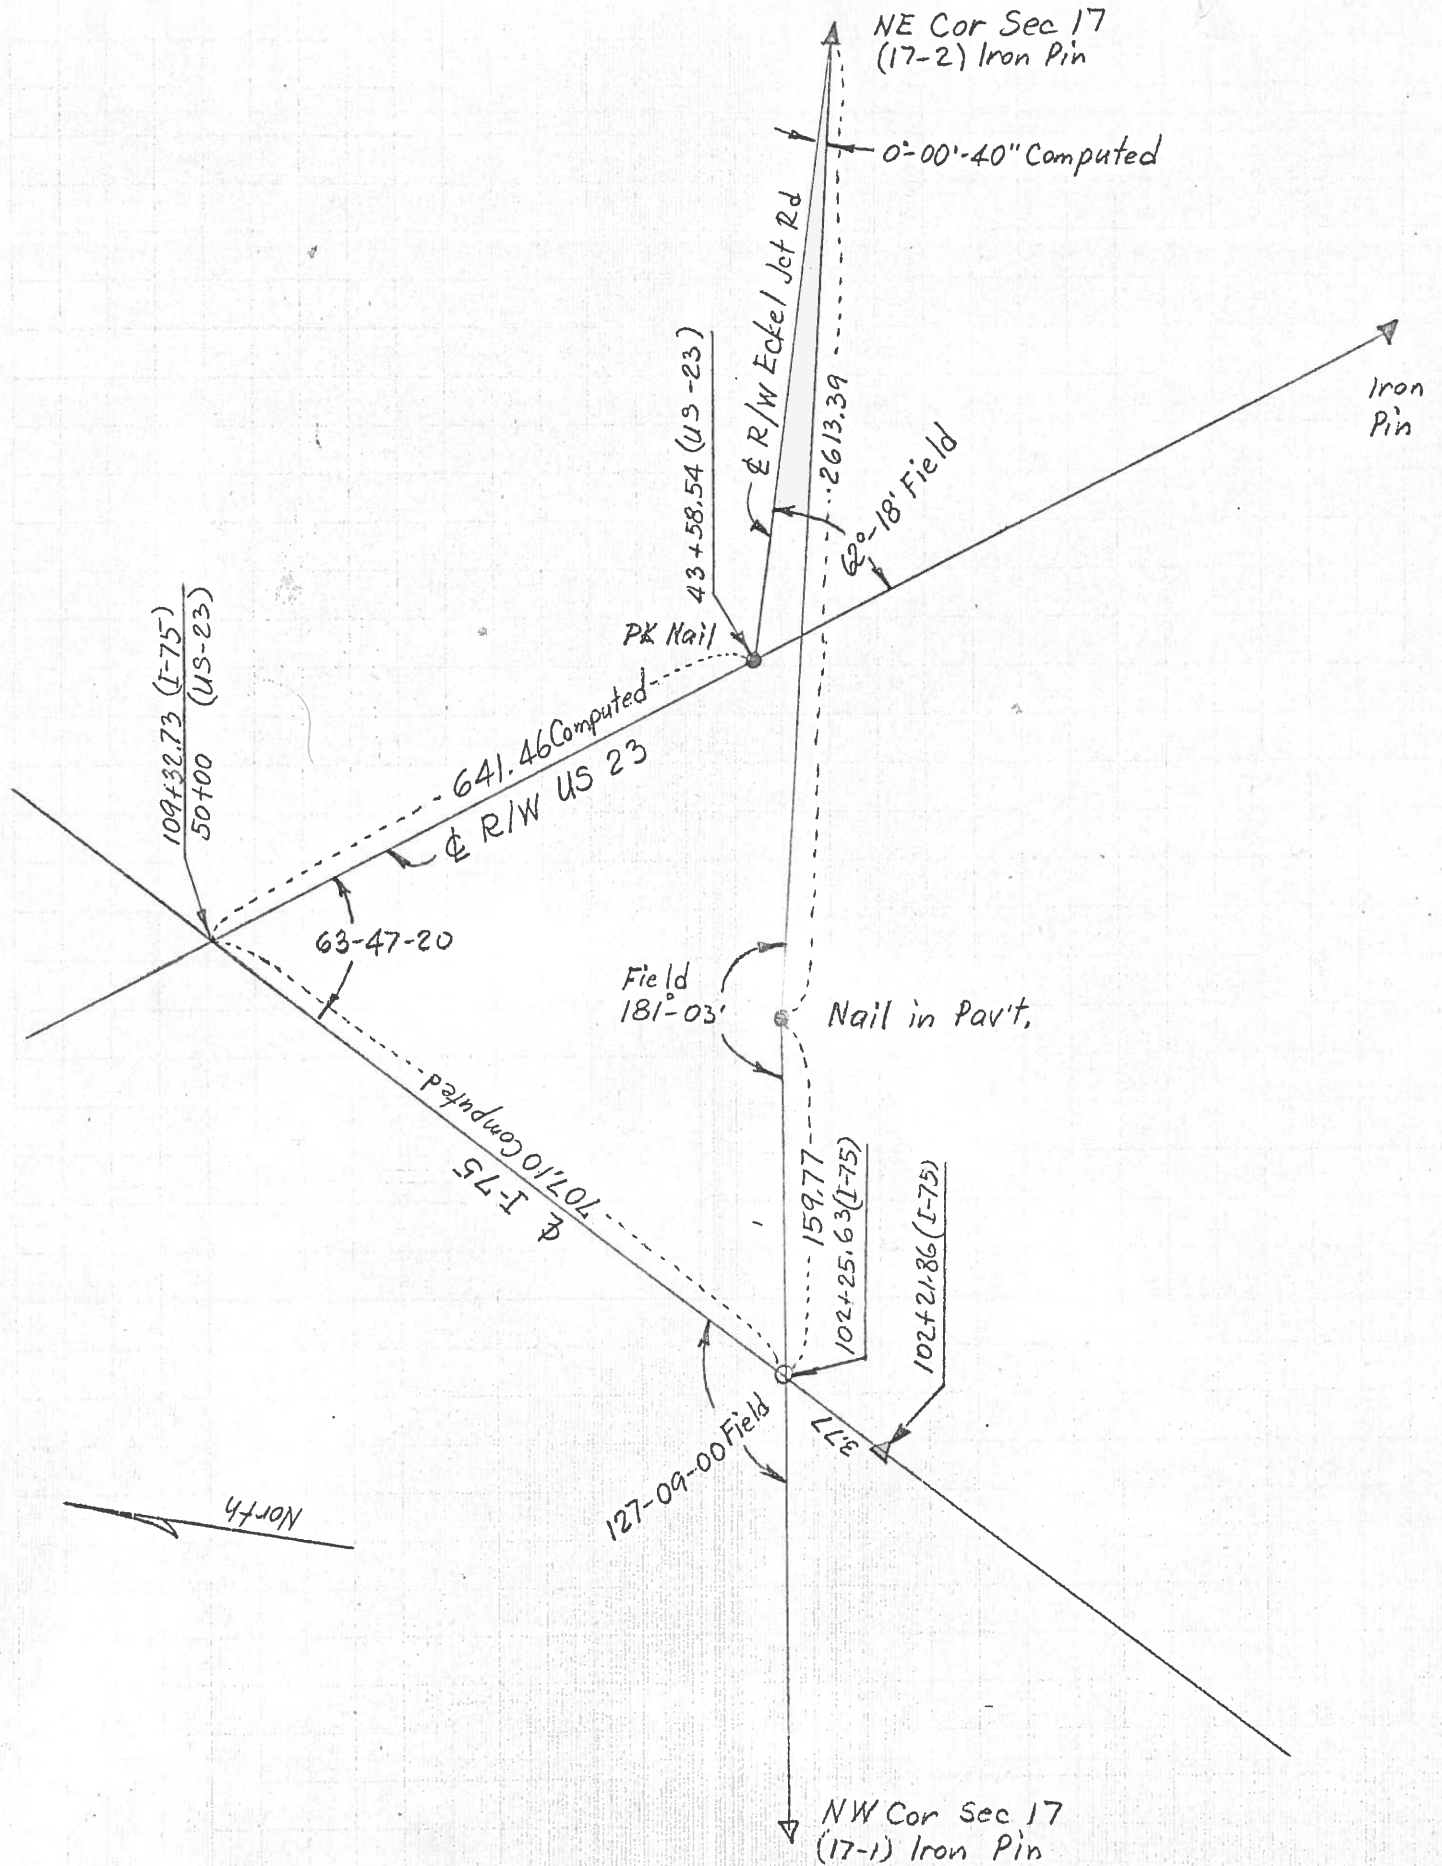

PERSONNEL	TITLE	PERSONNEL	TITLE
Tomsic			
Neuser			
Vanyo			
Granata			

COUNTY WOOD DATE Sept. 9-71

S. R. 199 WEATHER \_\_\_\_\_

SEC. \_\_\_\_\_ TEMP. \_\_\_\_\_

DESCRIPTION \_\_\_\_\_ LEFT \_\_\_\_\_ CENTER LINE \_\_\_\_\_ RIGHT \_\_\_\_\_ JOB NO. \_\_\_\_\_

