


O.D.O.T. DISTRICT 2 SURVEY OFFICE (USE ONLY)


PERSONNEL _____ REFERENCE NO. 71 SHEET 1 OF 9
 NOTES BURNSIDE DATE 7/2/70 ROUTE SR 199
 H.C. HOFFMAN WEATHER CLEAR COUNTY WOOD
 R.C. _____ TEMP. 85° TOWNSHIP PERRYSBURG
 DWG BY NIESE PID _____ SECTION 8
 T 4 US

TYPE MONUMENT R.R. SPIKE
 ON SURFACE - ~~BELOW~~ ON _____
 OFFSET ☉ PAVEMENT ON _____ LT : RT
 - _____ TO - _____ EDGE PAVEMENT
 STATION: 1560+36.9

HORZ.DATUM: _____ GEOID: _____
 GRID: NORTHING: _____ EASTING: _____

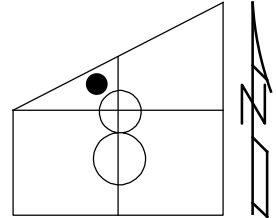

RECORD:
 STA. 1552+80.5
 1987 PLANS
 FD R.R. SPIKE
 7/2/70, BURNSIDE

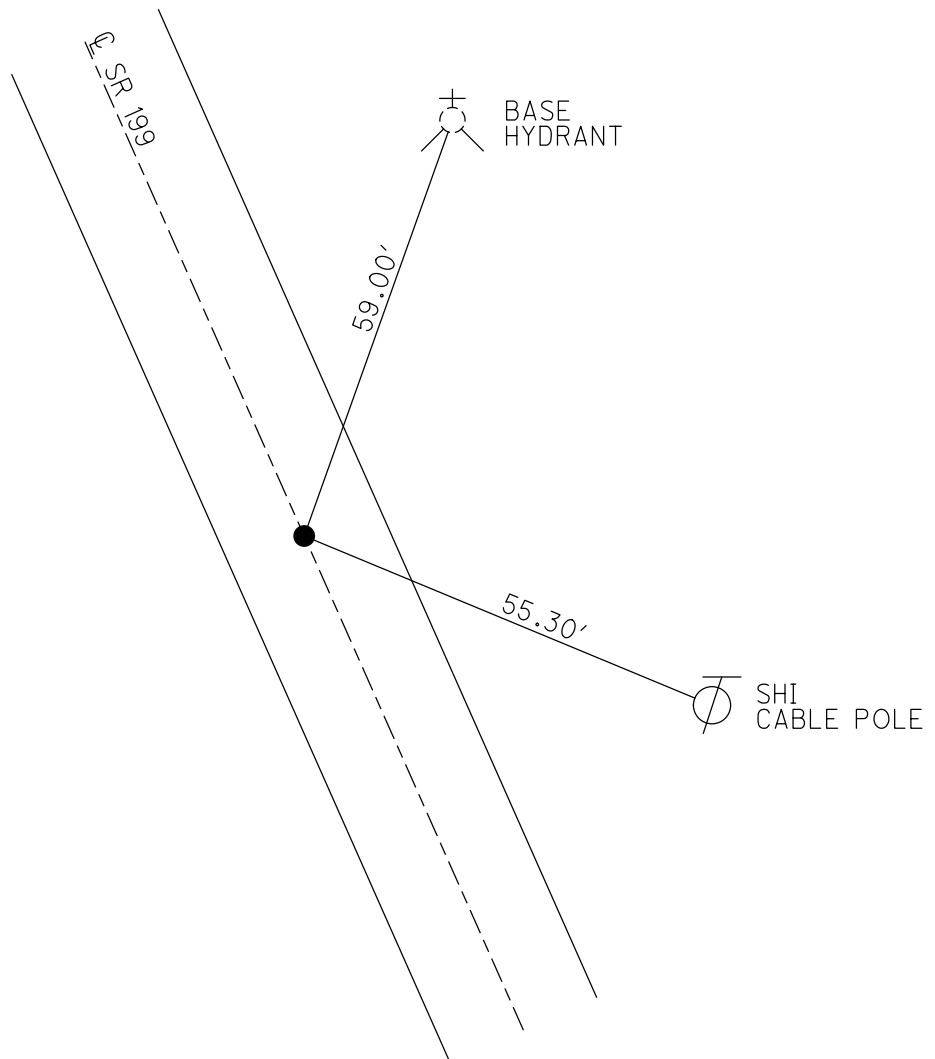

PERSONNEL TITLE PERSONNEL TITLE

BURNSIDE
HOFFMAN

COUNTY WOOD DATE 7-2-70

S. R. 199 (OLD 23) WEATHER CLEAR

SEC. FERRYSBURG TEMP. +85°

DESCRIPTION R.R. SPK'S (FOUND BEFORE RE-SURFACE) JOB NO. _____

LEFT

CENTER LINE

RIGHT

FD. R.R. Spk.
1557+09.3 S.L.M.

Stk. ϕ 30.33'

46.90'

Stk. Pole Pole

FD. R.R. Spk.
1552+80.5± S.L.M.

59.00'

BASE HYD.

55.30'

Stk. Pole Pole