

O.D.O.T. DISTRICT 2 SURVEY OFFICE (USE ONLY)

PERSONNEL _____

REFERENCE NO. 71 A

SHEET 2 OF 9

NOTES BURNSIDE

DATE 7/2/70

ROUTE SR 199

H.C. HOFFMAN

WEATHER CLEAR

COUNTY WOOD

R.C. _____

TEMP. 85°

TOWNSHIP PERRYSBURG

DWG BY NIESE

PID _____

SECTION 8

T 4 US

TYPE MONUMENT R.R. SPIKE

ON SURFACE - ~~BELOW~~ ON _____

OFFSET \odot PAVEMENT ON _____ LT : RT

- TO - EDGE PAVEMENT


STATION: 1564+66

HORZ.DATUM: _____


GEOID: _____

GRID: NORTHING: _____

EASTING: _____

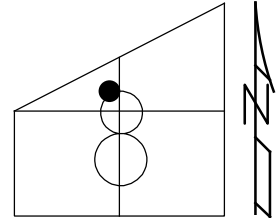

RECORD:
 STA.1557+09.3
 1987 PLANS
 FD R.R. SPIKE
 7/2/70, BURNSIDE

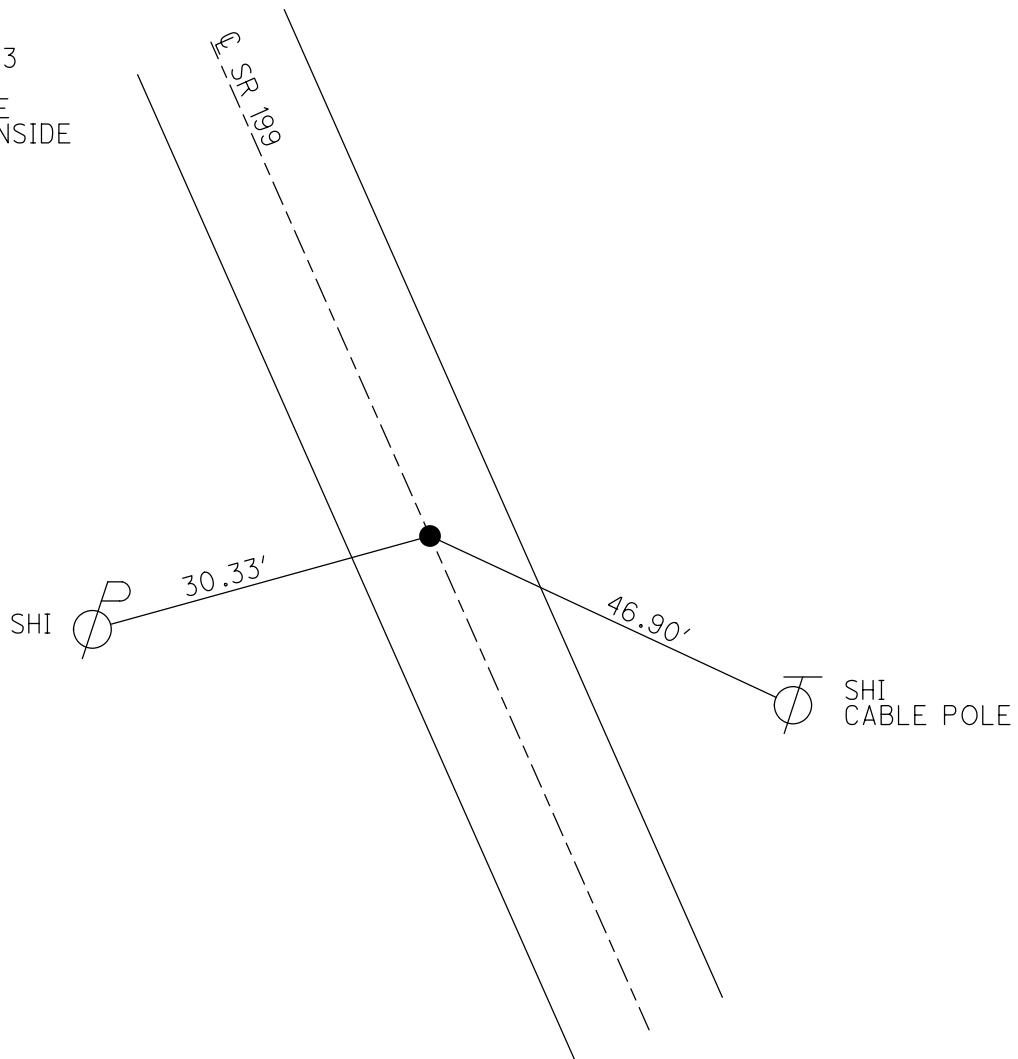

PERSONNEL TITLE PERSONNEL TITLE

BURNSIDE
HOFFMAN

COUNTY WOOD DATE 7-2-70

S. R. 199 (OLD 23) WEATHER CLEAR

SEC. FERRYSBURG TEMP. +85°

DESCRIPTION R.R. SPK'S (FOUND BEFORE RE-SURFACE) JOB NO. _____

LEFT

CENTER LINE

RIGHT

FD. R.R. Spk.
1557+09.3 S.L.M.

Stk. ϕ 30.33'

46.90'

Stk. Pole Pole

FD. R.R. Spk.
1552+80.5± S.L.M.

59.00'

BASE HYD.

55.30'

Stk. Pole Pole