

O.D.O.T. DISTRICT 2 SURVEY OFFICE (USE ONLY)

PERSONNEL

REFERENCE NO. 72

SHEET 4 OF 9

NOTES BURNSIDE

DATE 2/26/70

ROUTE SR 199

H.C. SMITH

WEATHER CLEAR

COUNTY WOOD

R.C. HOFFMAN

TEMP. 15°

TOWNSHIP PERRYSBURG

DWG BY NIESE PID \_\_\_\_\_

SECTION 12 MILE RESERVE

T 4 US

TYPE MONUMENT CMON W/ 1" IPIN

ON SURFACE - ~~BELOW~~ ON

OFFSET Q PAVEMENT ON LT : RT

- TO - EDGE PAVEMENT


STATION: 1565+53.78

HORIZ.DATUM: \_\_\_\_\_


GEOID: \_\_\_\_\_

GRID: NORTHING: \_\_\_\_\_

EASTING: \_\_\_\_\_

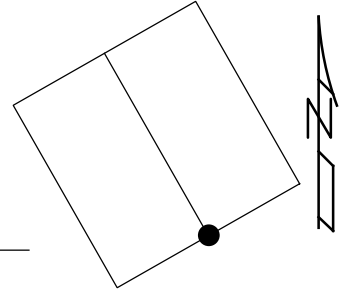

RECORD:  
FD CMON  
W/ 1" IPIN  
2/26/70, BURNSIDE

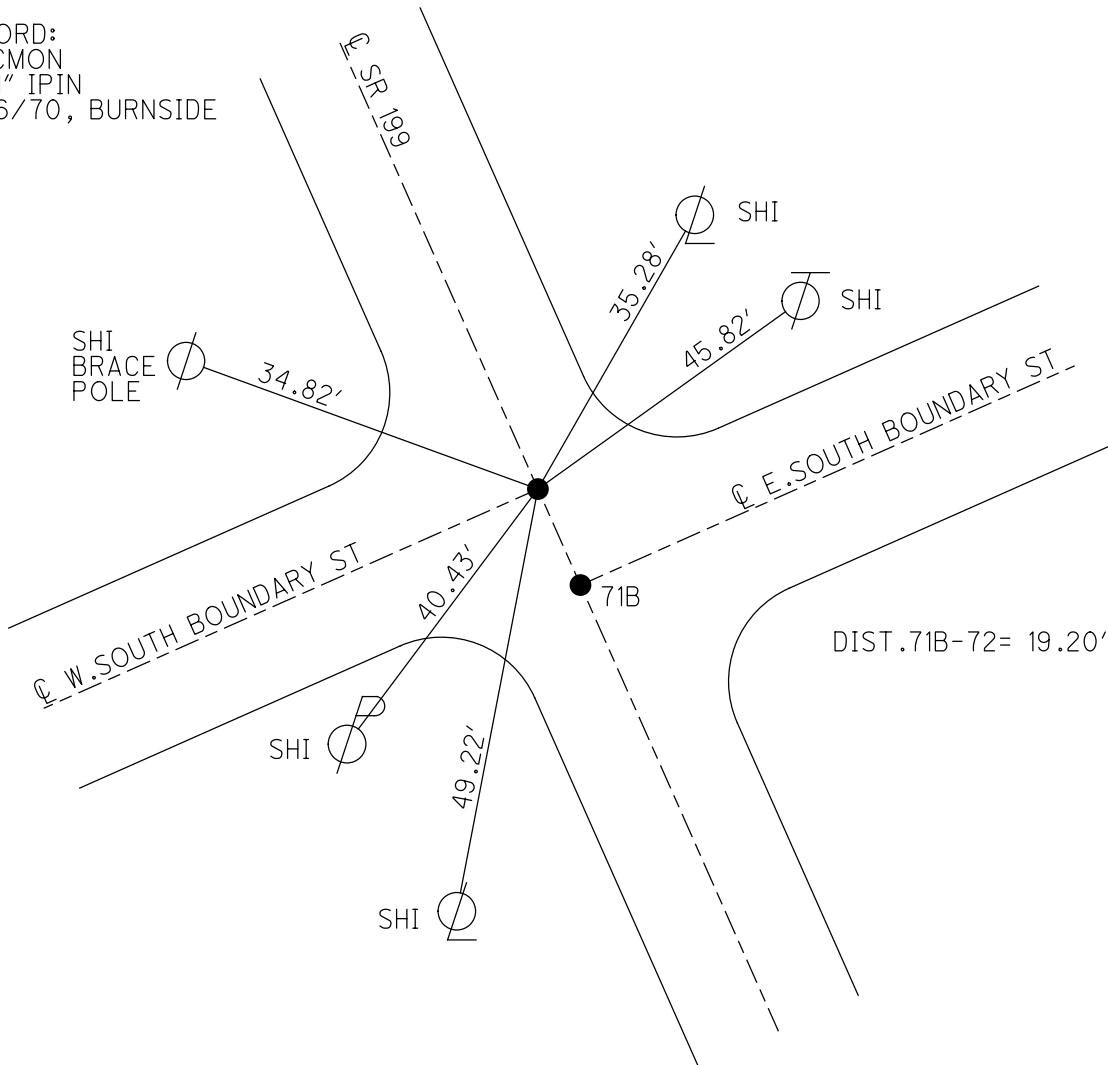

COPIED

PERSONNEL TITLE PERSONNEL TITLE

BURNSIDE  
SMITH  
HOFFMAN

COUNTY WOOD

DATE 2-26-70

S. R. 199


WEATHER CLEAR

SEC. PERRYSBURG CORP.  
(LOUISIANA AVE)

TEMP. +15°

DESCRIPTION CONTROL TIES

JOB NO.

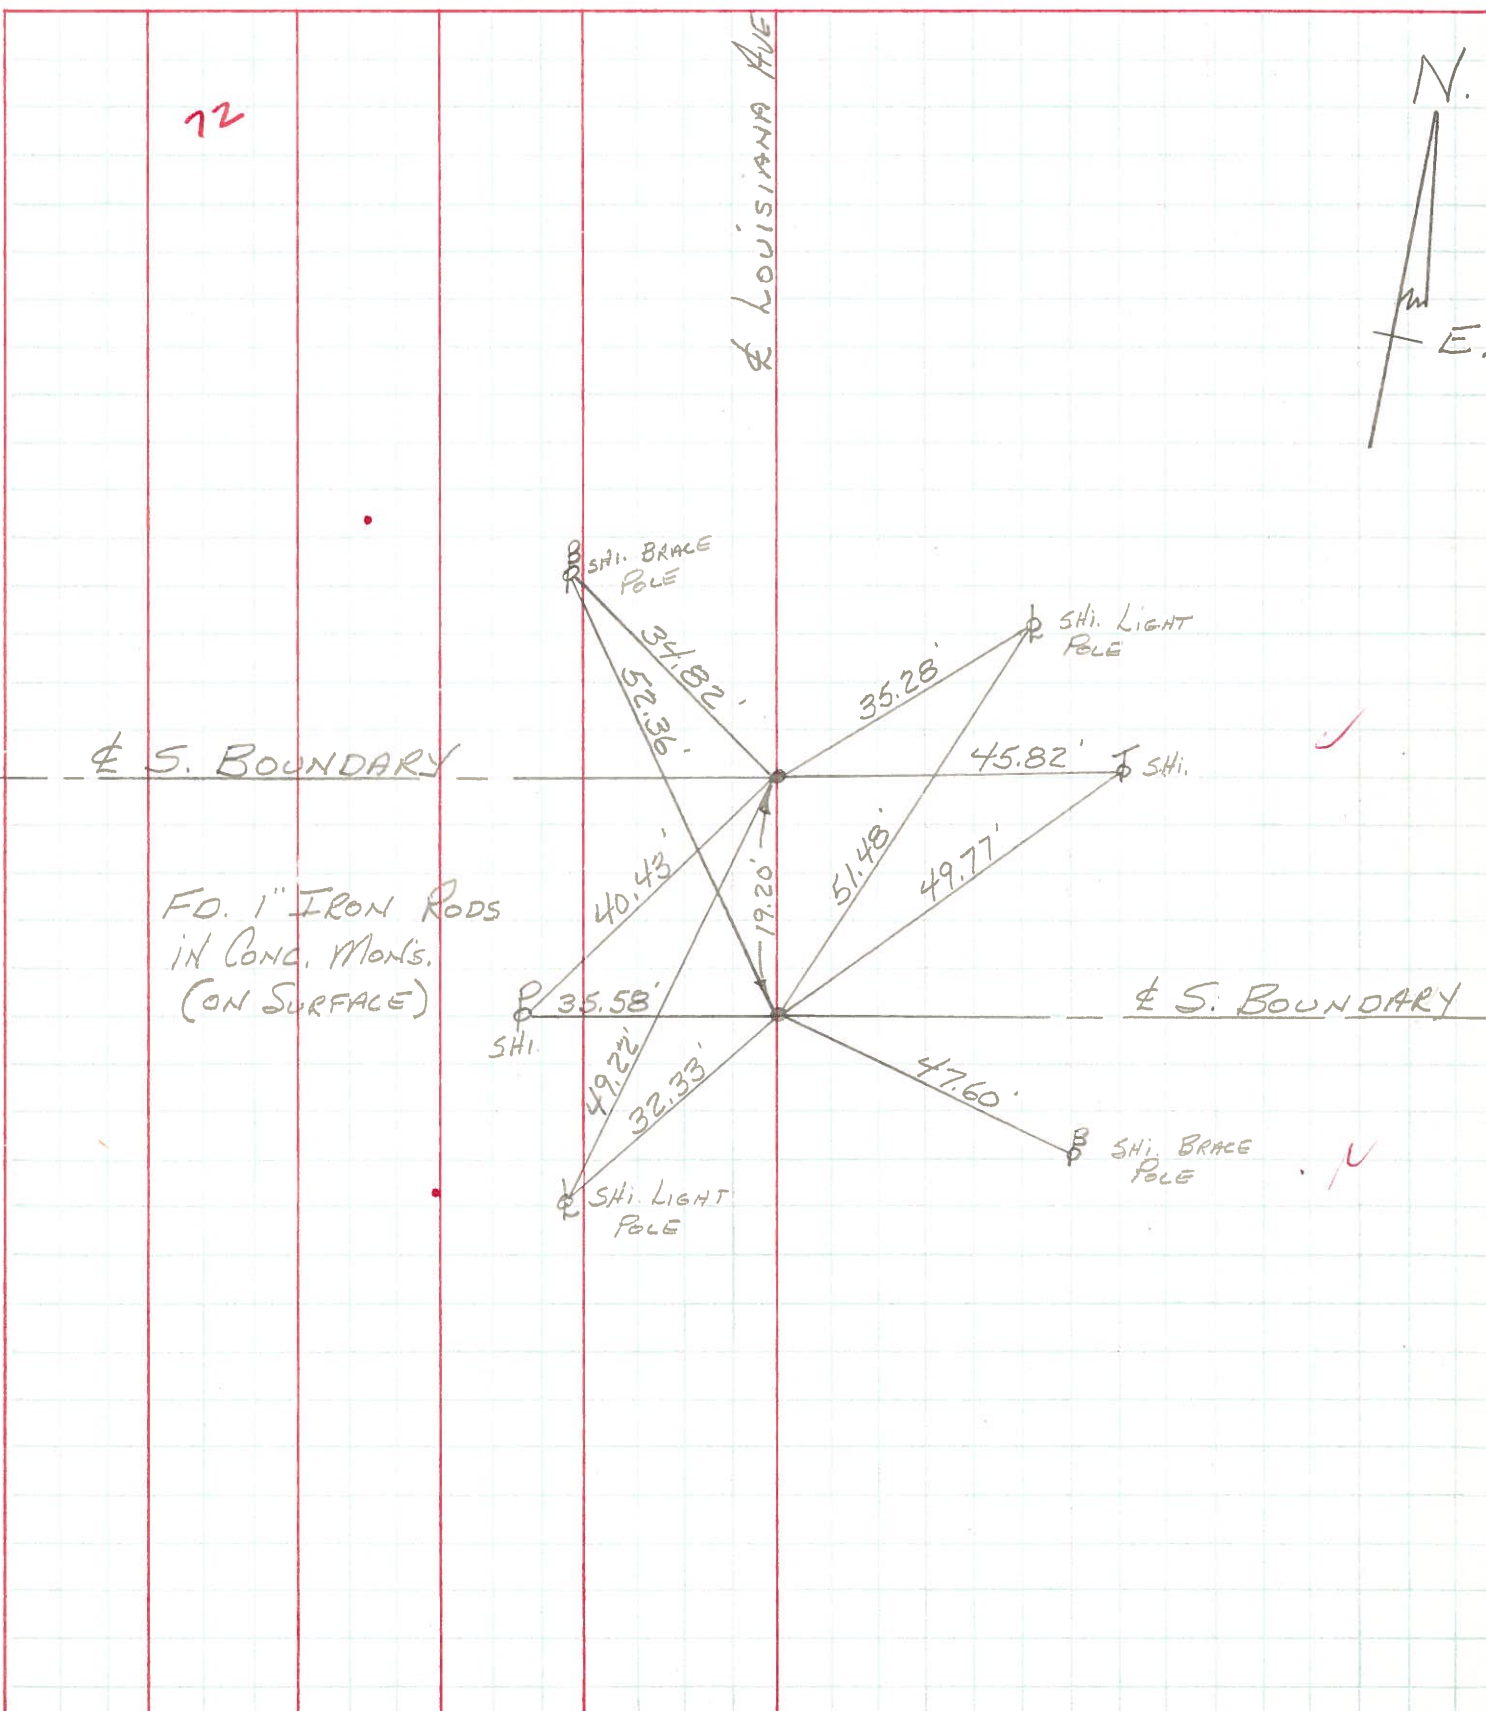

PERSONNEL TITLE PERSONNEL TITLE


BURDINE  
SMITH  
ROFFMAN

COUNTY WOOD DATE 2-26-70

S. R. 199 (OLD 5<sup>TH</sup>) WEATHER CLEAR

SEC. FERTISPOUR, LOUISIANA AVE. TEMP. +16°

DESCRIPTION CONTROL TIES (LOUISIANA AVE) JOB NO.

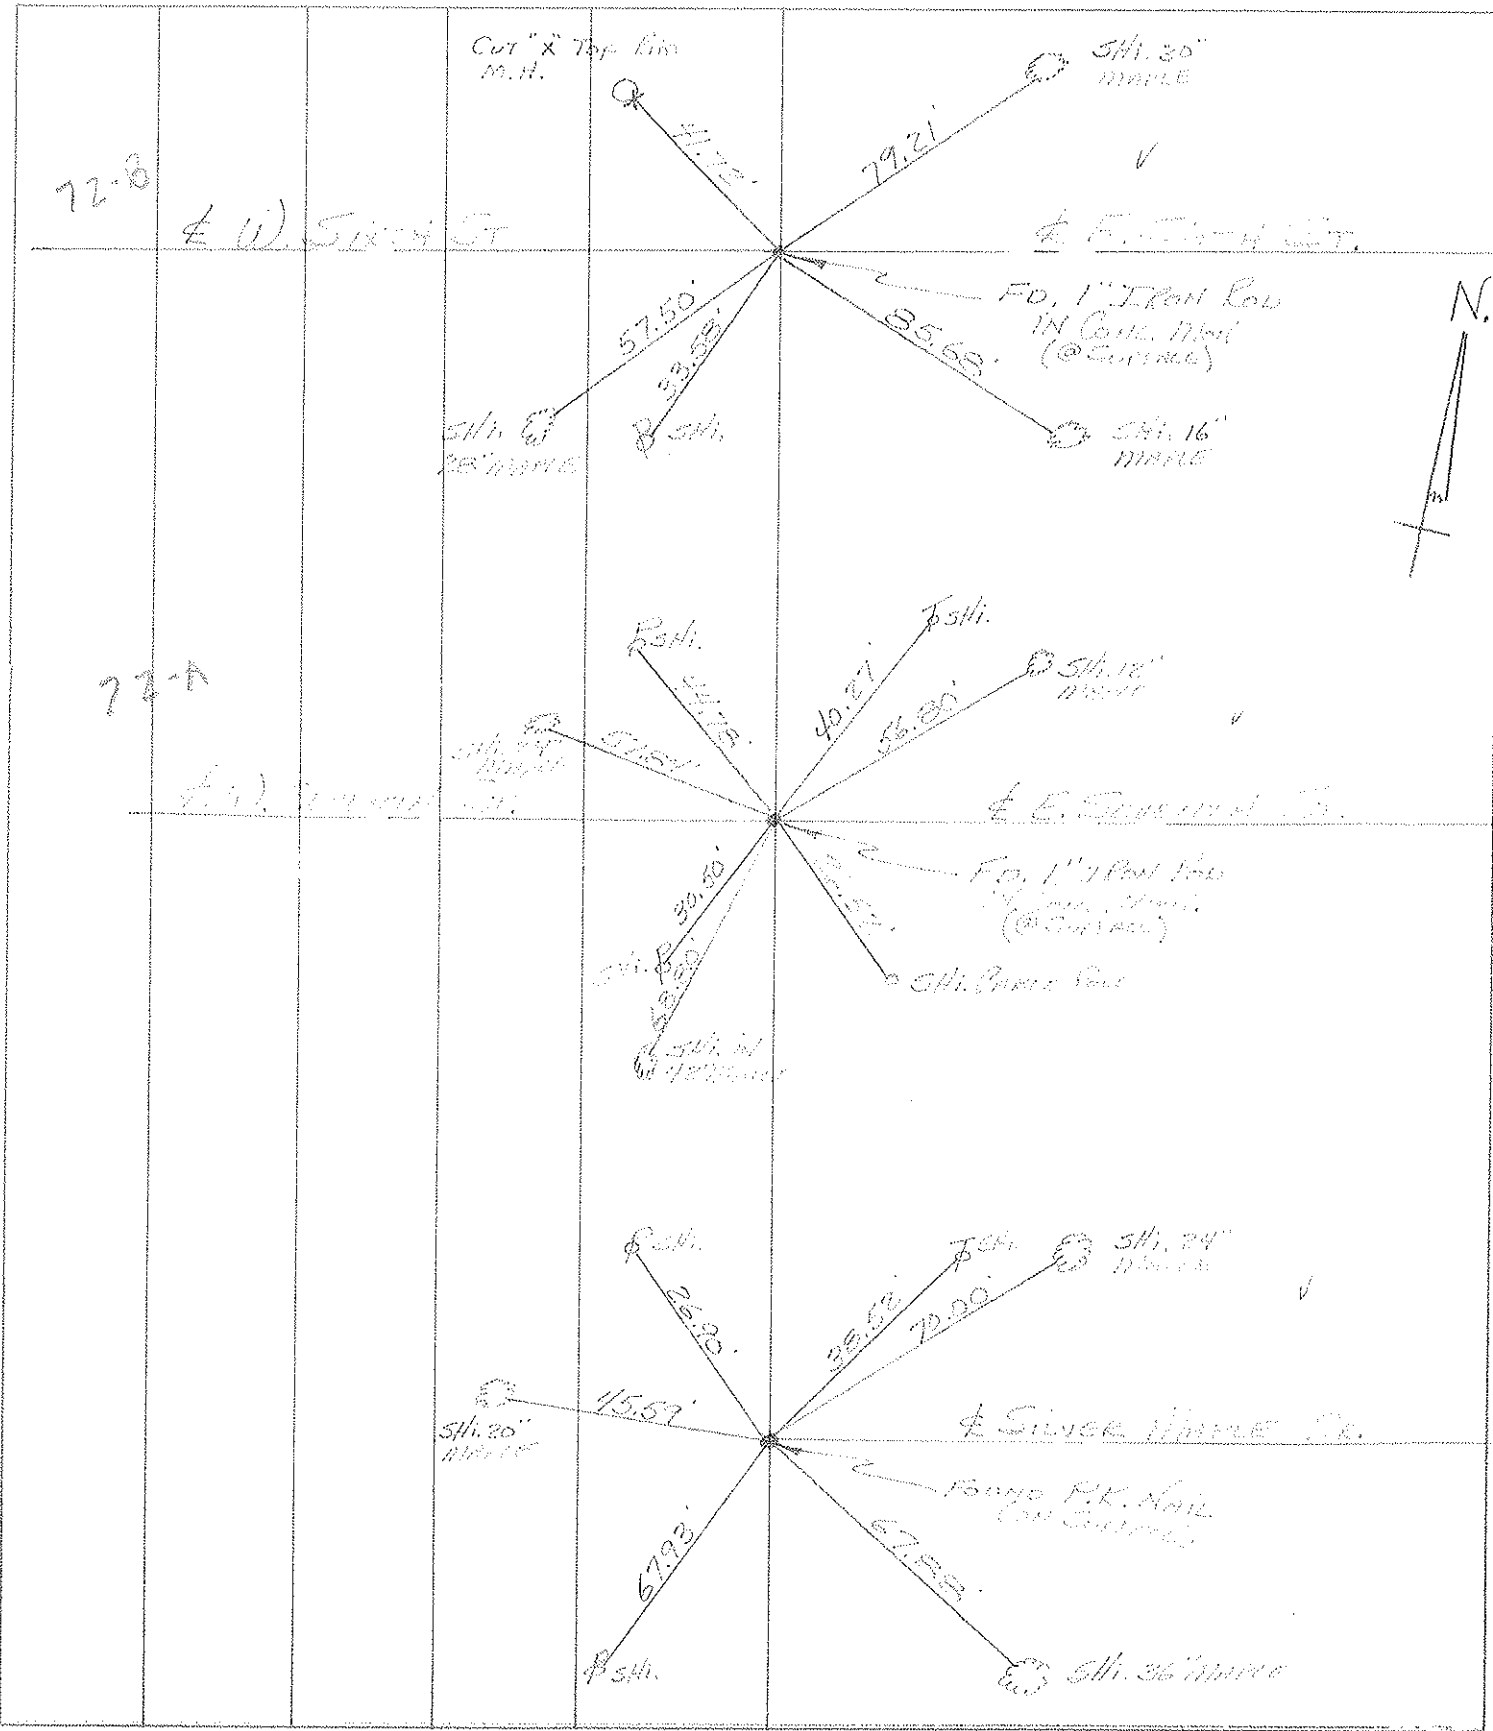

PERSONNEL TITLE PERSONNEL TITLE

BURNSIDE  
SPRINT  
HOFFMANN

COUNTY WOOD

DATE 2-28-70

S. R. 177

WEATHER CLEAR

SEC. PEPPERSBURG COOP. TEMP. +18°

DESCRIPTION CONTROL TIES

(INDIANA AVE)

JOB NO.

LEFT

CENTER LINE

RIGHT

