

O.D.O.T. DISTRICT 2 SURVEY OFFICE (USE ONLY)

PERSONNEL

REFERENCE NO. 72 A

SHEET 6 OF 9

NOTES STONE
 H.C. CURTIS
 R.C. AHMAD
HOUSEHOLDER

DATE 4/9/90
 WEATHER CLOUDY
 TEMP. 45°

ROUTE SR 199
 COUNTY WOOD
 TOWNSHIP PERRYSBURG
 SECTION 12 MILE RESERVE
 T 4 US

DWG BY NIESE PID _____

TYPE MONUMENT CMON W/ IPIN

~~ON SURFACE~~ - BELOW 4"


OFFSET Q PAVEMENT ON LT : RT

- TO - EDGE PAVEMENT


STATION: 1605+64.8

HORZ. DATUM: _____ GEOID: _____

GRID: NORTHING: _____ EASTING: _____

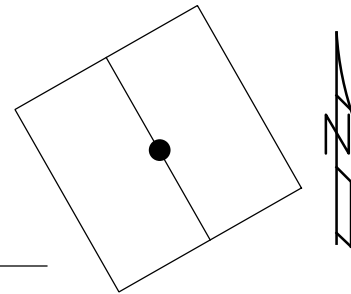

RECORD:
 FD CMON
 W/ 1" IPIN
 2/26/70, BURNSIDE
 FD CMON
 W/ IPIN
 4" DOWN
 4/9/90, DJC
 SET P.K. NAIL
 6/15/90, DJC

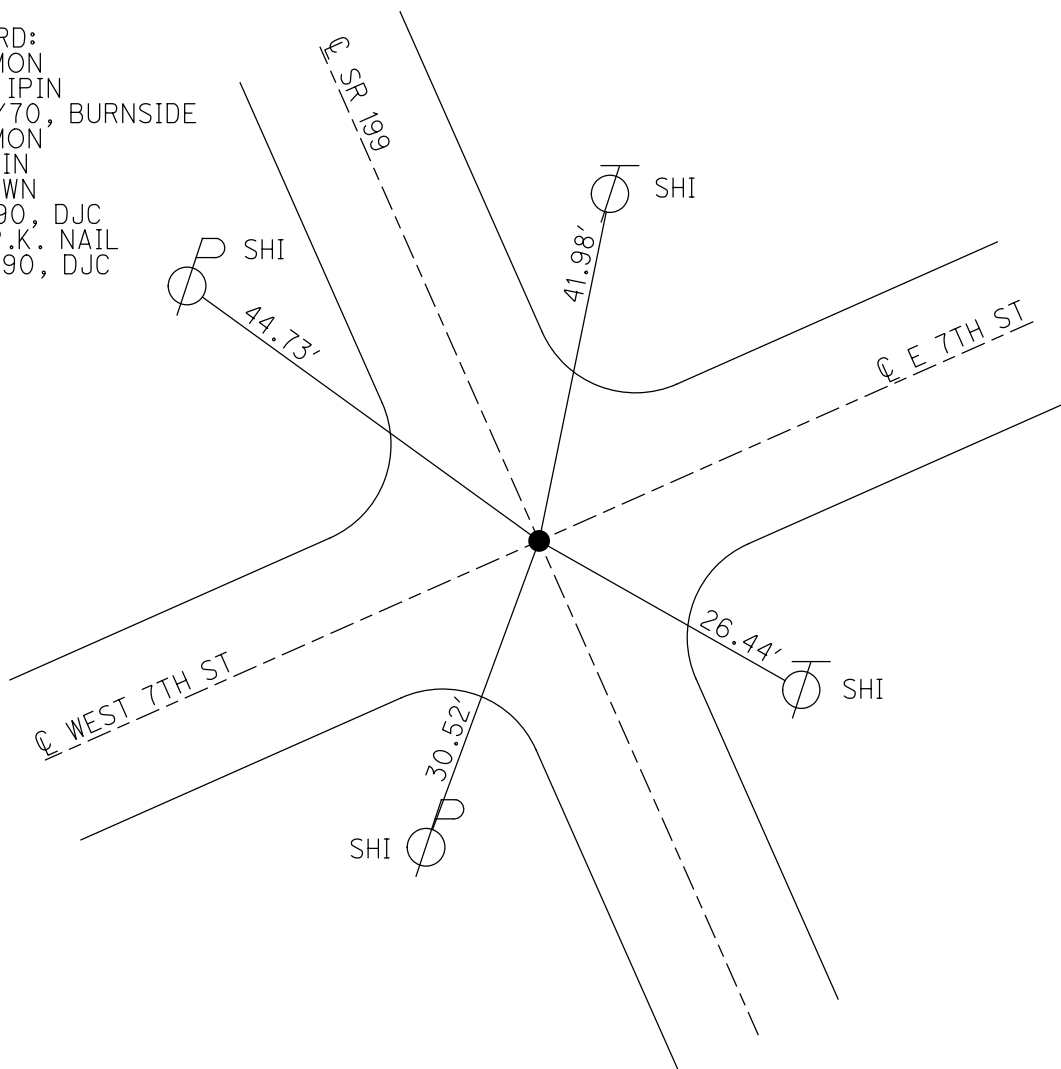

O.D.O.T. DISTRICT 2 SURVEY OFFICE

PERSONNEL

REFERENCE NO. 72-A

SHEET 19 OF 21

NOTES 1. Stone

H.C. D. Condit

R.C. B. Ahmad

J. Haushalter

DATE 9 April 90

WEATHER Cloudy

TEMP. 45°

ROUTE SR#199

COUNTY Wood

TOWNSHIP Perryburg

SECTION _____

T. _____ R. _____


TYPE MONUMENT 1. Red in Con.

ON SURFACE - BELOW 4" deep


LEFT- & PAV'T. - RIGHT ↔

TO _____ EDGE PAVEMENT

S.L.M. _____

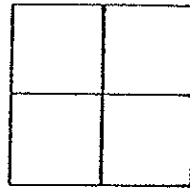

SET P.K. NAIL TO SURFACE
6-15-90
DJC

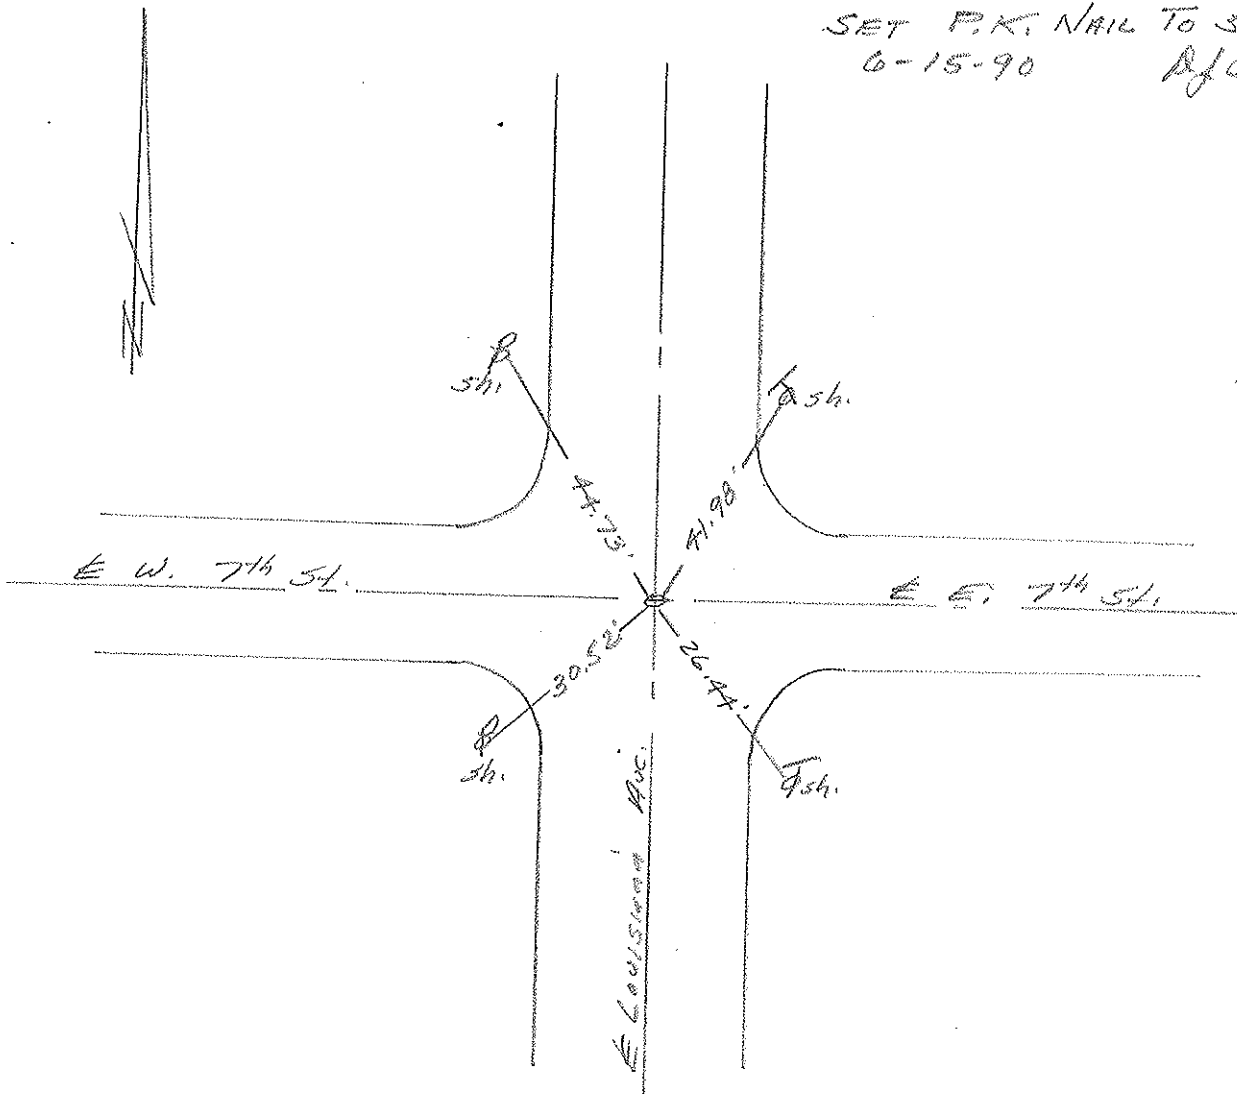

PERSONNEL	TITLE	PERSONNEL	TITLE	COUNTY	DATE
BURNSIDE				WOOD	2-26-70
SMITH				S. R. 199 (OLD U.S. #23)	WEATHER CLEAR
HOFFMAN				SEC. PERRYSBURG CORP.	TEMP. +16°
DESCRIPTION CONTROL TIES				(LOUISIANA AVE)	JOB NO.
LEFT		CENTER LINE		RIGHT	

