

O.D.O.T. DISTRICT 2 SURVEY OFFICE (USE ONLY)

PERSONNEL

REFERENCE NO. 72 C

SHEET 8 OF 9

NOTES STONE

DATE 4/9/90

ROUTE SR 199

H.C. CURTIS

WEATHER CLOUDY

COUNTY WOOD

R.C. AHMAD

TEMP. 46°

TOWNSHIP PERRYSBURG

HOUSEHOLDER

SECTION 12 MILE RESERVE

DWG BY NIESE PID _____

T 4 US

TYPE MONUMENT P.K. NAIL

ON SURFACE - ~~BELOW~~ ON

OFFSET Q PAVEMENT ON LT : RT

- TO - EDGE PAVEMENT


STATION: 1614+62

HORZ. DATUM: _____


GEOID: _____

GRID: NORTHING: _____

EASTING: _____

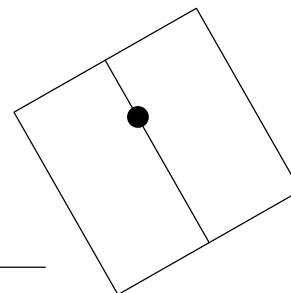

RECORD:
FD CMON
W/ 1" IPIN
2/26/70, BURNSIDE
FD P.K. NAIL
OVER CMON
4/9/90, DJC
SET P.K. NAIL
5/15/90, DJC

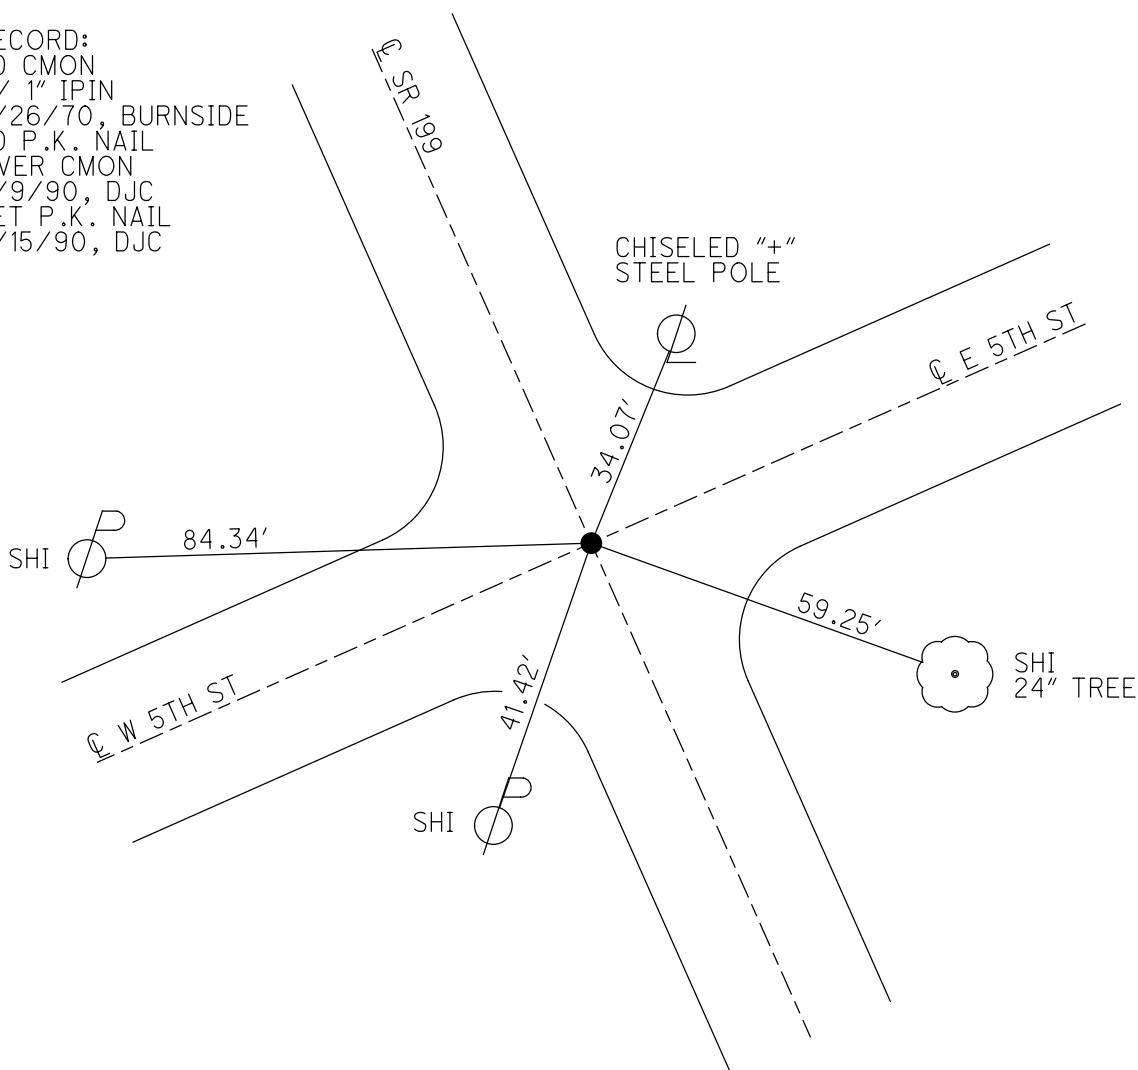

O.D.O.T. DISTRICT 2 SURVEY OFFICE

PERSONNEL

REFERENCE NO. 72-2

SHEET 21 OF 21

NOTES 1. Stone

H.C. D. Curtis

DATE 9 April 90

ROUTE SR#199

R.C. B. Abner

WEATHER cloudy

COUNTY Wood

J. Hauschalter

TEMP. 40°

TOWNSHIP Perryburg

SECTION _____

T _____ R _____


TYPE MONUMENT PK Nail over Con. Mass

ON SURFACE - BELOW Surface


LEFT - ☉ PAV'T. - RIGHT _____

_____ TO _____ EDGE PAVEMENT

S.L.M. _____

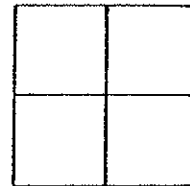

SET P.K. NAIL TO SURFACE
6-15-90
D/C

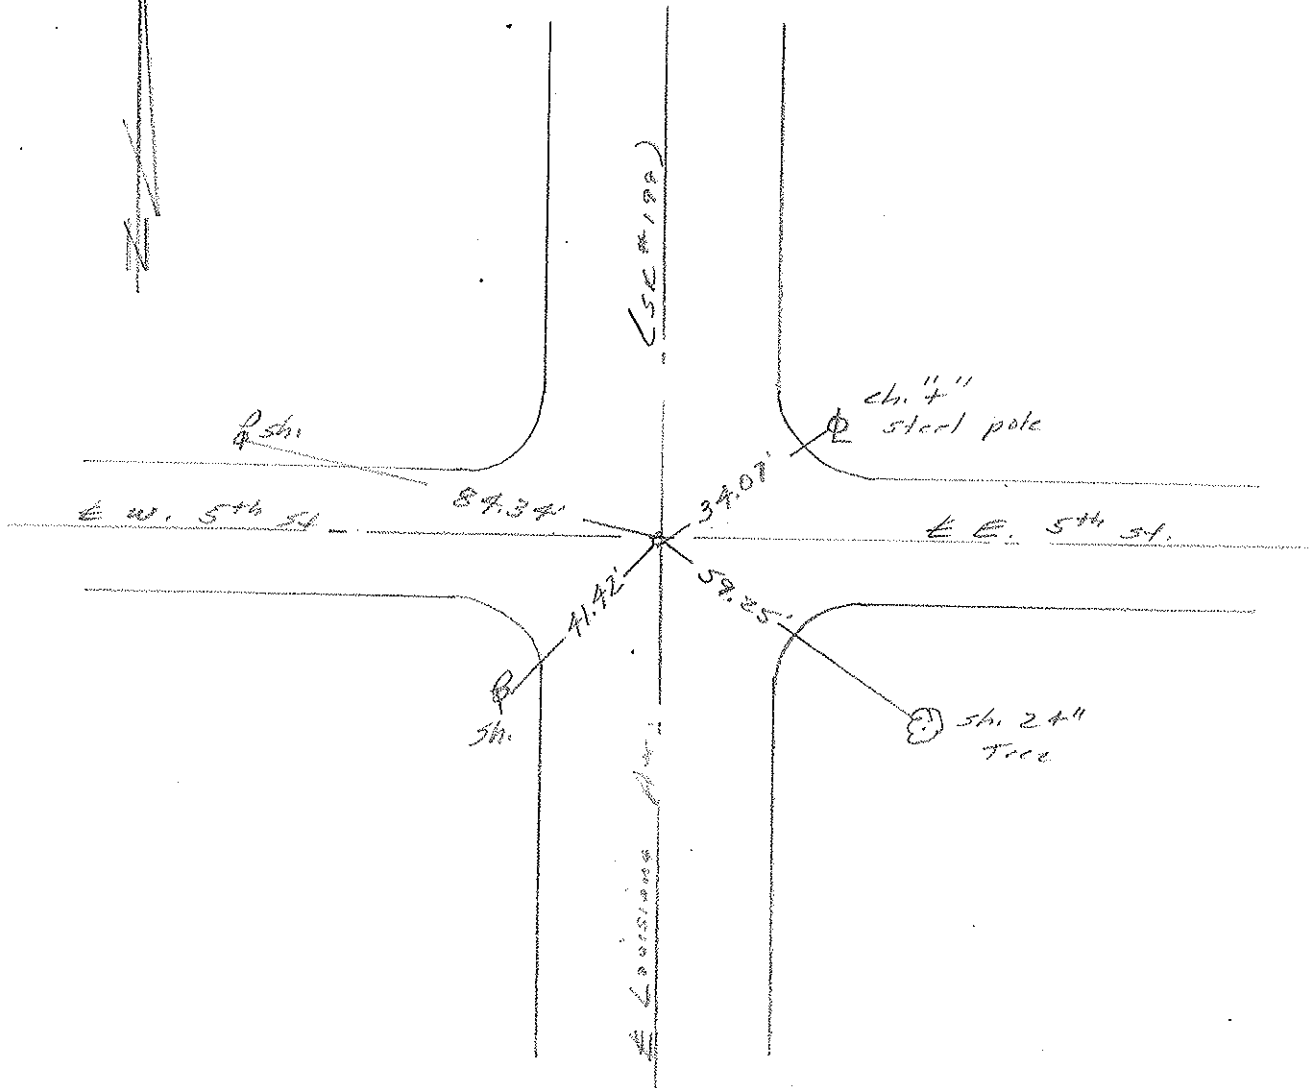

PERSONNEL	TITLE	PERSONNEL	TITLE	COUNTY	DATE
BURNSIDE				WOOD	2-26-70
SMITH				S. R. 199	WEATHER CLEAR
HOFFMAN				SEC. PERRY'S BURG. CORP.	TEMP. +18°
DESCRIPTION CONTROL TIES (LOUISIANA AVE)				JOB NO.	
	LEFT	CENTER LINE	RIGHT		

