

O.D.O.T. DISTRICT 2 SURVEY OFFICE (USE ONLY)

PERSONNEL

REFERENCE NO. A4

SHEET 4 OF 26

NOTES NIESE

DATE 10/28/24

ROUTE SR 235

H.C. NIESE

WEATHER CLEAR

COUNTY WOOD

R.C. PRESTON-COLVIN

TEMP. 47°

TOWNSHIP JACKSON

SECTION 25

DWG BY BARRIERE PID 101290

T 3 N R 9 E

TYPE MONUMENT MAG NAIL/WASHER

ON SURFACE - BELOW ON

OFFSET  $\varnothing$  PAVEMENT 1' LT ~~RT~~ : RT


TO EDGE PAVEMENT

STATION: \_\_\_\_\_

HORZ. DATUM: NAD83(2011)/WOOD LDP GEOID: 2018

GRID: NORTHING: 379244.199 EASTING: 127076.001

LDP: NORTHING: 557894.136 EASTING: 1615047.537

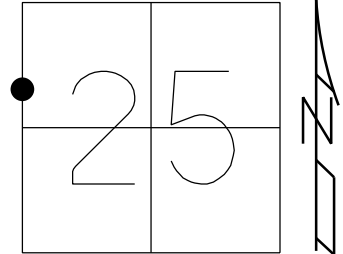

RECORD:  
FD MAG  
REFA4  
2/1/23, JAM  
5/21/24, TDN  
SET MAG/WASHER  
10/28/24, TDN

NOTE: SR 18 REFA13

