

O.D.O.T. DISTRICT 2 SURVEY OFFICE (USE ONLY)

PERSONNEL _____

REFERENCE NO. 13

SHEET 10 OF 10

NOTES S.P.

DATE 9/9/87

ROUTE IR-280

H.C. D.S.

WEATHER _____

COUNTY WOOD

R.C. G.W.

TEMP. _____

TOWNSHIP LAKE

SECTION 4

DWG BY NIESE PID _____

T 7 N R 12 E

TYPE MONUMENT _____

ON SURFACE - BELOW ON

OFFSET $\text{\textcircled{C}}$ PAVEMENT _____ LT : RT

- TO - EDGE PAVEMENT


STATION: 288+35.03

HORZ.DATUM: _____


GEOID: _____

GRID: NORTHING: _____

EASTING: _____

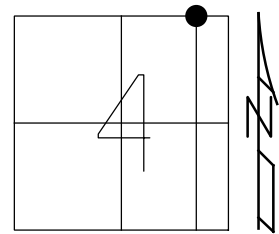

RECORD: P.O.T.
NORTHWOOD CORP. LINE
FD MON
 $\text{\textcircled{C}}$ SURVEY AND $\text{\textcircled{C}}$ R/W
3/17/74
MONUMENT LOCATIONS
NOT SET PER PLAN
9/9/87, SP

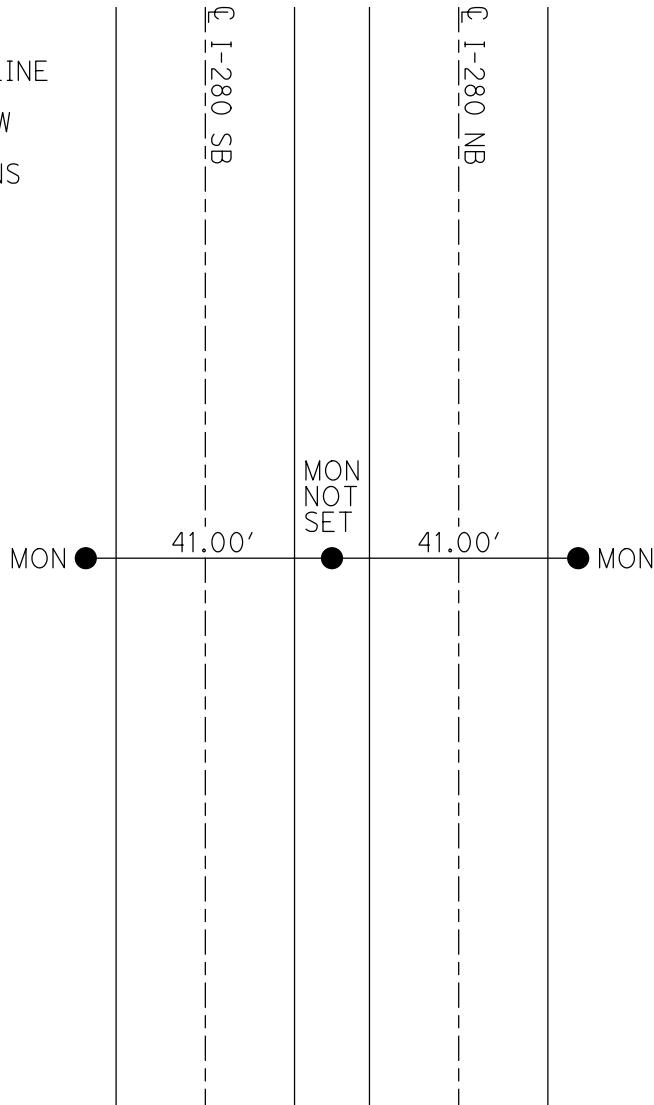

Personnel

Description

SHEET NO. _____

I-280

Date 9-9-87

S.P. MONUMENT LOCATIONS.

Job No. 702-85

D.S. NOT SET PER PLANS



Temp. _____

G.W.

Stakes _____

5.25 BY NORFOLK S. R. R.

5.46

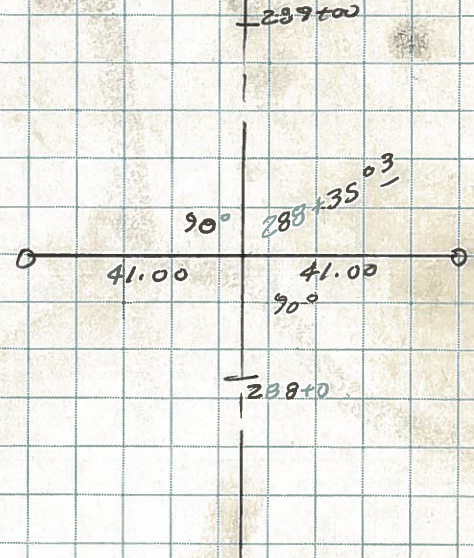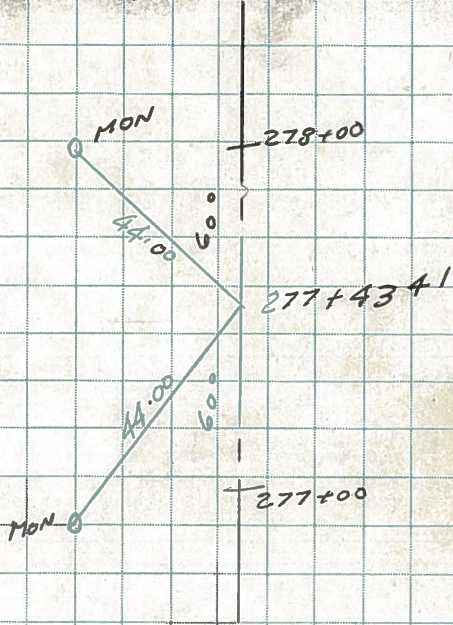

5.03

5.30

