

O.D.O.T. DISTRICT 2 SURVEY OFFICE (USE ONLY)

PERSONNEL

REFERENCE NO. 28 A

SHEET 17 OF 36

NOTES O'DONNELL

DATE 3/14/22

ROUTE SR 281

H.C. AUBLE

WEATHER SUNNY

COUNTY WOOD

R.C. NIESE

TEMP. 35°

TOWNSHIP PORTAGE

SECTION 19

DWG BY RHOADES

PID 94340

T 4 N R 11 E

TYPE MONUMENT MONBOX W/ 1" IPIN

ON SURFACE - ~~BELOW~~ ON

OFFSET \varnothing PAVEMENT 0.4' LT : ~~RT~~

11.2' TO RT EDGE PAVEMENT


STATION: 667+24.31

HORZ.DATUM: NAD83 2011


GEOID: NAVD88 2018

GRID: NORTHING: 590804.747

EASTING: 1655201.244

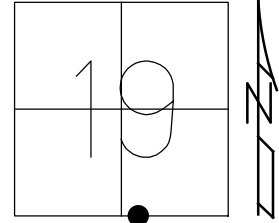

RECORD:
 FD MONBOX
 9-26-00
 5-25-04
 7-8-04, RGN
 FD MONBOX
 W/ 1" IPIN
 12-20-13, JLL
 REFA28
 3-19-18, JLL
 NEWREFA28
 1-14-19, JLL
 3/14/22, JFO

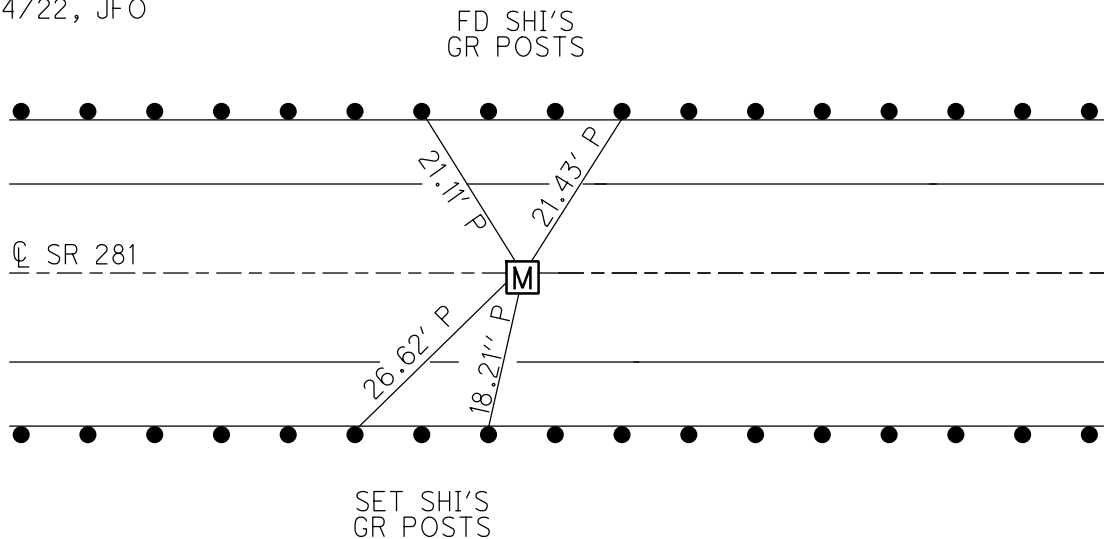

O.D.O.T. DISTRICT 2 SURVEY OFFICE (USE ONLY)

PERSONNEL

REFERENCE NO. 28 A

SHEET 17 OF 27

NOTES LEU

DATE 1-14-19

ROUTE SR 281

H.C. LEU

WEATHER SUNNY

COUNTY WOOD

R.C. MILLER

TEMP. 26°

TOWNSHIP PORTAGE

DWG BY JAMES PID 97957

SECTION 19

T 4 N R 11 E

TYPE MONUMENT MONBOX W/ 1" IPIN

ON SURFACE - ~~BELOW~~ ON

OFFSET Q PAVEMENT 0.4' LT : ~~RT~~

11.2' TO RT EDGE PAVEMENT


STATION: 667+67

HORZ.DATUM: NAD83 2011


GEOID: NAVD88 2012A

GRID: NORTHING: 590804.747

EASTING: 1655201.244

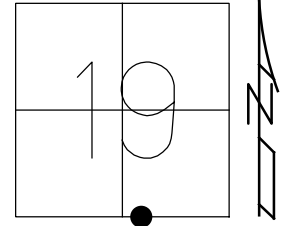

RECORD:
 FD MONBOX
 9-26-00
 5-25-04
 7-8-04, RGN
 FD MONBOX
 W/ 1" IPIN
 12-20-13, JLL
 REFA28
 3-19-18, JLL
 NEWREFA28
 1-14-19, JLL

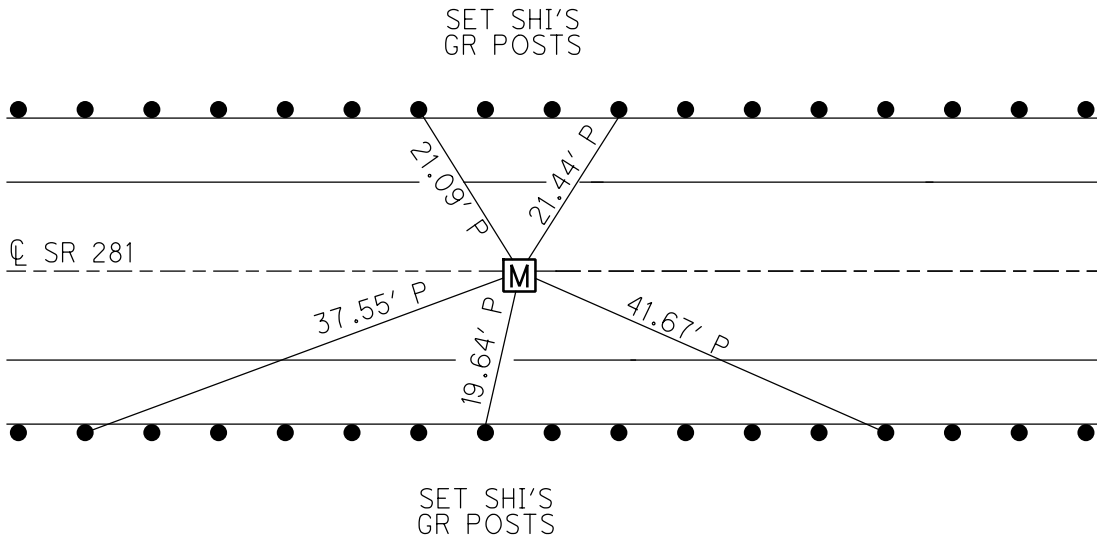

O.D.O.T. DISTRICT 2 SURVEY OFFICE (USE ONLY)

PERSONNEL

REFERENCE NO. 28-A

SHEET 17 OF 25

NOTES RHOADES

DATE 12-20-13

ROUTE S.R. 281

H.C. LEU

WEATHER RAINY/WINDY

COUNTY WOOD

R.C. RHOADES

TEMP. 40° F

TOWNSHIP PORTAGE

SECTION 19

T 4 N R 11 E

TYPE MONUMENT 1" IRON PIN IN MONUMENT BOX



ON SURFACE - ~~BELOW~~ YES

LEFT - Q PAV'T ~~RIGHT~~ 0.4'

11.2' TO RT. EDGE PAVEMENT

S.L.M. 667+67

Grid: Northing: 590,804.714 Easting: 1,655,201.247

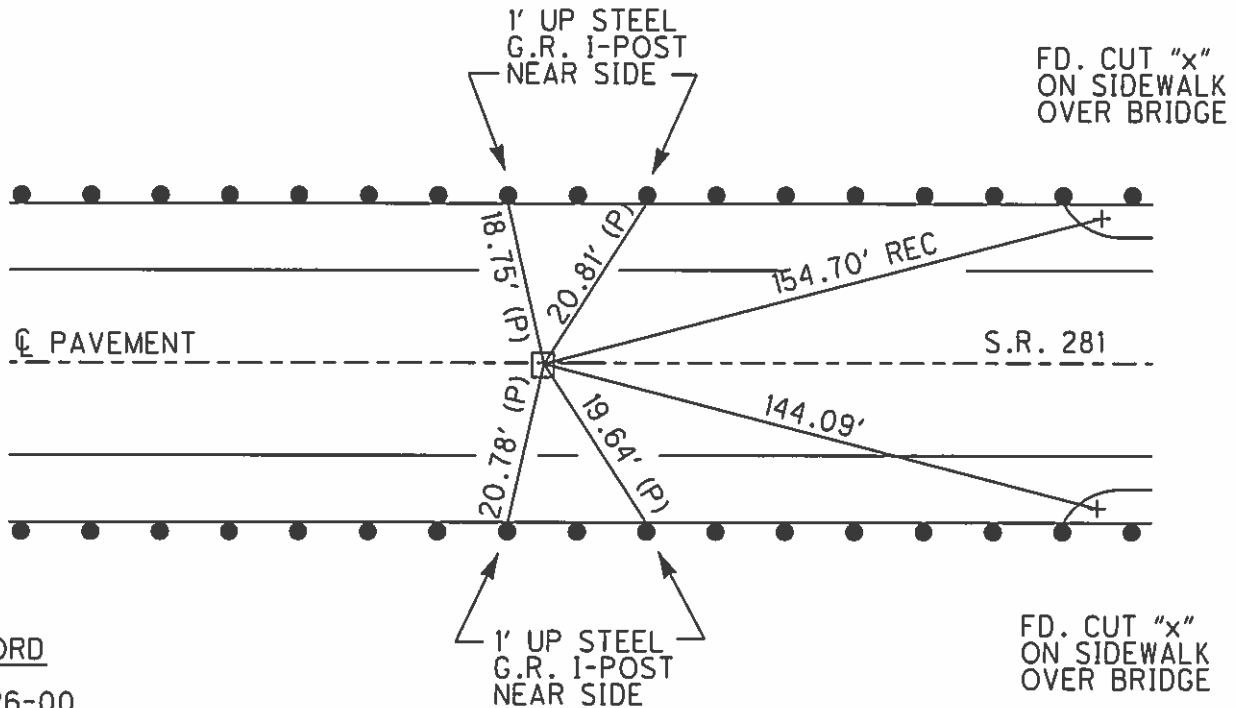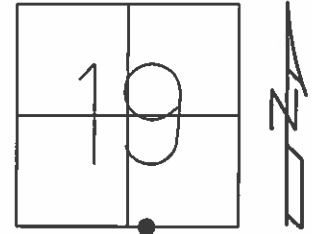

RECORD

09-26-00
RE-SET SAME
BOX TO GRADE

05-25-04 RGN
FD. MON BOX

07-08-04 RGN
MON BOX VISIBLE

O.D.O.T. DISTRICT 2 SURVEY OFFICE

PERSONNEL

REFERENCE NO. 28-A

SHEET 3 OF 11

NOTES HOFFMAN

H.C. LOSHRKE

R.C. BARNHISEL

DATE 6-5-90

WEATHER CLEAR

TEMP. 68°

ROUTE SR 281

COUNTY WOOD

TOWNSHIP PORTAGE

SECTION 19

T4 NR 11 E


TYPE MONUMENT MONUMENT BOX

ON SURFACE - ~~BELOW~~ YES


~~LEFT - C PAV'T.~~ - ~~RIGHT~~ YES

11.6 TO RT. EDGE PAVEMENT

S.L.M. 667+67

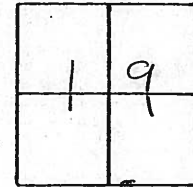

DID NOT OPEN BOX
TIES TO CTR OF LID

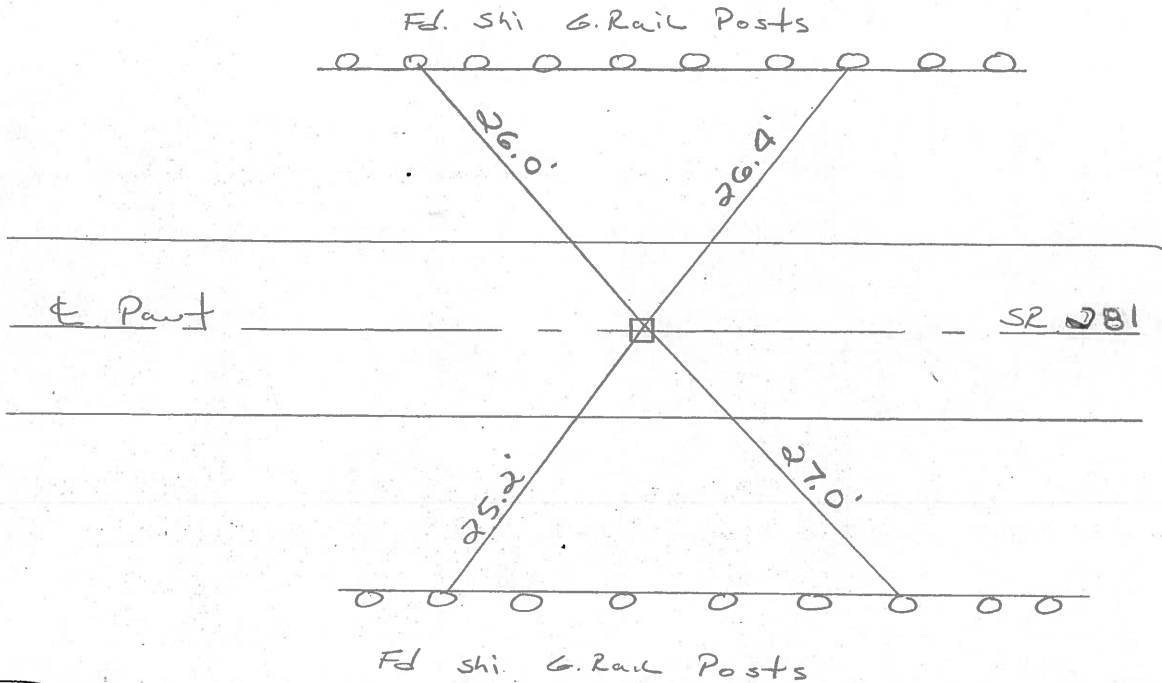

NOTE:
Re-set SAME
BOX TO GRADE
9-26-00

OD.O.T. DISTRICT 2 SURVEY OFFICE

SHEET _____ OF _____

County WOOD S.R. 281

Date MARCH 28, 83

Township PORTAGE


Weather OVERCAST - WINDY

Section 19

Temp. +30°

T4N, R11E

Personnel HOFFMAN

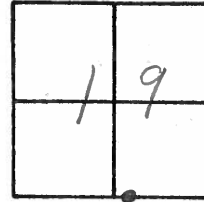

LOEHRKE

HOUSEHOLDER


BARNHISEL


28-A

Fd Mon. Box @ surface $\sqrt{5/25/83}$
ON & PAUT.



SLM 668+15

DID NOT OPEN BOX -
TIES TO ctr. of LIDS.

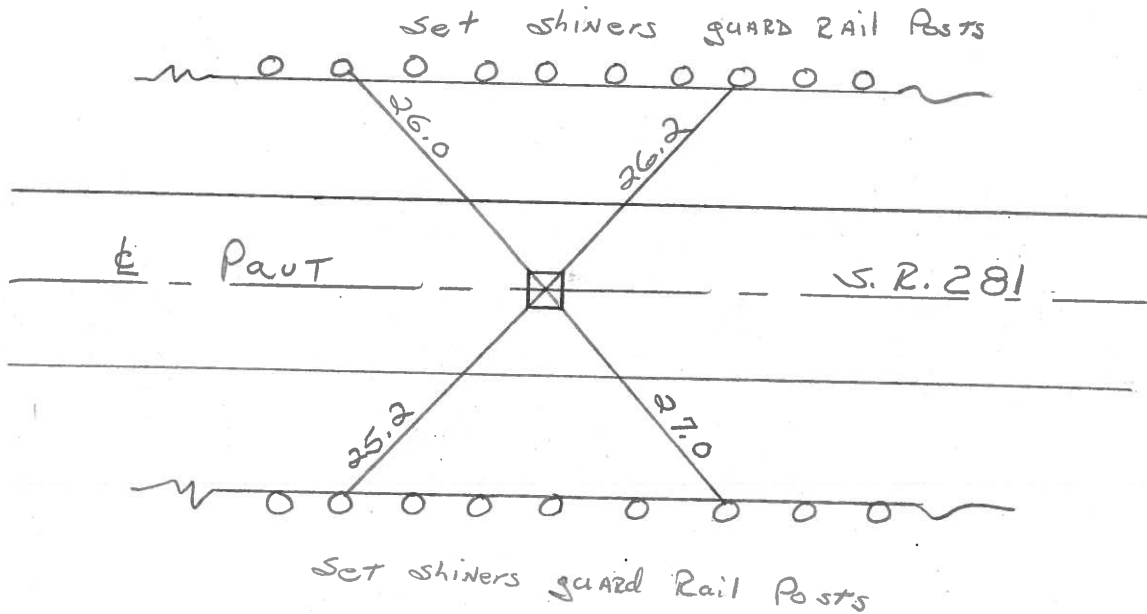


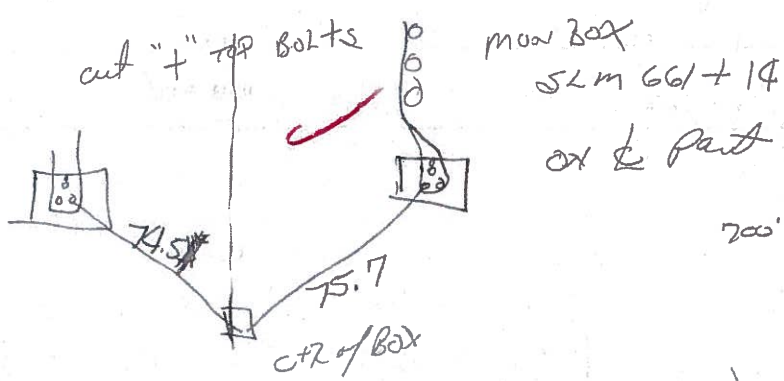

28-A

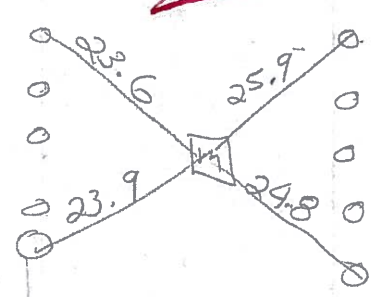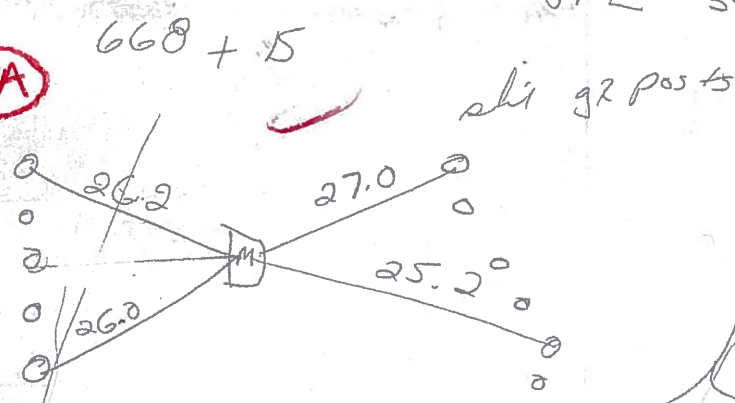

681 + 15
m & part

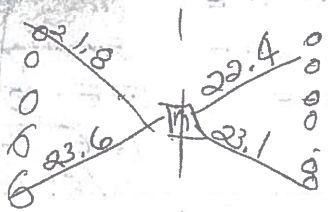

$$\begin{array}{r} 692+61 \\ 661+14 \\ \hline 31+47 \end{array}$$

86+40

$$\begin{array}{r} 692+61 \\ 681+15 \\ \hline 11+46 \end{array}$$

$$\begin{array}{r} 692+61 \\ 668+15 \\ \hline 24+46 \end{array}$$