


O.D.O.T. DISTRICT 2 SURVEY OFFICE (USE ONLY)


PERSONNEL _____ REFERENCE NO. 28 B SHEET 18 OF 27
 NOTES LEU DATE 1-14-19 ROUTE SR 281
 H.C. LEU WEATHER SUNNY COUNTY WOOD
 R.C. MILLER TEMP. 26° TOWNSHIP PORTAGE
 DWG BY JAMES PID 97957 SECTION 19
 T 4 N R 11 E

TYPE MONUMENT MONBOX W/ 1" IPIN
 ON SURFACE - ~~BELOW~~ ON
 OFFSET Q PAVEMENT ON ~~RT~~ : ~~RT~~
11' TO RT EDGE PAVEMENT
 STATION: 672+68

HORZ. DATUM: NAD83 2011 GEOID: NAVD88 2012A
 GRID: NORTHING: 590783.978 EASTING: 1655700.784

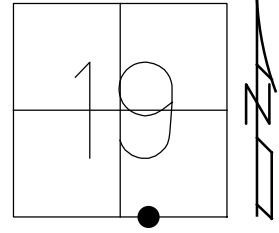

RECORD:
 FD MONBOX
 9-26-00
 FD MONBOX
 W/ 1" IPIN
 5-25-04
 7-8-04, RGN
 REFB28
 3-19-18, JLL
 CKREFB28
 6-13-18, JLL
 NEWREFB28
 1-14-19, JLL

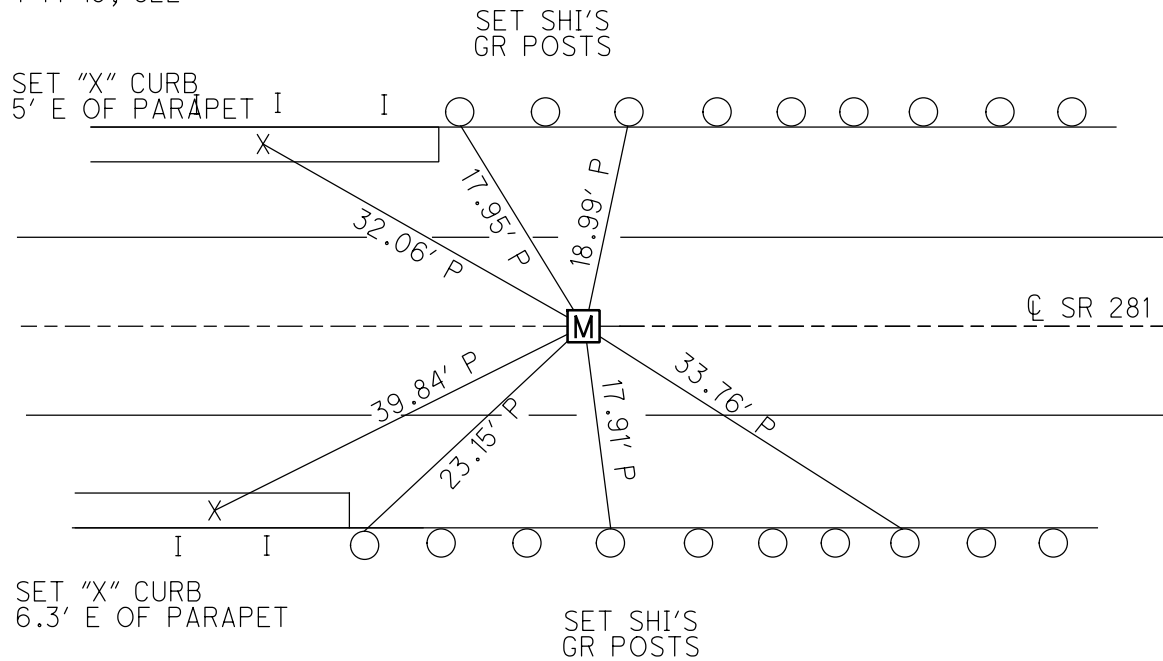

O.D.O.T. DISTRICT 2 SURVEY OFFICE (USE ONLY)

PERSONNEL

REFERENCE NO. 28-B

SHEET 18 OF 25

NOTES RHOADES

DATE 12-20-13

ROUTE S.R. 281

H.C. LEU

WEATHER RAINY/WINDY

COUNTY WOOD

R.C. RHOADES

TEMP. 40° F

TOWNSHIP PORTAGE

SECTION 19

T 4 N R 11 E

TYPE MONUMENT 1" IRON PIN IN MONUMENT BOX


ON SURFACE - ~~LOW~~ YES

~~RIGHT~~ - Q PAV'T ~~RIGHT~~ YES

11' TO RT. EDGE PAVEMENT


S.L.M. 672+68

Grid: Northing: 590,783.999 Easting: 1,655,700.776

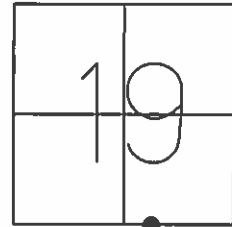

FD. CUT "x"
ON SIDEWALK
OVER BRIDGE

1' UP STEEL
G.R. I-POST
NEAR SIDE

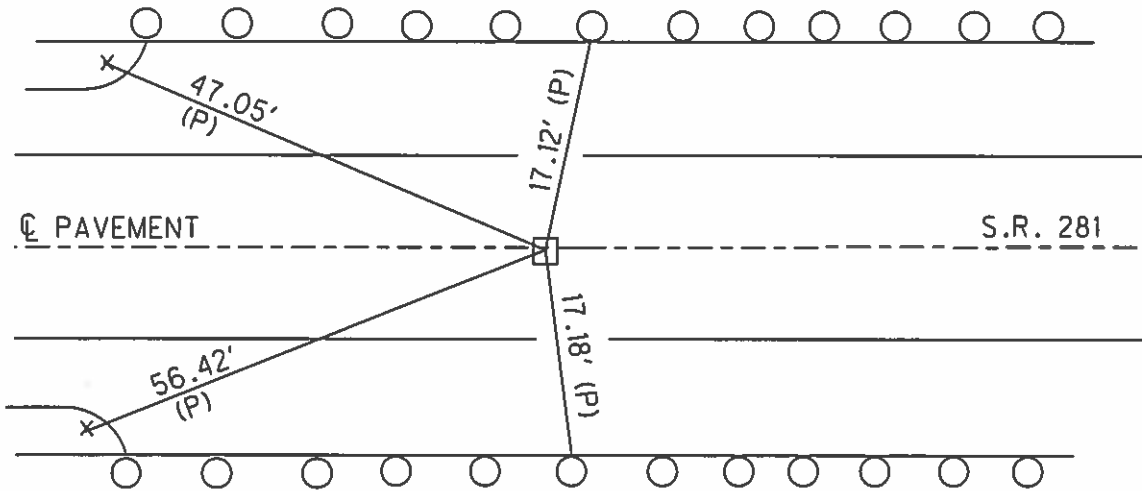

FD. CUT "x"
ON SIDEWALK
OVER BRIDGE

1' UP STEEL
G.R. I-POST
NEAR SIDE

RECORD

09-26-00
RE-SET SAME
BOX TO GRADE

05-25-04 RGN
FD. 1" I.P. IN MON BOX

07-08-04 RGN
MON BOX VISIBLE

O.D.O.T. DISTRICT 2 SURVEY OFFICE

PERSONNEL

REFERENCE NO. 28-B

SHEET 4 OF 11

NOTES HOFFMAN

H.C. LOSHRKE

R.C. BARWISSEL

DATE 6-5-90

WEATHER CLEAR

TEMP. 68°

ROUTE SR 281

COUNTY WOOD

TOWNSHIP PORTAGE

SECTION 19

T. 4 N. R 11 E


TYPE MONUMENT MONUMENT BOX

ON SURFACE - BELOW YES


LEFT - ~~C~~ PAVT. - RIGHT 0.6'

11.5 TO RT. EDGE PAVEMENT

S.L.M. 672+68

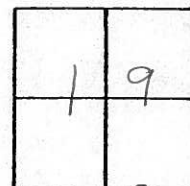

DID NOT OPEN BOX
TIES TO CTR. OF LID

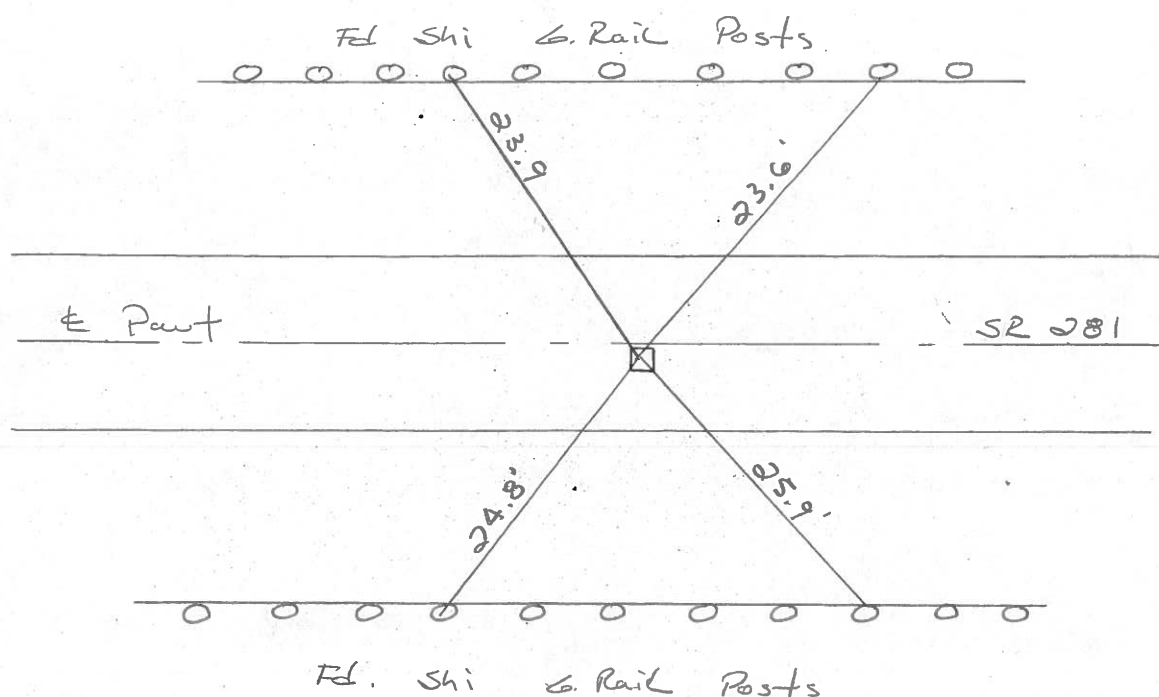

NOTE:
Re-set
SAME BOX
TO GRADE.
9-27-00

OD.O.T. DISTRICT 2 SURVEY OFFICE

SHEET _____ OF _____

County WOOD S.R. 281

Date MARCH 28, 83

Township PORTAGE

Weather OVERCAST - WINDY

Section 19

Temp. +30°

T4N, R11E


Personnel HOFFMAN

LOHRKE

HOUSEHOLDER

BARNHISEL


28-B



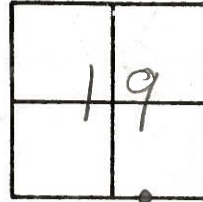


Fd. Mon. Box @ SURFACE \checkmark 5/25/83
ON $\&$ PAUT

SLM 673 + 15

DID NOT OPEN BOX -
TIES TO CTR of LID.

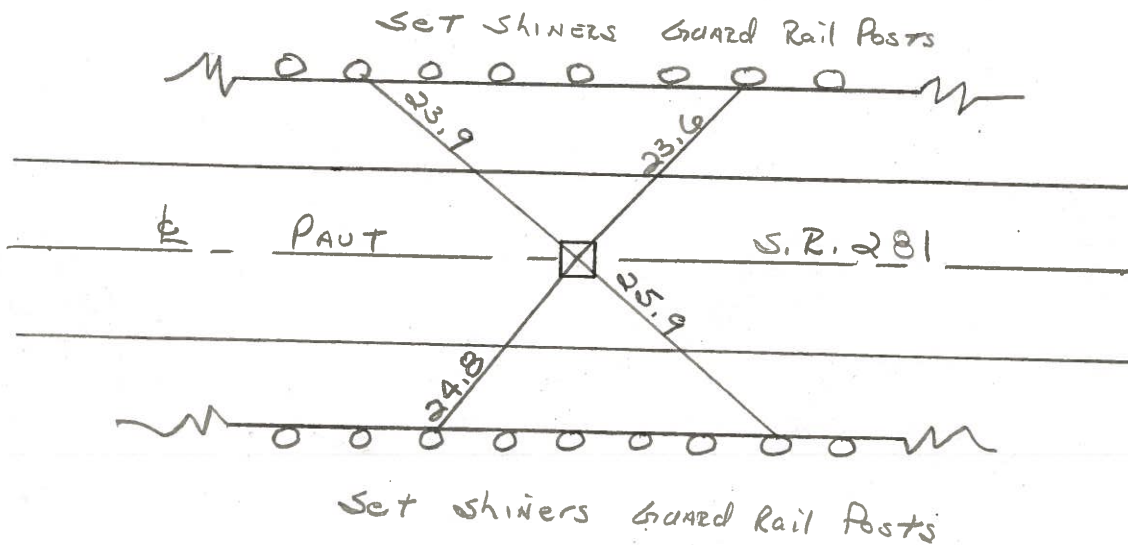

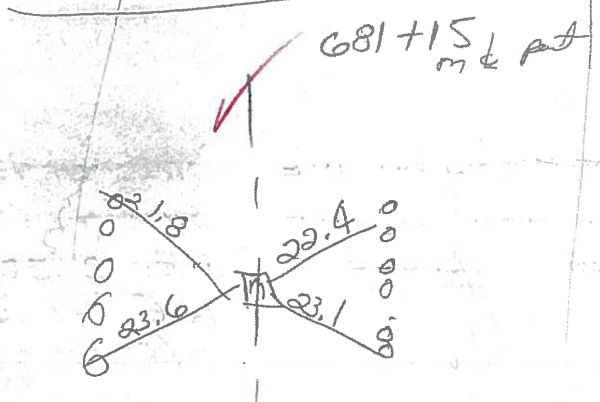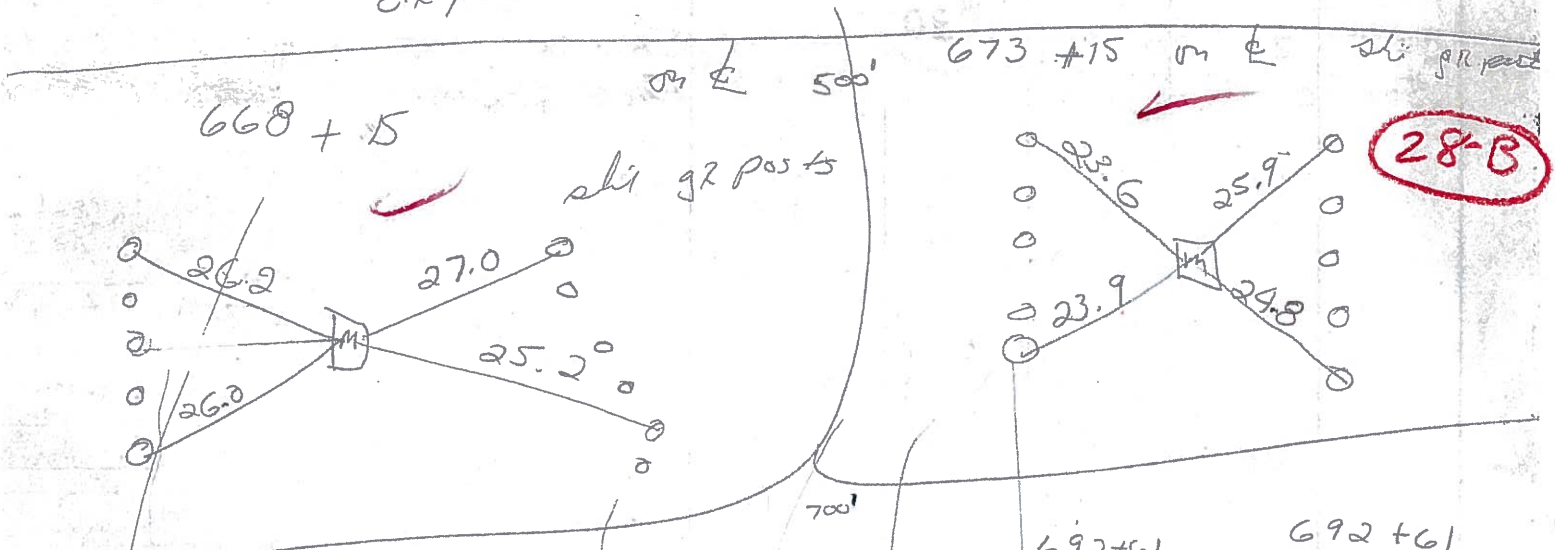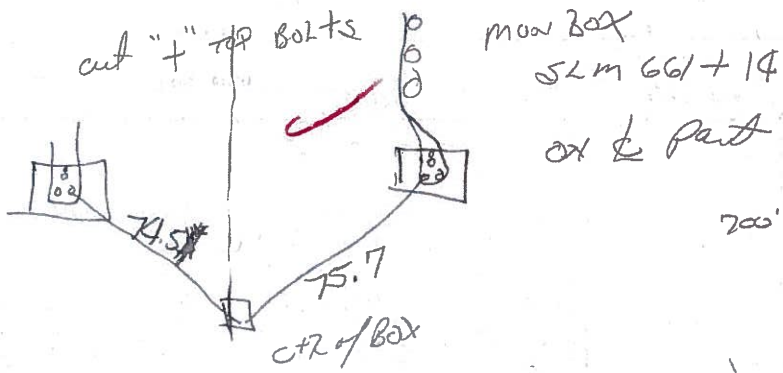

$$\begin{array}{r} 692+61 \\ 661+14 \\ \hline 31+47 \\ 26+40 \end{array}$$

$$\begin{array}{r} 692+61 \\ 681+15 \\ \hline 11+46 \end{array}$$

$$\begin{array}{r} 692+61 \\ 668+15 \\ \hline 24+46 \end{array}$$