

O.D.O.T. DISTRICT 2 SURVEY OFFICE (USE ONLY)

PERSONNEL

REFERENCE NO. 28 C

SHEET 19 OF 36

NOTES O'DONNELL

DATE 3/14/22

ROUTE SR 281

H.C. AUBLE

WEATHER SUNNY

COUNTY WOOD

R.C. NIESE

TEMP. 35°

TOWNSHIP PORTAGE

DWG BY RHOADES PID 94340

SECTION 19

T 4 N R 11 E

TYPE MONUMENT MONBOX W/ 1" IPIN

ON SURFACE - ~~BELOW~~ ON

OFFSET  $\oslash$  PAVEMENT 0.4' LT : ~~RT~~

11.2' TO RT EDGE PAVEMENT


STATION: 680+24.45

HORZ.DATUM: NAD83 2011


GEOID: NAVD88 2018

GRID: NORTHING: 590751.134

EASTING: 1656500.331

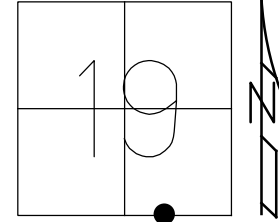


RECORD:  
 COULD NOT OPEN BOX  
 TIES TO CTR LID  
 6-5-90, CL  
 FD MONBOX  
 9-27-00  
 7-8-04, RGN  
 FD MONBOX  
 W/1" IPIN  
 REFC28  
 3-19-18, JLL

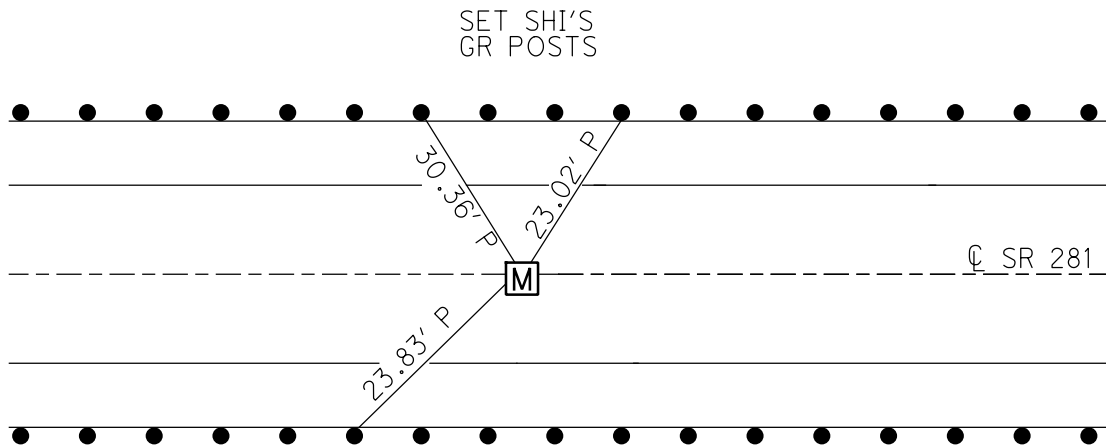

O.D.O.T. DISTRICT 2 SURVEY OFFICE (USE ONLY)


PERSONNEL \_\_\_\_\_ REFERENCE NO. 28 C SHEET 19 OF 27  
 NOTES NUHFER DATE 5-25-04 ROUTE SR 281  
 H.C. HOMAN WEATHER CLEAR COUNTY WOOD  
 R.C. ADKINS TEMP. 68° TOWNSHIP PORTAGE  
 \_\_\_\_\_ SECTION 19  
 DWG BY JAMES PID 97957 T 4 N R 11 E

TYPE MONUMENT MONBOX  
 ON SURFACE - ~~BELOW~~ ON  
 OFFSET  $\varnothing$  PAVEMENT 0.4' ~~RT~~ : RT  
11.4' TO RT EDGE PAVEMENT  
 STATION: 682+34.19

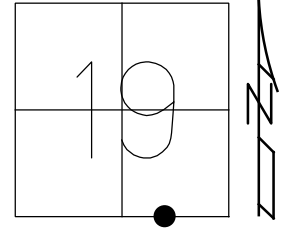

HORIZ.DATUM: NAD83 2011 GEOID: NAVD88 2012A  
 GRID: NORTHING: 590751.134 EASTING: 1656500.331

RECORD:  
 COULD NOT OPEN BOX  
 TIES TO CTR LID  
 6-5-90, CL  
 FD MONBOX  
 9-27-00  
 7-8-04, RGN  
 FD MONBOX  
 W/1" IPIN  
 REFC28  
 3-19-18, JLL

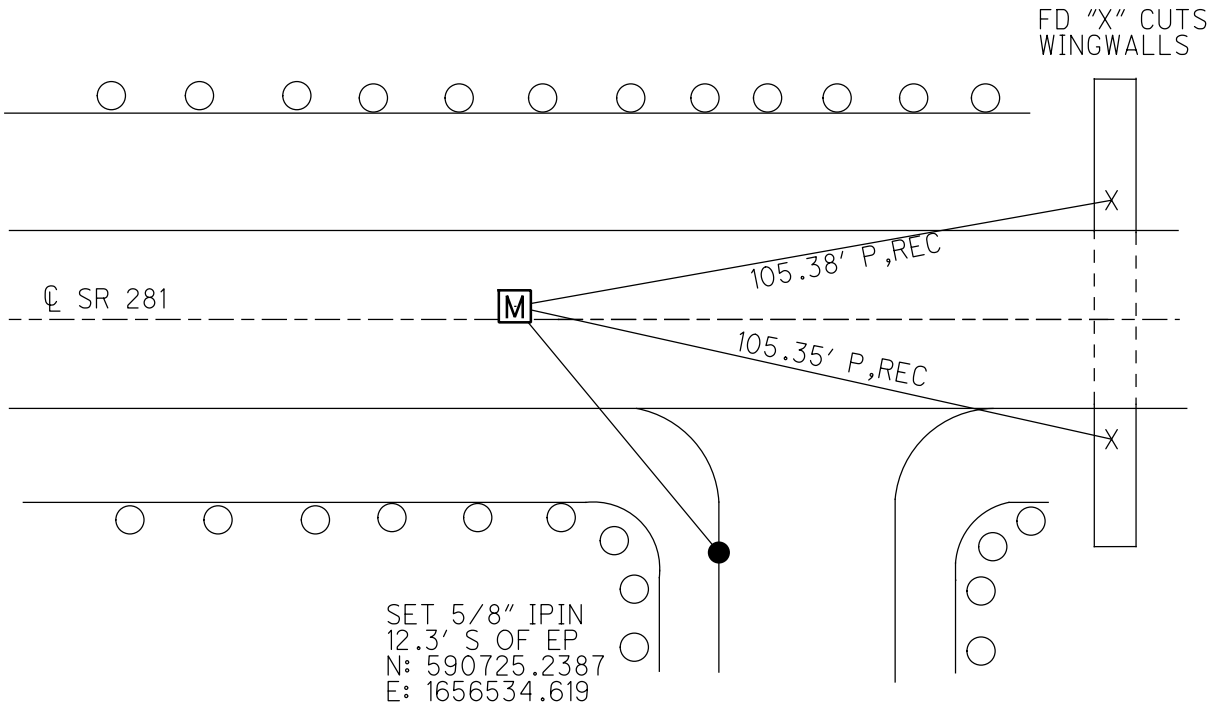

O.D.O.T. DISTRICT 2 SURVEY OFFICE (USE ONLY)

PERSONNEL

REFERENCE NO. 28-C

SHEET 19 OF 25

NOTES NUHFER

DATE 5-25-04

ROUTE S.R. 281

H.C. HOMAN

WEATHER CLEAR

COUNTY WOOD

R.C. ADKINS

TEMP. +68°

TOWNSHIP PORTAGE

SECTION 19

T 4 N R 11 E

TYPE MONUMENT MONUMENT BOX


ON SURFACE - ~~BELOW~~ YES

~~BELOW~~ - ☉ PAV'T - RIGHT 0.4'

11.4' TO RT. EDGE PAVEMENT


S.L.M. 680+68

Grid: Northing: \_\_\_\_\_ Easting: \_\_\_\_\_

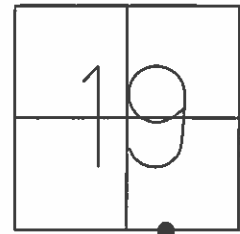

DID NOT OPEN BOX  
TIES TO CTR OF LID  
(COULD NOT OPEN)

NOTE: MON BOX VISIBLE  
7-8-04  
RGN

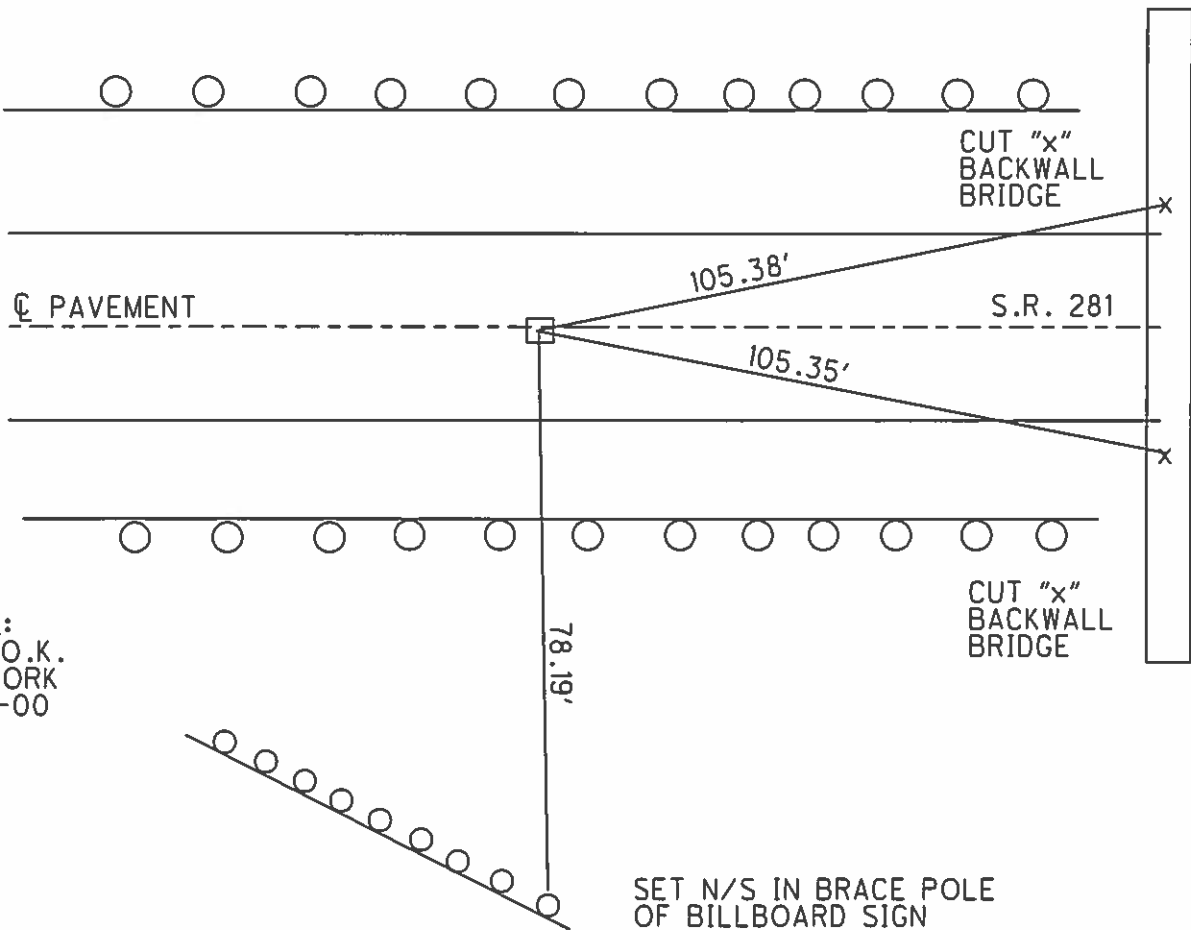

NOTE:  
BOX O.K.  
NO WORK  
9-27-00

SET N/S IN BRACE POLE  
OF BILLBOARD SIGN

# O.D.O.T. DISTRICT 2 SURVEY OFFICE

PERSONNEL

REFERENCE NO. 28-C

SHEET 5 OF 11

NOTES HOFFMAN

H.C. LOGHRS

DATE 6-5-90

ROUTE SR 281

R.C. BARNHISEL

WEATHER CLEAR

COUNTY WOOD

TEMP. 68°

TOWNSHIP PORTAGE

SECTION 19

T.4 N R.11 E


TYPE MONUMENT MONUMENT BOX

ON SURFACE - BELOW YES


LEFT- & PAV'T. - RIGHT YES

11.9 TO RT. EDGE PAVEMENT

S.L.M. 680 + 68

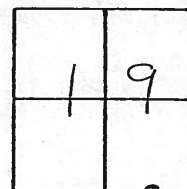

DID NOT OPEN BOX  
TUES TO CTR of LID

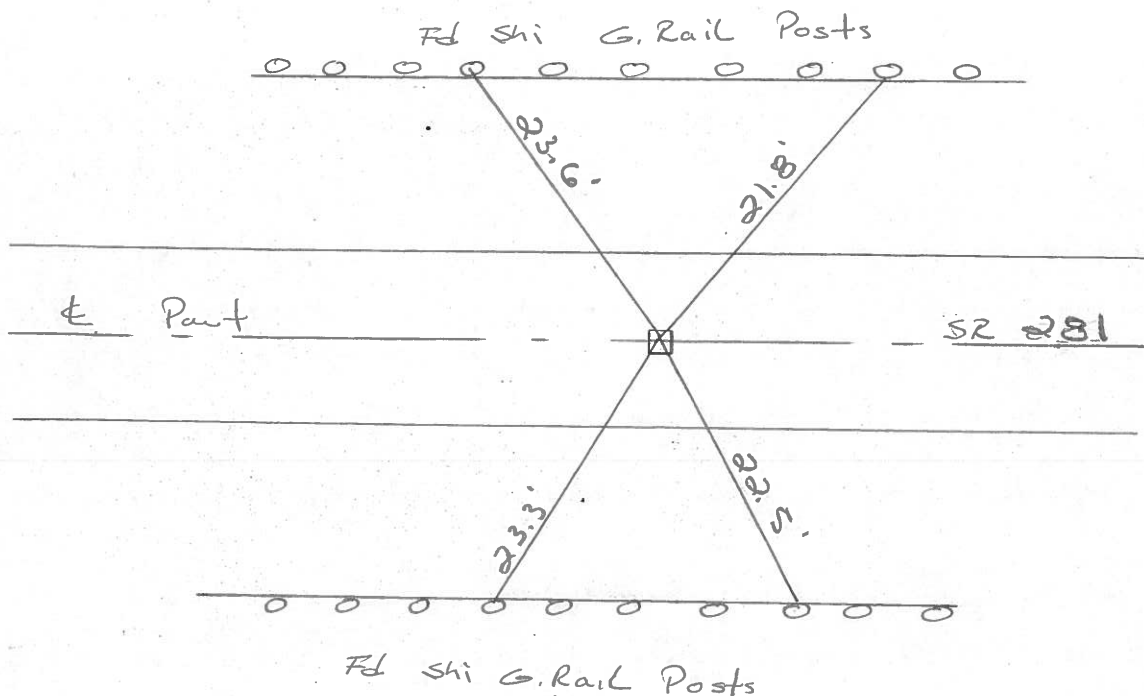

NOTE!  
BOX O.K.  
NO WORK.  
9-27-00

ODOT. DISTRICT 2 SURVEY OFFICE

SHEET \_\_\_\_\_ OF \_\_\_\_\_

County WOOD S.R. 281

Date MARCH 28, 83

Township PORTAGE

Weather OVERCAST - WINDY

Section 19

Temp. +30°

T4N, R11E


Personnel HOFFMAN

LOHRKE

HOUSEHOLDER

BARNHISEL


26-0




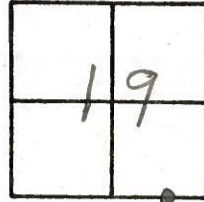


Fd  MON. BOX @ SURFACE  $\checkmark$  5/25/83  
ON  $\&$  PAUT

SLM 681+15

DID NOT OPEN BOX -  
TIES TO CTR OF RD.

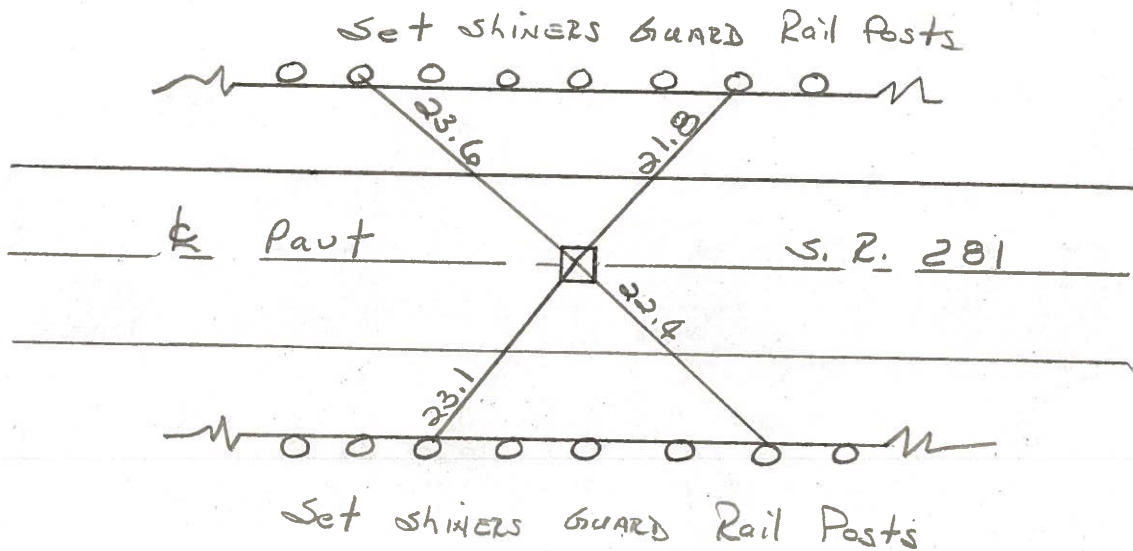

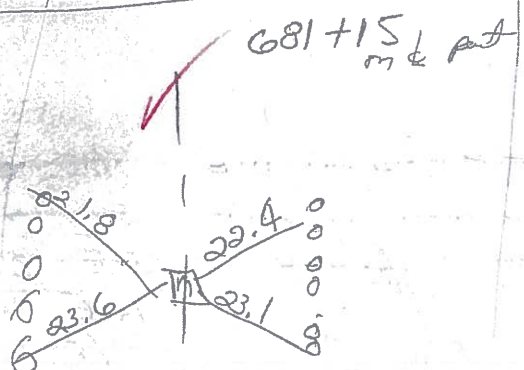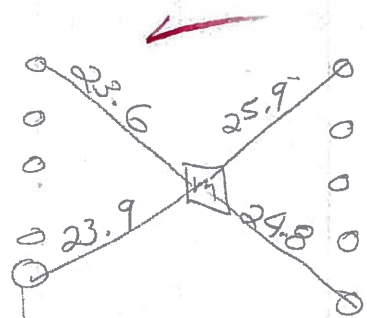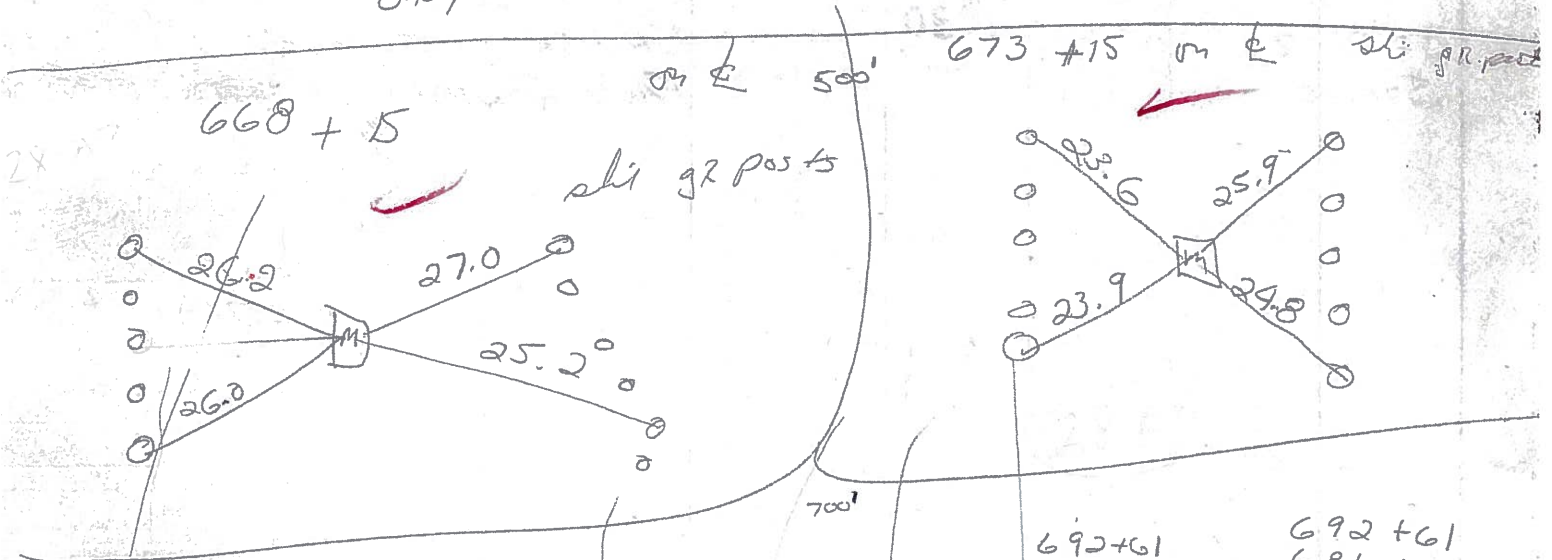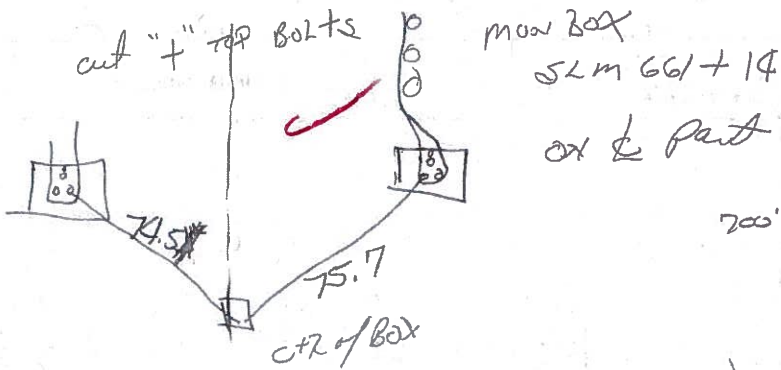

**28-C**

$$\begin{array}{r} 692 + 61 \\ 661 + 14 \\ \hline 31 + 47 \\ 36 + 40 \end{array}$$

$$\begin{array}{r} 692 + 61 \\ 681 + 15 \\ \hline 11 + 46 \end{array}$$

$$\begin{array}{r} 692 + 61 \\ 668 + 15 \\ \hline 24 + 46 \end{array}$$