


O.D.O.T. DISTRICT 2 SURVEY OFFICE (USE ONLY)


PERSONNEL _____ REFERENCE NO. 45 B SHEET 6 OF 51
 NOTES MILLER DATE 6/14/23 ROUTE SR 281
 H.C. AUBLE WEATHER BREEZY COUNTY WOOD
 R.C. NIESE TEMP. 57° TOWNSHIP MONTGOMERY
 BEJARANO SECTION 21
 DWG BY RHOADES PID CHIP SEAL T 4 N R 12 E

TYPE MONUMENT MAG/WASHER
 ON SURFACE - ~~BELOW~~ ON
 OFFSET ☐ PAVEMENT 1.3' ~~LF~~ : RT
8.3' TO RT EDGE PAVEMENT
 STATION: 1080+00

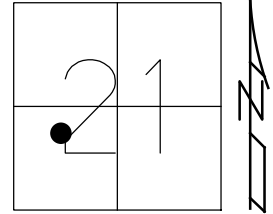

HORZ.DATUM: NAD83 2011 GEOID: NAVD88 2018
 GRID: NORTHING: 592756.444 EASTING: 1695087.699

WOOD LPD:
 N: 415161.857
 E: 206656.007

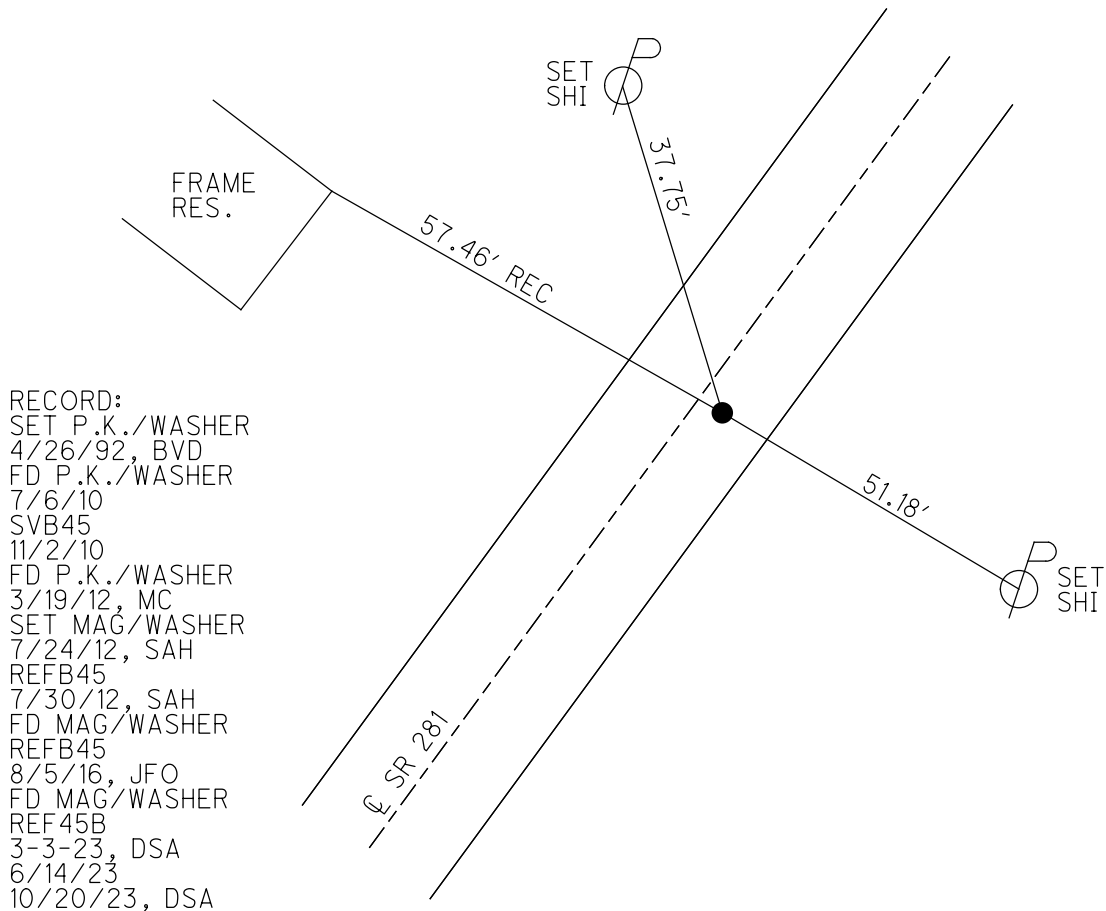


RECORD:
 SET P.K./WASHER
 4/26/92, BVD
 FD P.K./WASHER
 7/6/10
 SVB45
 11/2/10
 FD P.K./WASHER
 3/19/12, MC
 SET MAG/WASHER
 7/24/12, SAH
 REFB45
 7/30/12, SAH
 FD MAG/WASHER
 REFB45
 8/5/16, JFO
 FD MAG/WASHER
 REF45B
 3-3-23, DSA
 6/14/23
 10/20/23, DSA


O.D.O.T. DISTRICT 2 SURVEY OFFICE (USE ONLY)

PERSONNEL _____ REFERENCE NO. 45 B SHEET 6 OF 49
 NOTES HUSS DATE 3/19/12 ROUTE SR 281
 H.C. CANTERBURY WEATHER CLEAR COUNTY WOOD
 R.C. HUSS TEMP. 70° TOWNSHIP MONTGOMERY
 _____ SECTION 21
 _____ T 4 N R 12 E

TYPE MONUMENT P.K./WASHER
 ON SURFACE - ~~BELOW~~ ON
~~LEFT~~ - Q PAV'T - RIGHT 1.3'
8.3' TO RT EDGE PAVEMENT
 S.L.M. 1080+00

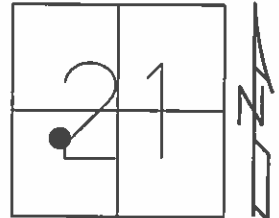

GRID: NORTHING: 592756.421 EASTING: 1695087.720

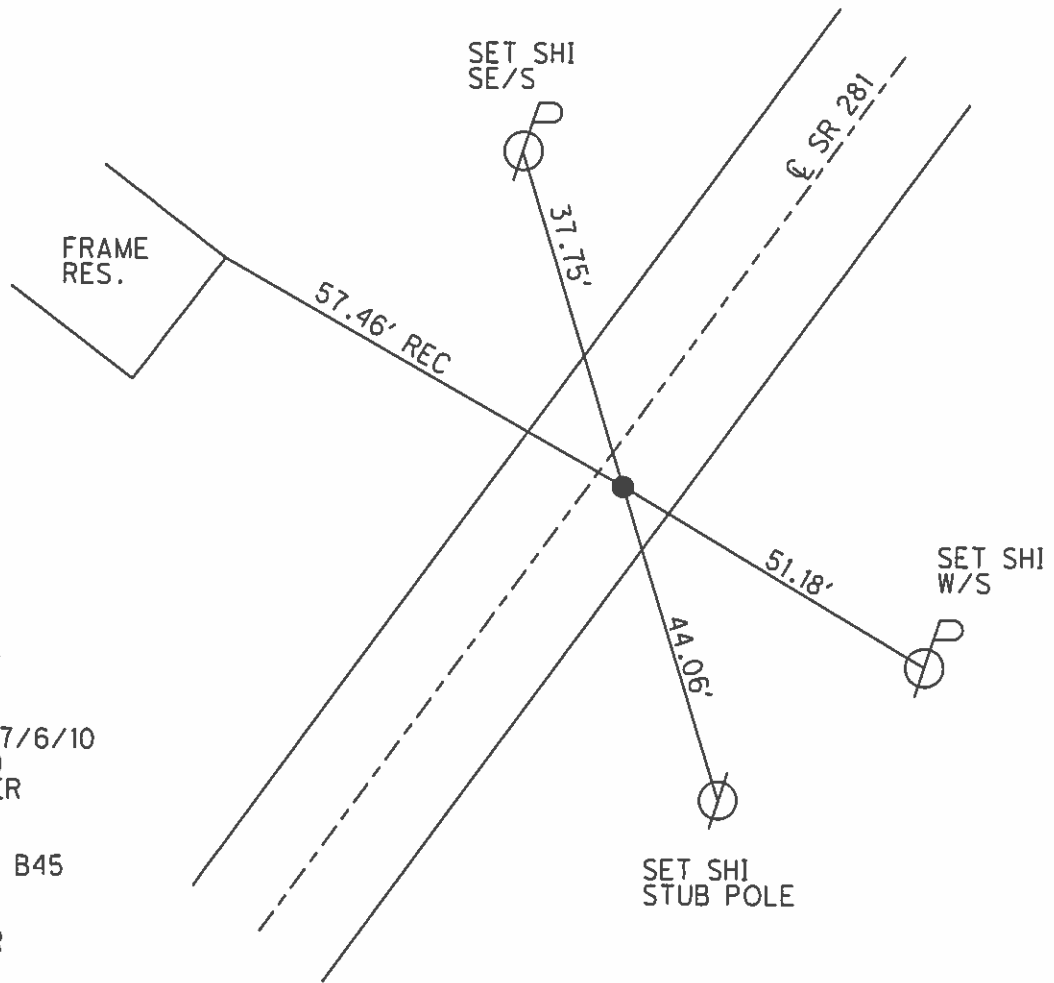

SET PK/WASHER
 4/26/92, BVD

FD PK/WASHER 7/6/10
 SV B45, 11/2/10
 SET MAG/WASHER
 7/24/12, SAH

FINAL GPS, REF B45
 7/30/12, SAH

FD MAG/WASHER
 REFB45
 8/5/16, JFO

O.D.O.T. DISTRICT 2 SURVEY OFFICE

PERSONNEL

REFERENCE NO. 45 a,b,c

SHEET OF

NOTES BARNHISEL

H.C. CUETIS

DATE 4-26-92

ROUTE 281

R.C. VAN DUSEN

WEATHER cloudy

COUNTY Wood

ROMETO

TEMP. +53°

TOWNSHIP MONTGOMERY

FISHER

SECTION 21

T 4 N R 12 E



TYPE MONUMENT NAILS & SHINERS

ON SURFACE - BELOW 4"

- PAV'T. - RIGHT 1.5 ±

 TO EDGE PAVEMENT

S.L.M.

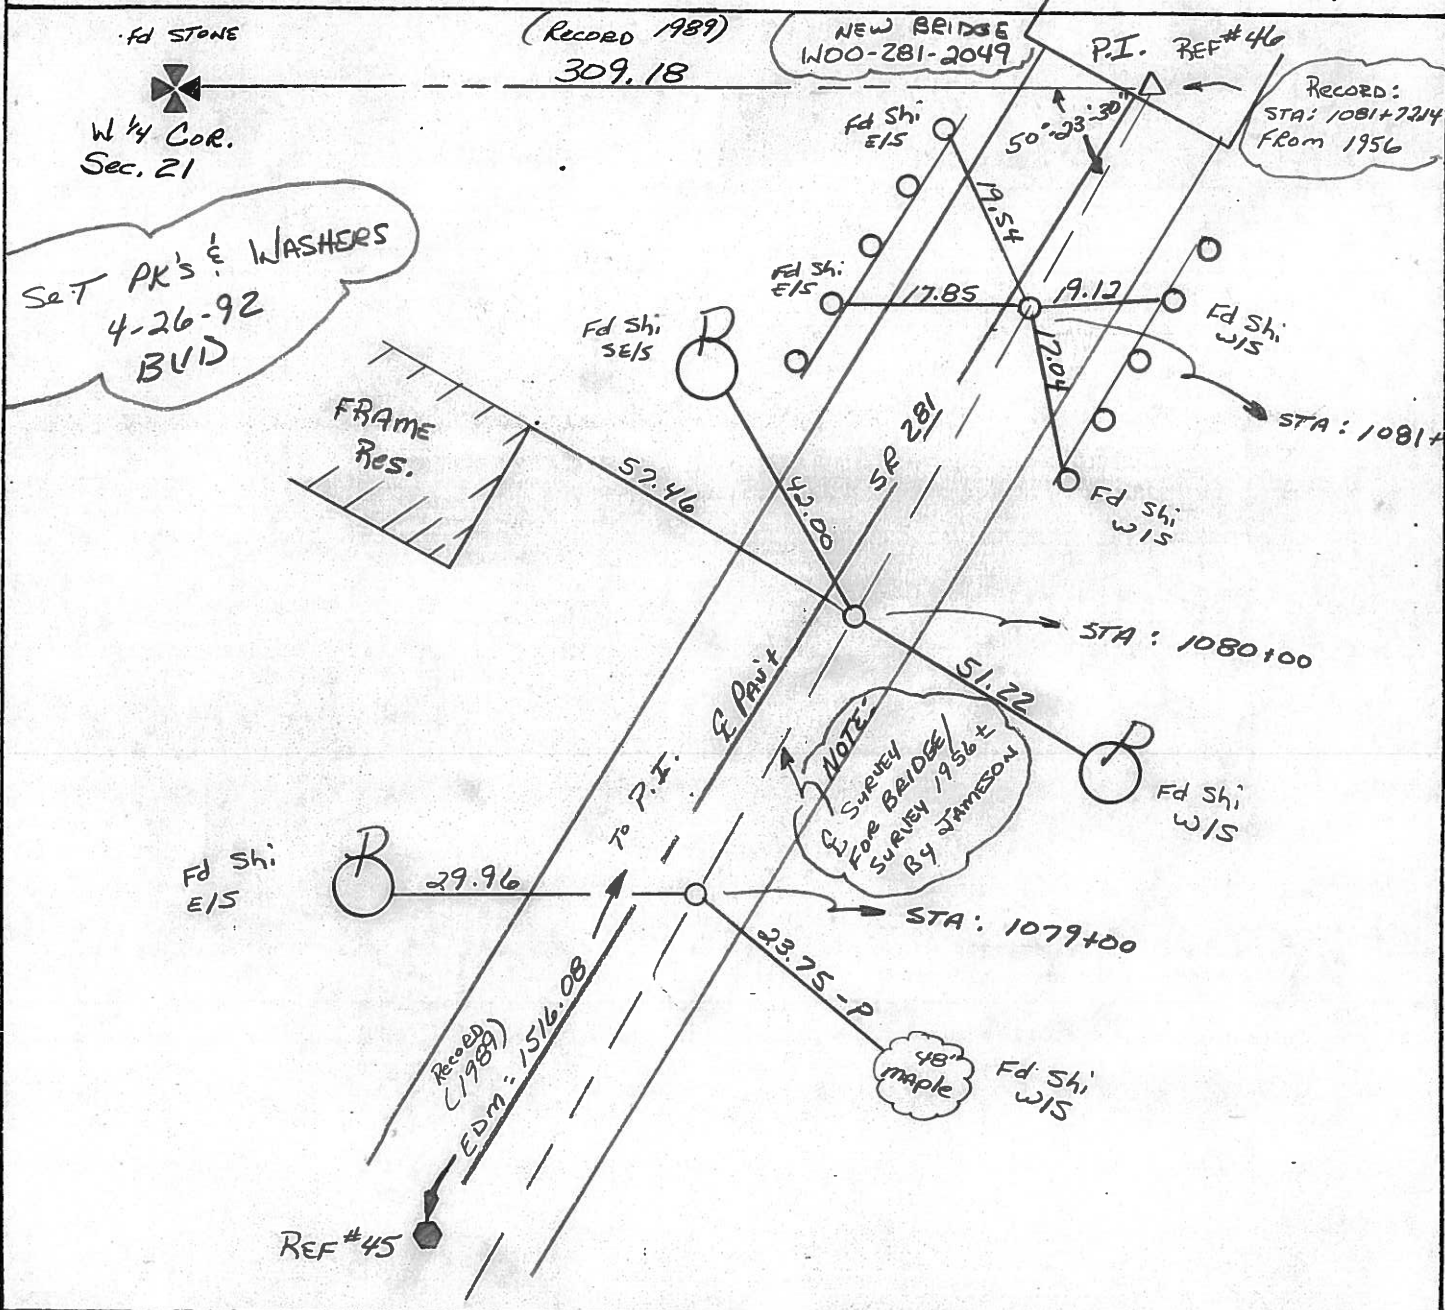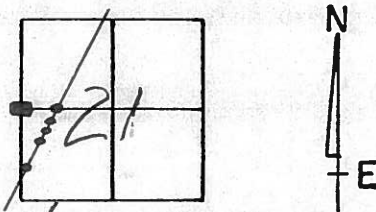

O.D.O.T. DISTRICT 2 SURVEY OFFICE

PERSONNEL

REFERENCE NO. 45-a,b,c

SHEET 1 OF 2

NOTES HOFFMAN

H.C. LOSHRKE

R.C. BARANISSEL

DATE MAY 11, 1989

WEATHER CLEAR

TEMP. 52°

ROUTE SR 281

COUNTY Woods

TOWNSHIP MONTGOMERY

SECTION 21

T 4 N R 12 E

TYPE MONUMENT Nail-shiner

ON SURFACE - BELOW 4"

LEFT - C PAV'T. - RIGHT 1.5' ±

TO EDGE PAVEMENT

S.L.M. _____

