

O.D.O.T. DISTRICT 2 SURVEY OFFICE (USE ONLY)

PERSONNEL

REFERENCE NO. 46 A

SHEET 8 OF 51

NOTES MILLER
 H.C. AUBLE
 R.C. NIESE
BEJARANO

DATE 6/14/23
 WEATHER BREEZY
 TEMP. 57°

ROUTE SR 281
 COUNTY WOOD
 TOWNSHIP MONTGOMERY
 SECTION 21

DWG BY RHOADES PID CHIP SEAL

T 4 N R 12 E

TYPE MONUMENT MAG/WASHER

ON SURFACE - ~~BELOW~~ ON

OFFSET Q PAVEMENT 16.5' LT : ~~RT~~
5' TO LT EDGE PAVEMENT


STATION: 1115+90

HORZ.DATUM: NAD83 2011

GEOID: NAVD88 2018


GRID: NORTHING: 595571.559

EASTING: 1697333.330

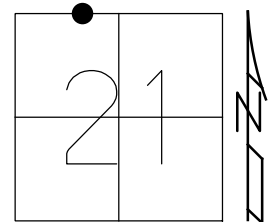

RECORD:
 UNKNOWN ORIGIN
 FD MAG/WASHER
 REF46A
 3/3/23, JAM
 6/14/23
 10/20/23, DSA

WOOD LPD:
 N: 418006.584
 E: 208864.479

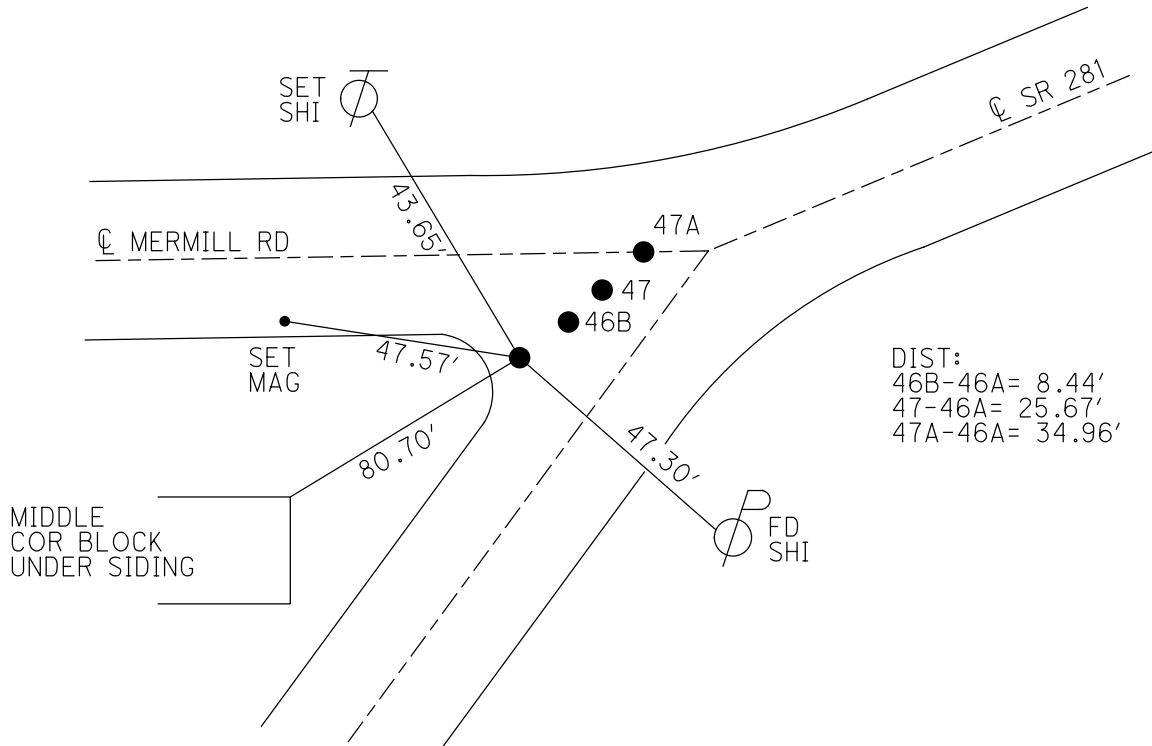

DIST:
 46B-46A= 8.44'
 47-46A= 25.67'
 47A-46A= 34.96'

O.D.O.T. DISTRICT 2 SURVEY OFFICE (USE ONLY)

PERSONNEL

REFERENCE NO. 46 A

SHEET 9 OF 52

NOTES AUBLE

DATE 3/3/23

ROUTE SR 281

H.C. MILLER

WEATHER CLOUDY

COUNTY WOOD

R.C. NIESE

TEMP. 40°

TOWNSHIP MONTGOMERY

SECTION 21

DWG BY MILLER PID R/W, NO PID

T 4 N R 12 E

TYPE MONUMENT MAG/WASHER

ON SURFACE - ~~BELOW~~ ON

OFFSET CL PAVEMENT 16.5' LT : ~~RT~~

5' TO LT EDGE PAVEMENT


STATION: 1115+90

HORZ. DATUM: NAD83(2011)

GEOID: NAVD88 2018

GRID: NORTHING: 595571.578

EASTING: 1697333.327

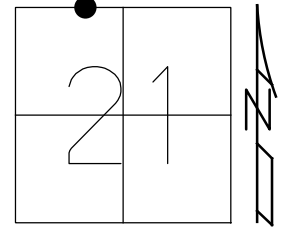

RECORD:
UNKNOWN ORIGIN
FD MAG/WASHER
REF 46A
3/3/23, JAM

