

O.D.O.T. DISTRICT 2 SURVEY OFFICE (USE ONLY)

PERSONNEL _____ REFERENCE NO. 46 B SHEET 9 OF 51
 NOTES MILLER DATE 6/14/23 ROUTE SR 281
 H.C. AUBLE WEATHER BREEZY COUNTY WOOD
 R.C. NIESE TEMP. 57° TOWNSHIP MONTGOMERY
 BEJARANO SECTION 21
 DWG BY RHOADES PID CHIP SEAL T 4 N R 12 E

TYPE MONUMENT NAIL


~~ON SURFACE~~ - BELOW 1"

OFFSET \oslash PAVEMENT 13.25' LT : ~~RT~~
2.7' TO LT EDGE PAVEMENT

STATION: 1115+98


HORZ. DATUM: NAD83 2011 GEOID: NAVD88 2018

GRID: NORTHING: 595574.021 EASTING: 1697341.450

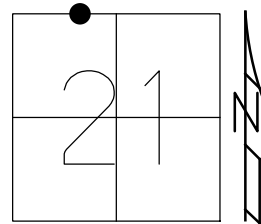

RECORD:
 UNKNOWN ORIGIN
 FD HOLE
 W/BENT NAIL
 1" DOWN
 REF 46B
 3/3/23, JAM
 6/14/23
 10/20/23, DSA

WOOD LPD:
 N: 418009.153
 E: 208872.566

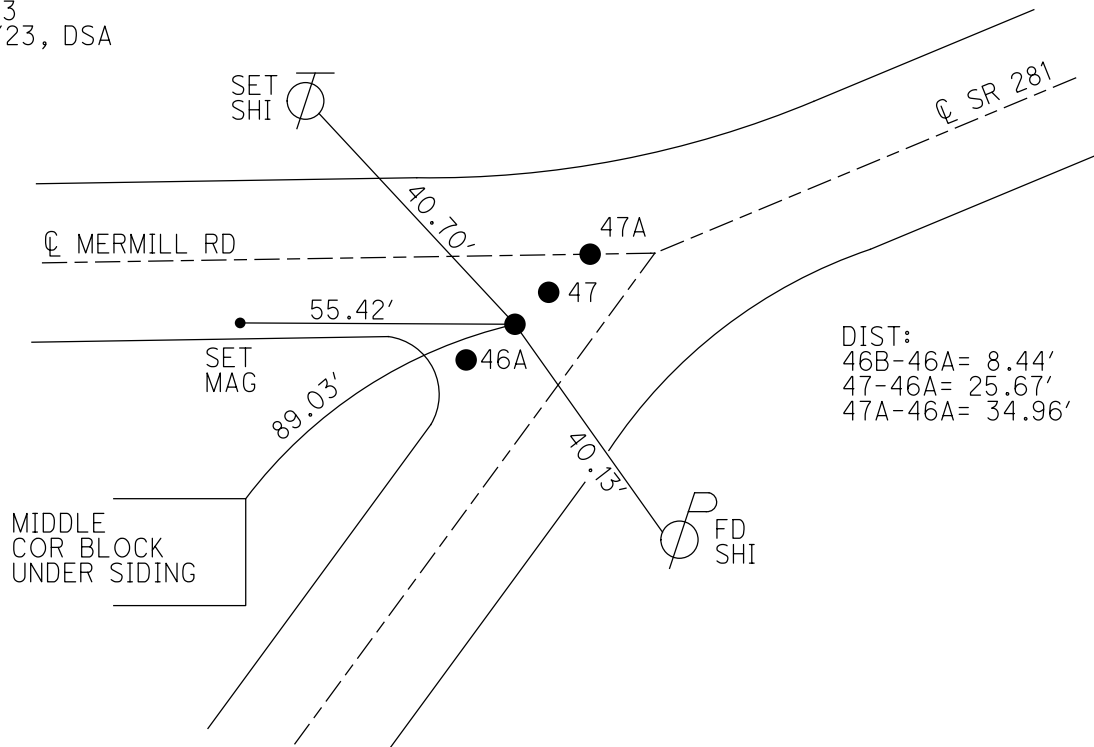

O.D.O.T. DISTRICT 2 SURVEY OFFICE (USE ONLY)

PERSONNEL _____

REFERENCE NO. 46B

SHEET 10 OF 52

NOTES AUBLE

DATE 3/3/23

ROUTE SR 281

H.C. MILLER

WEATHER CLOUDY

COUNTY WOOD

R.C. NIESE

TEMP. 40°

TOWNSHIP MONTGOMERY

SECTION 21

DWG BY MILLER

PID R/W, NO PID

T 4 N R 12 E

TYPE MONUMENT NAIL

~~ON SURFACE~~ - BELOW 1"

OFFSET \varnothing PAVEMENT 13.25' LT : ~~RT~~

2.7' TO LT EDGE PAVEMENT


STATION: 1115+98

HORZ.DATUM: NAD83(2011)

GEOID: NAVD88 2018

GRID: NORTHING: 595574.049

EASTING: 1697341.431

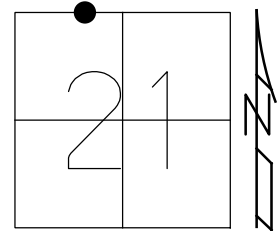

RECORD:
UNKNOWN ORIGIN
FD HOLE
W/BENT NAIL
1" DOWN
REF46B
3/3/23, JAM

