

O.D.O.T. DISTRICT 2 SURVEY OFFICE (USE ONLY)

PERSONNEL

REFERENCE NO. 49 BA

SHEET 16 OF 51

NOTES MILLER

DATE 6/14/23

ROUTE SR 281

H.C. AUBLE

WEATHER BREEZY

COUNTY WOOD

R.C. NIESE

TEMP. 57°

TOWNSHIP MONTGOMERY

BEJARANO

SECTION 16

DWG BY RHOADES

PID CHIP SEAL

T 4 N R 12 E

TYPE MONUMENT MAG/WASHER

ON SURFACE - ~~BELOW~~ ON

OFFSET ☉ PAVEMENT 2.2' ~~±~~ : RT

7.6' TO RT EDGE PAVEMENT


STATION: 1142+69

HORIZ.DATUM: NAD83 2011

GEOID: NAVD88 2018


GRID: NORTHING: 596654.145

EASTING: 1699440.905

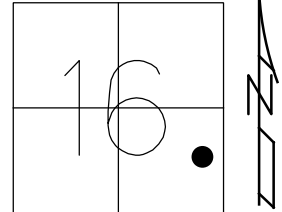

RECORD:
 ORIGIN UNKNOWN
 SET P.K./WASHER
 3/3/92, MB
 FD P.K./WASHER
 SVBB49
 11/2/10, SAH
 SET MAG/WASHER
 7/24/12, MC
 REFBB49
 7/30/12, SAH
 FD MAG/WASHER
 REF49AB
 6/14/23
 10/20/23, DSA


WOOD LPD:
 N: 419121.511
 E: 211301.752

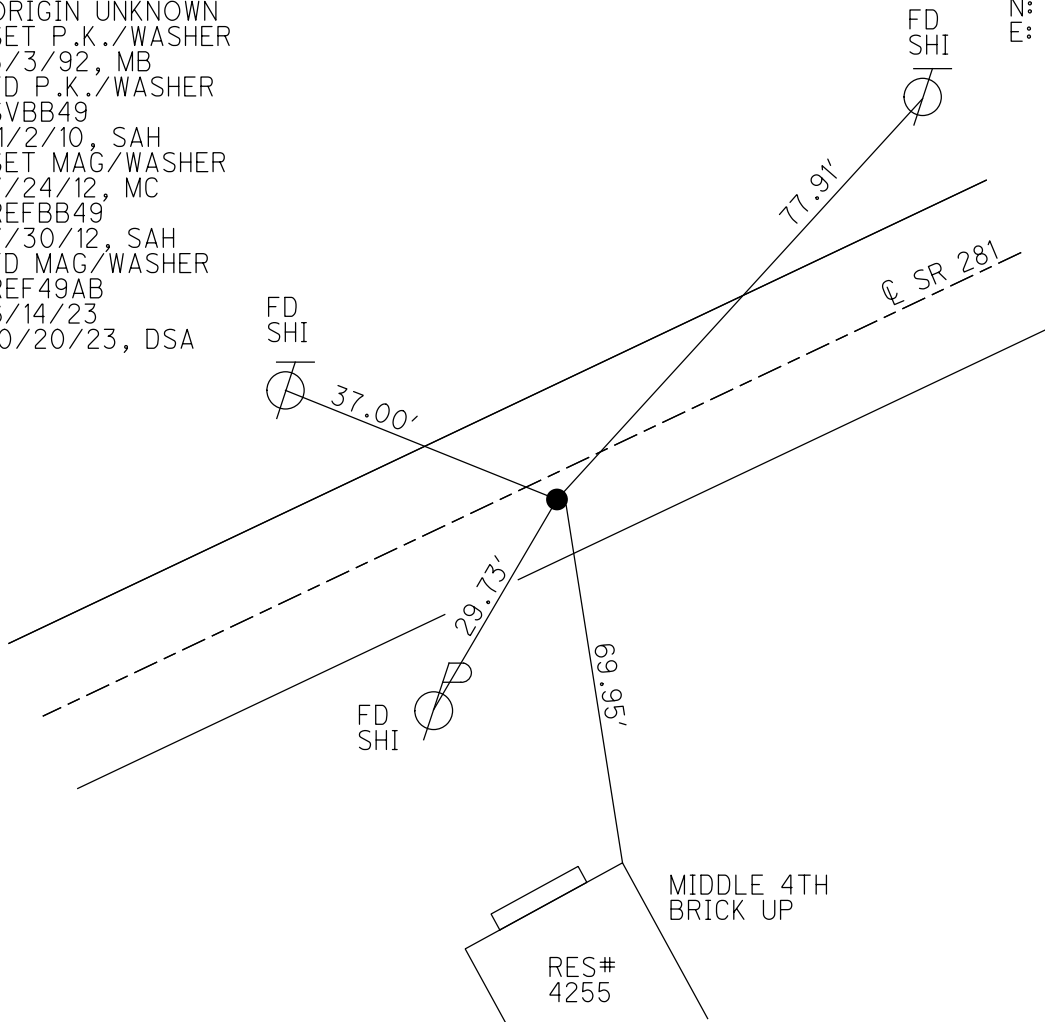

O.D.O.T. DISTRICT 2 SURVEY OFFICE (USE ONLY)

PERSONNEL	REFERENCE NO. <u>49 BA</u>	SHEET <u>14</u> OF <u>49</u>
NOTES <u>HUSS</u>	DATE <u>3/21/12</u>	ROUTE <u>SR 281</u>
H.C. <u>CANTERBURY</u>	WEATHER <u>CLEAR</u>	COUNTY <u>WOOD</u>
R.C. <u>HUSS</u>	TEMP. <u>74°</u>	TOWNSHIP <u>MONTGOMERY</u>
		SECTION <u>16</u>
		T <u>4</u> N R <u>12</u> E

TYPE MONUMENT P.K./WASHER
 ON SURFACE - ~~BELOW~~ ON
~~LEFT~~ - Q PAV'T - RIGHT 2.2'
7.6' TO RT EDGE PAVEMENT
 S.L.M. 1142+69

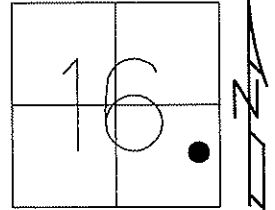


Grid: Northing: 596654.259 Easting: 1699784.817

RECORD:
 ORIGIN UNKNOWN

SET P.K./WASHER
 3/3/92, MB

RES#4246

FD P.K./WASHER
 8/9/10, SAH
 GPS, BB49, 11/2/10
 SET MAG/WASHER
 7/24/12, MC
 FINAL REF BB49
 7/30/12, SAH

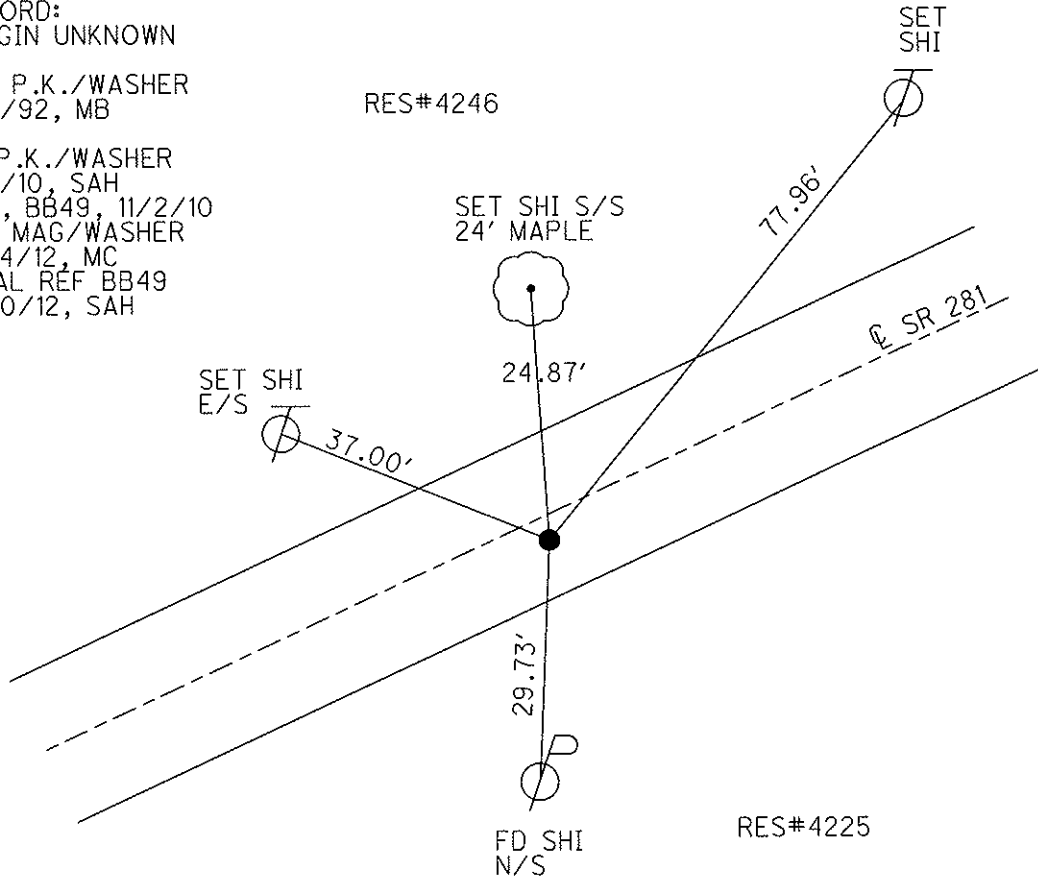

O.D.O.T. DISTRICT 2 SURVEY OFFICE

PERSONNEL _____

REFERENCE NO. 49-B-1

SHEET _____ OF _____

NOTES LOHRKE

H.C. VAN DUSEN

DATE 7-18-91

ROUTE S.R. 281

R.C. KUSZ

WEATHER clear

COUNTY WOOD

BARNSIEL

TEMP. +80°

TOWNSHIP MONTGOMERY

SECTION 16

T 4 N R 12 E

TYPE MONUMENT P.K. / WASHER



ON SURFACE - BELOW yes

LEFT - Q PAV'T. - RIGHT 2.2

8.8 TO RT EDGE PAVEMENT


S.L.M. 1142+69

49-BA

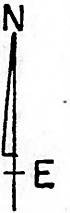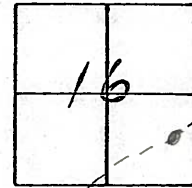

ORIGIN UNKNOWN

Set P.K. & WASHER
3-3-92
MB

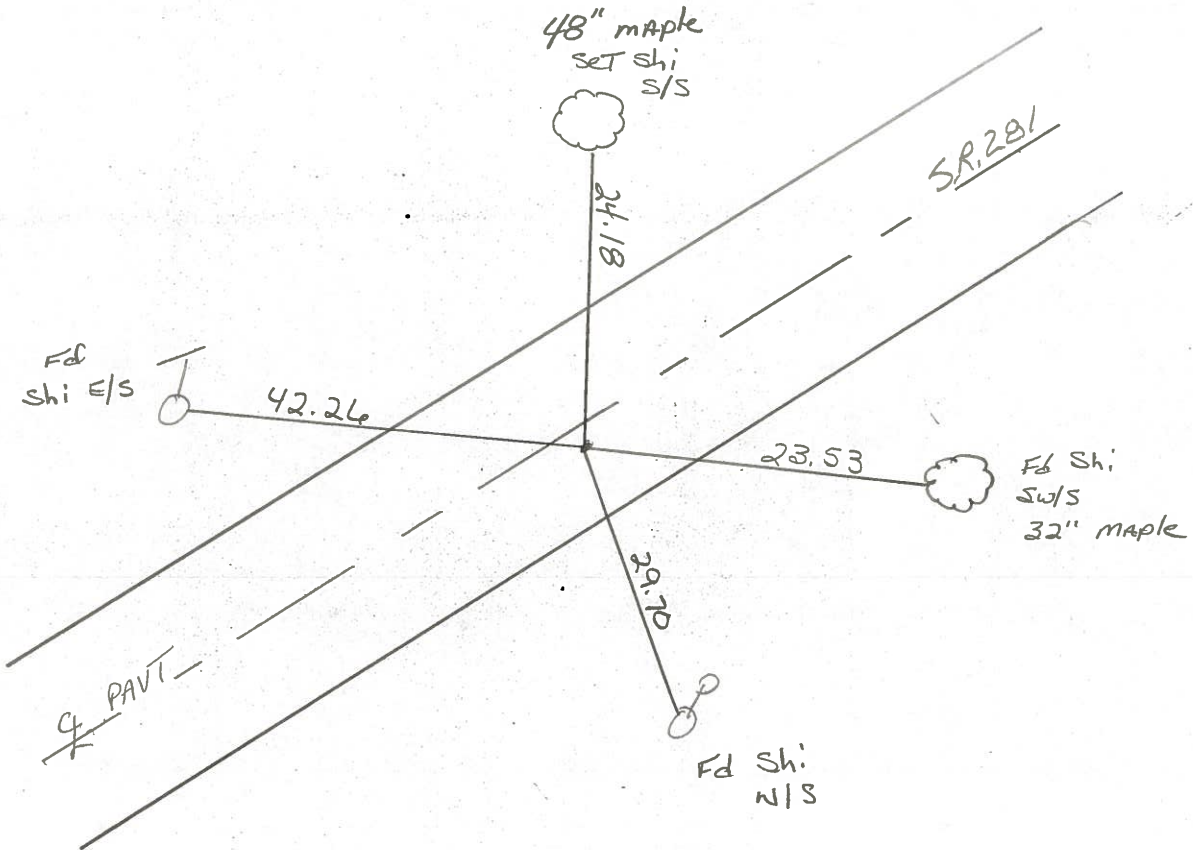

Q.D.O.T. DISTRICT 2 SURVEY OFFICE

SHEET _____ OF _____

County Wood S.R. 281

Date 12-19-83

Township MONTGOMERY

Weather Cloudy

Section 16

Temp. +15°

T4N, R12E


Personnel HOFFMANN

HOUSEHOLDER R.C.

BARNHISEL H.C.

#49-B-1

49-BA

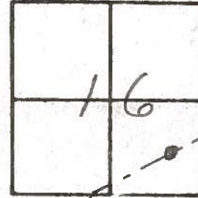

Fd. R.L. SPK @ SURFACE ; ORIGIN UNKNOWN

S.L.M. 1142 +66

3.0' RT. & PAUT


12.4' TO LT. EP

7.7' TO RT. EP

Set P.K./ Washer

8-15-84

S.W.H.

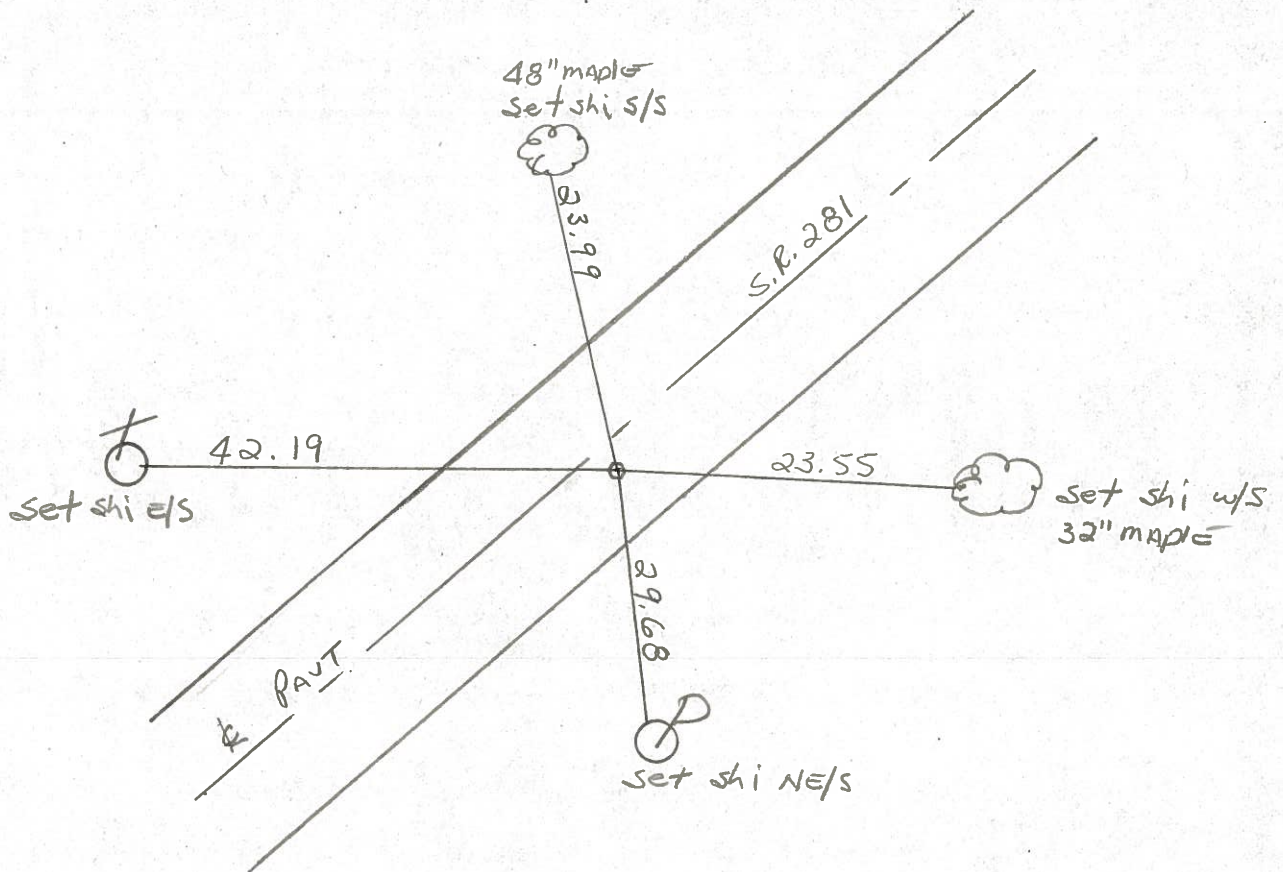


PERSONNEL TITLE PERSONNEL TITLE
MORRISON _____

COUNTY WOOD DATE APRIL 6 1959

S. R. 281 WEATHER Cloudy & Windy

SEC. WAYNE, Ohio. TEMP. +65°

DESCRIPTION LEFT CENTER LINE RIGHT JOB NO. _____

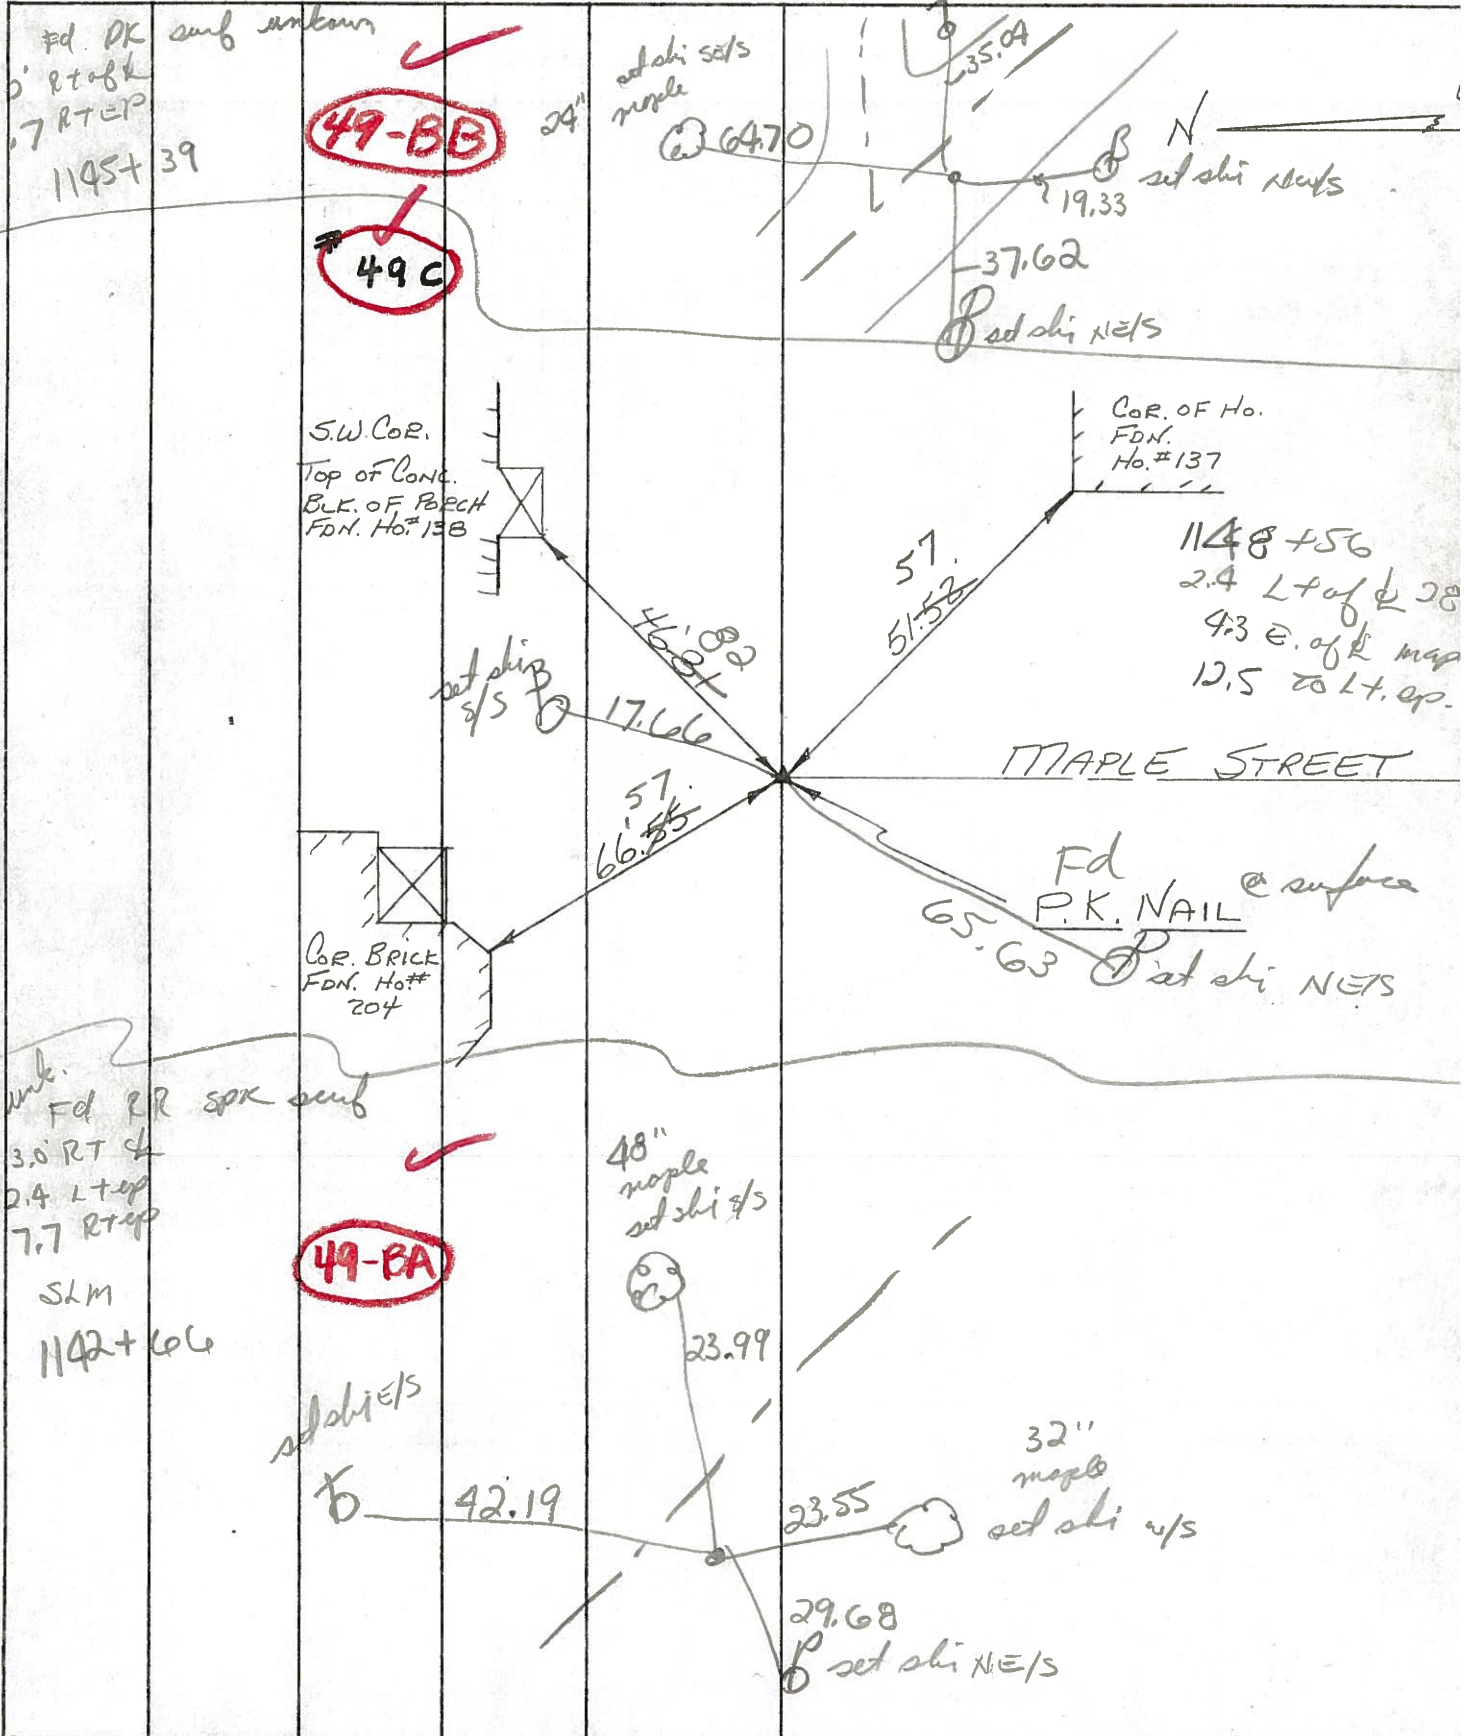

Fd. PK surf unkwn
2.0' RT of k
9.7' RT EP
1145+39

49-BB

49C

S.W. CoR.
TOP OF CONC.
BLK. OF BRICK
FDN. Ho# 138

CoR. BRICK
FDN. Ho# 204

unk. Fd RR spk surf
3.0' RT of
12.4' LT top
7.7' RT top
SLM
1142+66

49-BA

48" maple set shi s/s

32" maple set shi w/s

CoR. OF Ho.
FDN.
Ho. # 137

1148+56
2.4' LT of k 28
4.3' E. of k map
12.5' to LT. ep.

MAPLE STREET

Fd P.K. NAIL @ surface
65.63 set shi NETS

29.68 set shi N/E/S