

O.D.O.T. DISTRICT 2 SURVEY OFFICE (USE ONLY)

PERSONNEL

REFERENCE NO. 49 BB

SHEET 17 OF 51

NOTES MILLER DATE 6/14/23
 H.C. AUBLE WEATHER BREEZY
 R.C. NIESE TEMP. 57°
BEJARANO

ROUTE SR 281
 COUNTY WOOD
 TOWNSHIP MONTGOMERY
 SECTION 16

DWG BY RHOADES PID CHIP SEAL

T 4 N R 12 E

TYPE MONUMENT MAG/WASHER

ON SURFACE - ~~BELOW~~ ON

OFFSET 0.9' ~~RT~~ : RT

10.6' TO RT EDGE PAVEMENT


STATION: 1145+41

HORIZ.DATUM: NAD83 2011

GEOID: NAVD88 2018


GRID: NORTHING: 596762.313

EASTING: 1700032.100

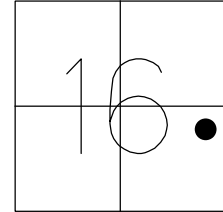

RECORD:
 ORIGIN UNKNOWN
 SET P.K./WASHER
 3/3/92, MB
 FD P.K./WASHER
 8/9/10, SAH
 BBB49, 11/16/10
 FD P.K./WASHER
 3/21/12, MC
 SET MAG/WASHER
 7/24/12, MC
 REFBBB49
 7/30/12, SAH
 FD MAG/WASHER
 REF49BB
 6/14/23
 10/20/23, DSA


WOOD LPD:
 N: 419232.941
 E: 211547.518

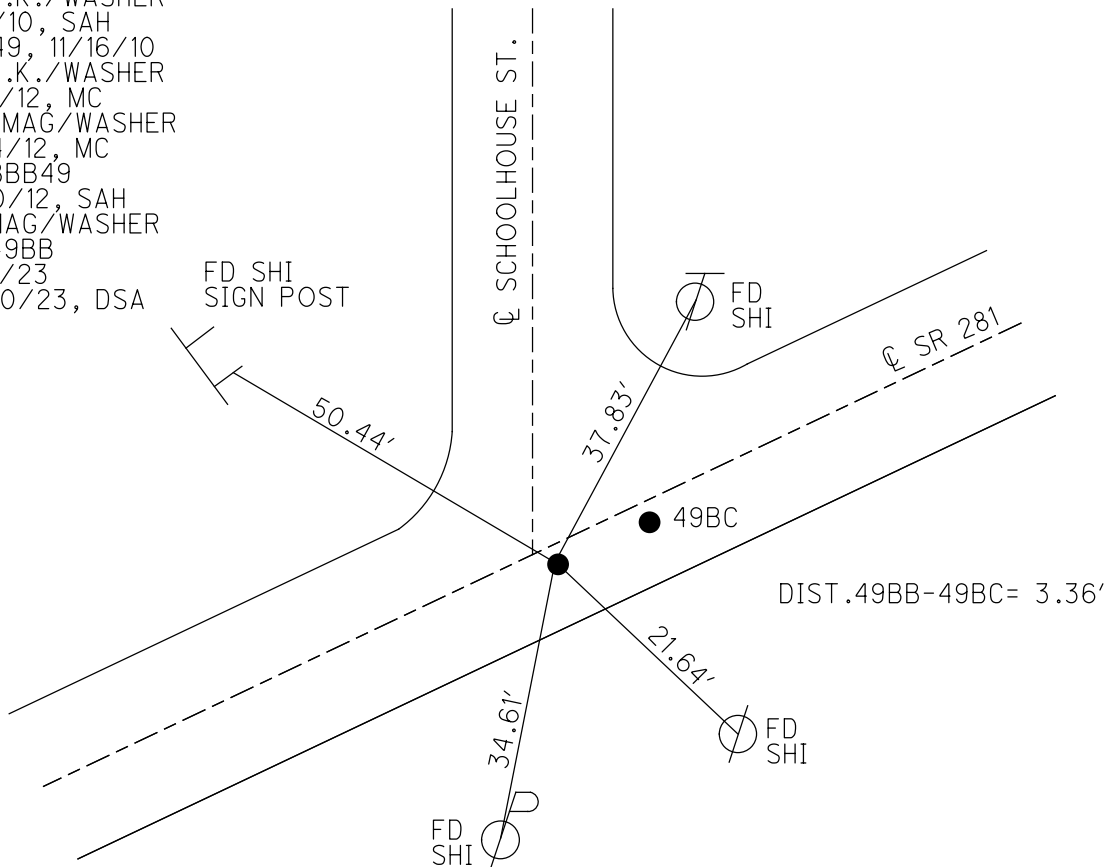

O.D.O.T. DISTRICT 2 SURVEY OFFICE (USE ONLY)

PERSONNEL	REFERENCE NO. <u>49 BB</u>	SHEET <u>15</u> OF <u>49</u>
NOTES <u>HUSS</u>	DATE <u>3/21/12</u>	ROUTE <u>SR 281</u>
H.C. <u>CANTERBURY</u>	WEATHER <u>CLEAR</u>	COUNTY <u>WOOD</u>
R.C. <u>HUSS</u>	TEMP. <u>74°</u>	TOWNSHIP <u>MONTGOMERY</u>
		SECTION <u>16</u>
		T <u>4</u> N R <u>12</u> E


TYPE MONUMENT P.K./WASHER
 ON SURFACE - ~~BELOW~~ ON _____
~~LEFT~~ - \odot PAV'T - RIGHT 0.9'
10.6' TO RT EDGE PAVEMENT
 S.L.M. 1145+41
 Grid: Northing: 596762.384 Easting: 1700032.094

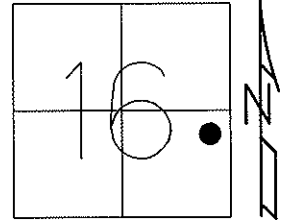

RECORD:
 ORIGIN UNKNOWN

SET P.K./WASHER
 3/3/92, MB

FD P.K./WASHER
 8/9/10, SAH
 GPS, BBB49, 11/16/10
 SET MAG/WASHER
 7/24/12, MC
 FINAL REF BBB49
 7/30/12, SAH

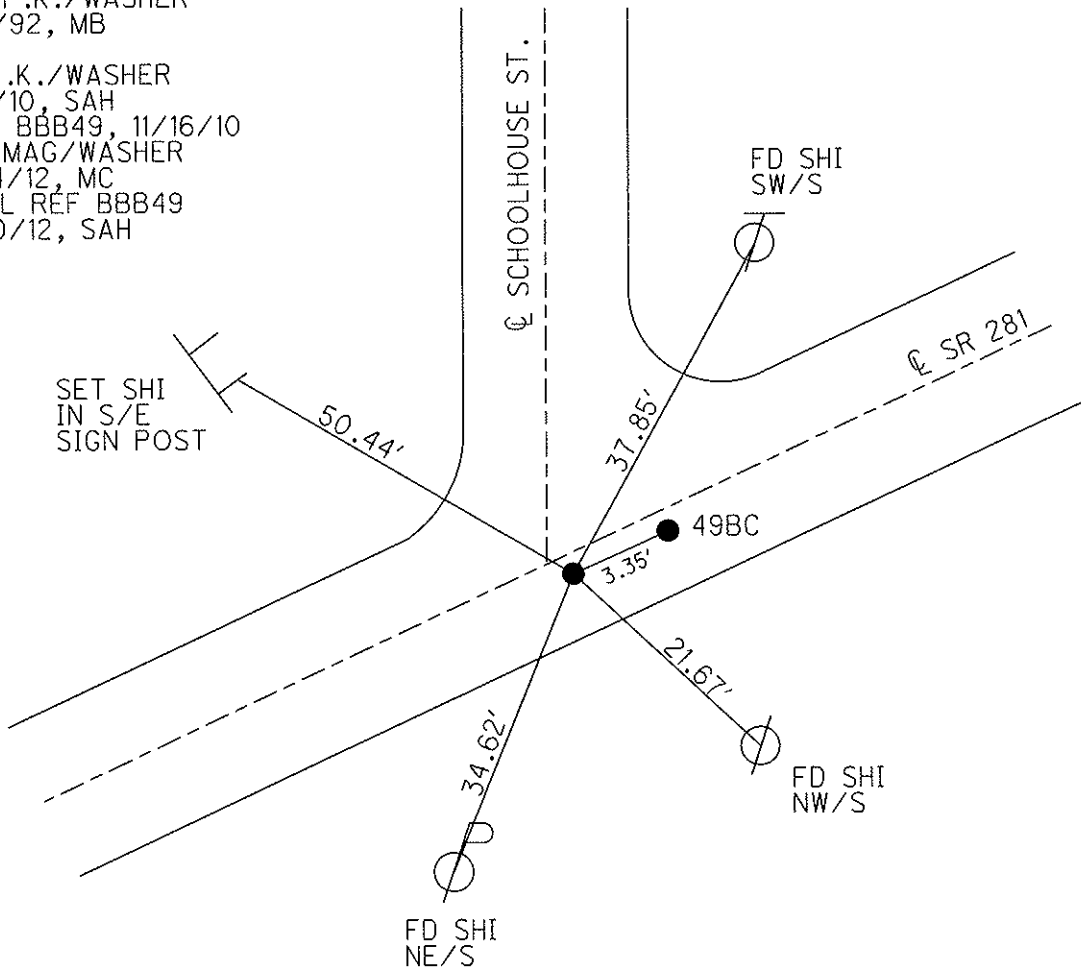

O.D.O.T. DISTRICT 2 SURVEY OFFICE

PERSONNEL _____

REFERENCE NO. 4982

SHEET _____ OF _____

NOTES LOEHRKE

H.C. VAN DUSEN

DATE 7-18-91

ROUTE S.R. 281

R.C. KUSZ

WEATHER Clear

COUNTY WOOD

BARNHISEL

TEMP. +80°


TOWNSHIP MONTGOMERY

SECTION 16

T4 N R12 E

49-BB

49-BC

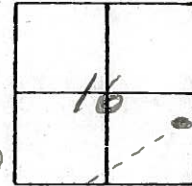

TYPE MONUMENT P.K. / Washer

ON SURFACE - BELOW yes

LEFT - & PAV'T. - RIGHT 2.2


10.7 TO RT EDGE PAVEMENT

S.L.M. 1145+46 TO EAST POINT

3.35 Between

ORIGIN UNKNOWN

Set P.K.'s & Washers
3-3-92
MB

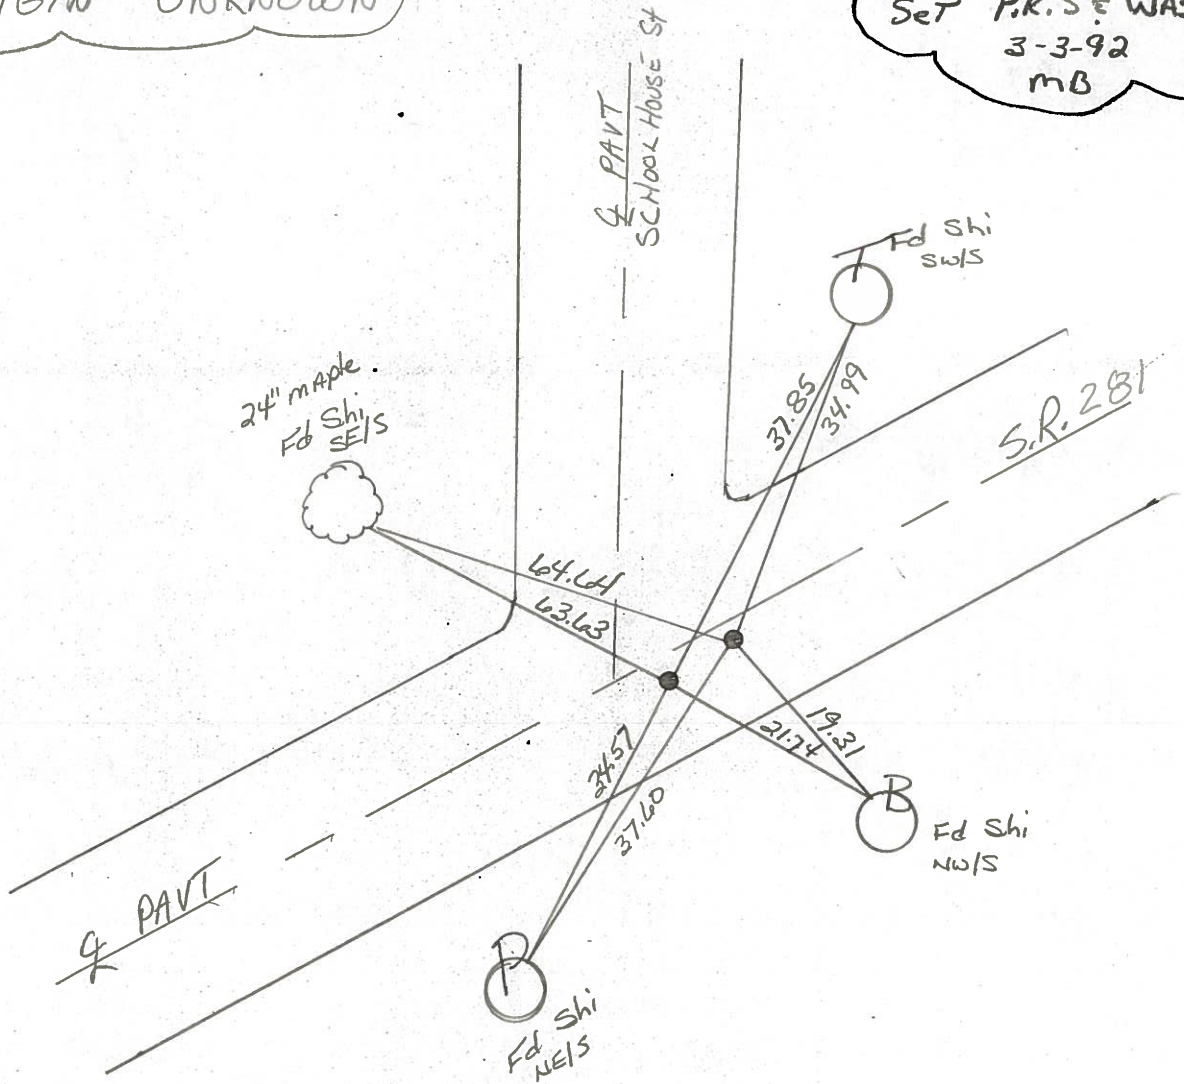

Q.D.O.T. DISTRICT 2 SURVEY OFFICE

SHEET _____ OF _____

County Wood S.R. 281

Date 12-19-83

Township Montgomery

Weather Cloudy

Section 16


Temp. +15°

T4N, R12E

Personnel HOFFMAN

HOUSEHOLDER R.C.

BARHISEL H.C.

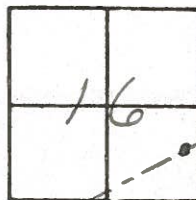

#49-B-2

49-BB


49-BC

Fd. P.K. Nail @ surface; ORIGIN UNKNOWN

S L M 1145+39

2.0' RT of & Pavt SR281

9.7' TO RT. EP

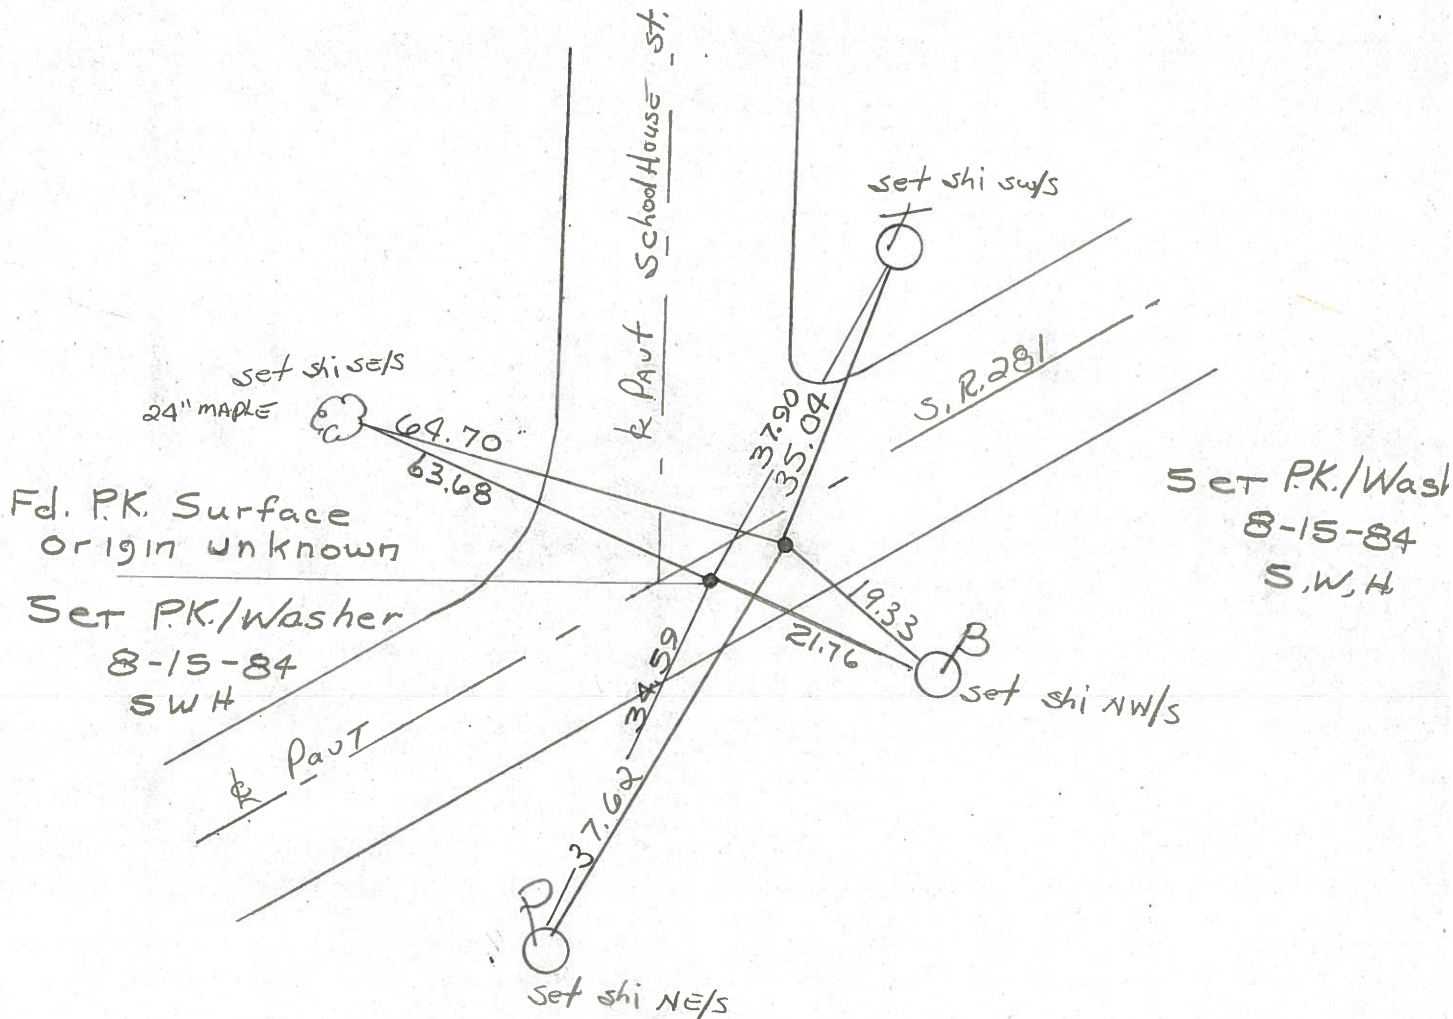

PERSONNEL TITLE PERSONNEL TITLE
MORRISON _____

COUNTY WOOD DATE APRIL 6 1950

S. R. 281 WEATHER CLOUDY & WINDY

SEC. WAYNE, OHIO TEMP. +65°

DESCRIPTION LEFT CENTER LINE RIGHT JOB NO. _____

