

O.D.O.T. DISTRICT 2 SURVEY OFFICE (USE ONLY)

PERSONNEL

REFERENCE NO. 49 BC

SHEET 18 OF 51

NOTES MILLER

DATE 6/14/23

ROUTE SR 281

H.C. AUBLE

WEATHER BREEZY

COUNTY WOOD

R.C. NIESE

TEMP. 57°

TOWNSHIP MONTGOMERY

BEJARANO

SECTION 16

DWG BY RHOADES

PID CHIP SEAL

T 4 N R 12 E

TYPE MONUMENT MAG/WASHER

ON SURFACE - ~~BELOW~~ ON

OFFSET Q PAVEMENT 0.7' ~~LT~~ : RT

10.8' TO LT EDGE PAVEMENT


STATION: 114544.35

HORZ.DATUM: NAD83 2011

GEOID: NAVD88 2018


GRID: NORTHING: 596763.724

EASTING: 1700035.177

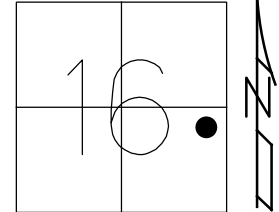

RECORD:
 ORIGIN UNKNOWN
 SET P.K./WASHER
 3/3/92, MB
 FD P.K./WASHER
 8/9/10, SAH
 BBB49, 11/2/10
 FD P.K./WASHER
 3/21/12, MC
 SET MAG/WASHER
 7/24/12, MC
 REFBBB49
 7/30/12, SAH
 FD MAG/WASHER
 REF49BC
 6/14/23
 10/20/23, DSA


WOOD LPD:
 N: 419234.392
 E: 211550.576

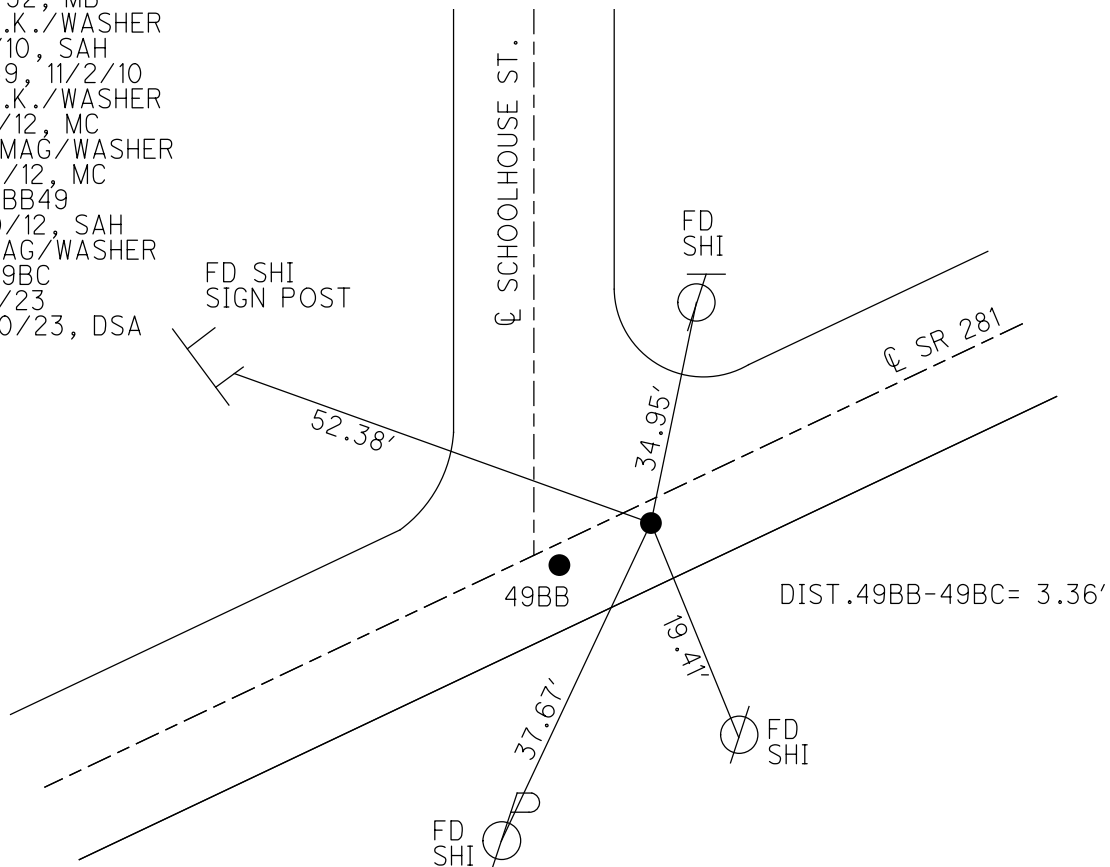

O.D.O.T. DISTRICT 2 SURVEY OFFICE (USE ONLY)

PERSONNEL	REFERENCE NO. <u>49 BC</u>	SHEET <u>16</u> OF <u>49</u>
NOTES <u>HUSS</u>	DATE <u>3/21/12</u>	ROUTE <u>SR 281</u>
H.C. <u>CANTERBURY</u>	WEATHER <u>CLEAR</u>	COUNTY <u>WOOD</u>
R.C. <u>HUSS</u>	TEMP. <u>74°</u>	TOWNSHIP <u>MONTGOMERY</u>
		SECTION <u>16</u>
		T <u>4</u> N R <u>12</u> E

TYPE MONUMENT P.K./WASHER
 ON SURFACE - ~~BELOW~~ ON
~~LEFT~~ - Q PAV'T - RIGHT 0.7'
10.8' RT EDGE PAVEMENT
 S.L.M. 114544.35

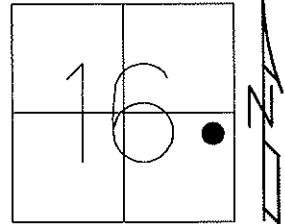

Grid: Northing: 596763.801 Easting: 1700035.149

RECORD:
 ORIGIN UNKNOWN

SET P.K./WASHER
 3/3/92, MB

FD P.K./WASHER
 8/9/10, SAH
 GPS, BBB49, 11/2/10
 SET MAG/WASHER
 7/24/12, MC
 FINAL REF BBB49
 7/30/12, SAH

