

O.D.O.T. DISTRICT 2 SURVEY OFFICE (USE ONLY)

PERSONNEL _____

REFERENCE NO. 49 C

SHEET 17 OF 49

NOTES HUSS

DATE 3/21/12

ROUTE SR 281

H.C. CANTERBURY

WEATHER CLEAR

COUNTY WOOD

R.C. HUSS

TEMP. 74°

TOWNSHIP MONTGOMERY

SECTION 15

T 4 N R 12 E

TYPE MONUMENT P.K./WASHER



ON SURFACE - ~~BELOW~~ ON _____

LEFT - ☉ PAV'T - ~~RIGHT~~ 4.0'

_____ TO _____ EDGE PAVEMENT

S.L.M. 1148+56, 4.3' EAST OF ☉ MAPLE ST.

Grid: Northing: 596890.948 Easting: 1700326.337

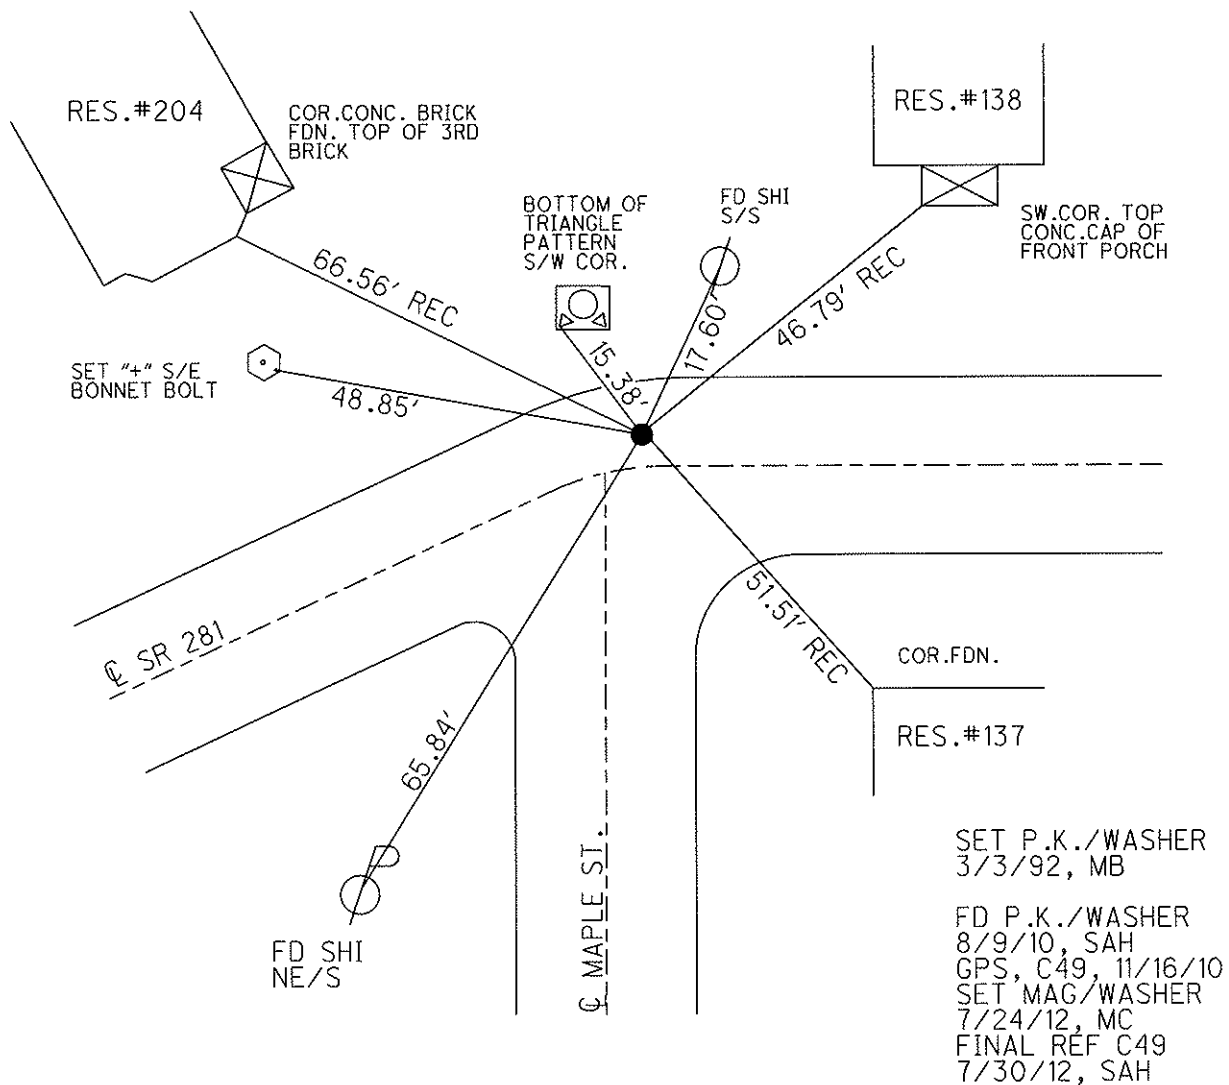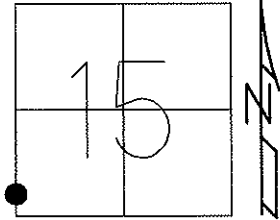

O.D.O.T. DISTRICT 2 SURVEY OFFICE

PERSONNEL

REFERENCE NO. 49-C

SHEET _____ OF _____

NOTES LOEHRKE

H.C. VAN DUSEN

DATE 7-18-91

ROUTE S.R. 281

R.G. KUSZ

WEATHER clear

COUNTY WOOD

BARNHISEL

TEMP. +80°

TOWNSHIP MONTGOMERY

SECTION 15

T4 N R 12 E

TYPE MONUMENT P.K. / Washer


49-C

ON SURFACE - ~~BELOW~~ yes


LEFT - ~~Q~~ PAV'T. - RIGHT 4.0

12.5 TO LT. EDGE PAVEMENT

S.L.M. 1148+56 4.3 EAST OF Q maple ST.

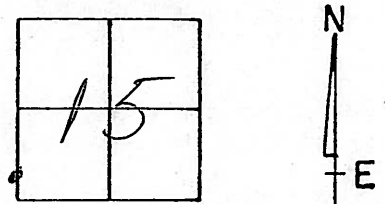

Set P.K. & Washer
3-3-92
MB

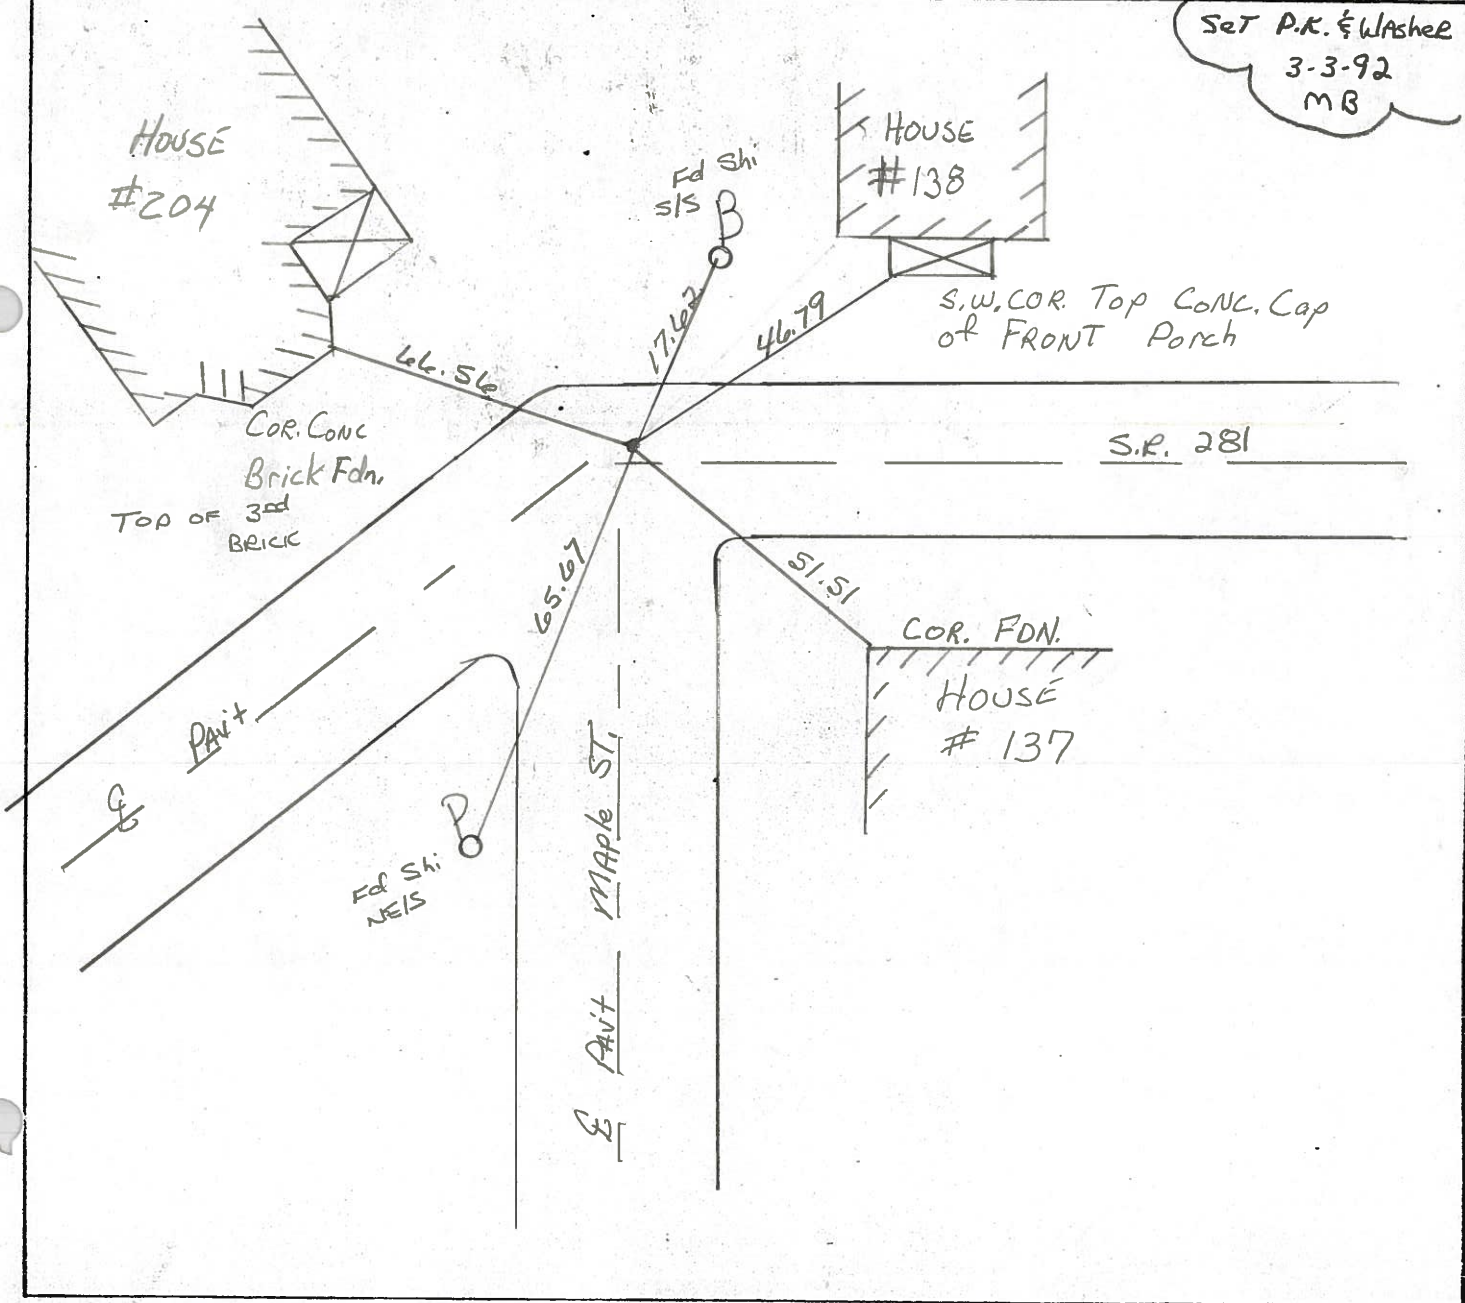

Q.D.O.T. DISTRICT 2 SURVEY OFFICE

SHEET _____ OF _____

County WOOD S.R. 281

Date 12-20-83

Township MONTGOMERY

Weather CLEAR

Section 15

Temp. +15°

T4N, R12E


Personnel HOFFMAN

LOSHKE H.C.

HOUSEHOLDER R.C.


BARNHISEL

49-C

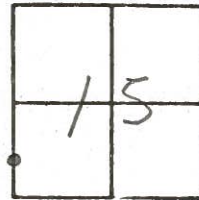

Fd P.K. Nail @ surface
2.4' Lt. of PAUT SR281
12.5' TO LT. EP.

S.L.M. 1148 + 50

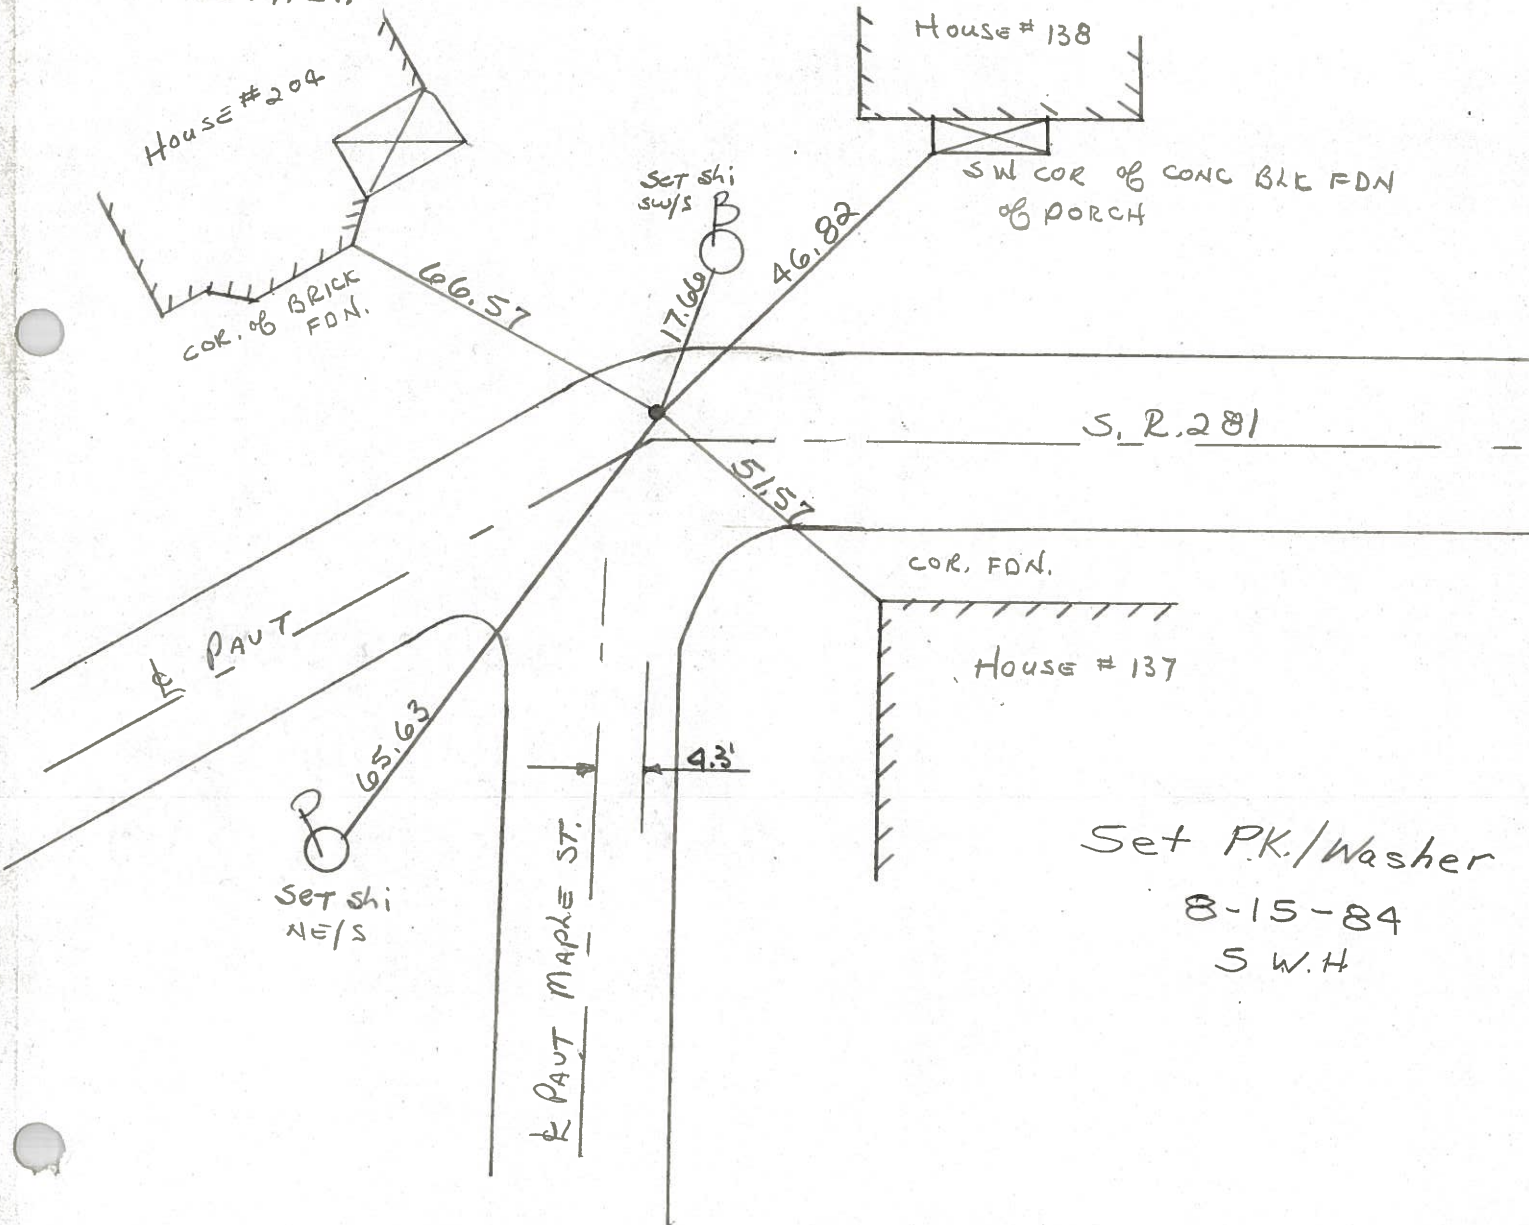

S. R. 281

Set P.K./Washer
8-15-84
S.W.H

PERSONNEL TITLE PERSONNEL TITLE
 MORRISON _____


COUNTY WOOD DATE APRIL 6 1950

S. R. 281 WEATHER CLOUDY & Wind

SEC. WAYNE OHIO. TEMP. +65°

DESCRIPTION _____

ad shi s/s JOB NO. _____

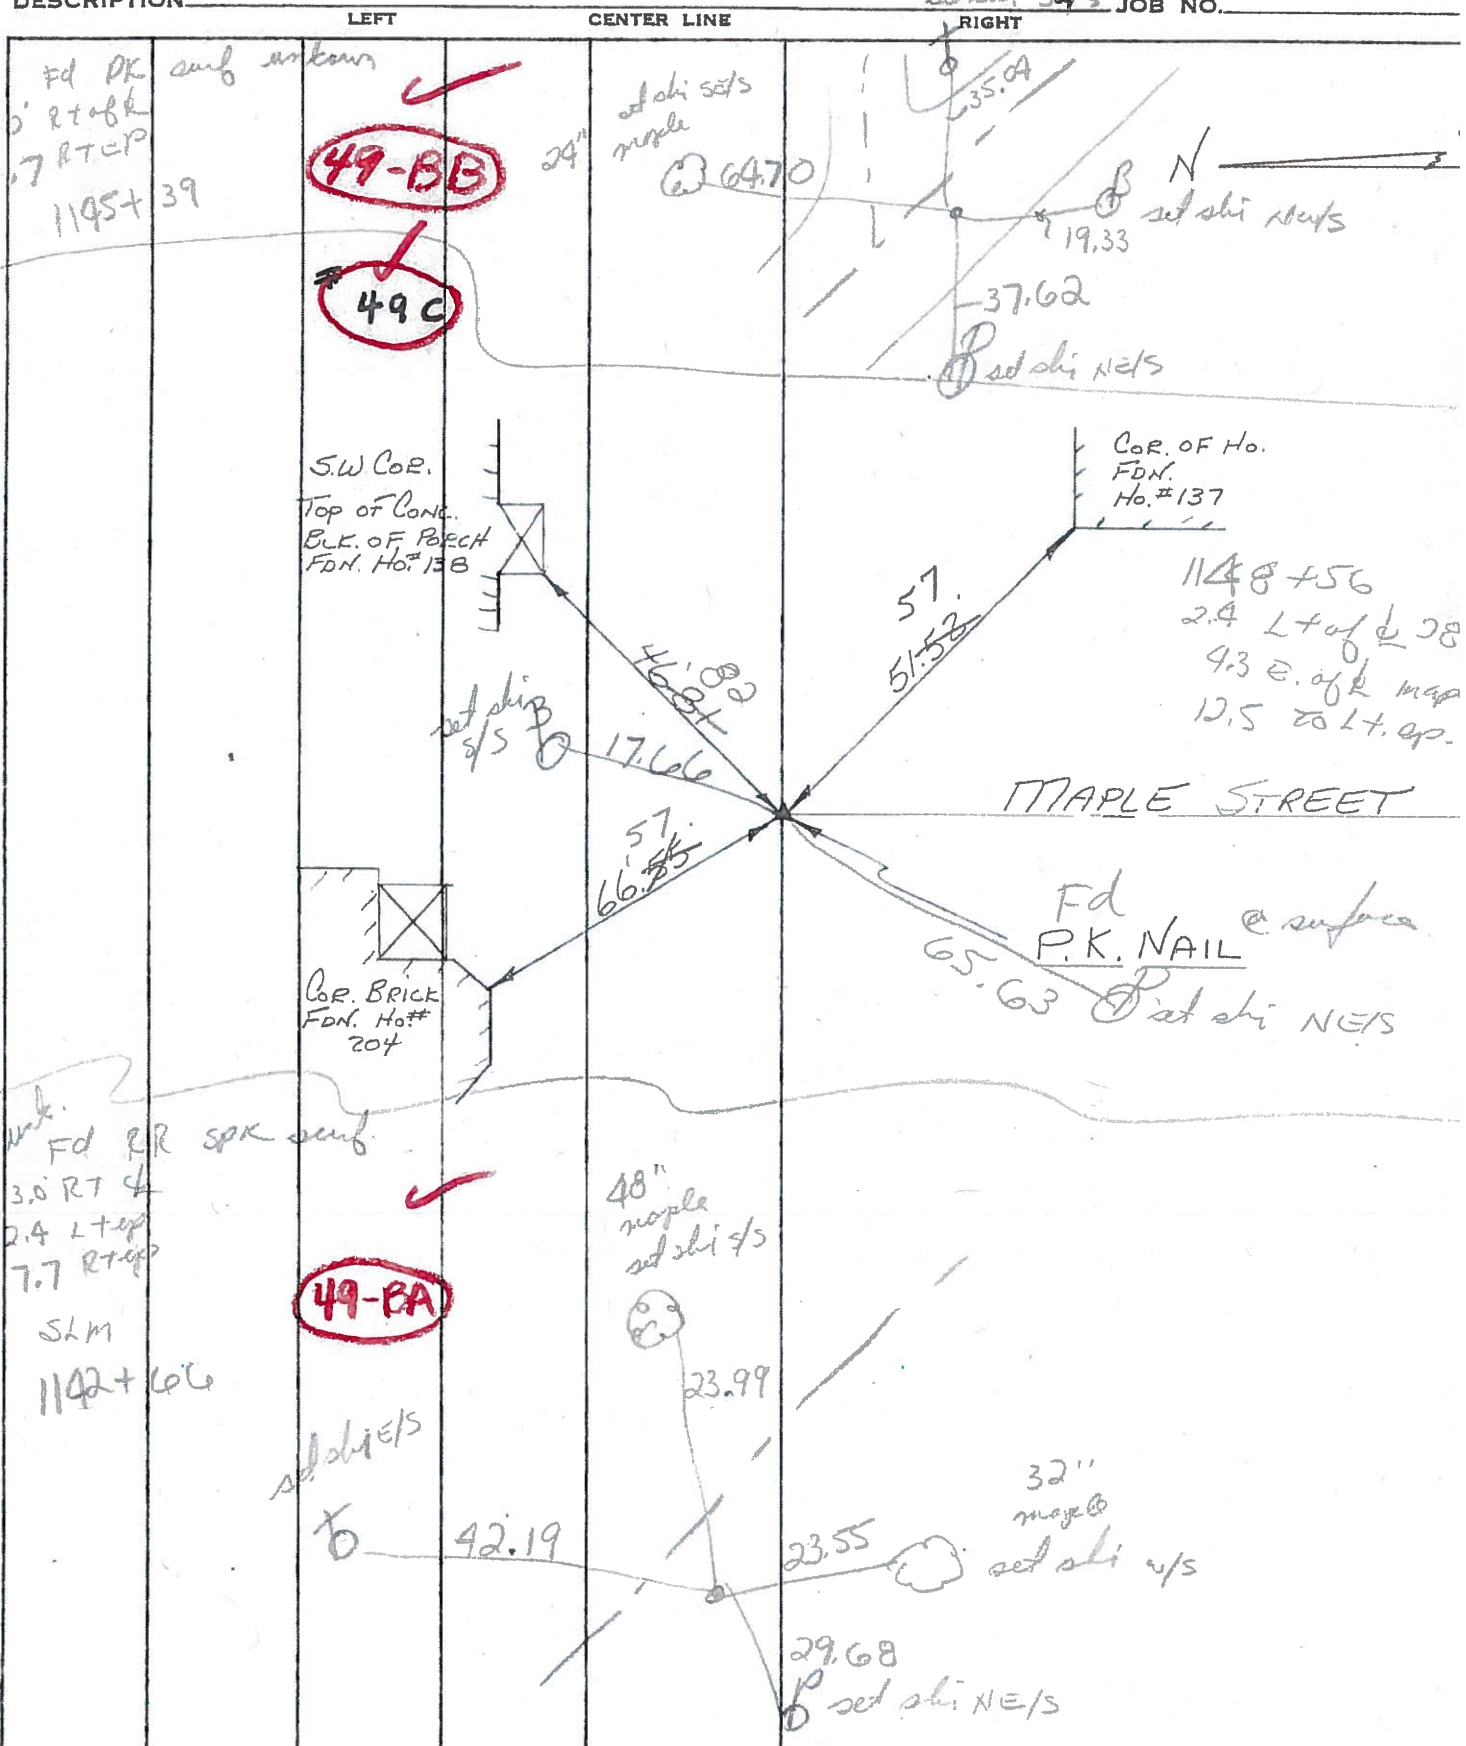


PERSONNEL TITLE PERSONNEL TITLE
MORRISON _____

COUNTY WOOD DATE APRIL 6 1959

S. R. 281 WEATHER CLOUDY & WINDY

SEC. WAYNE, OHIO TEMP. +65°

DESCRIPTION LEFT CENTER LINE RIGHT JOB NO. _____

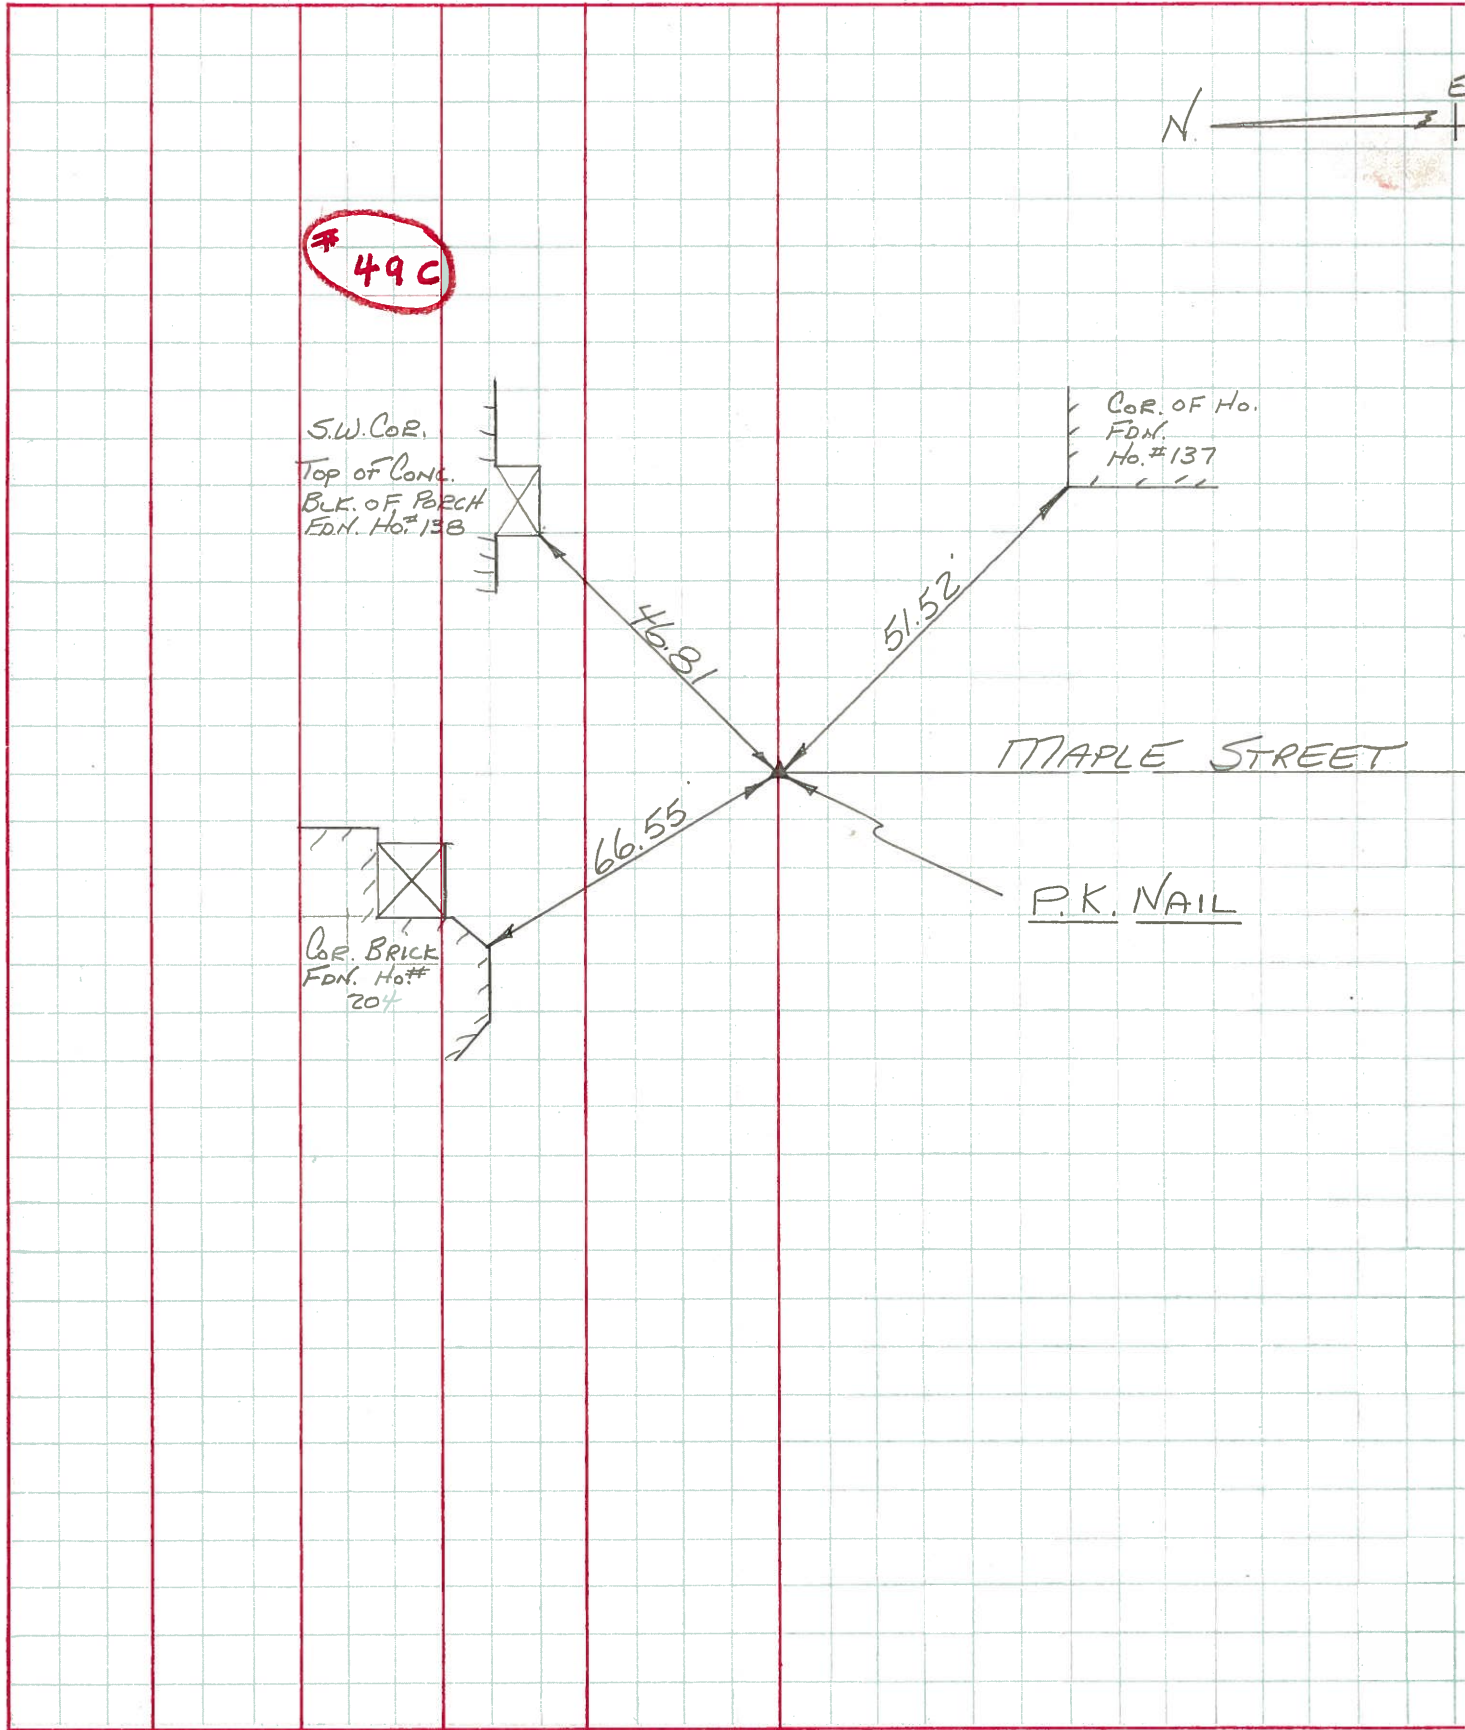

PERSONNEL TITLE PERSONNEL TITLE
 Morrison _____
 Bowers _____
 Mercer _____


COUNTY Wood DATE April 6, 195
 S. R. #281 WEATHER Cloudy & W
 SEC. WAYNE TEMP. +65°

DESCRIPTION Wayne Main Street JOB NO. _____

LEFT CENTER LINE RIGHT


49-E

Ties to RR spk. Found @ Church & Main St.

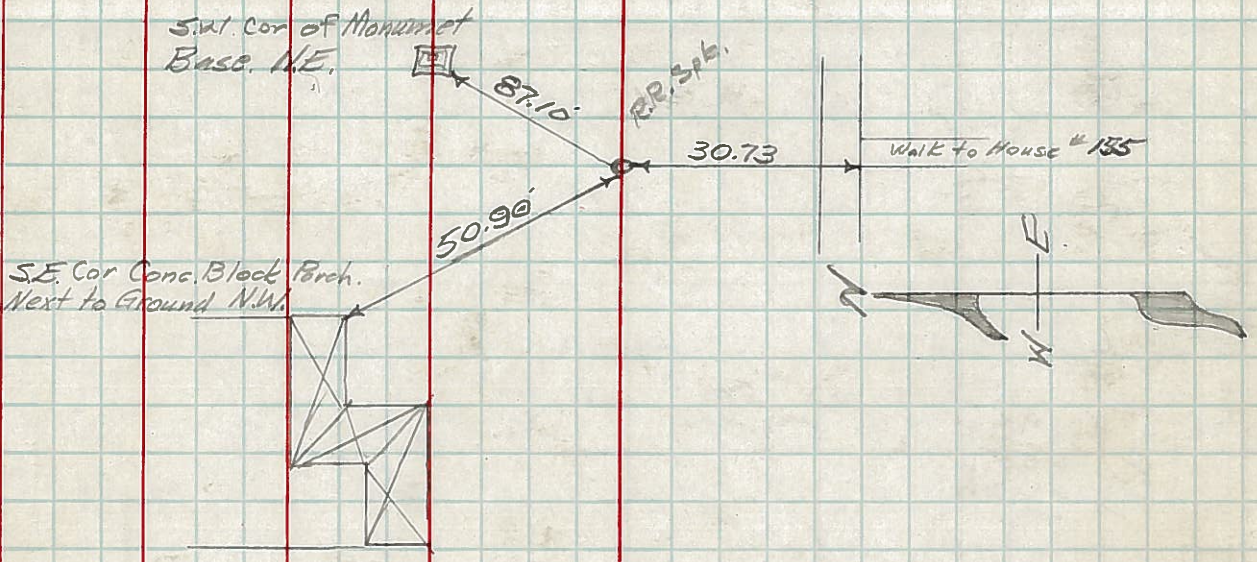

49-D

Ties to intersection. Center & Main Streets.

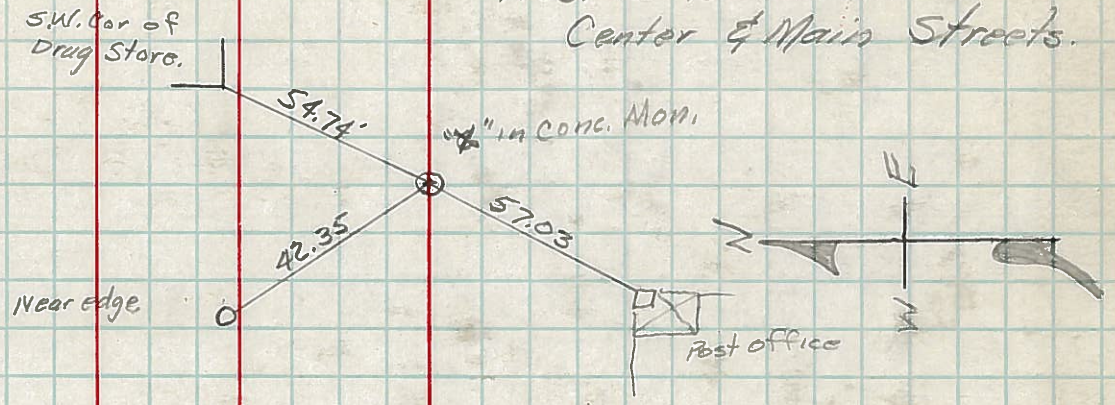

49-C

Ties to intersection. Main & Maple Streets

