

O.D.O.T. DISTRICT 2 SURVEY OFFICE (USE ONLY)

PERSONNEL _____

REFERENCE NO. 49 K

SHEET 26 OF 49

NOTES HUSS

DATE 3/21/12

ROUTE SR 281

H.C. HUSS

WEATHER CLEAR

COUNTY WOOD

R.C. HARBAUGH

TEMP. 80°

TOWNSHIP MONTGOMERY

SECTION 15

T. 4 N R. 12 E

TYPE MONUMENT MON.BOX


ON SURFACE - ~~BELOW~~ ON _____

LEFT - Q PAV'T - ~~RIGHT~~ 11.1'

0.8' TO LT EDGE PAVEMENT

S.L.M. 1183+65

Grid: Northing: 598606.302 Easting: 1702988.059

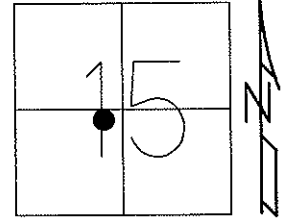


RECORD P.I.
STA. 1183+92.10

DID NOT OPEN
USED CTR. OF LID
7/31/91, MB

COULD NOT OPEN
USED MARKS FOR
CTR. OF MON.BOX
LID. 8/9/10, SAH

GPS, K49, 11/17/10

FINAL REF K49
7/30/12, SAH

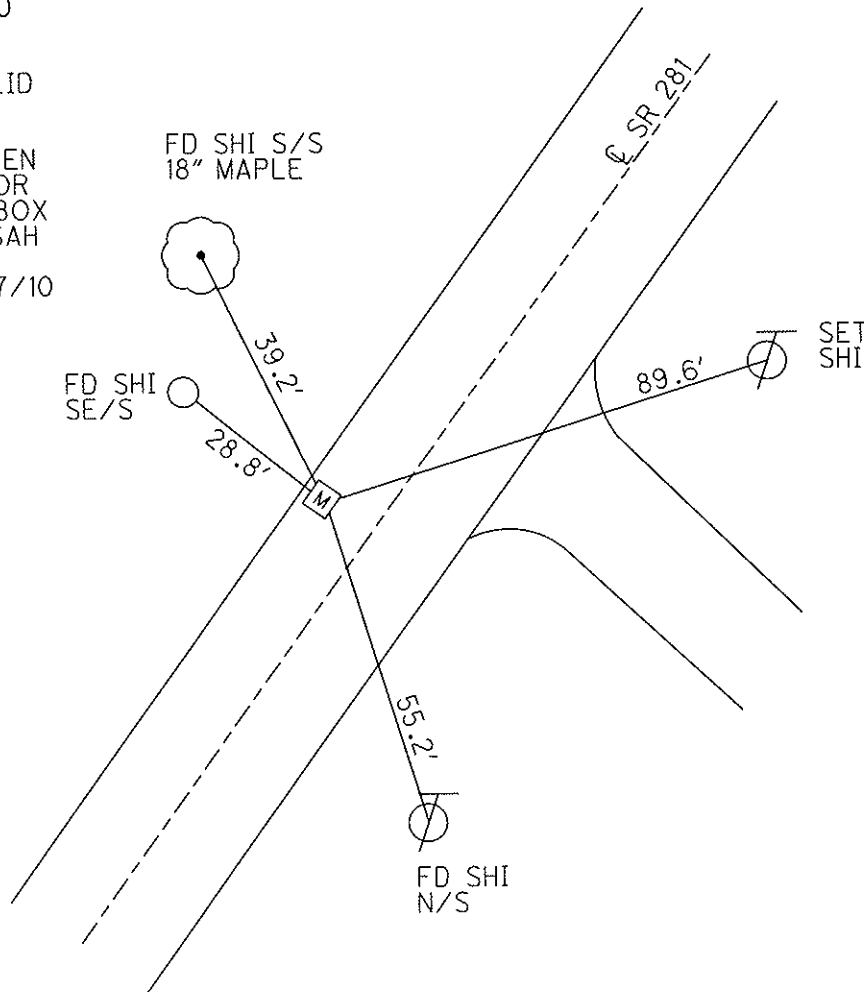

O.D.O.T. DISTRICT 2 SURVEY OFFICE

PERSONNEL _____ REFERENCE NO. _____ SHEET _____ OF _____

NOTES LOEHRKE

H.C. VAN DUSEN

R.G. YEAGER

BARNHISEL

DATE 7-31-91

WEATHER clear

TEMP. +80°

ROUTE S.R. 281

COUNTY WOOD

TOWNSHIP Montgomery

SECTION 15

T 4 N R 2 E

TYPE MONUMENT Mon. Box



ON SURFACE - BELOW YES

LEFT-~~C~~ PAV'T. - RIGHT 11.1

2.7 TO Lt EDGE PAVEMENT CURB

S.L.M. 1183+65


49-K

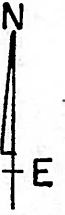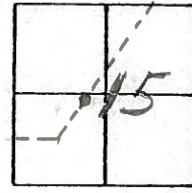

RECORD P.I.
Sta 1183+92.10

2.7 to Lt CURB
25.35 to Rt CURB

Didn't open
USED CTR. OF I.D

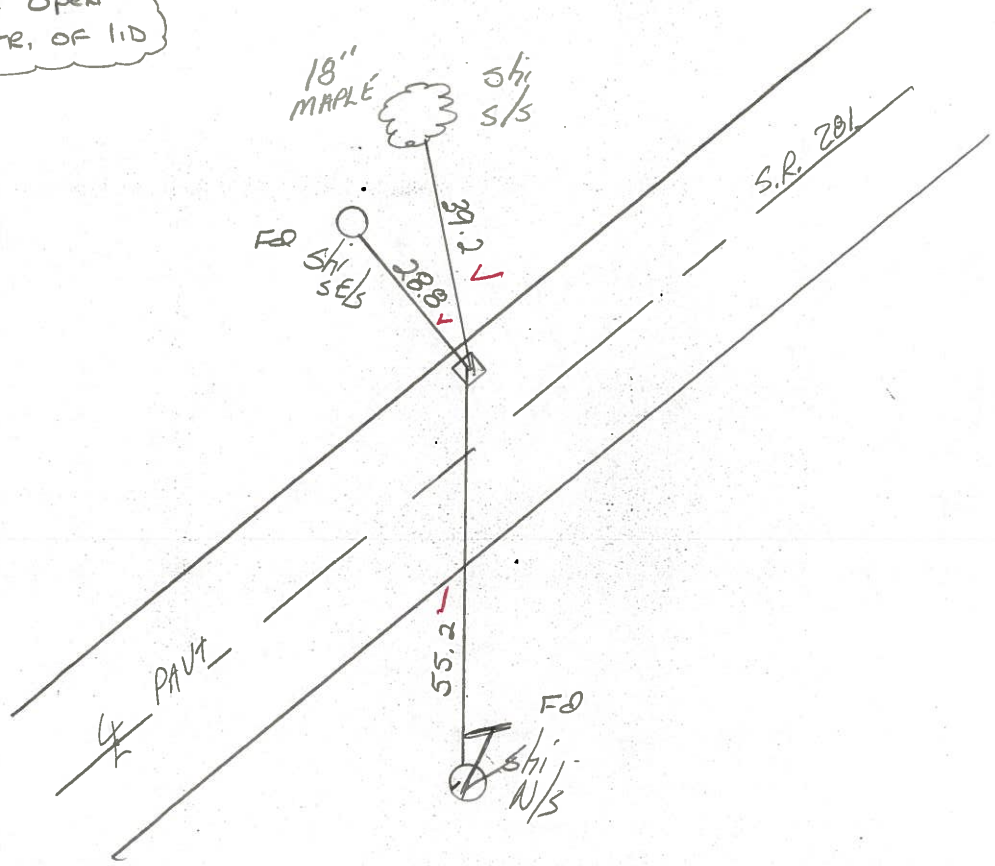

Preventive Maintenance
Chip & Seal 2000
Existing Point Uncovered
Date 11-9-2000

Q.D.O.T. DISTRICT 2 SURVEY OFFICE

SHEET _____ OF _____

County Wood S.R. 281

Date 12-20-83

Township MONTGOMERY

Weather CLEAR

Section 15

Temp. +15°

T4N, R12E


Personnel HOFFMAN

LOEHRKE H.C.

HOUSEHOLDER R.C.

BARNHISEL

49-K

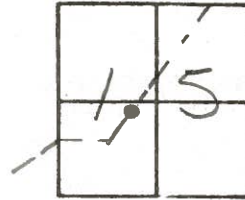

Fd MON. BOX @ SURFACE/NOTCHES ON RIM, MADE "t" ON TOP

Ref. to "t"


S.L.M. 1183+65

11.1 Lt. of & PAUT

2.70 TO LT. CURB FACE

25.35 TO RT. CURB FACE

Record:
P.I.
1183+92.18

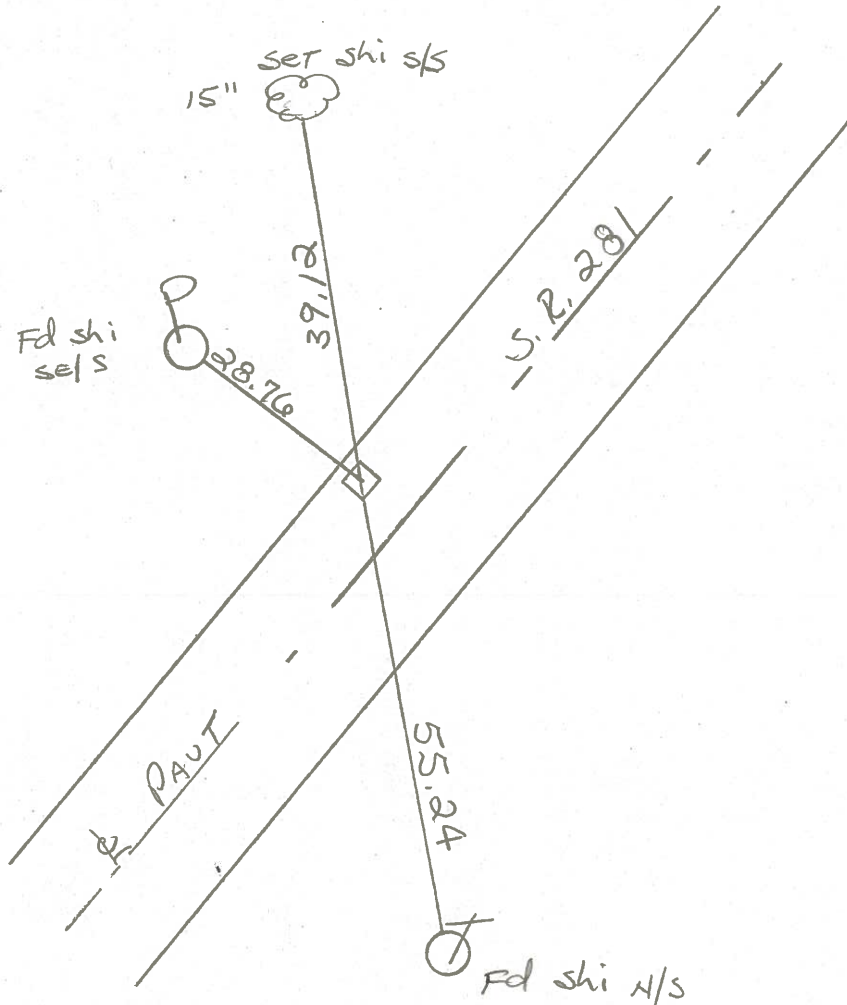


PERSONNEL TITLE PERSONNEL TITLE
PURNSIDE _____
SMITH _____
HOFFMAN _____

COUNTY WOOD DATE 4-17-70

S. R. "281" WEATHER CLEAR

SEC. _____ TEMP. +65°

DESCRIPTION CONTROL TIES JOB NO. _____

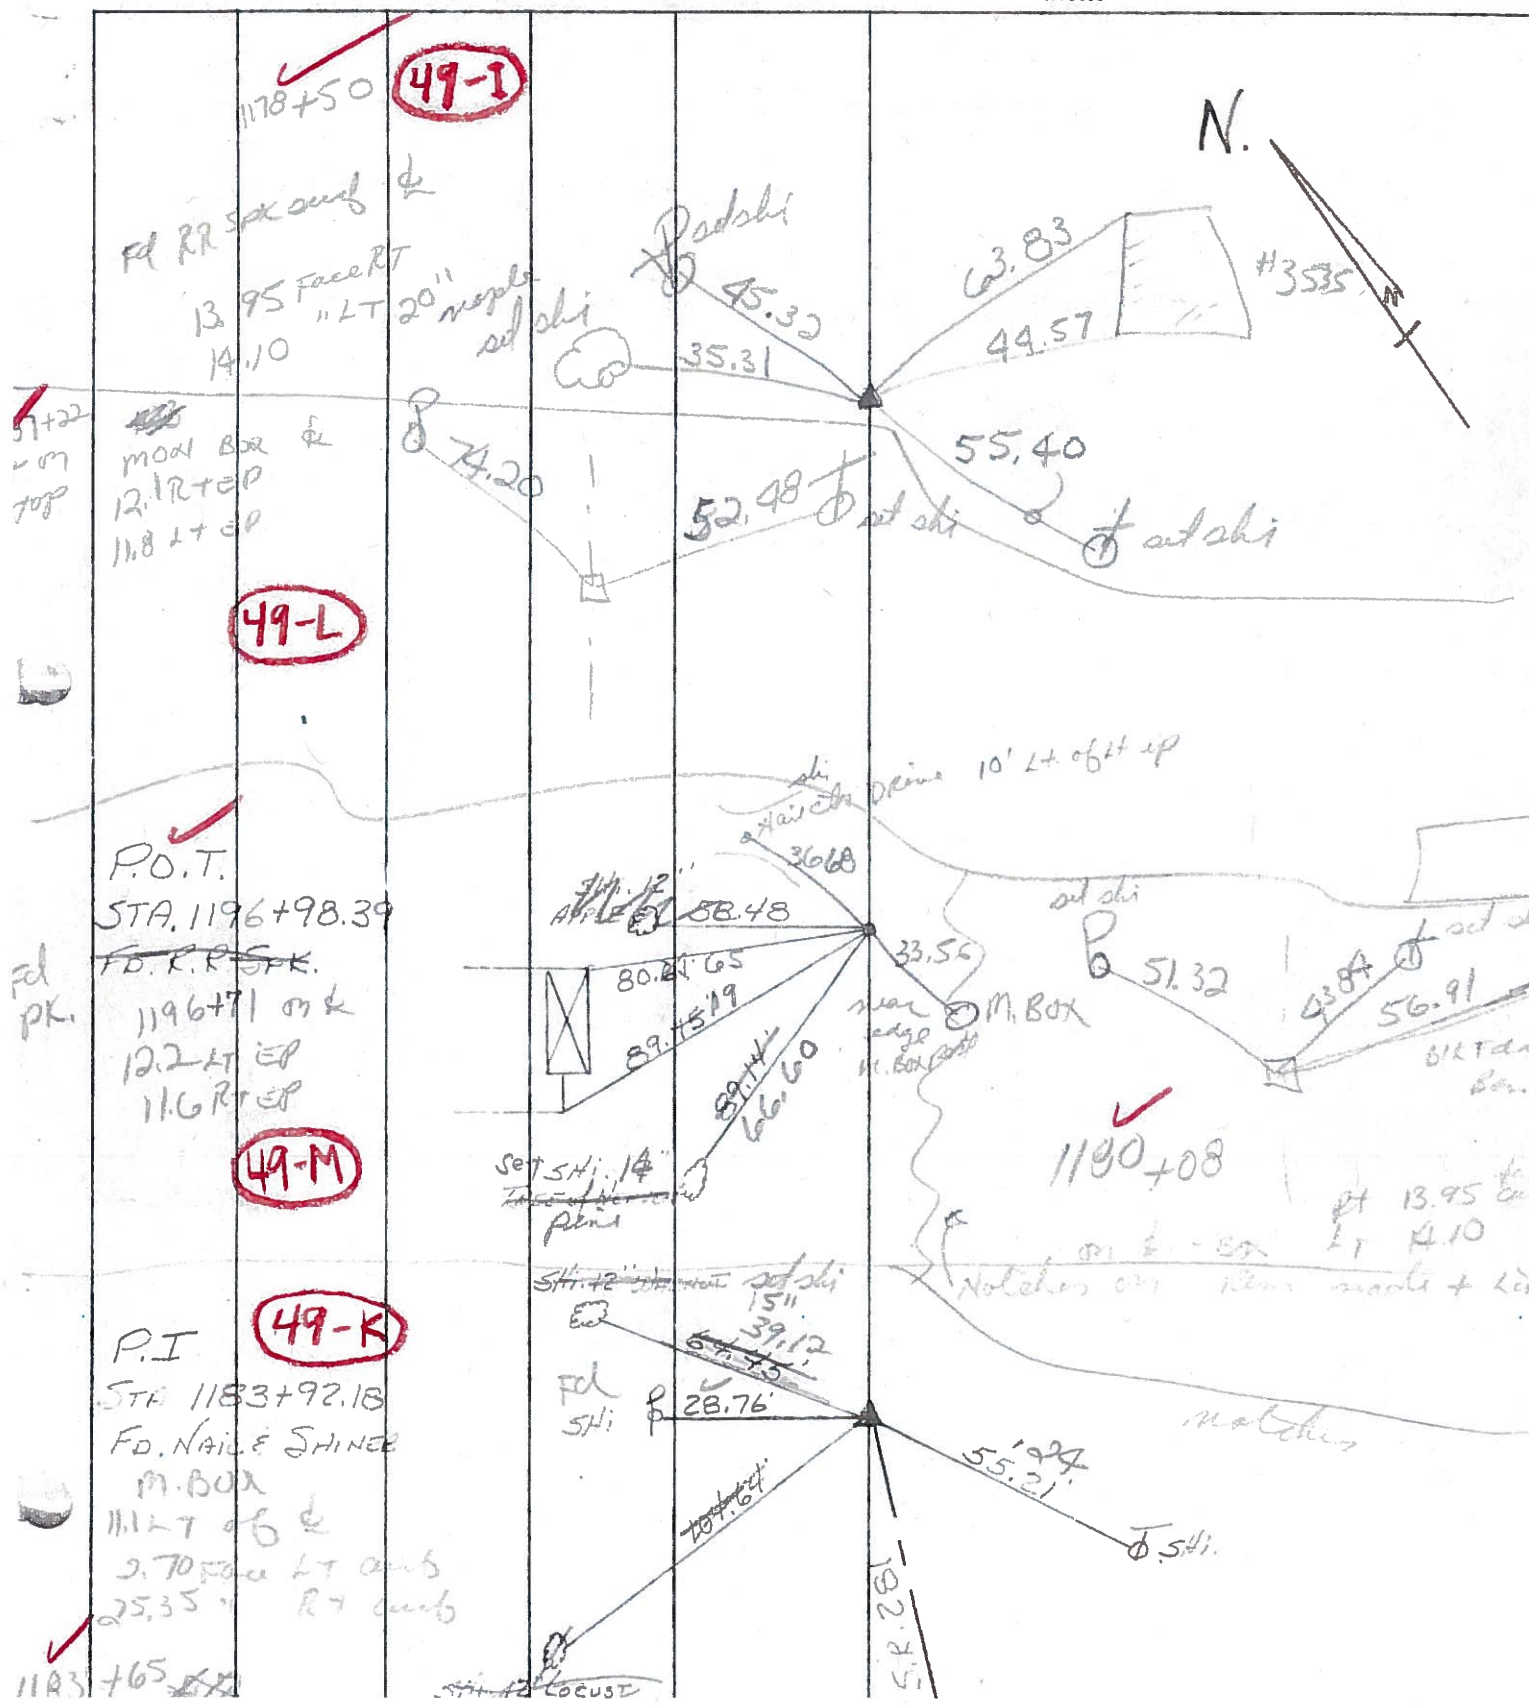


PERSONNEL	TITLE	PERSONNEL	TITLE
BURNSIDE			
SMITH			
HOFFMAN			

COUNTY WOOD DATE 4-17-70
 S. R. #281 WEATHER CLEAR
 SEC. _____ TEMP. +65°


DESCRIPTION CONTROL TIES

JOB NO. _____

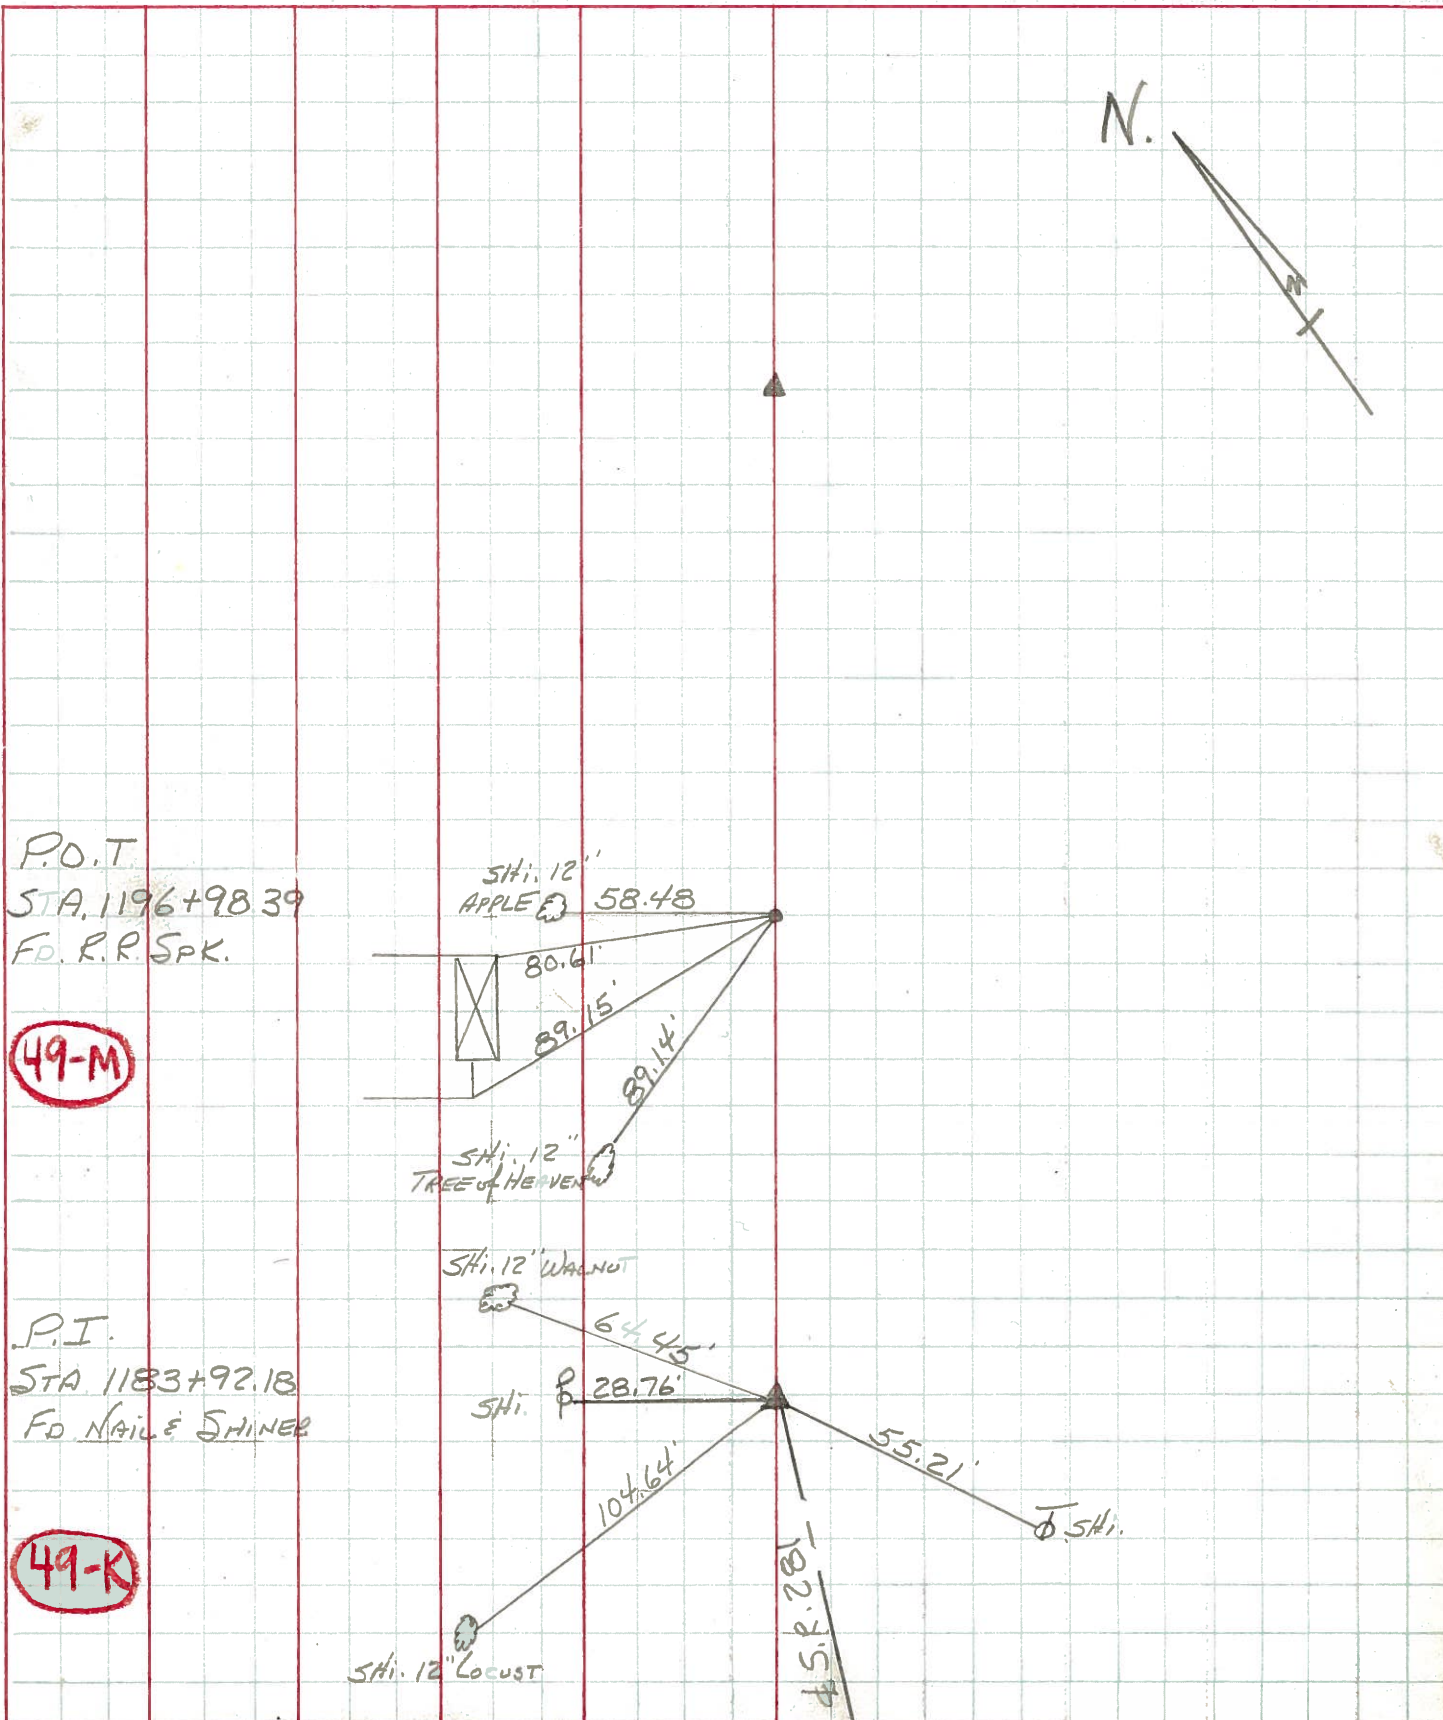

P.O.T.
 STA. 1196+98.39
 F.D. R.R. SPK.

49-M

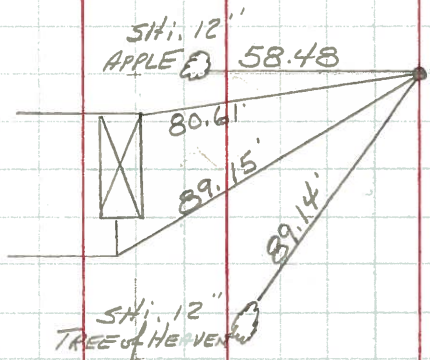

P.I.
 STA. 1183+92.18
 F.D. NAIL & SHINER

49-K

