


O.D.O.T. DISTRICT 2 SURVEY OFFICE (USE ONLY)

PERSONNEL	REFERENCE NO. <u>49 L</u>	SHEET <u>27</u> OF <u>49</u>
NOTES <u>HUSS</u>	DATE <u>3/22/12</u>	ROUTE <u>SR 281</u>
H.C. <u>CANTERBURY</u>	WEATHER <u>CLOUDY</u>	COUNTY <u>WOOD</u>
R.C. <u>HUSS</u>	TEMP. <u>70°</u>	TOWNSHIP <u>MONTGOMERY</u>
		SECTION <u>15</u>
		T <u>4</u> N R <u>12</u> E

TYPE MONUMENT MON.BOX
 ON SURFACE - ~~BELOW~~ ON
 LEFT - ☉ PAV'T - RIGHT ON
11.8' TO LT EDGE PAVEMENT
 S.L.M. 1187+22

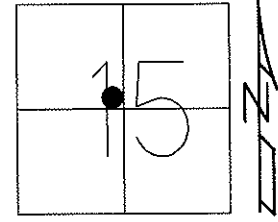


Grid: Northing: 598861.189 Easting: 1703240.486

DID NOT OPEN
 USED CTR.OF LID
 7/31/91, MB

DID NOT OPEN
 USED "+" SET ON
 LID WITH CROSS TIES
 8/9/10, SAH

GPS, L49, 11/17/10

FINAL REF L49
 7/30/12, SAH

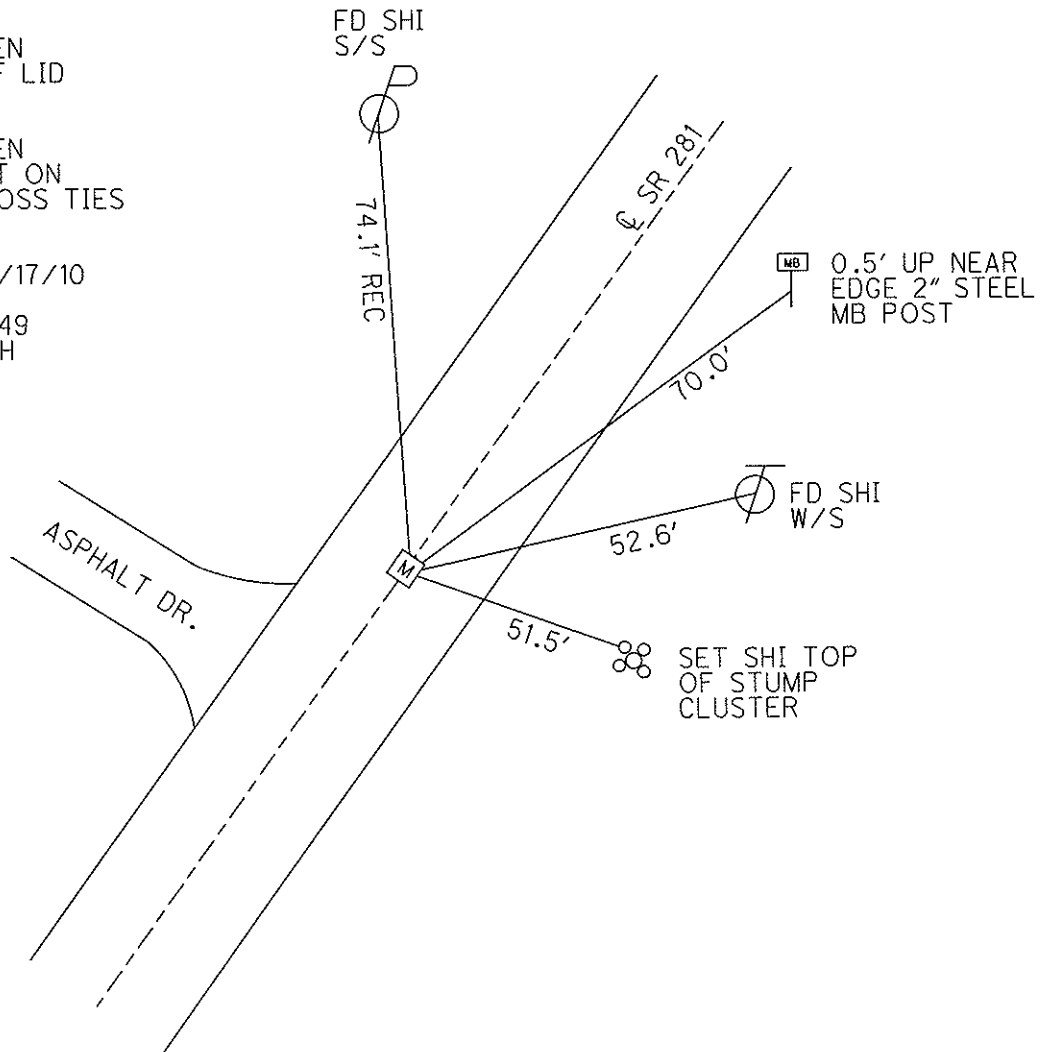

O.D.O.T. DISTRICT 2 SURVEY OFFICE

PERSONNEL _____

REFERENCE NO. _____

SHEET _____ OF _____

NOTES LOEHRKE

H.C. VAN DUSEN

DATE 7-31-91

ROUTE S.R. 281

R.C. YEAGER

WEATHER clear

COUNTY WOOD

BARNHISEL

TEMP. +80°

TOWNSHIP MONTGOMERY

SECTION 15

T. 4 NR. 12 E

TYPE MONUMENT Mon. Box


ON SURFACE - ~~BELOW~~ YES

~~LEFT - & PAV'T. - RIGHT~~ YES


N.B. TO Lt. EDGE PAVEMENT CURB

S.L.M. 1187+22

49-L

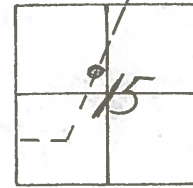

Didn't open
USED CTR. OF LID

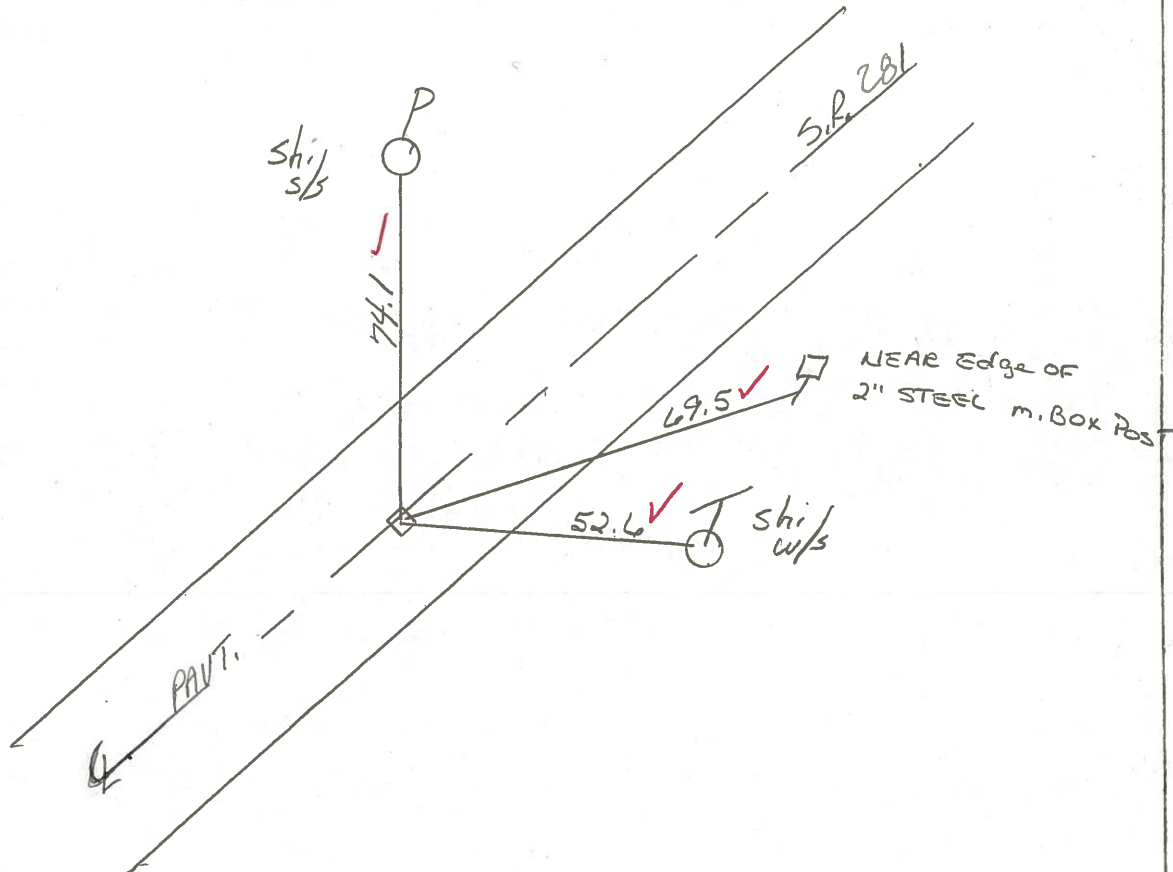

Preventive Maintenance
Chip & Seal 2000
Existing Point Uncovered
Date 11-9-00

Q.D.O.T. DISTRICT 2 SURVEY OFFICE

SHEET _____ OF _____

County Wood S.R. 281

Date 12-20-83

Township Montgomery

Weather Clear

Section 15

Temp. +15°

T4N, R12E


Personnel HOFFMAN

LOERKE H.C.

HOUSEHOLDER R.C.

BARNHISEL

49-L

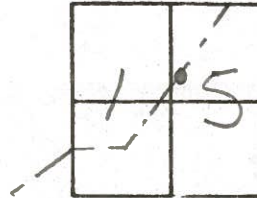

Fcd. Mon. Box / "+" ON TOP


S.L.M. 1187+22

Ref. to "+"

ON & PAUT

11.8 TO LT. EP

12.1 TO RT. EP

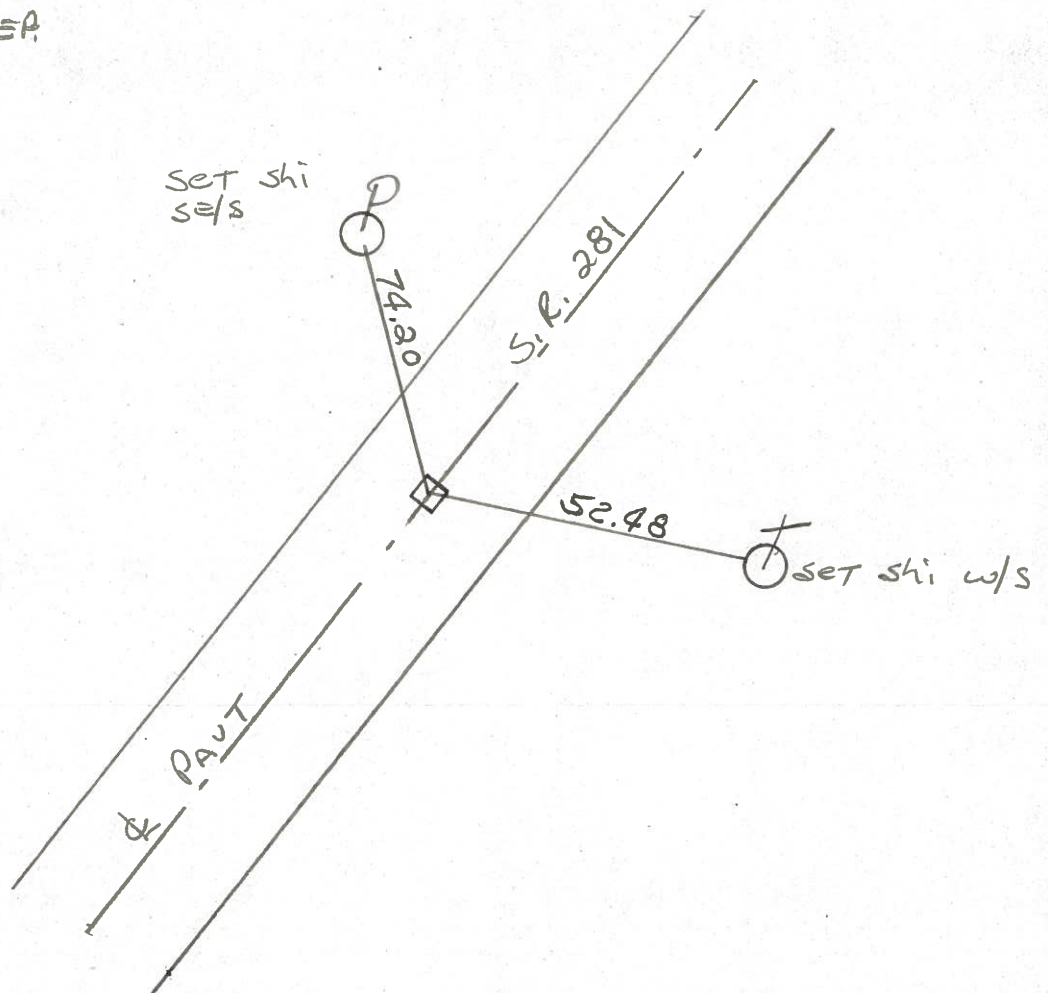

PERSONNEL TITLE PERSONNEL TITLE
PURNSIDE _____
SMITH _____
HOFFMAN _____

COUNTY WOOD DATE 4-17-70
 S. R. "281" WEATHER CLEAR
 SEC. _____ TEMP. +65°

DESCRIPTION CONTROL TIES JOB NO. _____

