
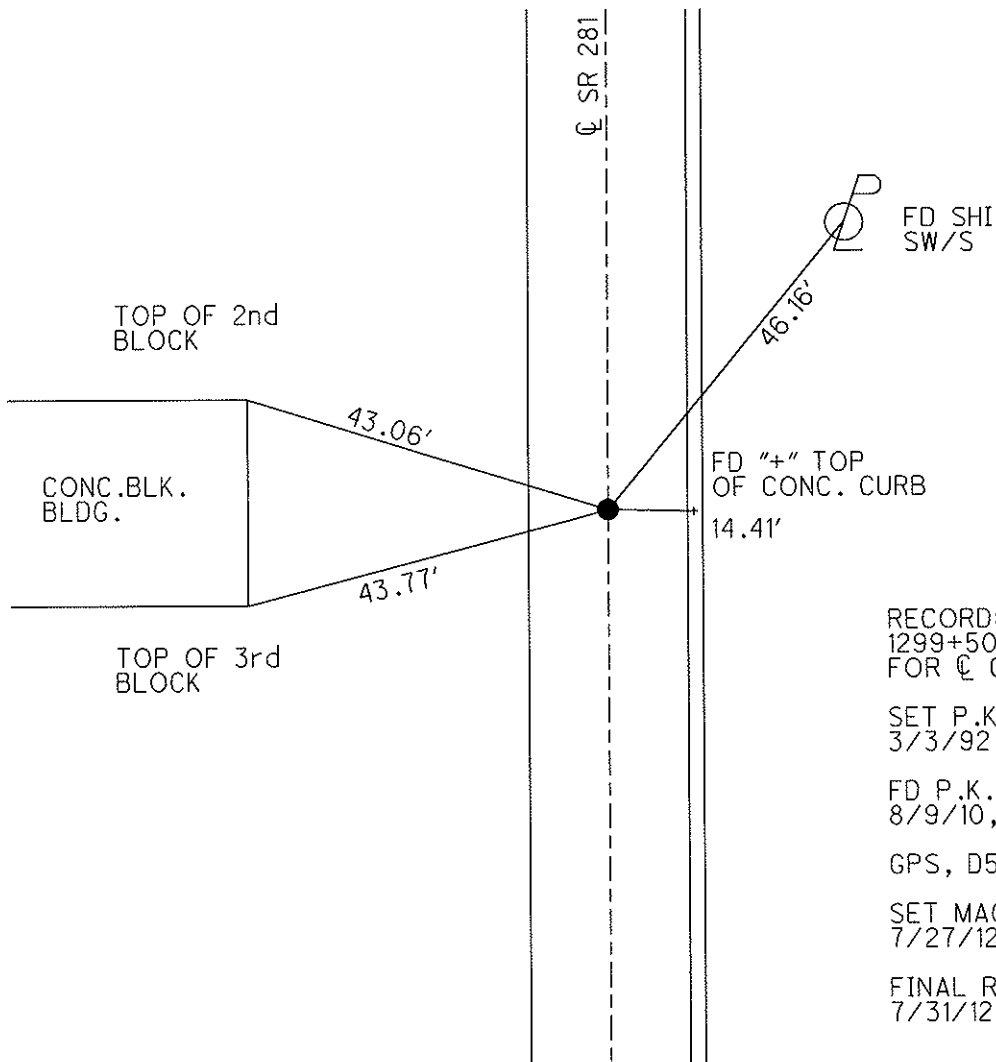


O.D.O.T. DISTRICT 2 SURVEY OFFICE (USE ONLY)

PERSONNEL	REFERENCE NO. <u>52 D</u>	SHEET <u>44</u> OF <u>49</u>
NOTES <u>HUSS</u>	DATE <u>4/2/12</u>	ROUTE <u>SR 281</u>
H.C. <u>CANTERBURY</u>	WEATHER <u>CLOUDY</u>	COUNTY <u>WOOD</u>
R.C. <u>HARBAUGH</u>	TEMP. <u>60°</u>	TOWNSHIP <u>MONTGOMERY</u>
		SECTION <u>2</u>
		T <u>4</u> N R <u>12</u> E

TYPE MONUMENT P.K./WASHER  
 ON SURFACE - ~~BELOW~~ ON  
 LEFT - CL PAV'T - RIGHT ON  
14.2' TO RT EDGE PAVEMENT  
 S.L.M. 1299+20  
 Grid: Northing: 606572.976 Easting: 1711172.953

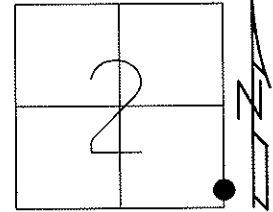

RECORD:  
 1299+50 BEGIN TAPER  
 FOR CL CONSTR. 7/30/91

SET P.K./WASHER  
 3/3/92, MB

FD P.K./WASHER  
 8/9/10, SAH

GPS, D52, 11/22/10

SET MAG/WASHER  
 7/27/12, SDC

FINAL REF D52  
 7/31/12, SAH

# O.D.O.T. DISTRICT 2 SURVEY OFFICE

PERSONNEL

REFERENCE NO. 52-B

SHEET      OF     

NOTES LOEHRKE

H.C. VAN DUSEN

R.C. KUSZ

BARNHISEL

DATE 7-30-91

WEATHER Clear

TEMP. +80°

ROUTE S.R. 281

COUNTY WOOD

TOWNSHIP MONTGOMERY

SECTION 2

T 4 N R 12 E

TYPE MONUMENT P.K. & Washer



ON SURFACE - BELOW yes

LEFT- & PAVT. - RIGHT yes

14.2 TO RT EDGE PAVEMENT


S.L.M. 1299+20

52-D

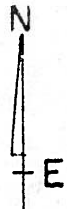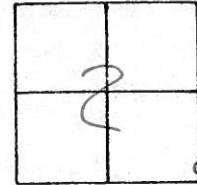

RECORD:  
 1299+50 Begin  
 TAPER FOR & CONST.

Set P.K. & Washer  
 3-3-92  
 MB

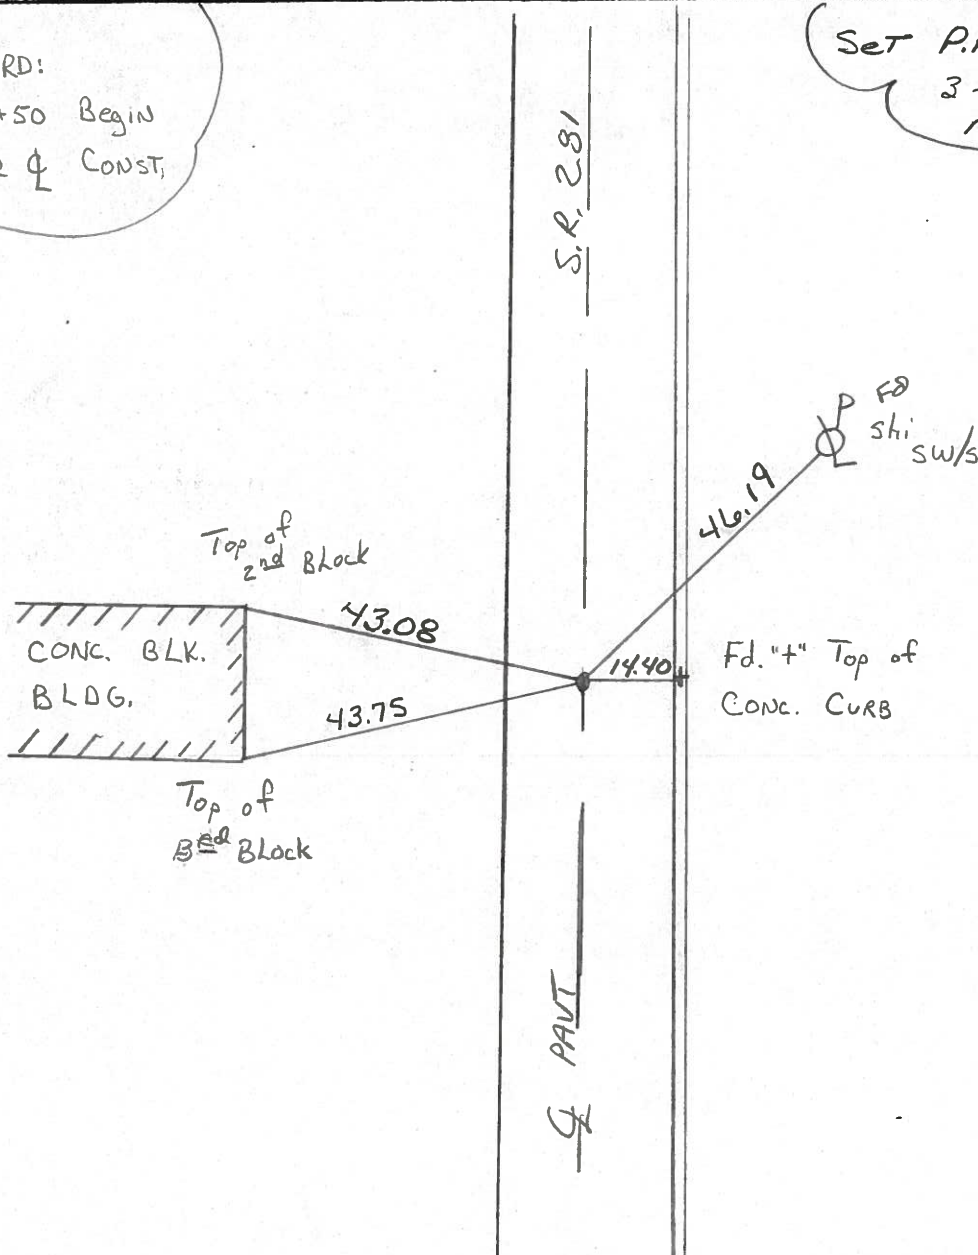

County WOOD S.R. 281

Date 1-18-84

Township MONTGOMERY

Weather SNOW

Section 2 IN BRADNER

Temp. +15°

T4N, R12E


Personnel HOFFMAN

LOEHRKE

HOUSEHOLDER R.C.

BARNHISEL H.C.

**52-D**

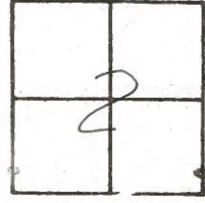


Fd Nail 2" Below surface  
on & PAUT

SLM = 1299+20

Record:  
1299+50 BEGIN TAPER  
FOR & CONST.

Set P.K./Washer  
8-20-84  
S.W.H.

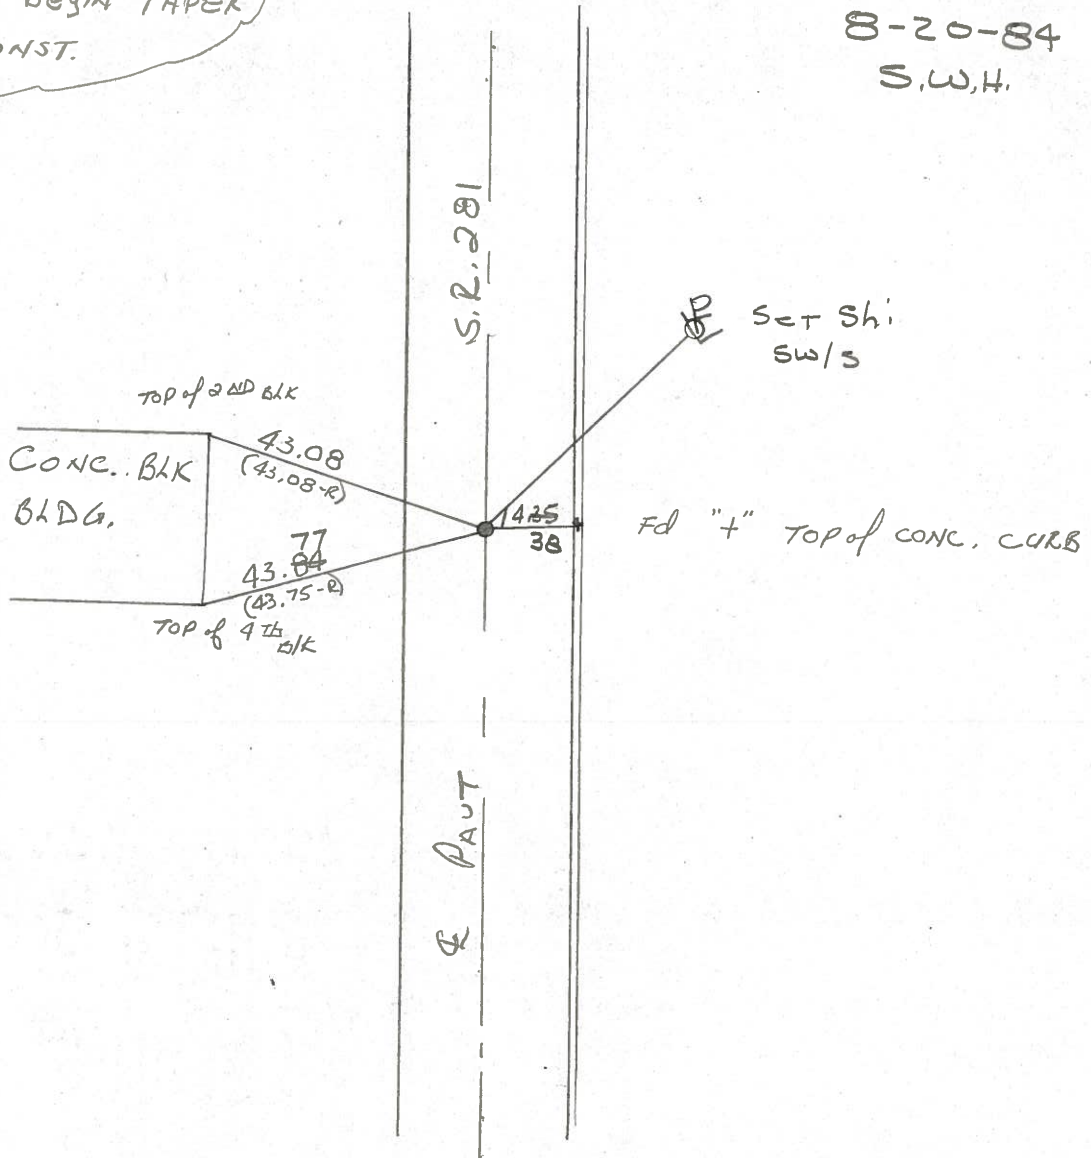

PERSONNEL TITLE PERSONNEL TITLE

MORRISON  
BURNSIDE  
SMITH  
McFARLAN

COUNTY Wood DATE 6-16-70

S. R. #281 WEATHER Cloudy


SEC. \_\_\_\_\_ TEMP. +83°

DESCRIPTION CONST. CONTROL TIES JOB NO. \_\_\_\_\_

LEFT CENTER LINE RIGHT

1301 +23 loop

1302+50  
END TAPER  
FOR CONST.  
(BEGIN 3' CONSTANT  
NORTH)

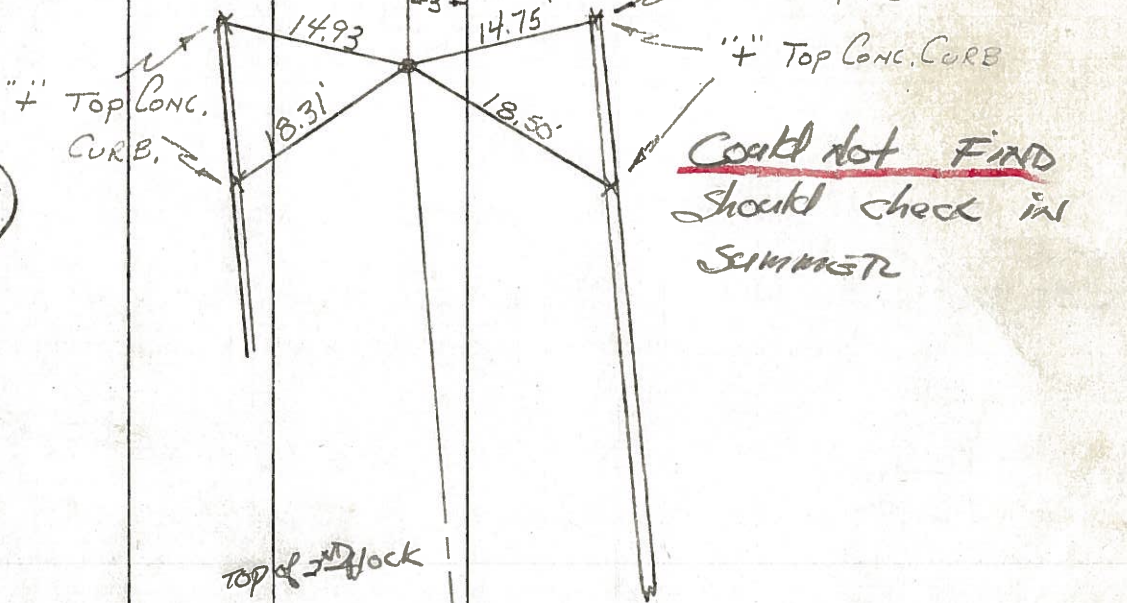


Could not FIND  
Should check in  
SUMMER

52-D

CONC. BLK.  
MACHINE  
SHOP  
BLDG.

1299+50  
BEGIN TAPER  
FOR CONST.  
Pd nail 2' down  
ONE

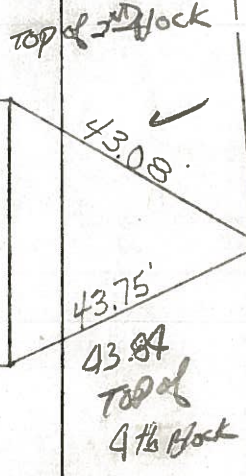


36  
14.34  
"4" Top CONC. CURB



PERSONNEL	TITLE	PERSONNEL	TITLE	COUNTY	DATE
MORRISON				Wood	6-16-70
BURNSIDE				S. R. #281	WEATHER Cloudy
SMITH				SEC.	TEMP. +83°
HOFFMAN					

DESCRIPTION ¢ CONST. CONTROL TIES JOB NO. \_\_\_\_\_

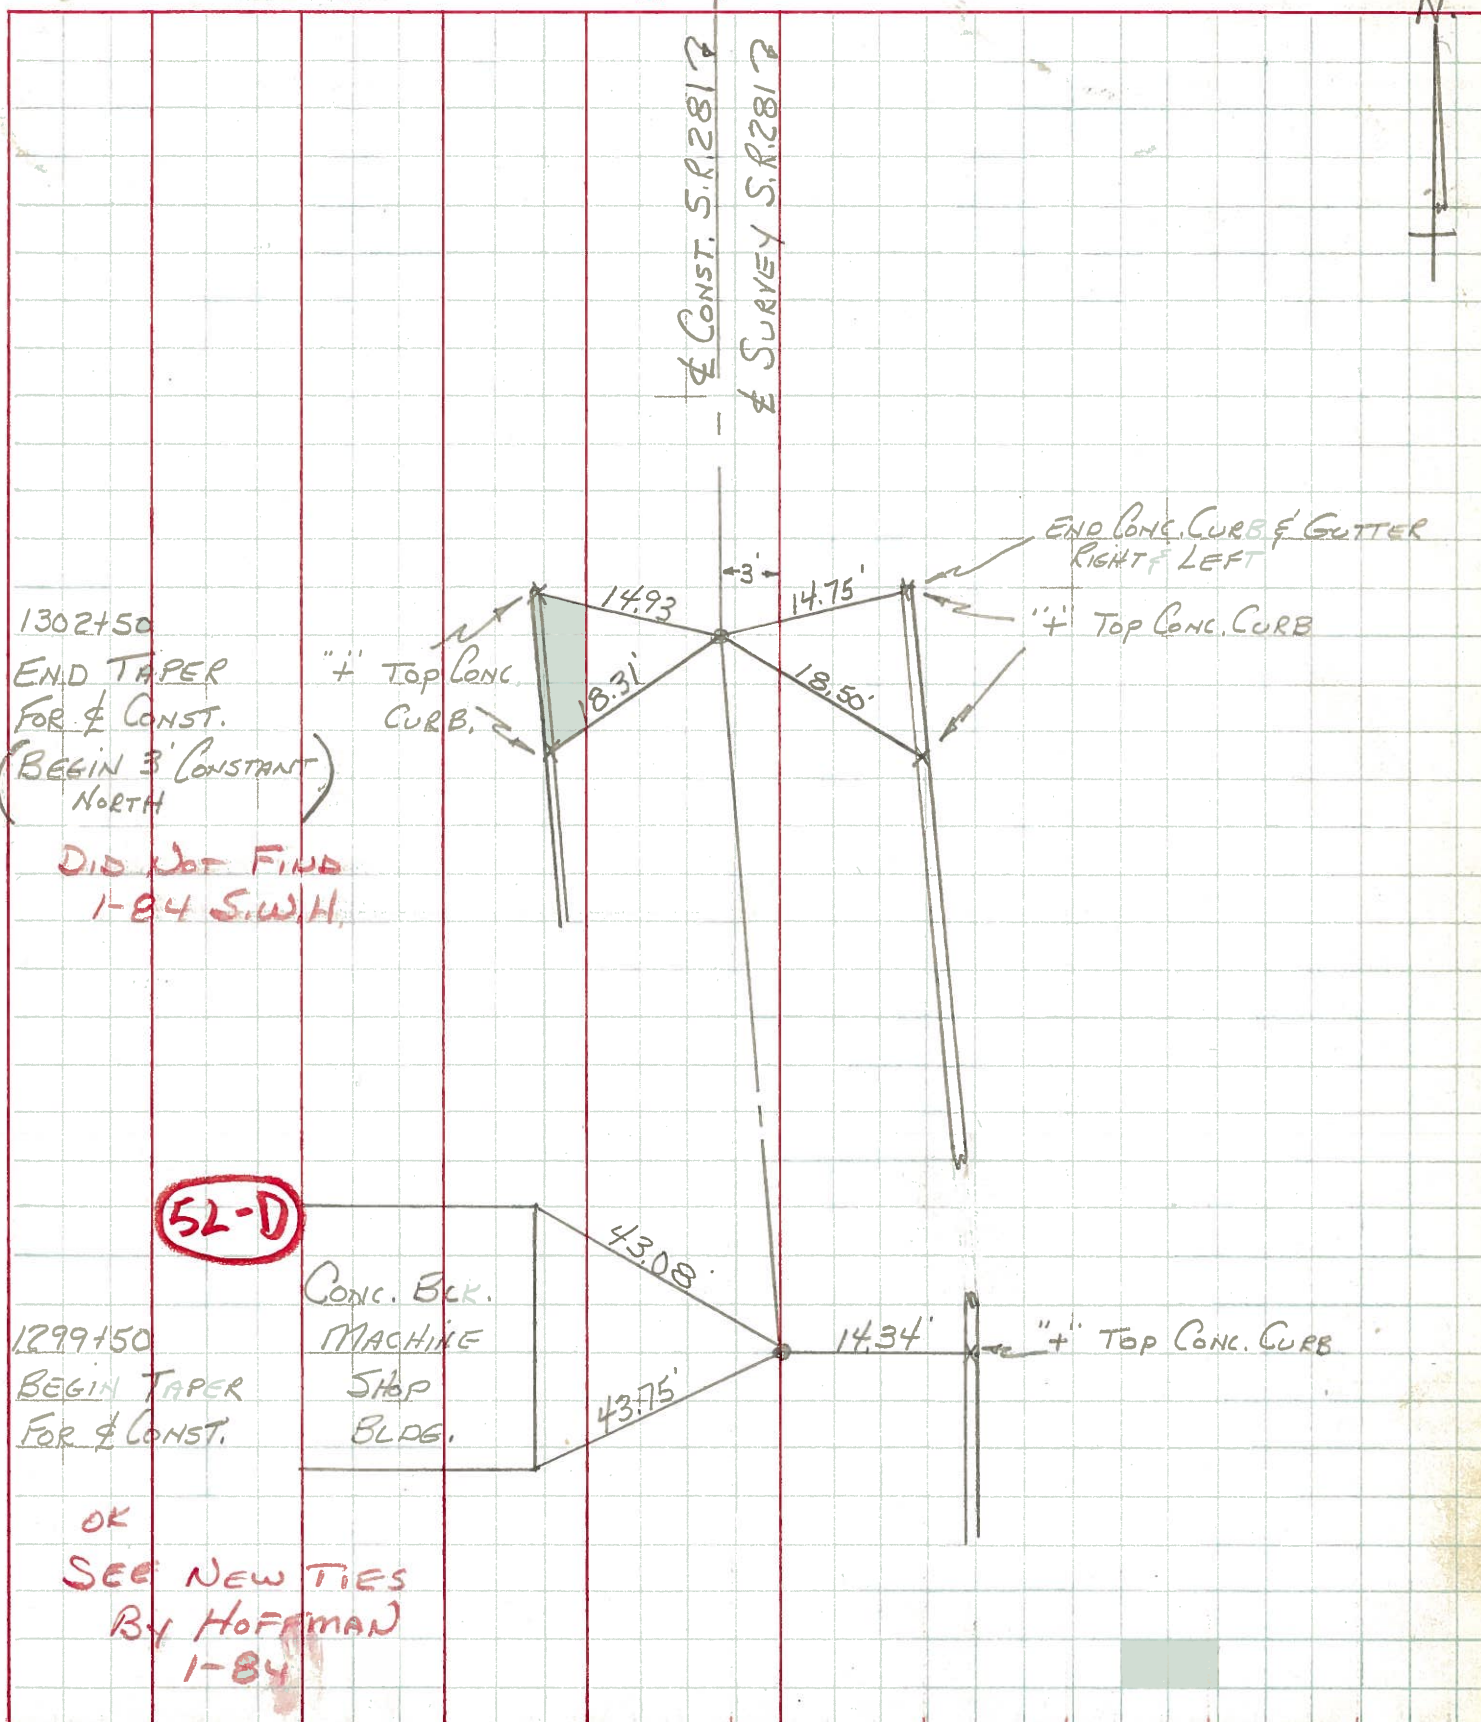

OK  
SEE NEW TIES  
BY HOFFMAN  
1-84