

O.D.O.T. DISTRICT 2 SURVEY OFFICE (USE ONLY)

PERSONNEL

REFERENCE NO. 1

SHEET 1 OF 7

NOTES LOEHRKE
 H.C. ROUSOS
 R.C. CANTERBURY

DATE 11/13/96
 WEATHER FAIR
 TEMP. 28°

ROUTE SR 420
 COUNTY WOOD
 TOWNSHIP TROY
 SECTION 3

DWG BY NIESE PID _____

T 6 N R 12 E

TYPE MONUMENT MONBOX

ON SURFACE - ~~BELOW~~ ON



OFFSET C PAVEMENT _____ LT : RT

- TO - EDGE PAVEMENT

STATION: 76+03

HORZ. DATUM: _____ GEOID: _____

GRID: NORTHING: _____ EASTING: _____

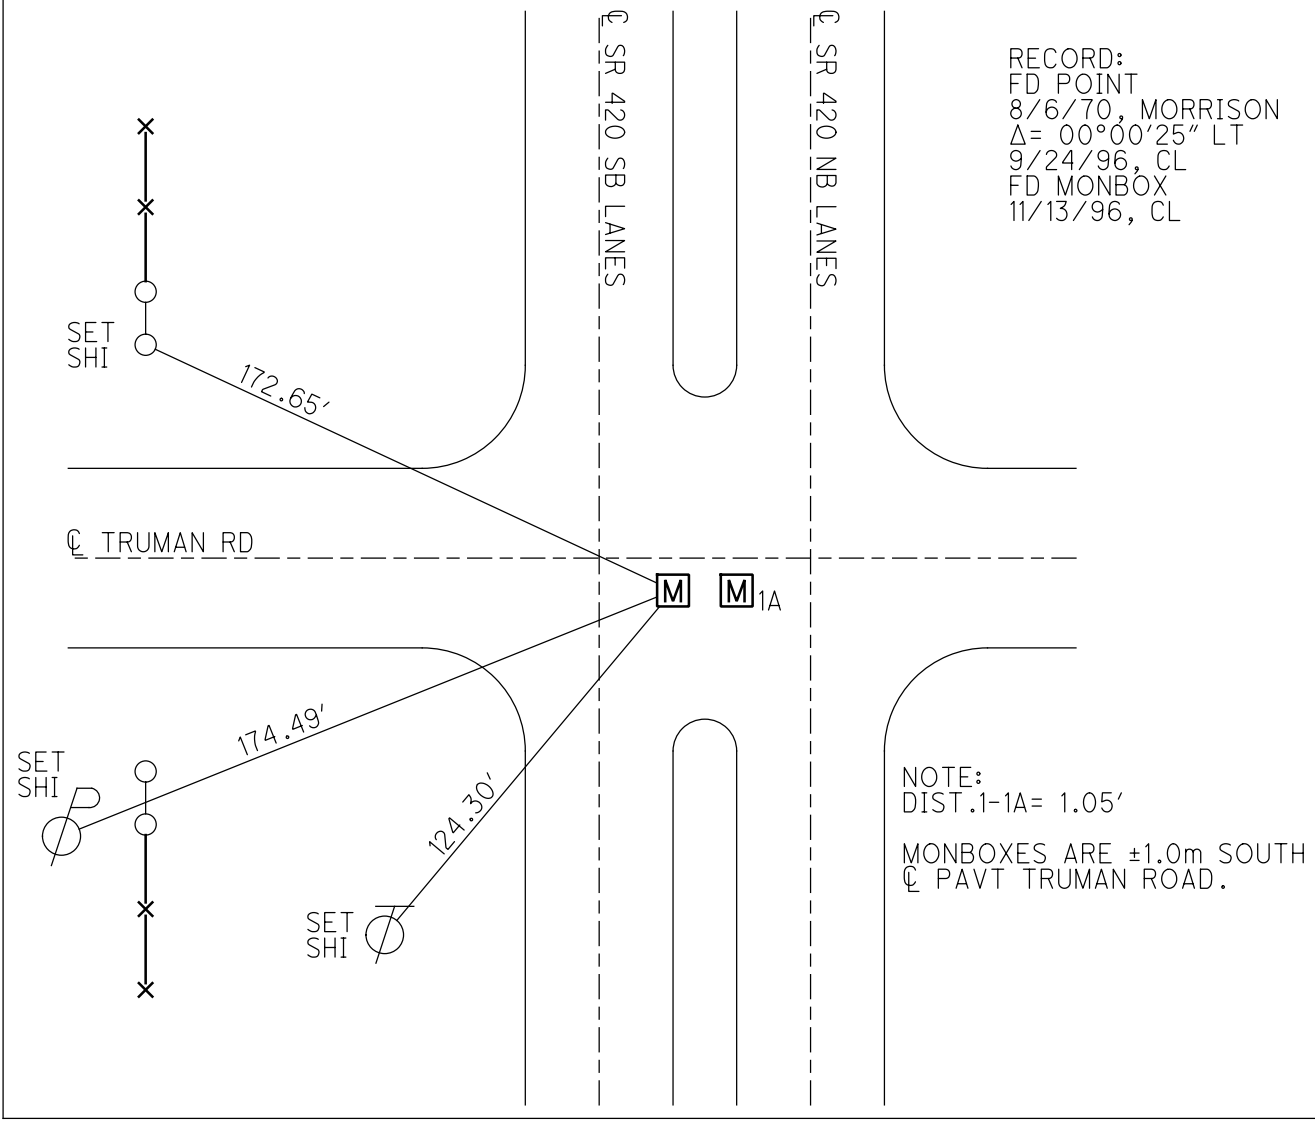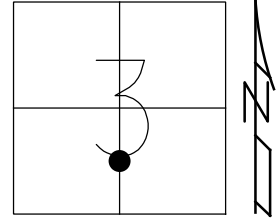

O.D.O.T. DISTRICT 2 SURVEY OFFICE (USE ONLY)

PERSONNEL

REFERENCE NO. 1 A

SHEET 2 OF 7

NOTES LOEHRKE

DATE 11/13/96

ROUTE SR 420

H.C. ROUSOS

WEATHER FAIR

COUNTY WOOD

R.C. CANTERBURY

TEMP. 28°

TOWNSHIP TROY

SECTION 3

DWG BY NIESE PID _____

T 6 N R 12 E

TYPE MONUMENT MONBOX

ON SURFACE - ~~BELOW~~ ON

OFFSET C PAVEMENT _____ LT : RT

- TO - EDGE PAVEMENT



STATION: 76+03

HORZ.DATUM: _____

GEOID: _____

GRID: NORTHING: _____

EASTING: _____

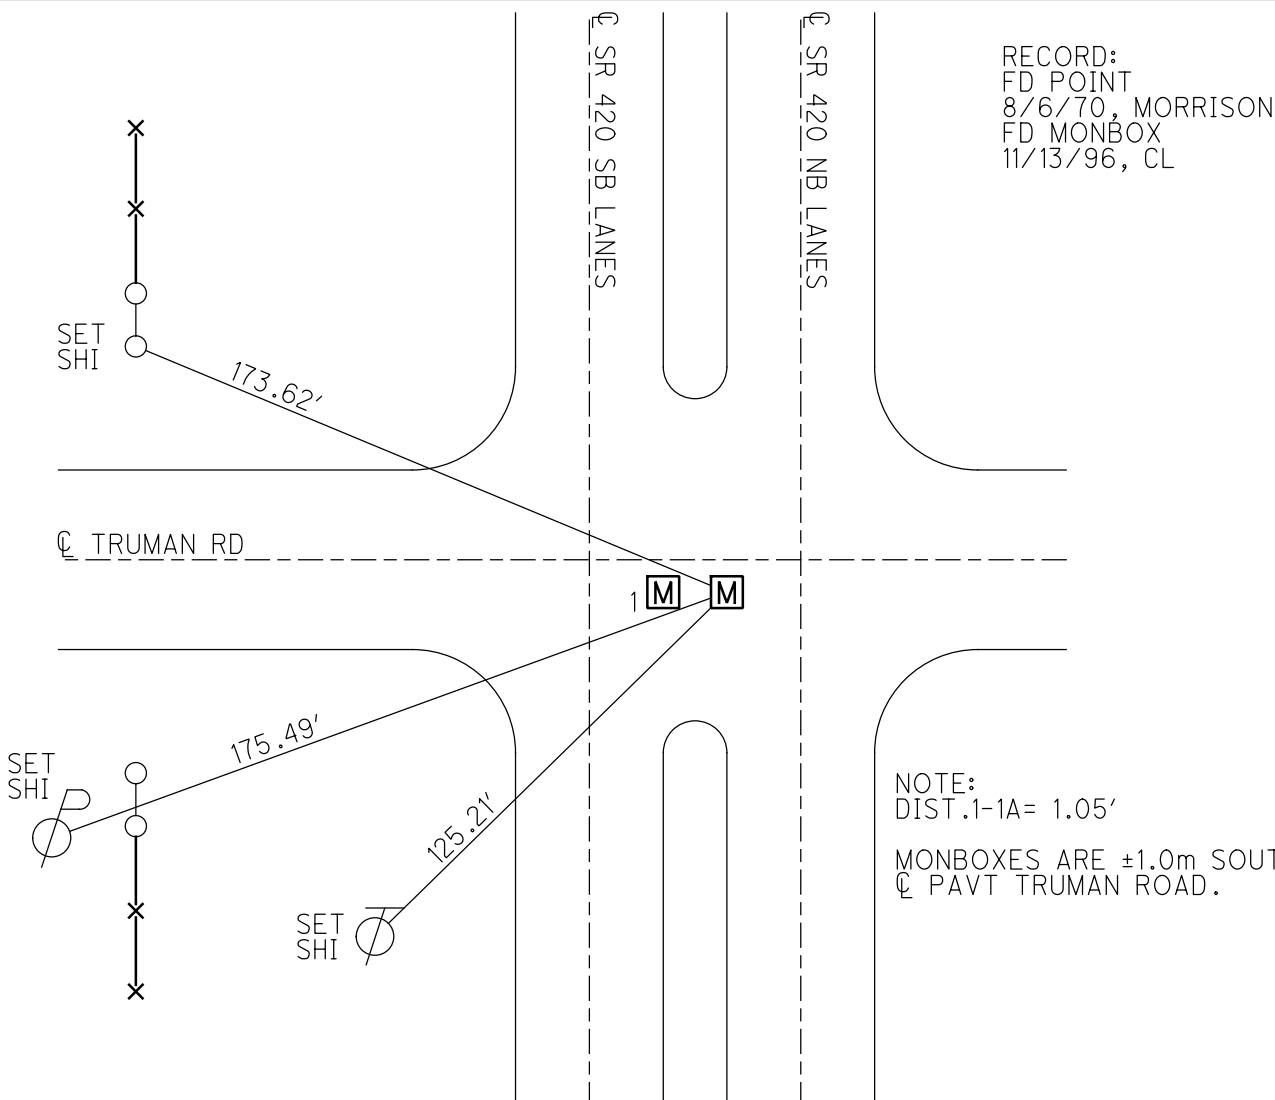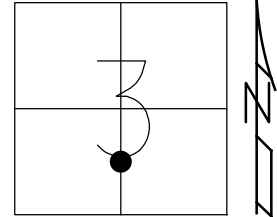


O.D.O.T. DISTRICT 2 SURVEY OFFICE (USE ONLY)

PERSONNEL _____ REFERENCE NO. 2 SHEET 1 OF 5


NOTES	<u>LOEHRKE</u>	DATE	<u>11/13/96</u>	ROUTE	<u>SR 420</u>
H.C.	<u>ROUSOS</u>	WEATHER	<u>FAIR</u>	COUNTY	<u>WOOD</u>
R.C.	<u>CANTERBURY</u>	TEMP.	<u>30°</u>	TOWNSHIP	<u>LAKE</u>
				SECTION	<u>34</u>
				T	<u>7</u> N
				R	<u>12</u> E

TYPE MONUMENT MONBOX
 ON SURFACE - ~~BELOW~~ ON
 LEFT - ☉ PAV'T - ~~RIGHT~~ 26.53'
 - TO - EDGE PAVEMENT
 S.L.M. 122+25.59

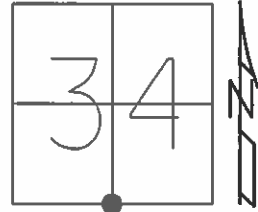

Grid: Northing: 674803.740 Easting: 1704657.877


FD MONBOX 2
 1/10/12, RJL
 6/25/14, DCH
 SR 163 STA. 120+41.83
 GPS, REFA7, REF2

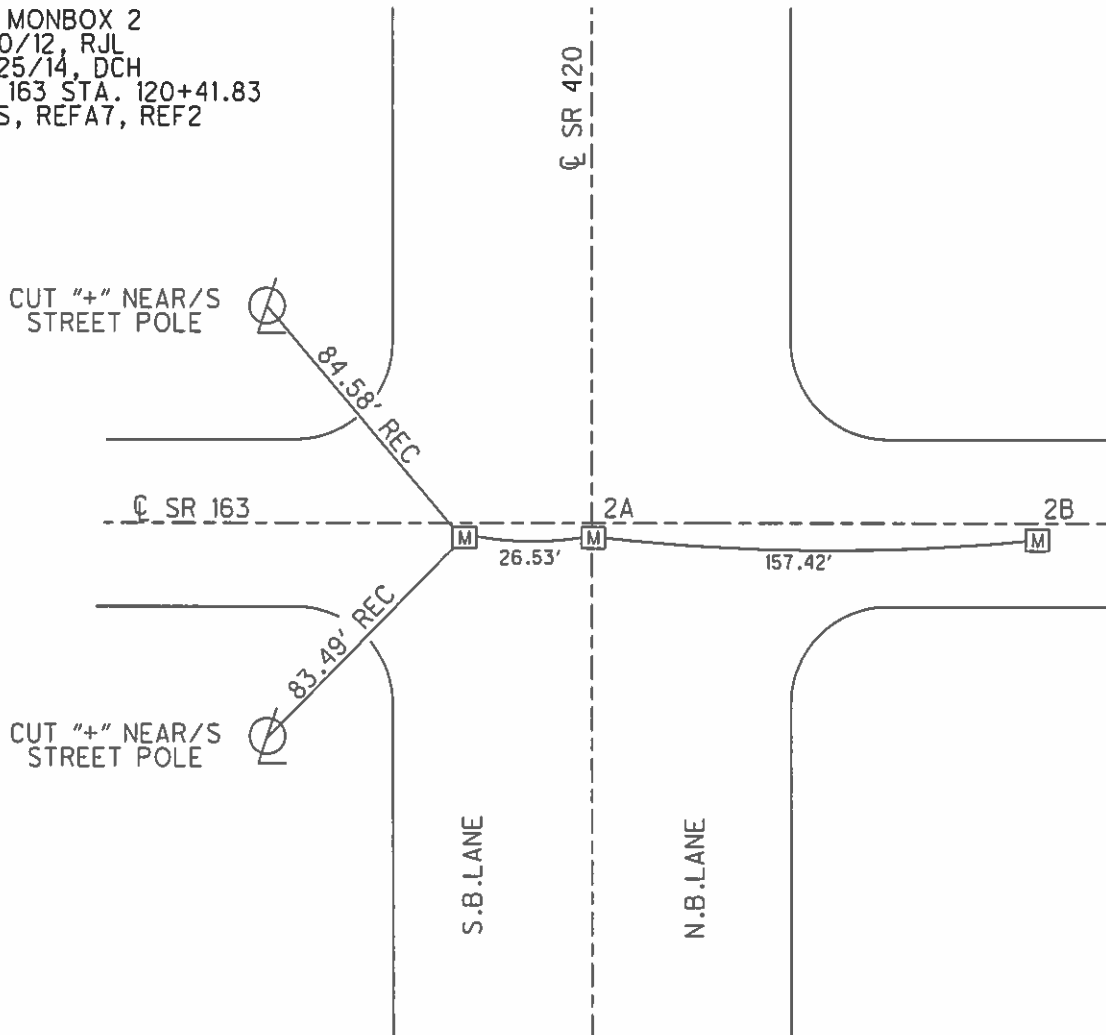

O.D.O.T. DISTRICT 2 SURVEY OFFICE (USE ONLY)


PERSONNEL _____ REFERENCE NO. 2 A SHEET 2 OF 5
 NOTES LOEHRKE DATE 11/13/96 ROUTE SR 420
 H.C. ROUSOS WEATHER FAIR COUNTY WOOD
 R.C. CANTERBURY TEMP. 30° TOWNSHIP LAKE
 _____ SECTION 34
 _____ T 7 N R 12 E

TYPE MONUMENT MONBOX
 ON SURFACE - ~~BELOW~~ ON
 LEFT - ☉ PAV'T - RIGHT ON
- TO - EDGE PAVEMENT
 S.L.M. 122+25.59

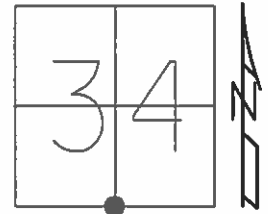

Grid: Northing: 674803.550 Easting: 1704684.270

FD MONBOX 2A
 1/10/12, RJL
 6/25/14, DCH
 SR 163 STA. 120+68.17
 GPS, REFB7, REFA2

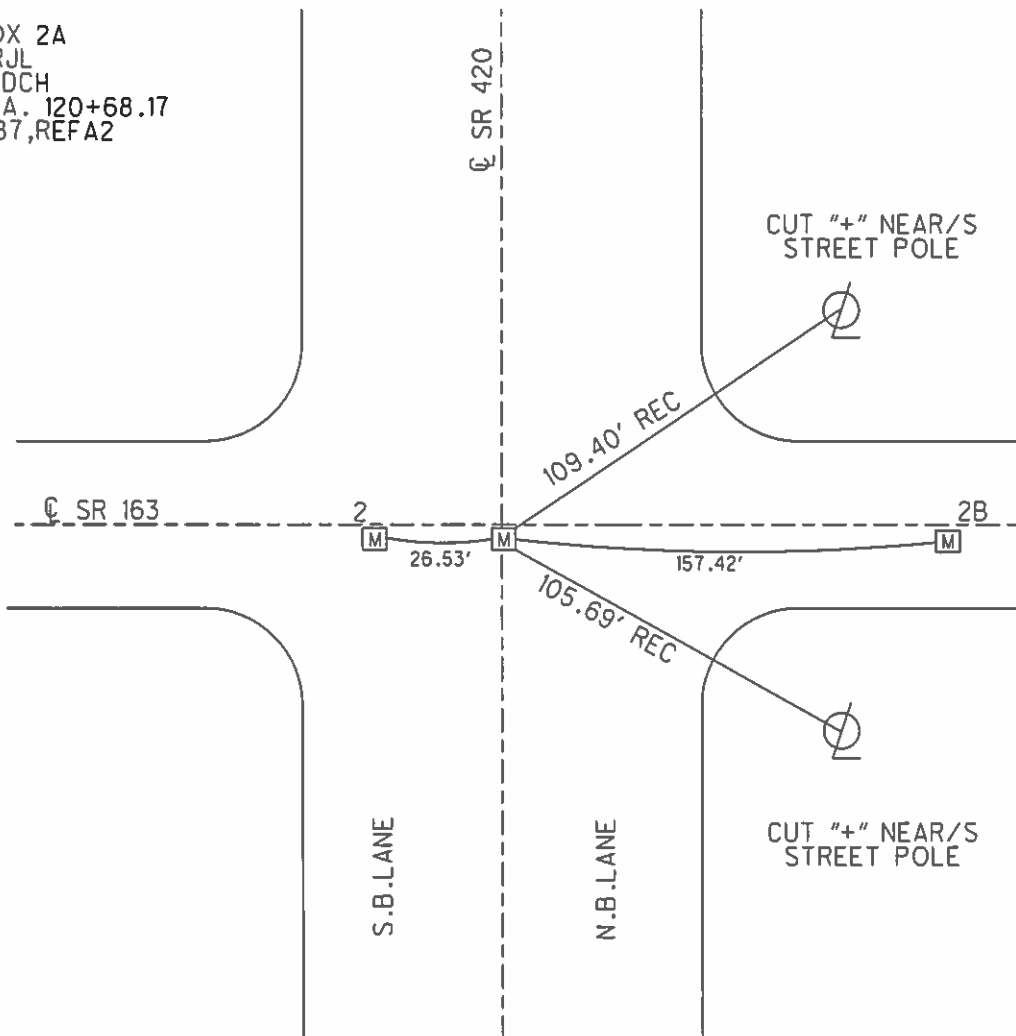


O.D.O.T. DISTRICT 2 SURVEY OFFICE (USE ONLY)

PERSONNEL _____ REFERENCE NO. 2 B SHEET 3 OF 5


NOTES RHOADES DATE 8/5/13 ROUTE SR 420
 H.C. CODER WEATHER FAIR COUNTY WOOD
 R.C. RHOADES TEMP. 74° TOWNSHIP LAKE
 _____ SECTION 34
 _____ T 7 N R 12 E

TYPE MONUMENT MONBOX
 ON SURFACE - ~~BELOW~~ ON _____
~~LEFT~~ - Q PAV'T - RIGHT 157.42'
 - TO - EDGE PAVEMENT
 S.L.M. 104+48.40

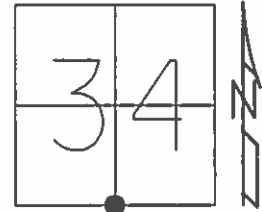

Grid: Northing: 674802.643 Easting: 1704841.659


RECORD:
 FD MONBOX 2B
 5/17/89
 MONBOX WAS
 NOT RAISED
 8/2/89, IS
 FD MONBOX
 W- 3/4" IPIN
 GPS, REF8
 1/10/12, RJL
 FD MONBOX
 SEC2
 6/25/14, DCH

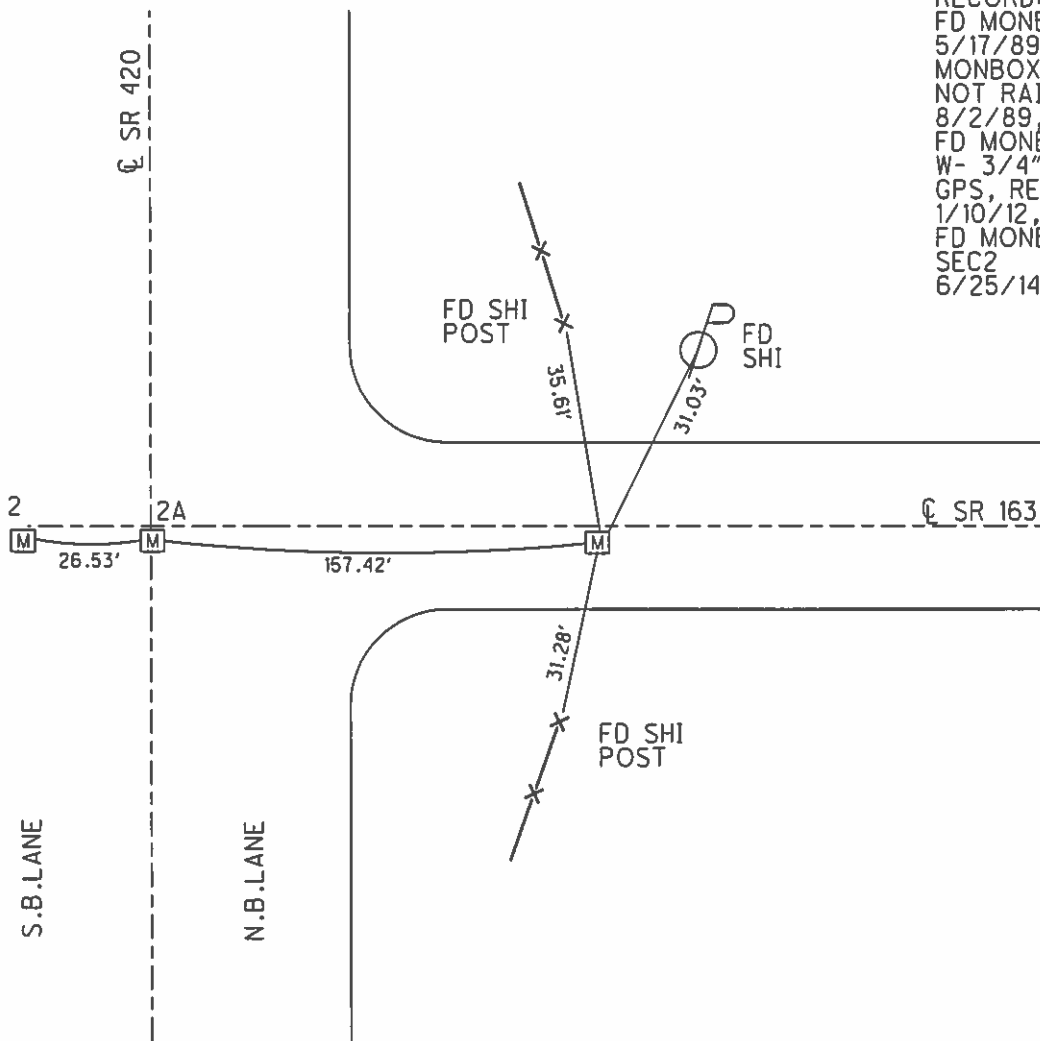

O.D.O.T. DISTRICT 2 SURVEY OFFICE (USE ONLY)


PERSONNEL _____ REFERENCE NO. 3 SHEET 4 OF 5
 NOTES HOMAN DATE 6/25/14 ROUTE SR 420
 H.C. LEU WEATHER CLOUDY COUNTY WOOD
 R.C. MEYER TEMP. 70° TOWNSHIP LAKE
 _____ SECTION 34
 _____ T 7 N R 12 E

TYPE MONUMENT MONBOX
 ON SURFACE - ~~BELOW~~ ON _____
 LEFT - ☉ PAV'T - RIGHT ON _____
 - TO - EDGE PAVEMENT
 S.L.M. 131+08.93

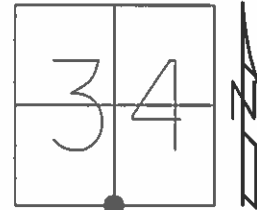

Grid: Northing: 677463.495 Easting: 1704739.908


FD MONBOX
 GPS, SECT
 6/25/14, DCH

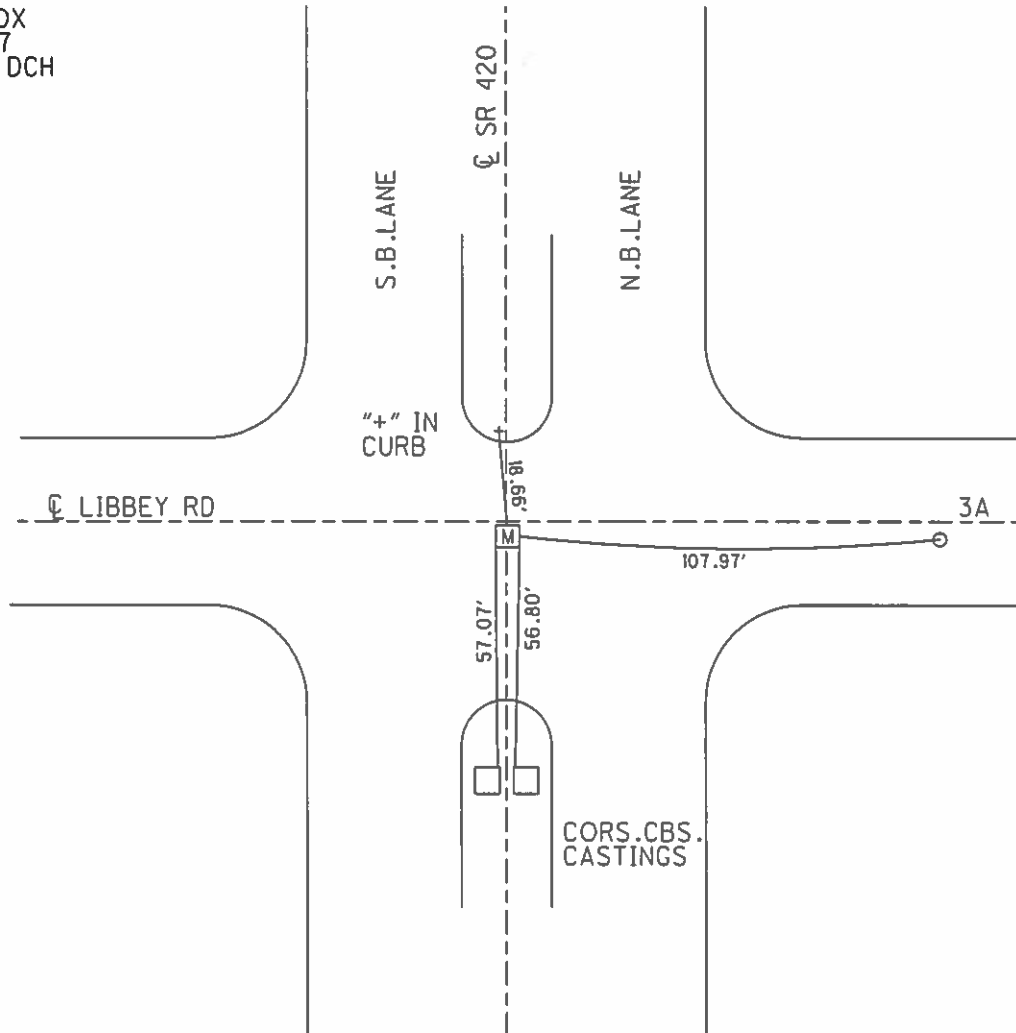

O.D.O.T. DISTRICT 2 SURVEY OFFICE (USE ONLY)

PERSONNEL _____ REFERENCE NO. 3 A SHEET 5 OF 5
 NOTES HOMAN DATE 6/25/14 ROUTE SR 420
 H.C. LEU WEATHER CLOUDY COUNTY WOOD
 R.C. MEYER TEMP. 70° TOWNSHIP LAKE
 _____ SECTION 34
 _____ T 7 N R 12 E

TYPE MONUMENT DRILLHOLE
 ON SURFACE - ~~BELOW~~ ON _____
~~LEFT~~ - Q PAV'T - RIGHT 107.9'
 - TO - EDGE PAVEMENT
 S.L.M. 131+08.93

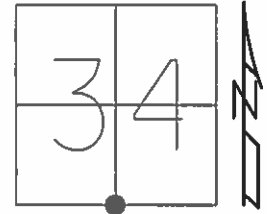

Grid: Northing: 677463.608 Easting: 1704847.875

RECORD: P.O.T.
 STA. 26+49.13
 FD DRILLHOLE
 GPS, CKSEC6
 6/25/14, DCH

