

O.D.O.T. DISTRICT 2 SURVEY OFFICE (USE ONLY)

PERSONNEL

REFERENCE NO. 1

SHEET 1 OF 7

NOTES LOEHRKE  
 H.C. ROUSOS  
 R.C. CANTERBURY

DATE 11/13/96  
 WEATHER FAIR  
 TEMP. 28°

ROUTE SR 420  
 COUNTY WOOD  
 TOWNSHIP TROY  
 SECTION 3

DWG BY NIESE PID \_\_\_\_\_

T 6 N R 12 E

TYPE MONUMENT MONBOX

ON SURFACE - ~~BELOW~~ ON



OFFSET  $\text{C}$  PAVEMENT \_\_\_\_\_ LT : RT

- TO - EDGE PAVEMENT

STATION: 76+03

HORZ. DATUM: \_\_\_\_\_ GEOID: \_\_\_\_\_

GRID: NORTHING: \_\_\_\_\_ EASTING: \_\_\_\_\_

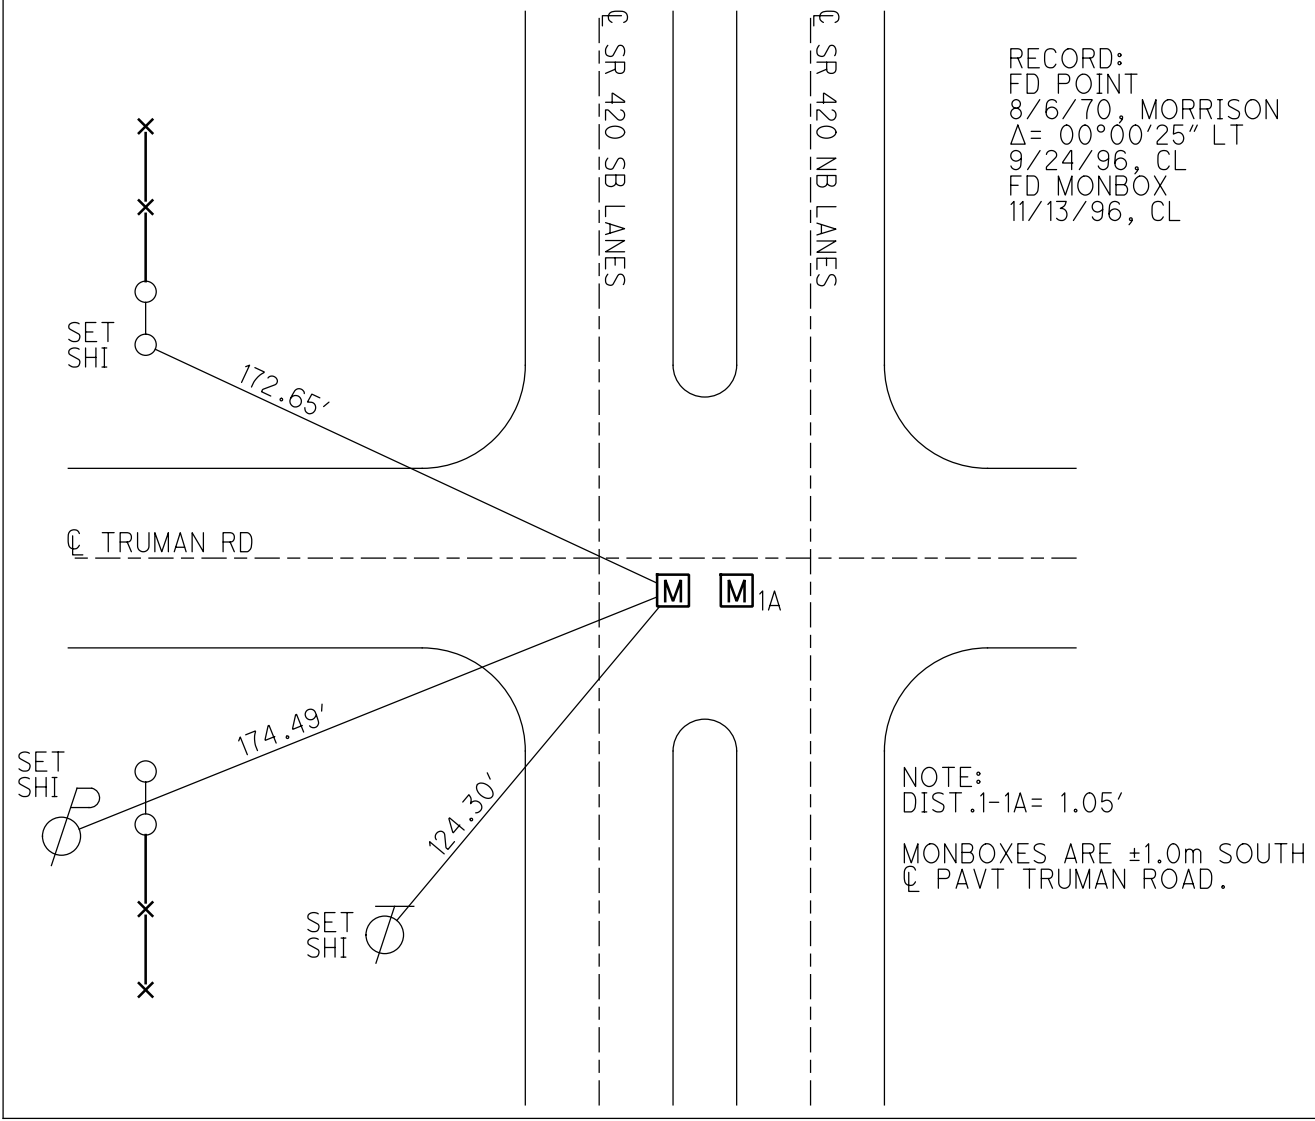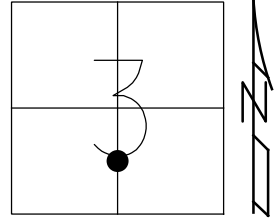

# O.D.O.T. DISTRICT 2 SURVEY OFFICE

PERSONNEL

REFERENCE NO. 1

SHEET      OF     

NOTES LOENRKE

H.C. POUSOS

R.C. CANTERBURY

DATE 11-13-96

WEATHER FAIR

TEMP. +28° F

ROUTE S.R. 420

COUNTY WOOD

TOWNSHIP TROY

SECTION 3

T6 N R 12 E



TYPE MONUMENT (Z) MOD Boxes

ON SURFACE - ~~BELOW~~ Yes

LEFT - ☉ PAV'T. - RIGHT     


     TO      EDGE PAVEMENT

S.L.M. 14522.8

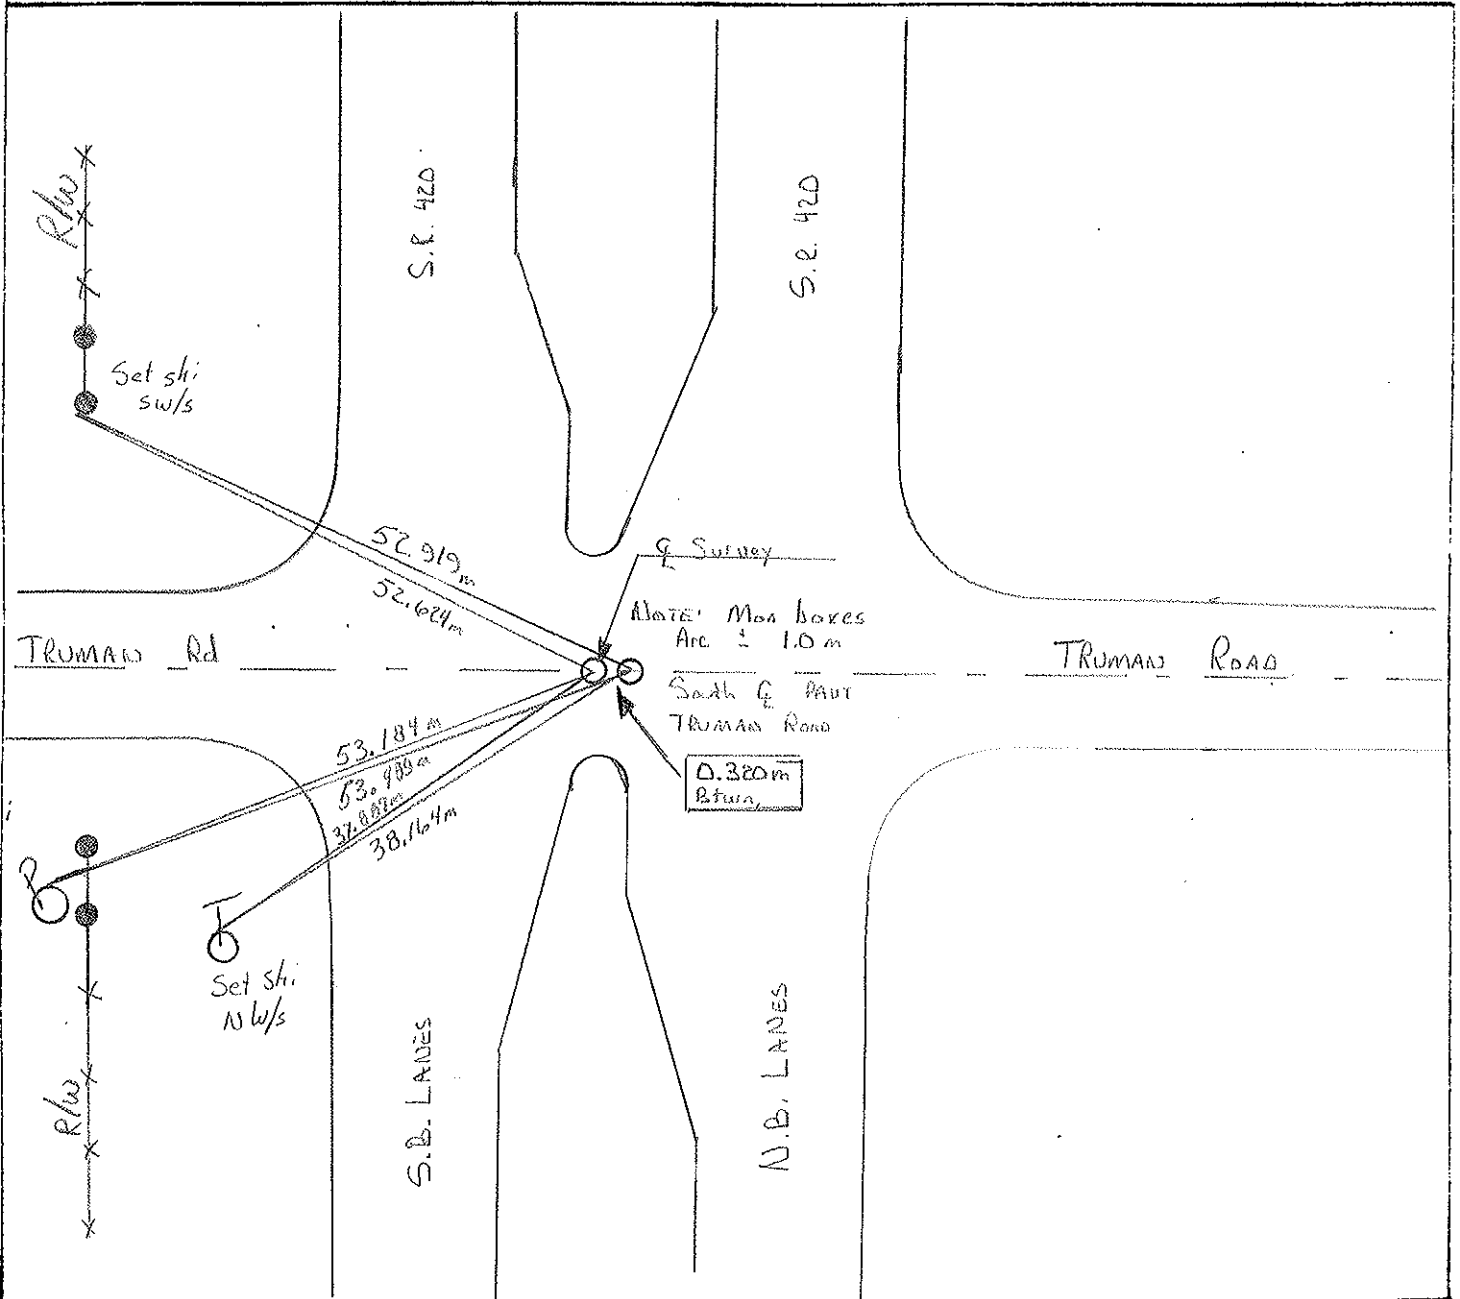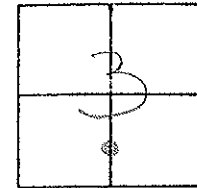

PERSONNEL	TITLE	PERSONNEL	TITLE	COUNTY	DATE
LABRUC				Wood	9-24-96
CANTRELL				S. R. 420	WEATHER Cloudy
Rowens				SEC. 0.00	TEMP. 64

DESCRIPTION Alignment LEFT CENTER LINE RIGHT JOB NO. \_\_\_\_\_

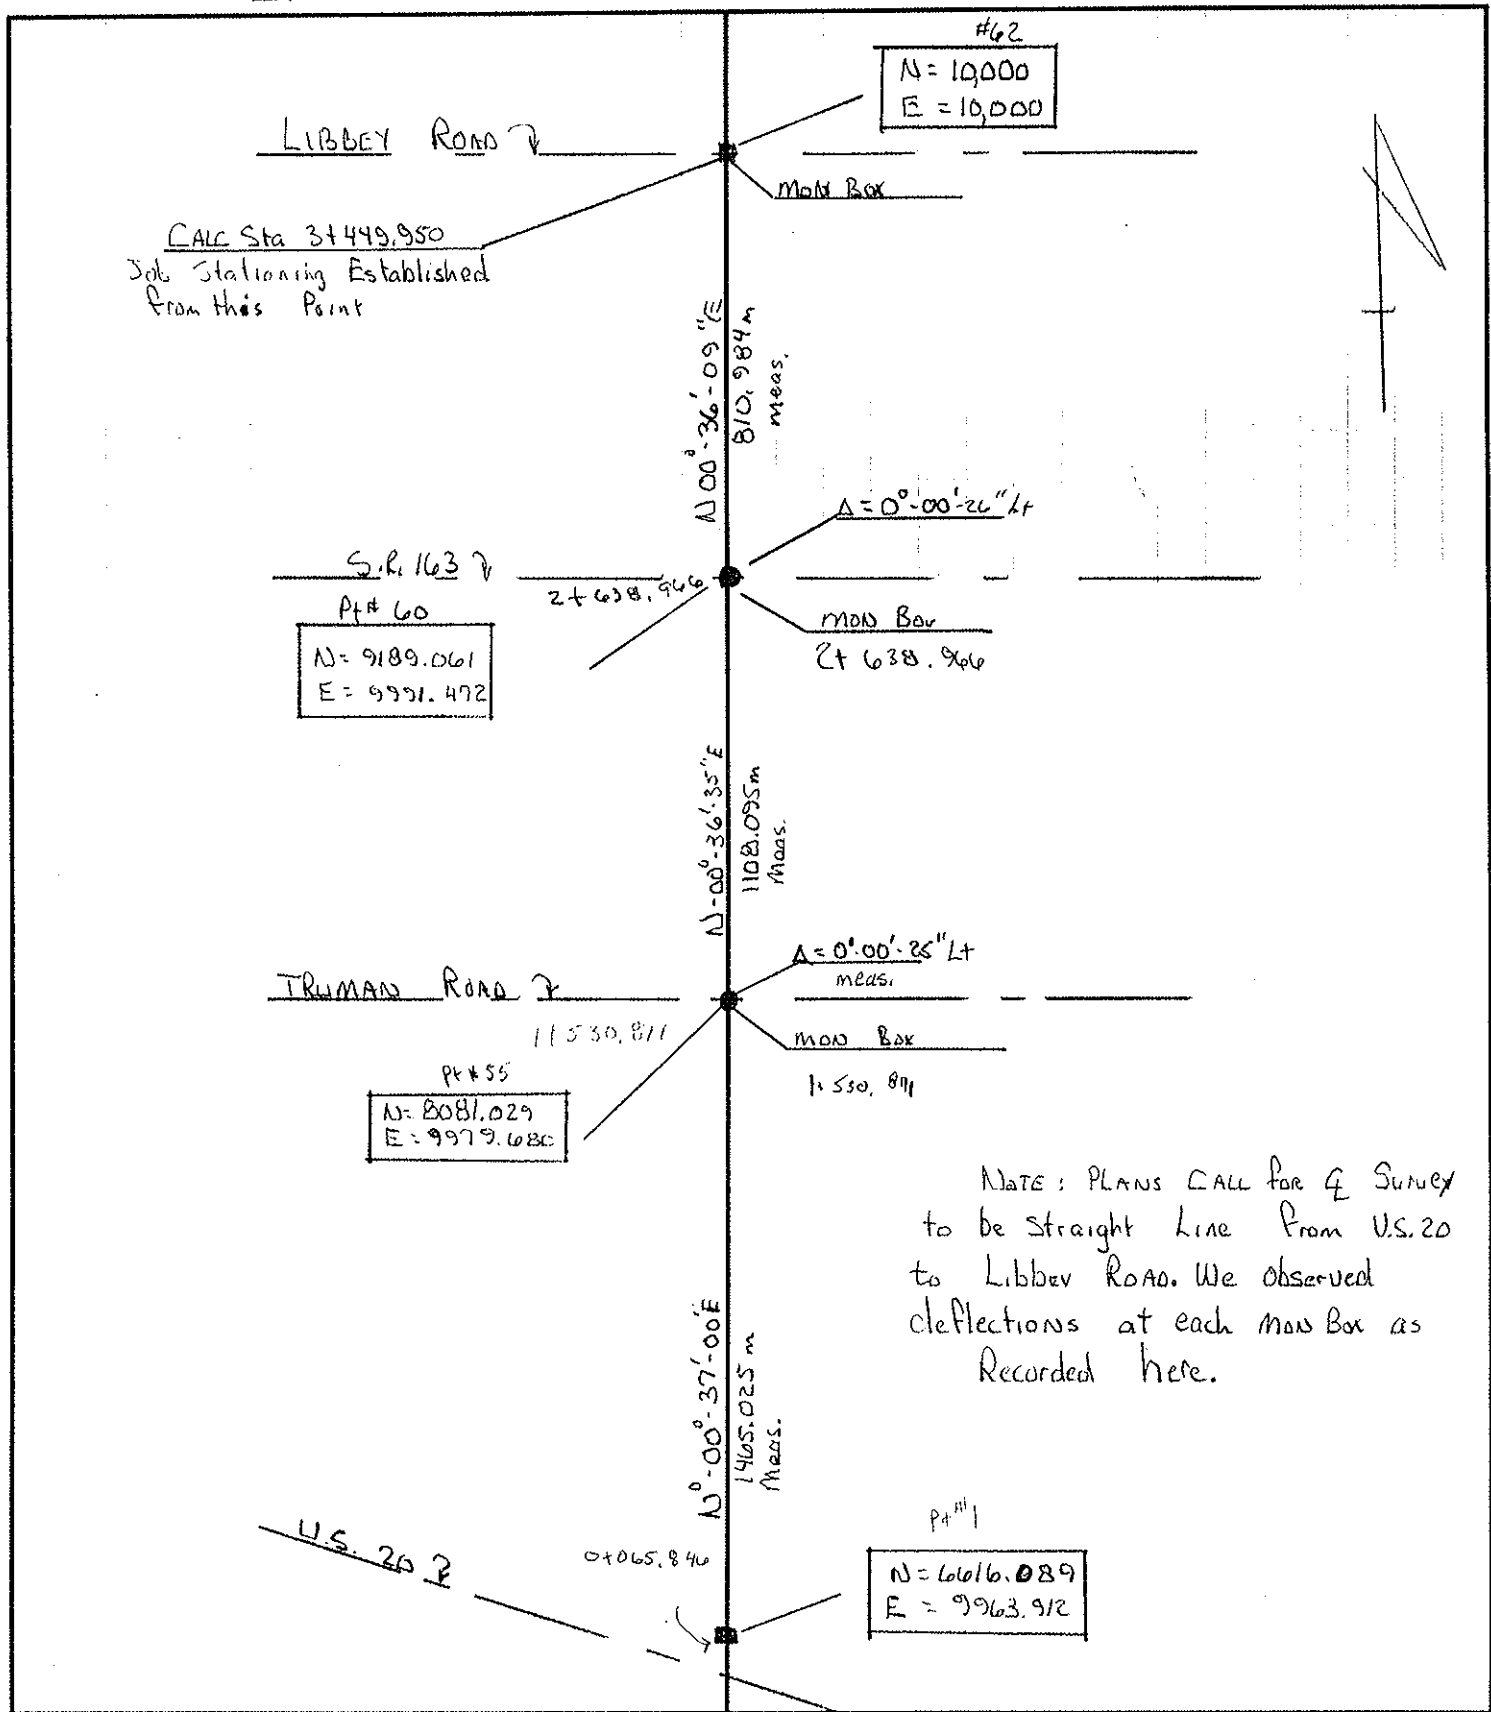

PERSONNEL	TITLE	PERSONNEL	TITLE
<u>D. Morrison</u>			
<u>Fowers</u>			
<u>Halcombe</u>			

COUNTY Wood DATE Aug. 6, 1970  
 S. R. # 420 WEATHER Pt. Cloudy  
 SEC. 45<sup>th</sup> 20 to Turnpike TEMP. +75°

DESCRIPTION Ties To Control Points on Tol. - Det. Elevation JOB NO. \_\_\_\_\_

