

O.D.O.T. DISTRICT 2 SURVEY OFFICE (USE ONLY)

PERSONNEL _____

REFERENCE NO. 1 A

SHEET 2 OF 7

NOTES LOEHRKE

DATE 11/13/96

ROUTE SR 420

H.C. ROUSOS

WEATHER FAIR

COUNTY WOOD

R.C. CANTERBURY

TEMP. 28°

TOWNSHIP TROY

SECTION 3

DWG BY NIESE PID _____

T 6 N R 12 E

TYPE MONUMENT MONBOX

ON SURFACE - ~~BELOW~~ ON



OFFSET C PAVEMENT _____ LT : RT

- TO - EDGE PAVEMENT

STATION: 76+03

HORZ.DATUM: _____ GEOID: _____

GRID: NORTHING: _____ EASTING: _____

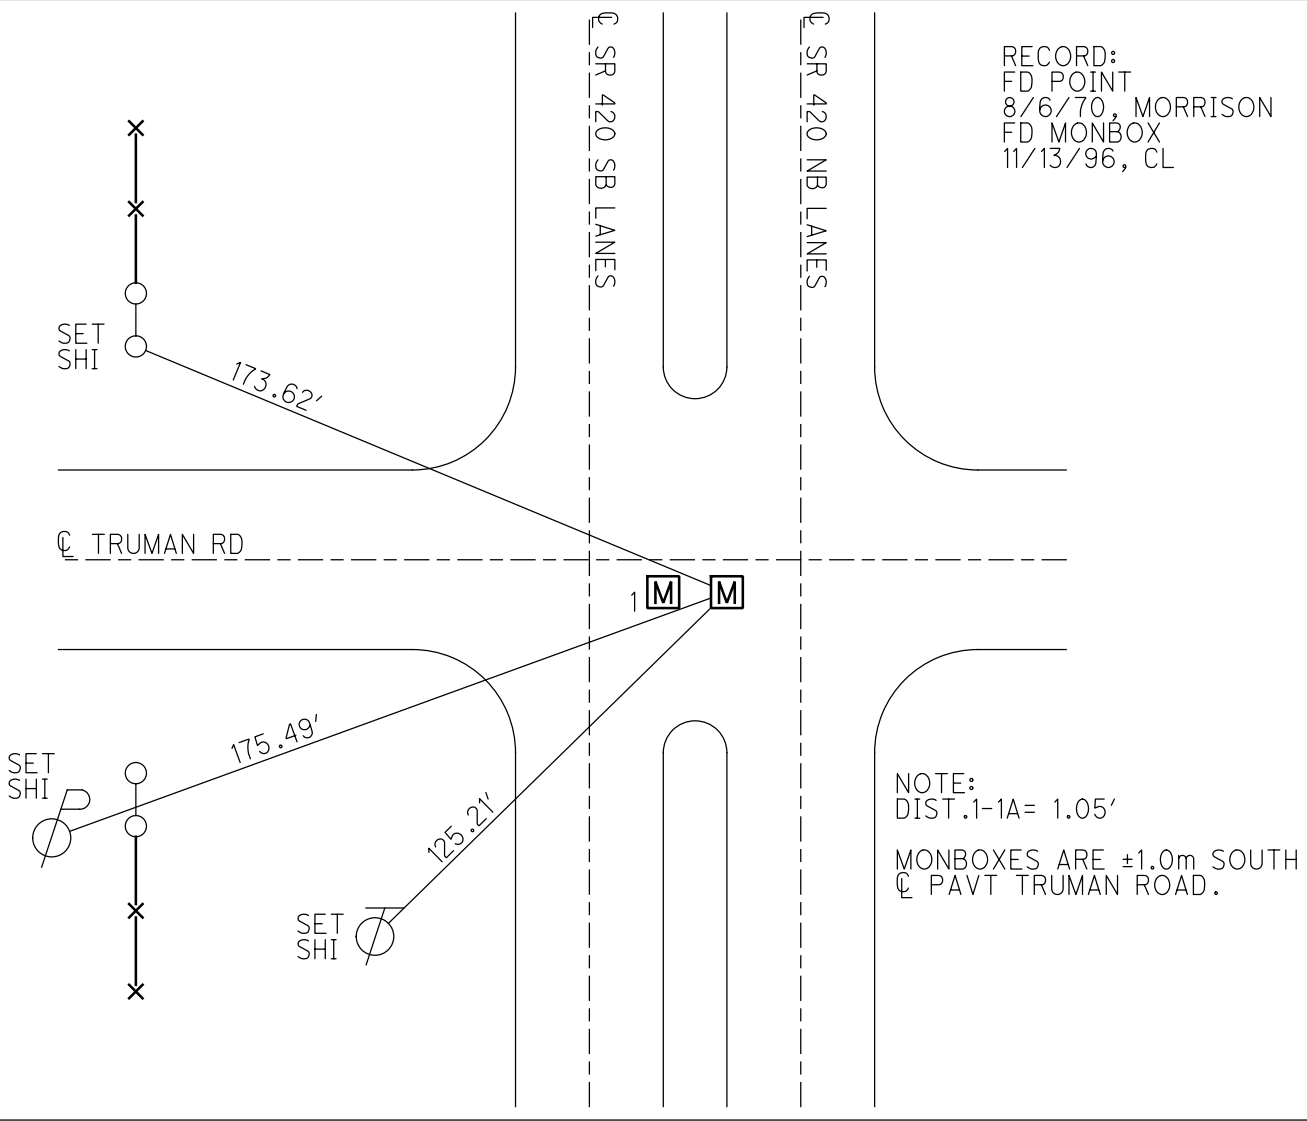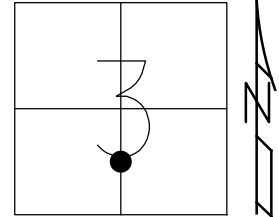

O.D.O.T. DISTRICT 2 SURVEY OFFICE

PERSONNEL _____

REFERENCE NO. 1

SHEET _____ OF _____

NOTES LOENRKE

H.C. PAUSOS

R.C. CANTERBURY

DATE 11-13-96

WEATHER FAIR

TEMP. +28° F

ROUTE S.R. 420

COUNTY WOOD

TOWNSHIP TROY

SECTION 3

T6 N R 12 E



TYPE MONUMENT (Z) MOD Boxes

ON SURFACE - ~~BELOW~~ Yes

LEFT - ☉ PAV'T. - RIGHT _____


TO _____ EDGE PAVEMENT

S.L.M. 14522.8

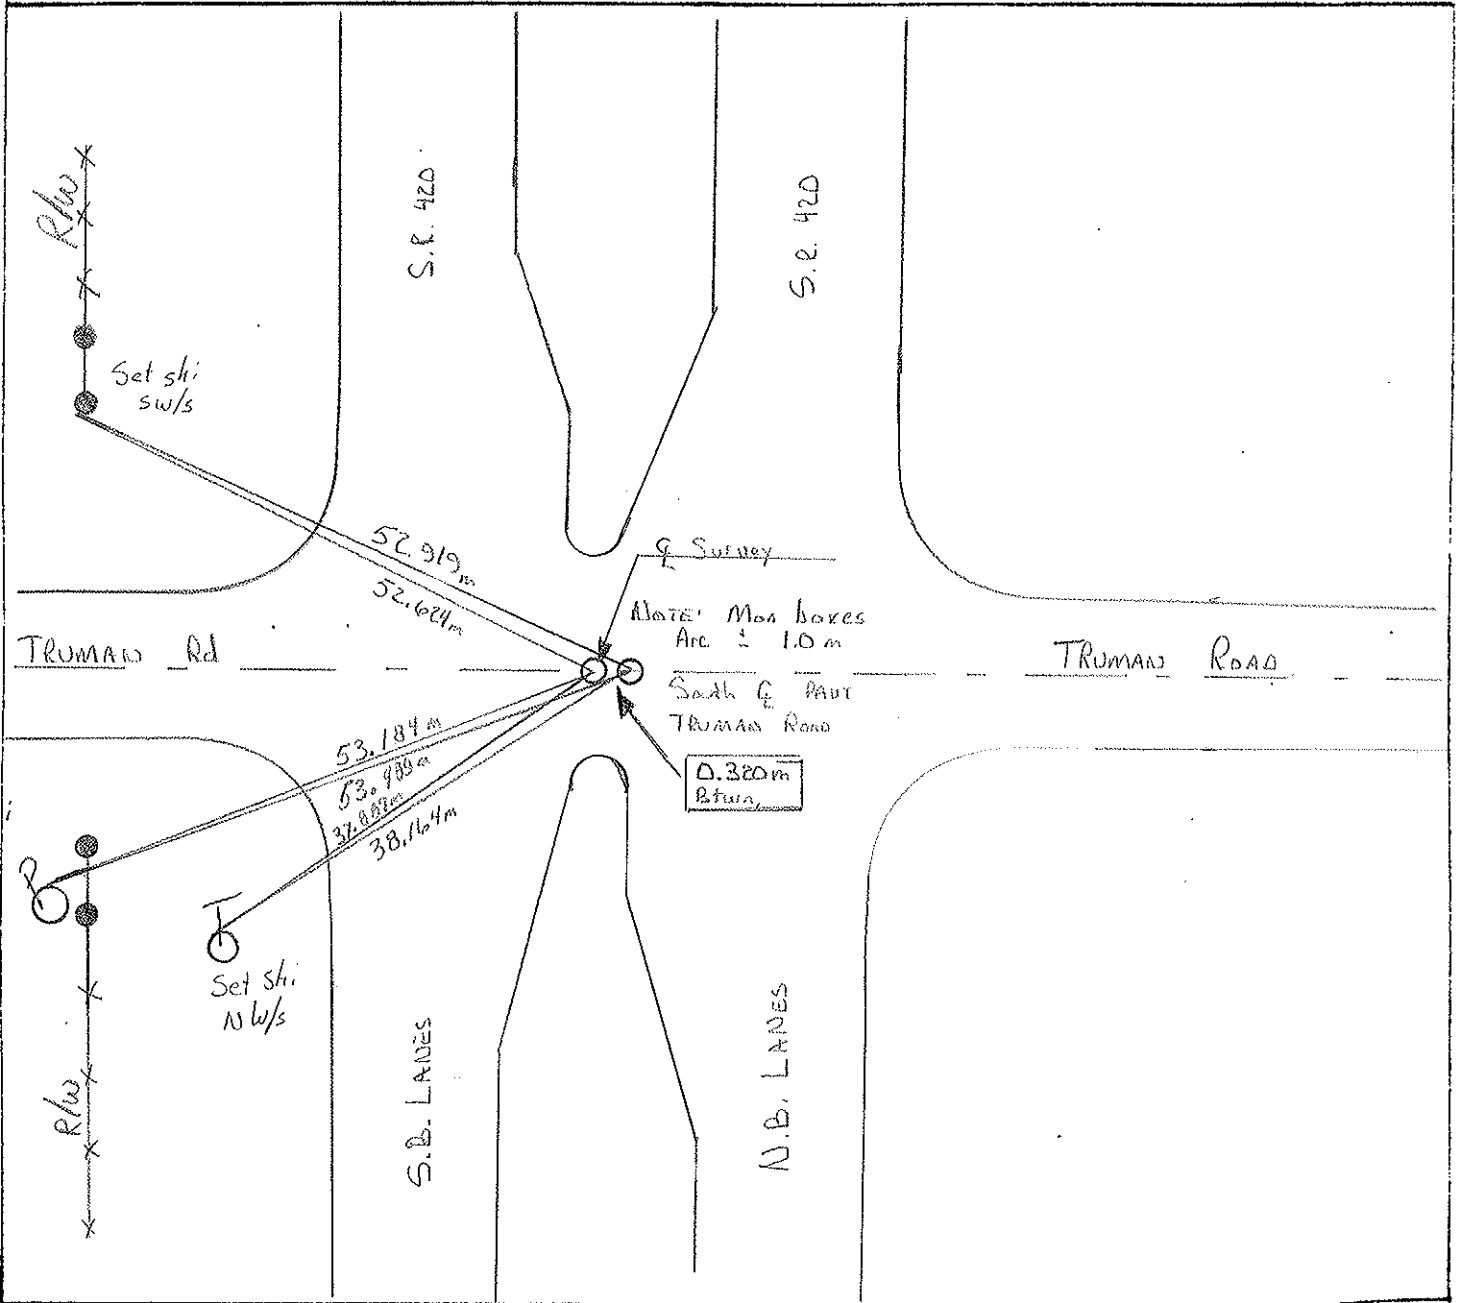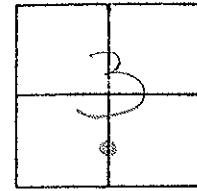

PERSONNEL	TITLE	PERSONNEL	TITLE	COUNTY	DATE
LABRUC				Wood	9-24-96
CANTRELL				S. R. 420	WEATHER Cloudy
Rowens				SEC. 0.00	TEMP. 64

DESCRIPTION Alignment LEFT CENTER LINE RIGHT JOB NO. _____

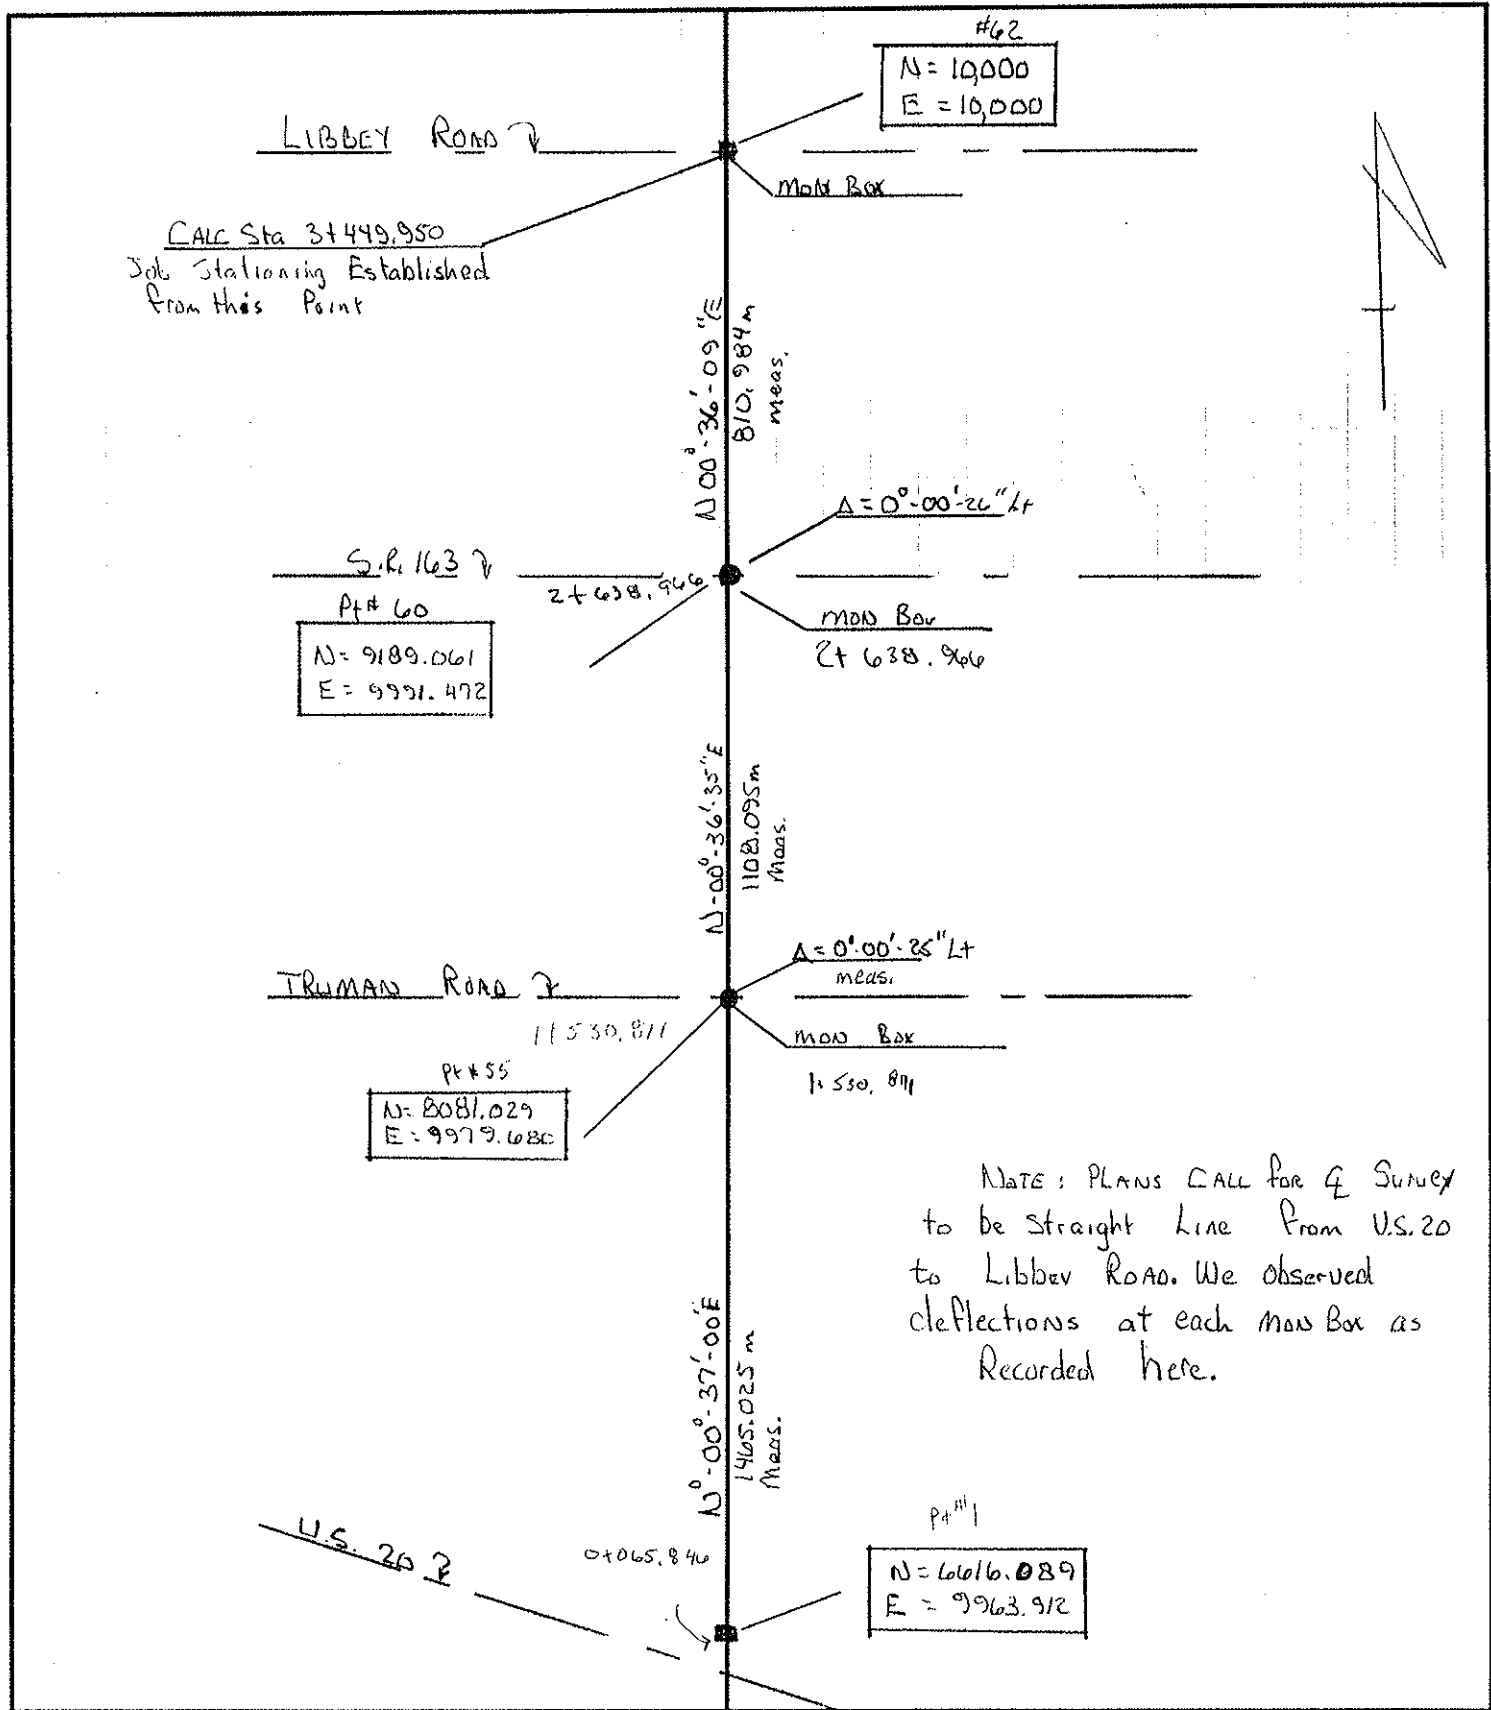

PERSONNEL	TITLE	PERSONNEL	TITLE
<u>D. Morrison</u>			
<u>Fowers</u>			
<u>Halcombe</u>			

COUNTY Wood DATE Aug. 6, 1970
 S. R. # 420 WEATHER Pt. Cloudy
 SEC. 45th 20 to Turnpike TEMP. +75°

DESCRIPTION Ties To Control Points on Tol. - Det. Elevation JOB NO. _____

