


O.D.O.T. DISTRICT 2 SURVEY OFFICE (USE ONLY)

PERSONNEL _____ REFERENCE NO. 2 SHEET 1 OF 5


NOTES	<u>LOEHRKE</u>	DATE	<u>11/13/96</u>	ROUTE	<u>SR 420</u>
H.C.	<u>ROUSOS</u>	WEATHER	<u>FAIR</u>	COUNTY	<u>WOOD</u>
R.C.	<u>CANTERBURY</u>	TEMP.	<u>30°</u>	TOWNSHIP	<u>LAKE</u>
				SECTION	<u>34</u>
				T	<u>7</u> N
				R	<u>12</u> E

TYPE MONUMENT MONBOX
 ON SURFACE - ~~BELOW~~ ON
 LEFT - ☉ PAV'T - ~~RIGHT~~ 26.53'
 - TO - EDGE PAVEMENT
 S.L.M. 122+25.59

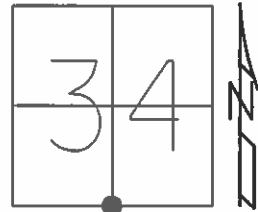

Grid: Northing: 674803.740 Easting: 1704657.877

FD MONBOX 2
 1/10/12, RJL
 6/25/14, DCH
 SR 163 STA. 120+41.83
 GPS, REFA7, REF2

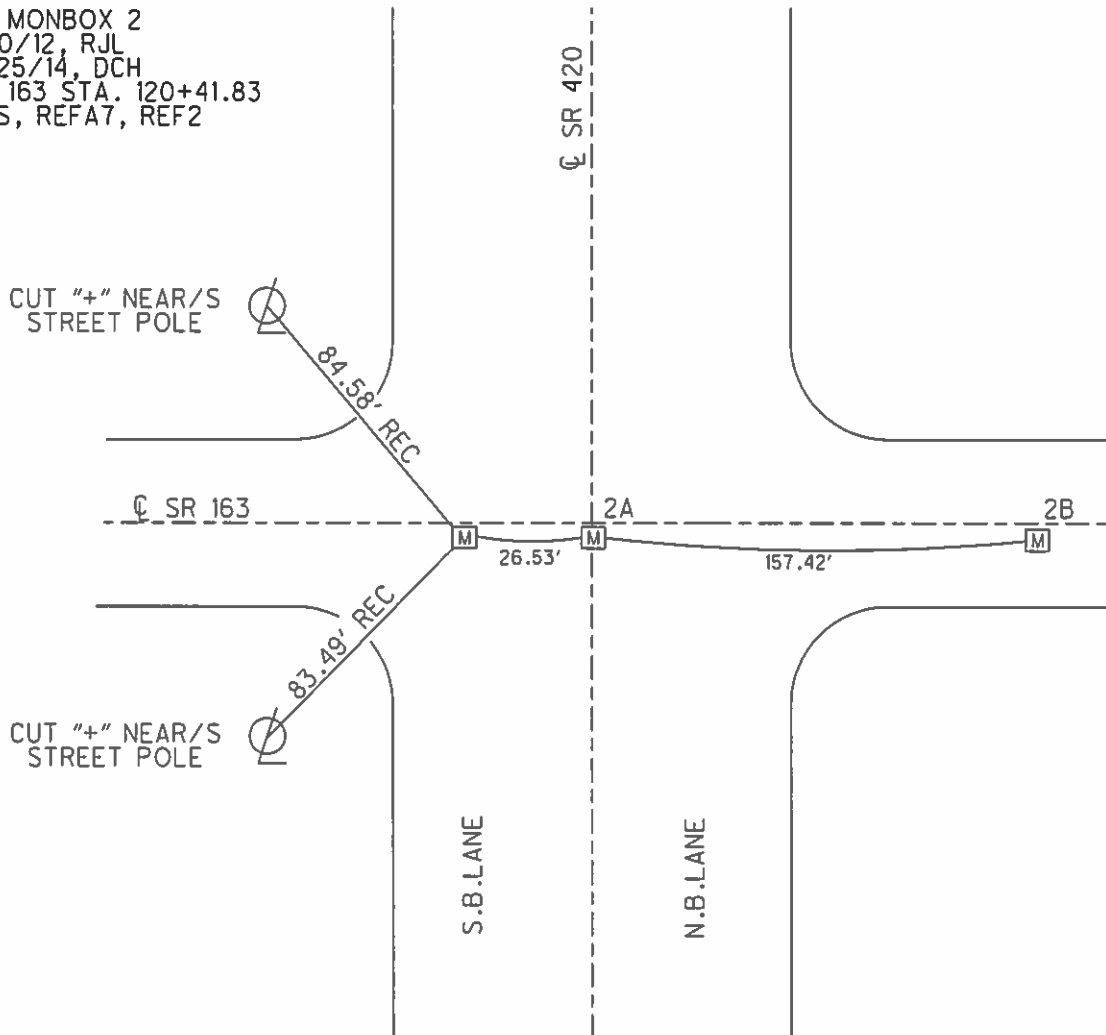

O.D.O.T. DISTRICT 2 SURVEY OFFICE

PERSONNEL

REFERENCE NO. 2

SHEET OF

NOTES LOEHRKE

H.C. ROUSOS

R.C. CANTERBURY

DATE 11-13-96

WEATHER FAIR

TEMP. +30°F

ROUTE S.R. 420



COUNTY Wood

TOWNSHIP TROY

SECTION 3


T 6 N 12 E

TYPE MONUMENT 3 Mon Boxes
 ON SURFACE - ~~BELOW~~ Yes
 LEFT- & PAV'T. - RIGHT
 TO EDGE PAVEMENT
 S.L.M. 2+638.960

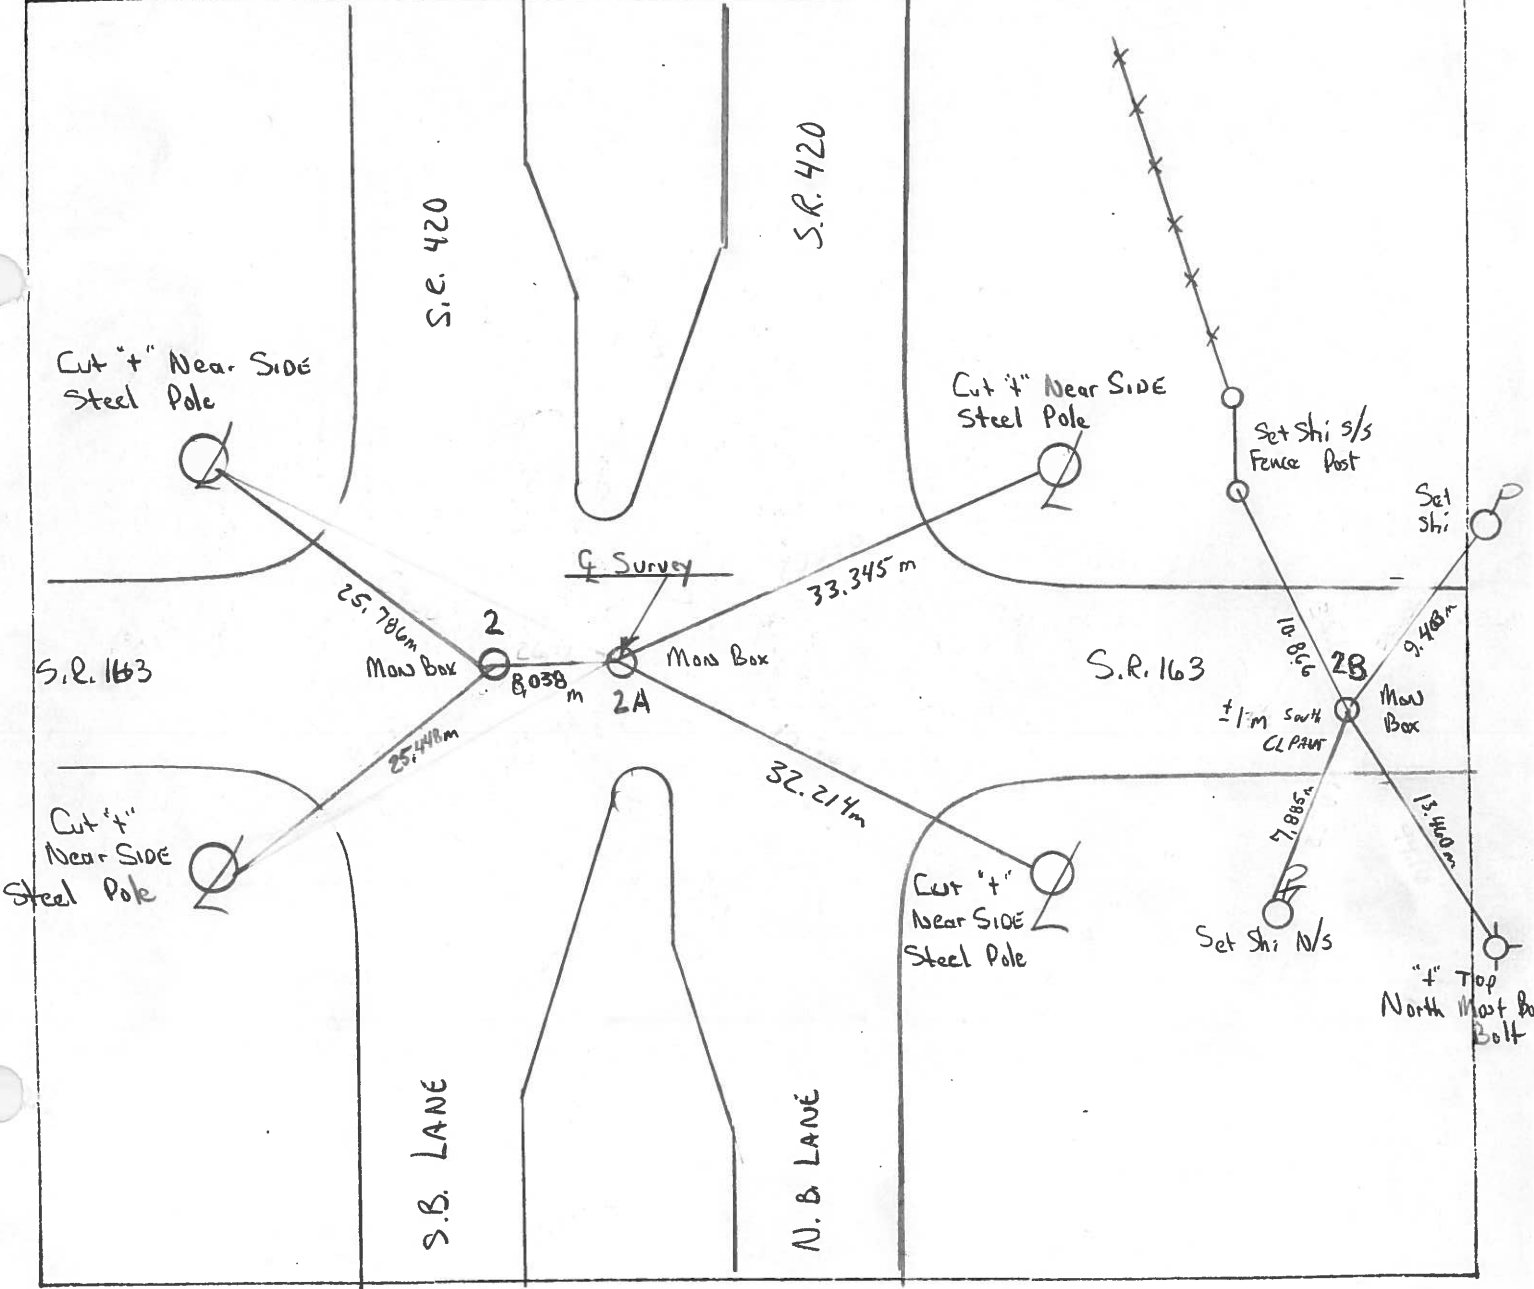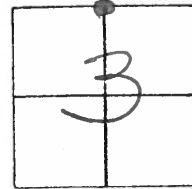

PERSONNEL	TITLE	PERSONNEL	TITLE	COUNTY	DATE
LABRYE				Wood	9-24-96
CANTRELL				S. R. 420	WEATHER Cloudy
Rowens				SEC. 0.00	TEMP. 64

DESCRIPTION Alignment LEFT CENTER LINE RIGHT JOB NO. _____

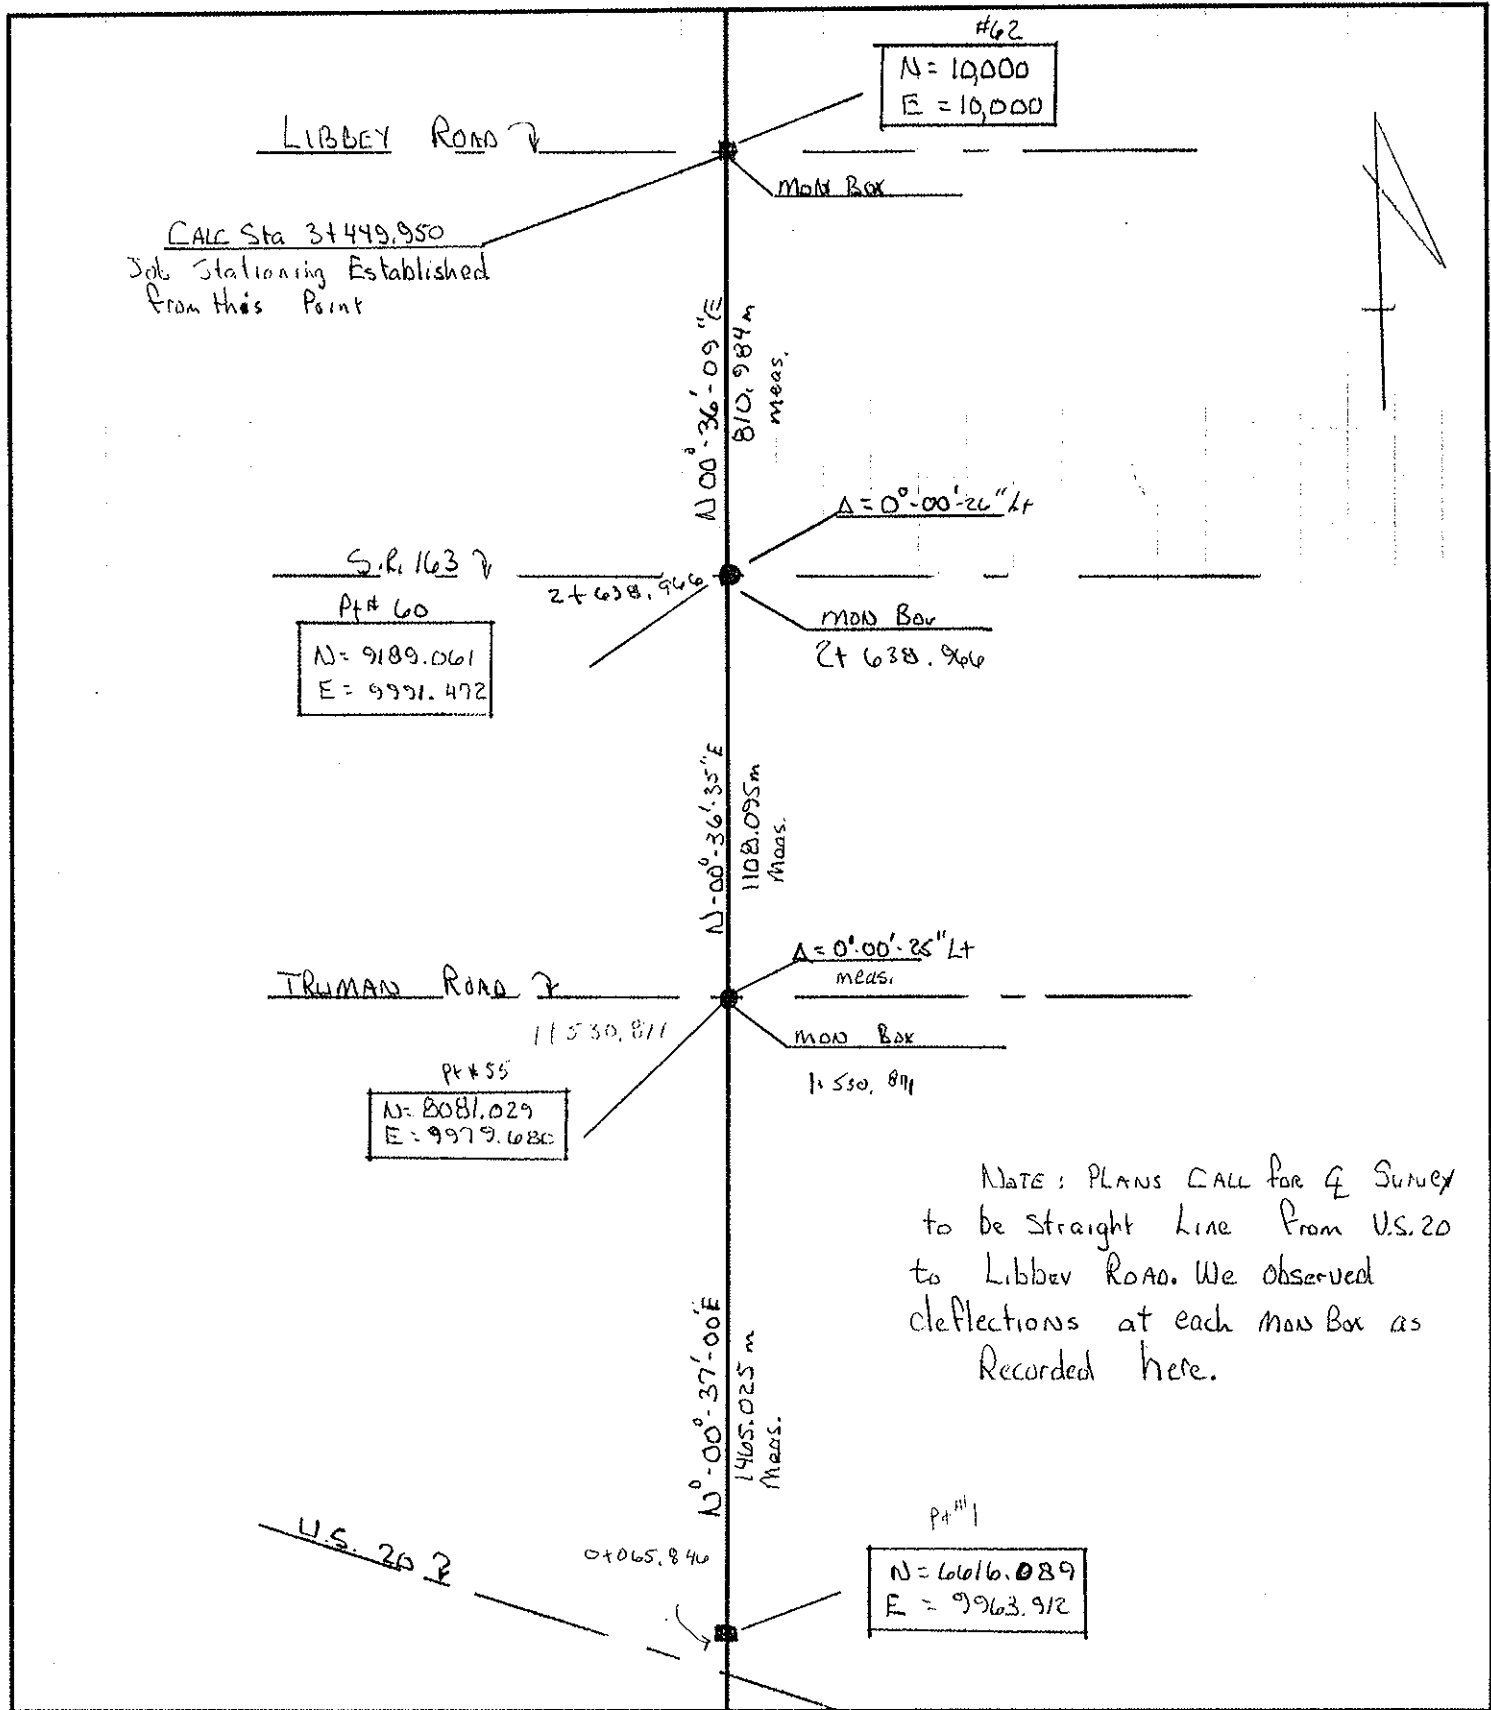

PERSONNEL	TITLE	PERSONNEL	TITLE
<u>D Morrison</u>			
<u>Fowers</u>			
<u>Halcombe</u>			

COUNTY Wood DATE Aug 6, 1970
 S. R. # 420 WEATHER Pt. Cloudy
 SEC. 45th 20 to Turnpike TEMP. +75°

DESCRIPTION Ties To Control Points on Tol. - Det. Elevation JOB NO. _____

