


O.D.O.T. DISTRICT 2 SURVEY OFFICE (USE ONLY)


PERSONNEL _____ REFERENCE NO. 3 A SHEET 5 OF 5
 NOTES HOMAN DATE 6/25/14 ROUTE SR 420
 H.C. LEU WEATHER CLOUDY COUNTY WOOD
 R.C. MEYER TEMP. 70° TOWNSHIP LAKE
 _____ SECTION 34
 _____ T 7 N R 12 E

TYPE MONUMENT DRILLHOLE
 ON SURFACE - ~~BELOW~~ ON _____
~~LEFT~~ - Q PAV'T - RIGHT 107.9'
 - TO - EDGE PAVEMENT
 S.L.M. 131+08.93

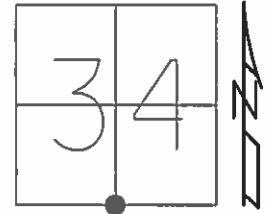

Grid: Northing: 677463.608 Easting: 1704847.875

RECORD: P.O.T.
 STA. 26+49.13
 FD DRILLHOLE
 GPS, CKSEC6
 6/25/14, DCH

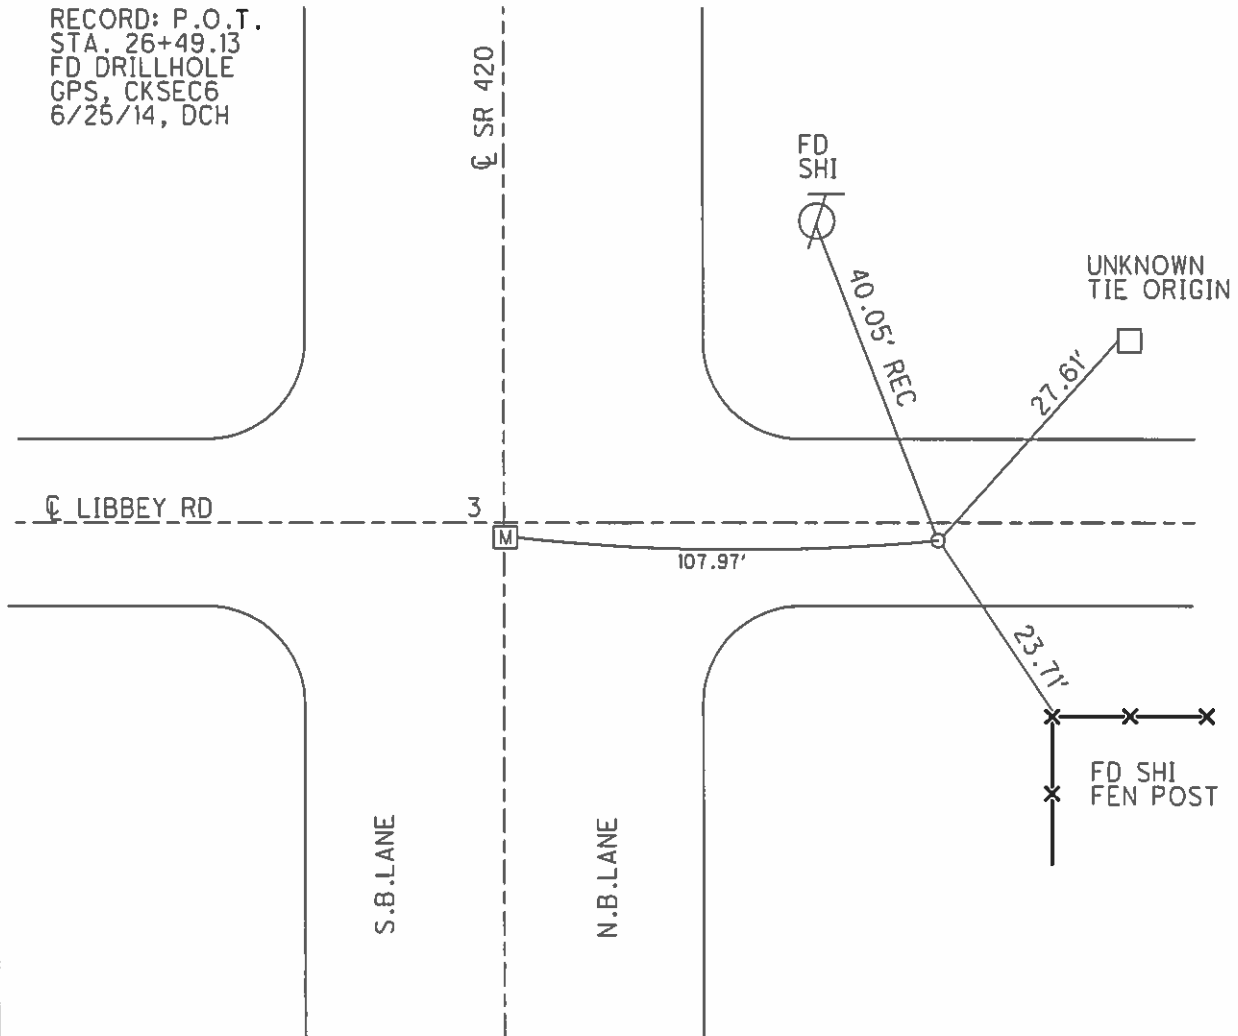

PERSONNEL TITLE PERSONNEL TITLE


COUNTY Wood DATE Aug, 6, 1970

S. R. #420 WEATHER Pt. Cloudy

SEC US#20 to turnpike. TEMP +85°

DESCRIPTION Tics to Control Points on Tol. - Det. expressway. JOB NO. _____

LEFT CENTER LINE RIGHT

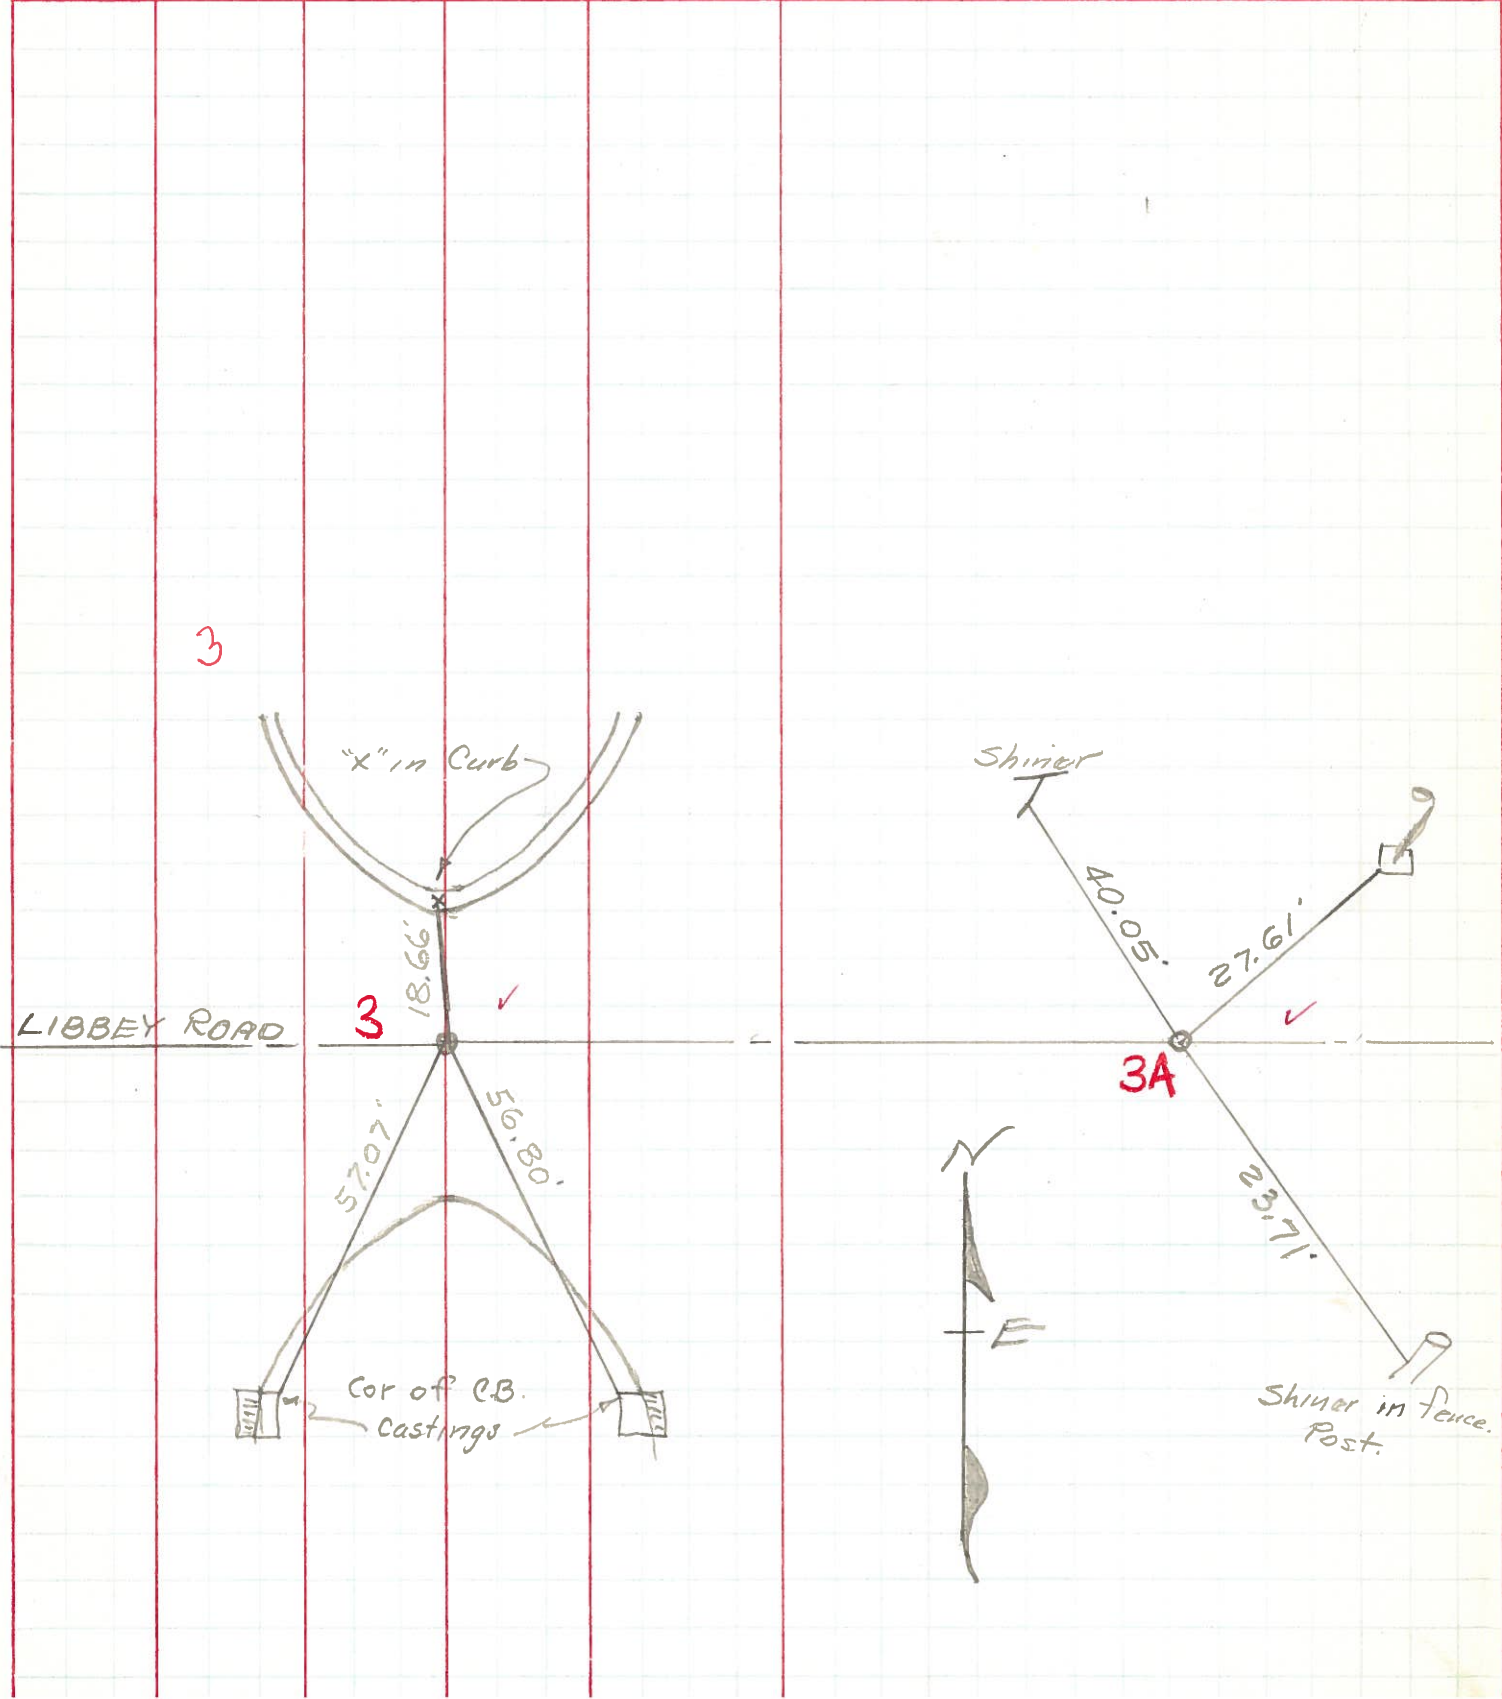

PERSONNEL	TITLE	PERSONNEL	TITLE	COUNTY	DATE
LABRYE				Wood	9-24-96
CANTRELL				S. R. 420	WEATHER Cloudy
Rowens				SEC. 0.00	TEMP. 64

DESCRIPTION Alignment JOB NO. _____

LEFT CENTER LINE RIGHT

