

MAINTENANCE PROGRAM 1982

(TOP) TYPE 404 THICKNESS 1 1/4" PART OF 6 PRIORITY

(BASE) TYPE _____ THICKNESS _____ PENETRATION _____

END LOG S.L.M. 248 (Oltens Co. construction joint Calc. 130+94.4)
BEGIN LOG S.L.M. 0.36 (Full 4-lane section Calc. 19+00.8)
TOTAL LENGTH 2.12

COUNTY Wood SECTION 0.36 WIDTH (20) BERM CURBED (✓)()
ROUTE 579 SECTION 248 end WIDTH (20) (✓)()
SECTION _____ WIDTH () ()
ORDINANCE Northwood SECTION _____ WIDTH () ()
END LOG 2.48 SECTION _____ WIDTH () ()
BEGIN LOG 0.36 SECTION _____ WIDTH () ()

EXISTING BERM TYPE Stab. EXISTING BERM WIDTH 8' & 3' (SEE BELOW) MAILBOX APPROACHES No. None

(PAVED, STABILIZED, AGGREGATE) MANHOLES 1

PROPOSED BERM TYPE _____ PROPOSED BERM WIDTH X INLETS CATCH BASINS None

INTERSECTIONS 8 ASPHALT DRIVEWAYS 27 CONCRETE DRIVEWAYS 1

STRUCTURES

STRUCTURE NO.	WIDTH	LENGTH	APPR. SLABS
<u>Wood 579-0104</u>	<u>36</u>	<u>68'</u>	<u>15' & 15'</u>
<u>Wood 579-0191</u>	<u>36</u>	<u>73'</u>	<u>15' & 15'</u>

RAILROAD CROSSINGS

NAME R. R.	STATION	() ()	No.	TRACKS
<u>None</u>		() ()		TRACKS
		() ()		TRACKS
		() ()		TRACKS
		() ()		TRACKS
		() ()		TRACKS

*Indicate length of crossing along E Pav't.



Raised Pavement Markers?

NOTES

NOTE: There is an 8' Stab. BERM on both sides from beg. project to End Taper Sta. 24+70 - From 24+70 to End project is 3' Stab. berm both sides

NO LIFE LINES

PERSONNEL TITLE PERSONNEL TITLE COUNTY Wood DATE 9 Oct. 81
Stone COUNTY 579 WEATHER Fair
Crow SEC. 0.36-2.48 TEMP. 52°
 DESCRIPTION LEFT CENTER LINE RIGHT JOB NO. 02612

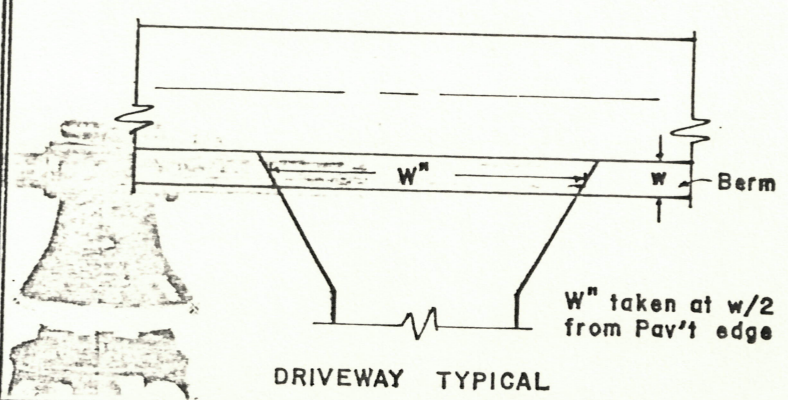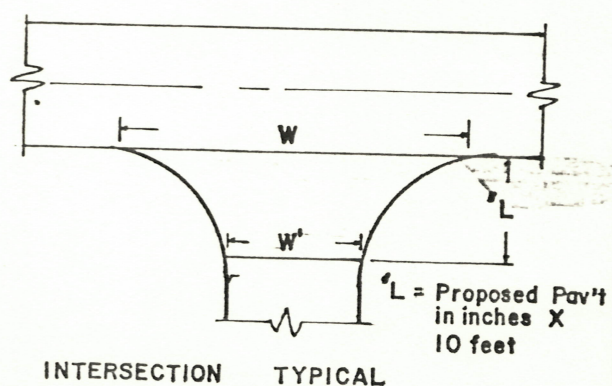

STATION	RT. LT.	L	W	W'	Asph	Conc		STATION	RT. LT.	w	W''	Asph	Conc	Aggr	Dropped Curb Feather NOT Req'd
19+68	LT	12.5	124	88	✓		E. Plaza	21+33	LT	8	35	✓			
79+45	LT	12.5	105	50	✓		Bradley	23+80	RT	8	50	✓			
79+29	RT	12.5	105	58	✓		"	31+90	LT	3	52	✓			
85+70	RT	12.5	96	50	✓		?	34+83	LT	3	43	✓			
91+75	RT	12.5	98	52	✓		Meadow View	40+35	LT	3	45	✓			
105+90	RT	12.5	105	46	✓		Hillway	49+75	RT	3	46	✓			
132+43	LT	12.5	100	44	✓		Foster	50+35	RT	3	49	✓			
132+43	RT	12.5	105	55	✓		"	51+15	LT	3	42	✓			
								51+60	RT	3	49	✓			
								54+40	LT	3	49	✓			
								60+30	RT	3	54	✓			
								68+30	LT	3	47	✓			
								72+20	LT	3	47	✓			
								78+15	RT	3	48	✓			
								86+05	LT	3	47	✓			
								88+30	RT	3	58	✓			
								93+00	RT	3	37		✓		
								97+00	RT	3	55	✓			
								98+95	RT	3	48	✓			
								101+00	LT	3	40	✓			
								104+25	RT	3	46	✓			
								111+35	LT	3	44	✓			
								113+65	RT	3	49	✓			
								113+85	LT	3	49	✓			

PERSONNEL TITLE PERSONNEL TITLE

Stone
E
Craw

COUNTY Wood DATE 9 Oct. 81

S. R. 579 WEATHER Fair

SEC. 0.36-2.48 TEMP. 52°

DESCRIPTION Pavement Data JOB NO. 02611E

