



O.D.O.T. DISTRICT 2 SURVEY OFFICE (USE ONLY)

PERSONNEL _____ REFERENCE NO. 7 SHEET 7 OF 25
 NOTES RHOADES DATE 4/8/14 ROUTE SR 582
 H.C. ROUSOS WEATHER FAIR COUNTY WOOD
 R.C. HOMAN TEMP. 53° TOWNSHIP MIDDLETON
GABLE SECTION 21
 T 6 N R 10 E

TYPE MONUMENT MAG/W
 ON SURFACE - ~~BELOW~~ ON _____
~~LEFT~~ - Q PAV'T - RIGHT 2.5'
5.8' TO RT EDGE PAVEMENT
 S.L.M. 96+00
 Grid: Northing: 655481.119 Easting: 1634468.795

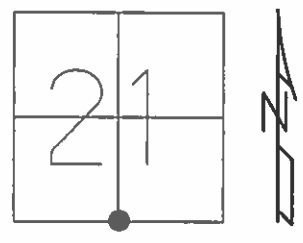

FD SM RR SPIKE
 4/20/04, M.B.
 RESET MAG/WASHER
 8/2/04, MC
 FND, 3/14/14
 FD MAG/W
 GPS, RE7
 4/8/14, TMR
 SET MAG/W
 7/25/14, EBW
 GPS, NEWREF7
 7/29/14, JMR

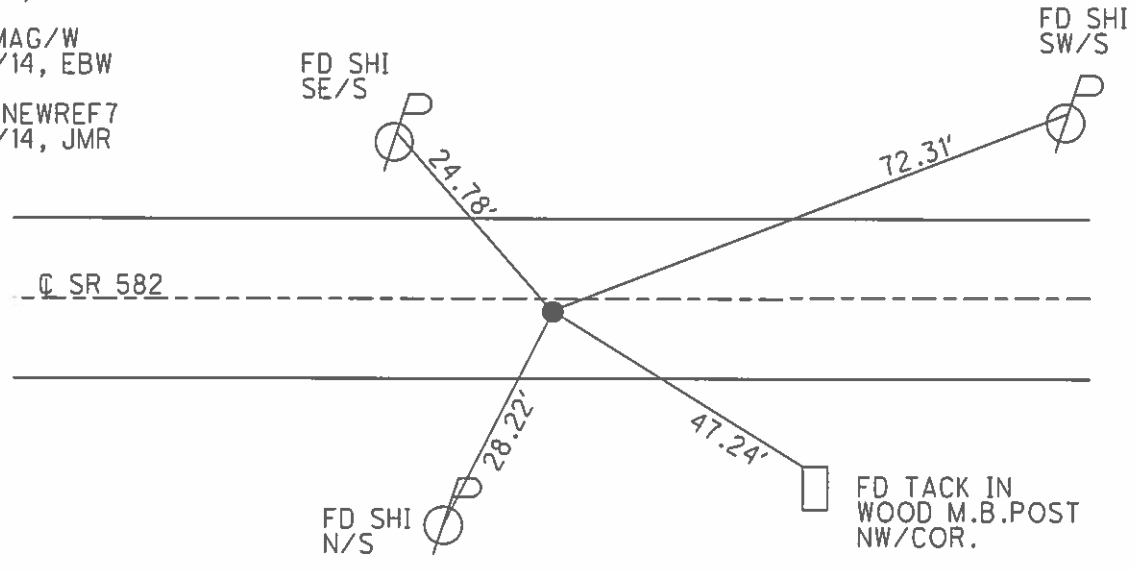

O.D.O.T. DISTRICT 2 SURVEY OFFICE

PERSONNEL

REFERENCE NO. 7

SHEET 5 OF 23

NOTES CANTERBURY RC

H.C. BARNHISEL (DRAWN)

R.C. _____

DATE 04/20/04

WEATHER Cloudy

TEMP. +48°

ROUTE S.R. 582

COUNTY Wood

TOWNSHIP MIDDLETON

SECTION 21

T.G.N.R. 10 E


TYPE MONUMENT Sm RR Spk

ON SURFACE - BELOW 2"


LEFT - C. PAV'T. - RIGHT 2.3'

S.B. TO RT. EDGE PAVEMENT

S.L.M. 96+00

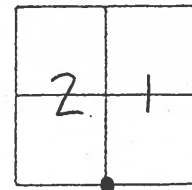

Reset May/Washer
08/02/04
MC

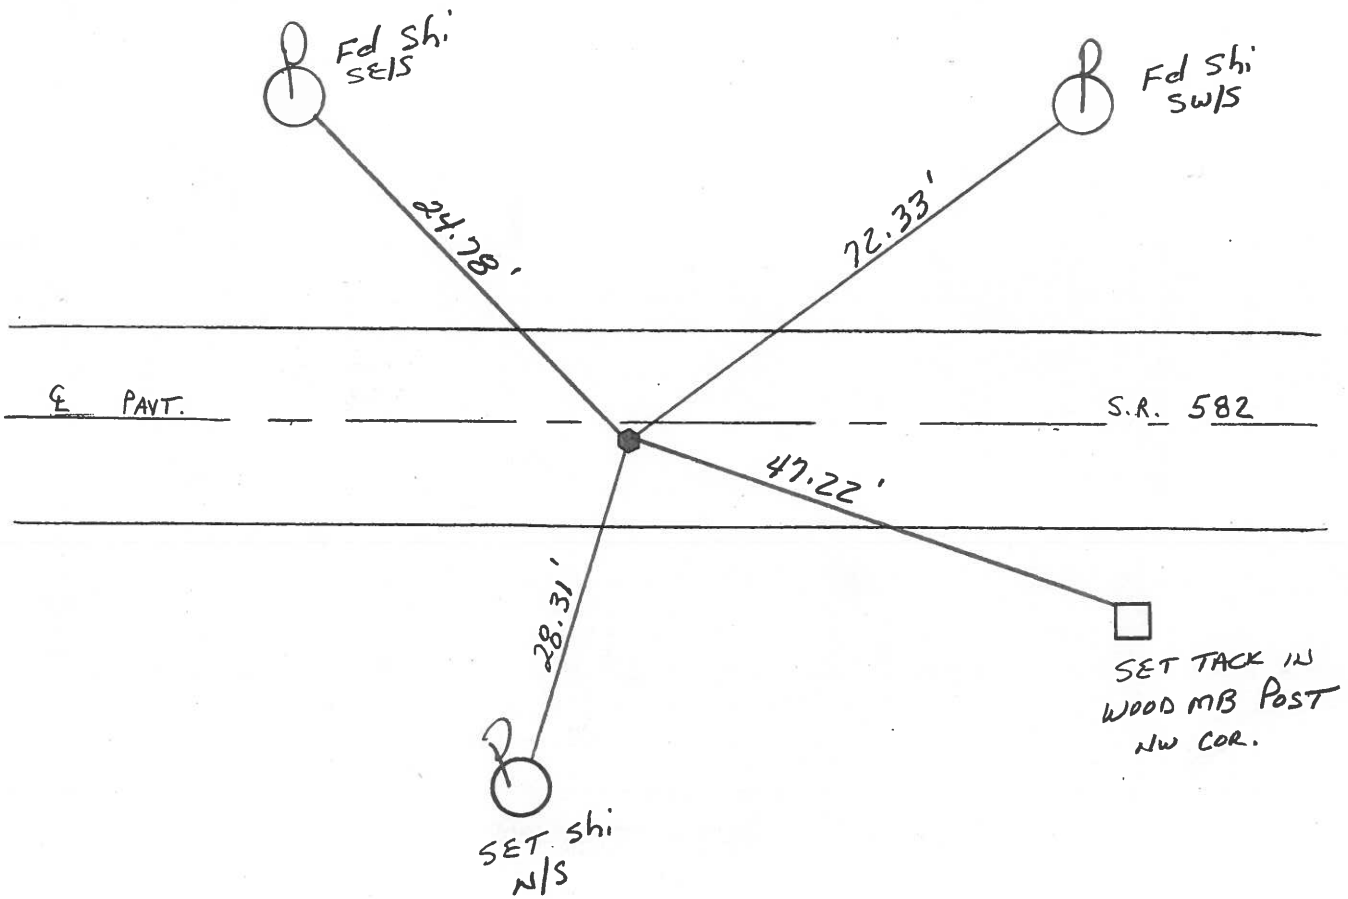

O.D.O.T. DISTRICT 2 SURVEY OFFICE

PERSONNEL

REFERENCE NO. 7

SHEET OF

NOTES BARNHISEL

H.C. HOFFMAN

DATE 3-27-86

ROUTE 582

R.C. Loehrke

WEATHER SUNNY

COUNTY WOOD

GRAMER

TEMP. +35°

TOWNSHIP MIDDLETON

SECTION 21

T 6 N R 10 E

TYPE MONUMENT Sm RR Spk



Set P.K./washer
5-6-86 SWN

ON SURFACE - BELOW yes

LEFT - ☉ PAV'T. - RIGHT 2.0

5.3 TO Rt EDGE PAVEMENT

S.L.M. 96+00

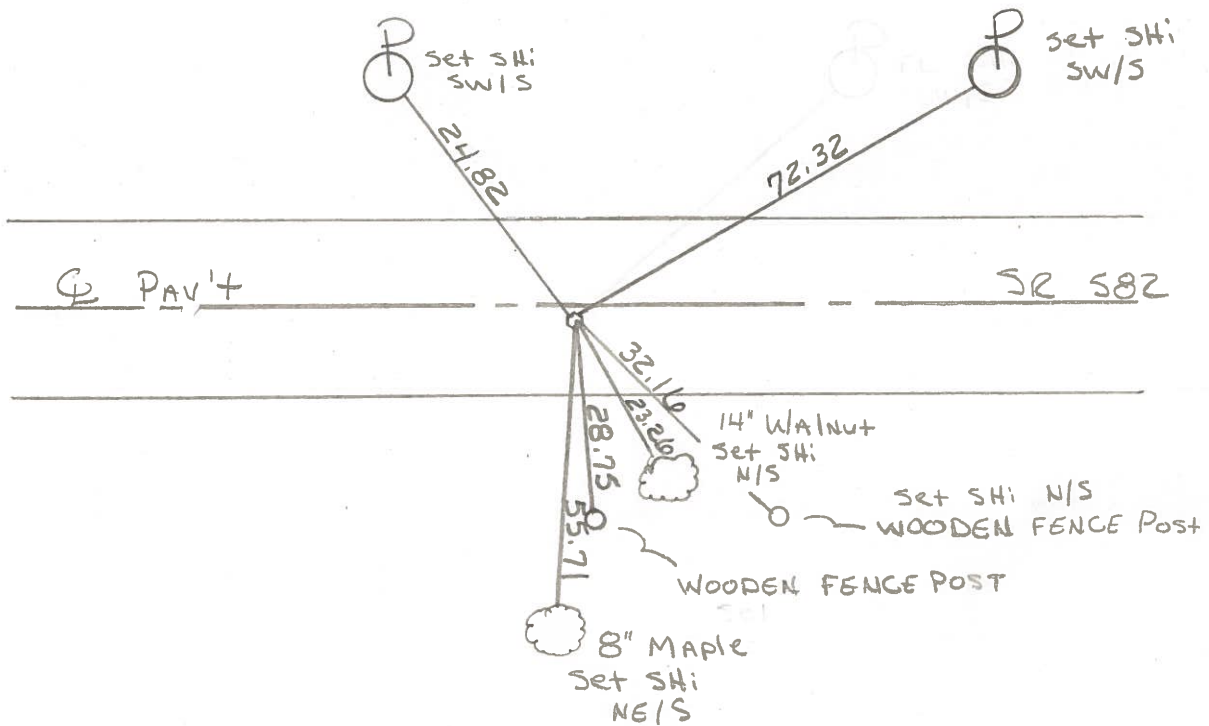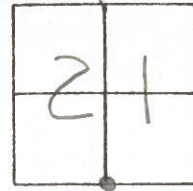

County Wood S.R. 582

Date 5-11-1979

Township Washington

Weather Partly Cloudy

Section N¹/₄ Corner Sec. 28


Temp. 84°

T6N, R10E


Personnel Smith

Knape

Mead

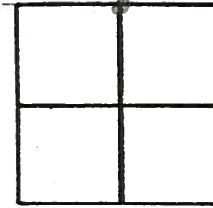


7

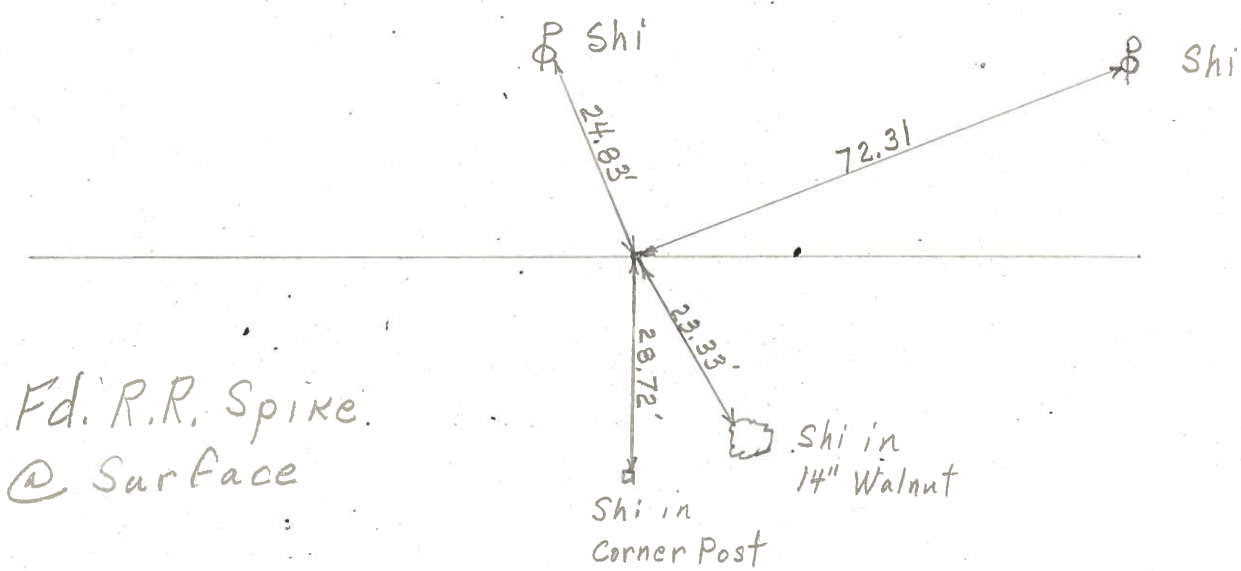

PERSONNEL	TITLE	PERSONNEL	TITLE
BURNSIDE			
BOWERS			
SMITH			
HOLCOMBE			

COUNTY WOOD DATE 5-25-71
 S. R. 582 WEATHER CLOUDY
 SEC. 28 TEMP. +60°

DESCRIPTION _____ LEFT _____ CENTER LINE _____ RIGHT _____ JOB NO. _____

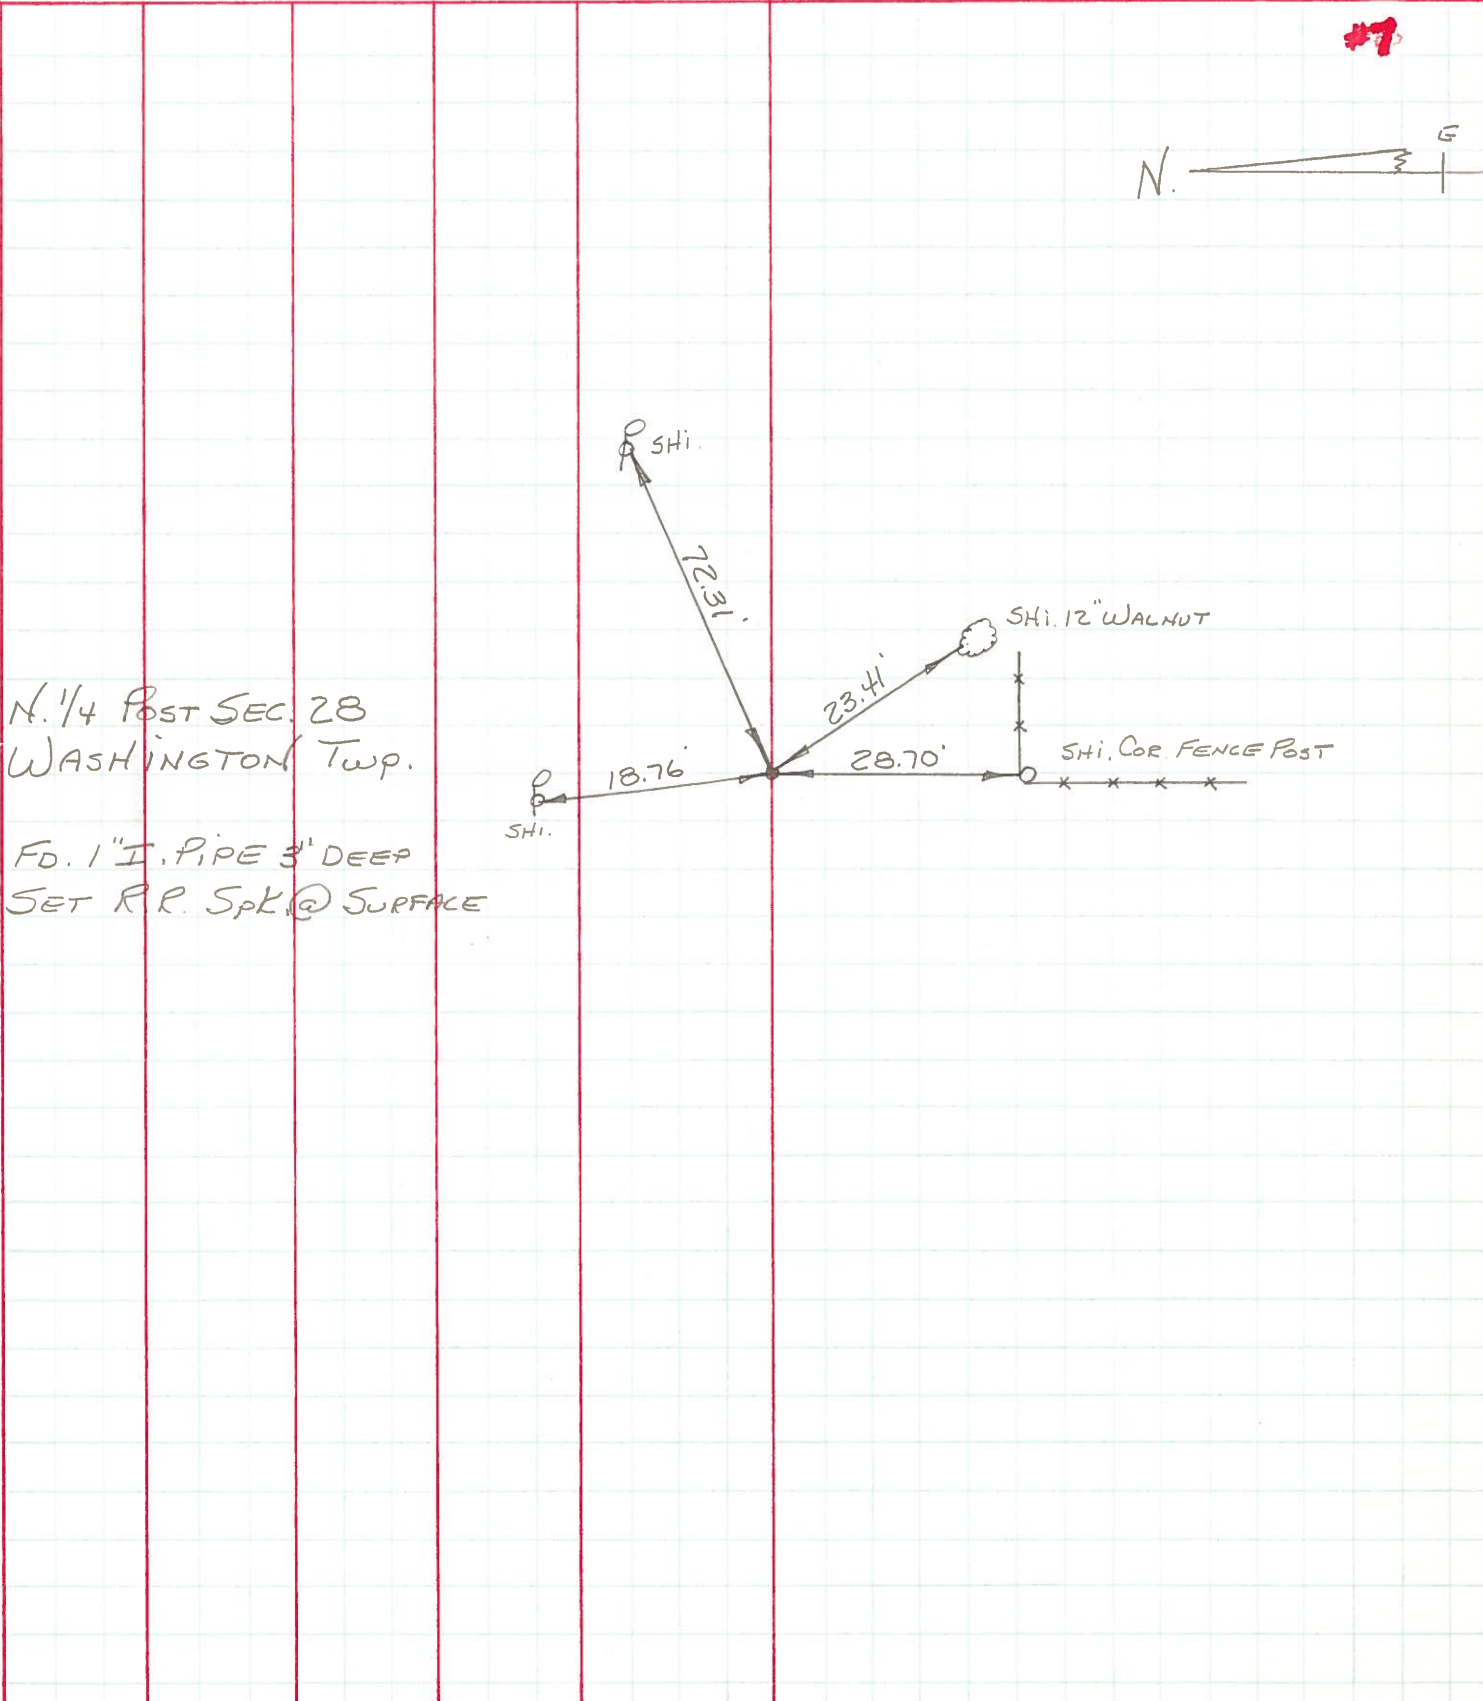

N. 1/4 Post SEC. 28
 WASHINGTON Twp.

FD. 1" I. PIPE 3' DEEP
 SET R.R. Spk @ SURFACE

PERSONNEL	TITLE	PERSONNEL	TITLE	COUNTY	DATE
<u>Schneider</u>				<u>Wood</u>	<u>6-12-67</u>
<u>Barbour</u>				S. R. # <u>582</u>	WEATHER <u>Fair-Hot</u>
<u>Redding</u>				SEC. <u>0.00-3.10</u>	TEMP. <u>80°</u>
<u>Potts</u>					

DESCRIPTION Ties for c - tro 2. ins JOB NO. _____

