

O.D.O.T. DISTRICT 2 SURVEY OFFICE

PERSONNEL _____

REFERENCE NO. _____


SHEET 9 OF 23

NOTES Huss
 H.C. Cordes
 R.C. Van Puseh
Flag - Cox

DATE 6-18-97
 WEATHER Cldy - Sprink.
 TEMP. +67°F

ROUTE S.A. 582
 COUNTY WOOD
 TOWNSHIP MIDDLETON
 SECTION 27
T 6 N R 10 E

TYPE MONUMENT (A) Sm RR Spk. (B) PK/w
~~CONCRETE~~ - BELOW Yes
~~PAV'T~~ - PAV'T
TO - EDGE PAVEMENT
 S.L.M. (A) 476+82 (B) 476+84

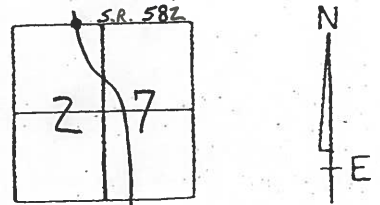


Records:

9B
 (A) Small RR Spk
 PI 110+89.9
 Δ 0°-07' Lt

9C
 (B) Fd. PK Shank
 on section line
 E.-W. on tangent
 line of SR-64

Not Covered
 8-2-04
 MC

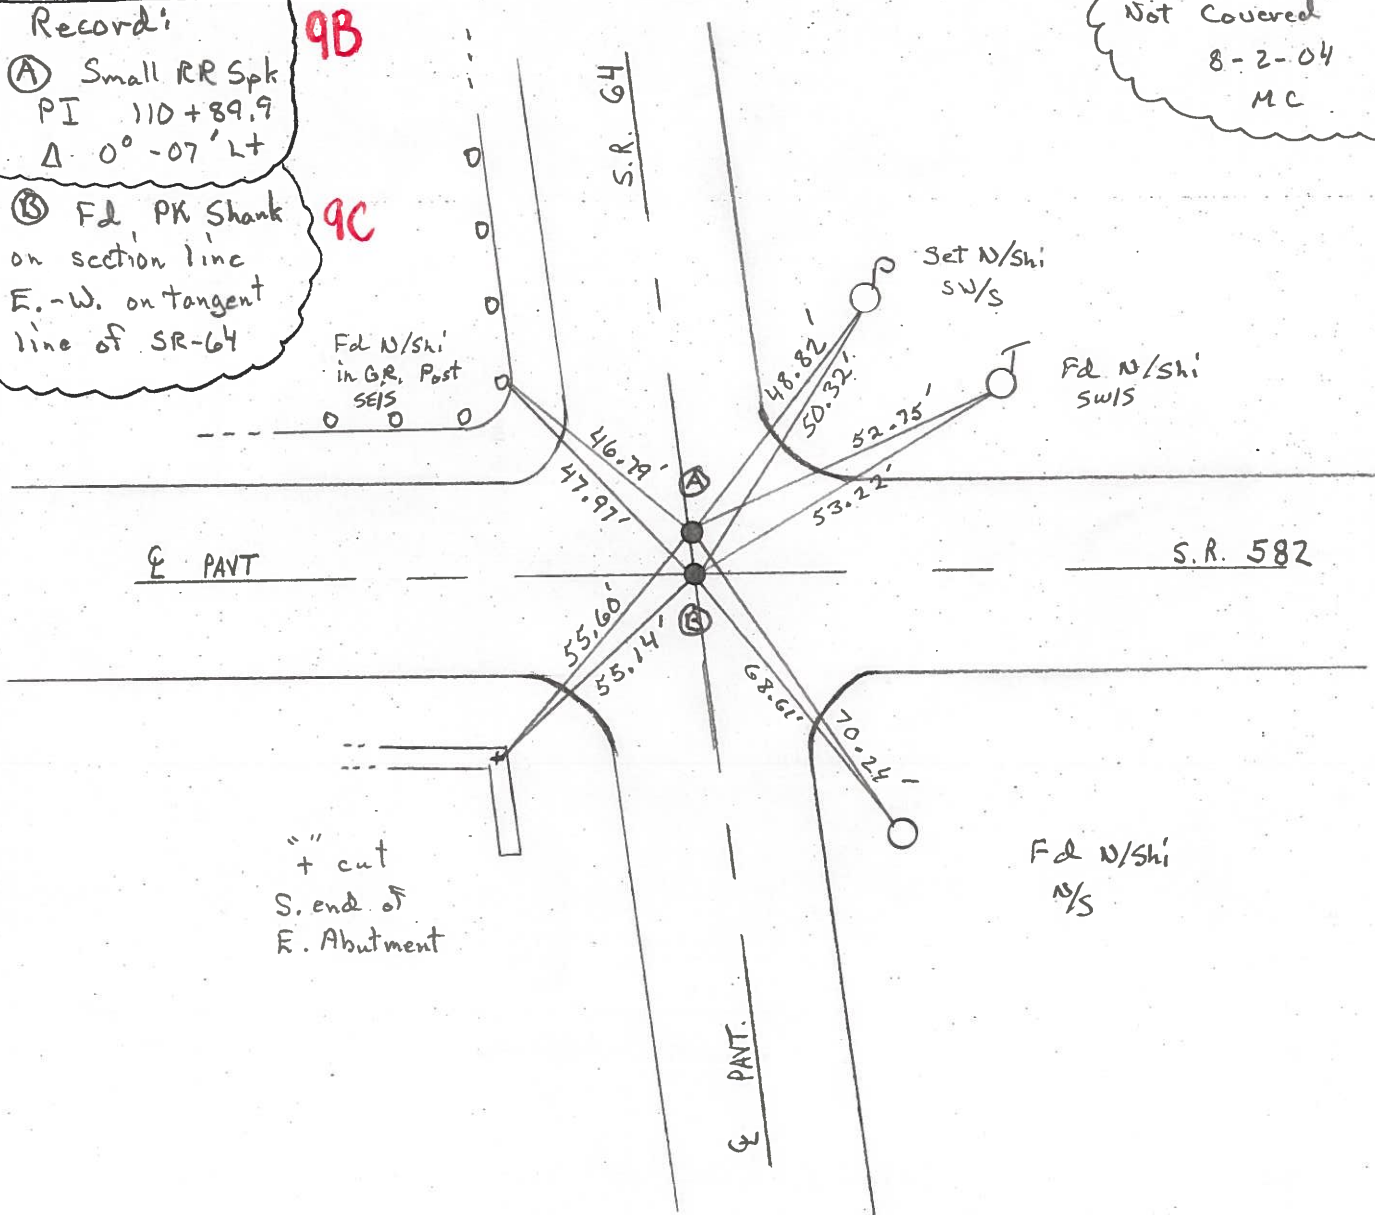

County WOOD S.R. 582 & 64

Township MIDDLETON

Section 27

TLN, R10E

Personnel NOFFMAN

LOETHRICE

HOUSEHOLDER R.C.


BARNHISEL H.C.

12


Date 6-1-84

Weather P. CLEAR

Temp. +70°

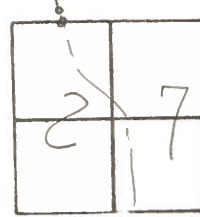

Pt. "B" Fd small spk @ surface
 Record: P.I, STA. 110+89.9
 $\Delta = 0^\circ - 07' 12''$

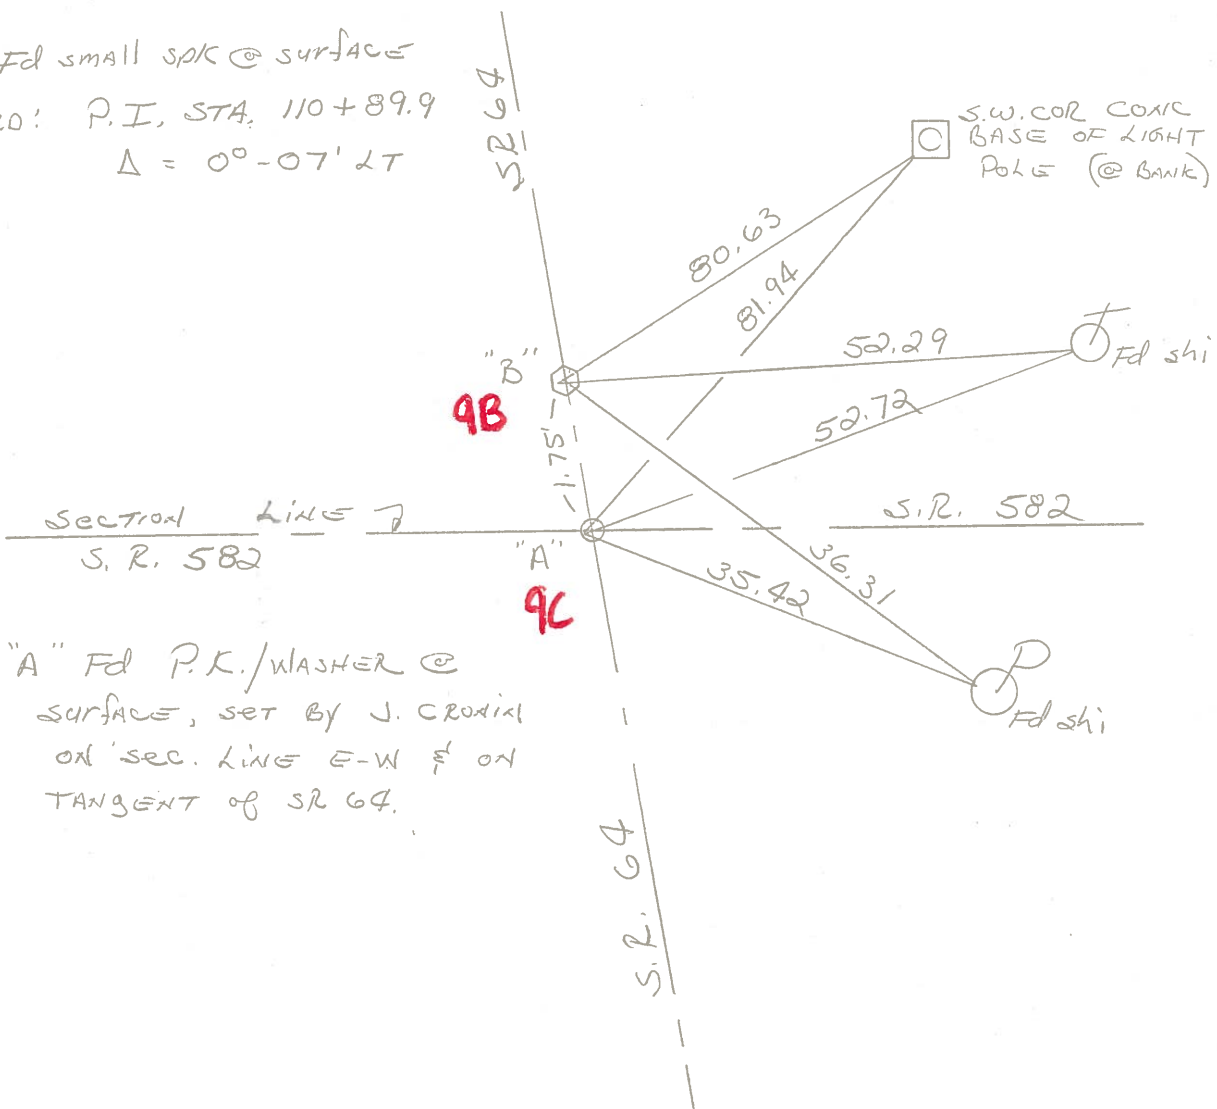

Pt. "A" Fd P.K./WASHER @
 surface, set by J. CROXAL
 on sec. line E-W & on
 TANGENT of SR 64.