

# O.D.O.T. DISTRICT 2 SURVEY OFFICE

PERSONNEL \_\_\_\_\_

REFERENCE NO. \_\_\_\_\_

SHEET 9 OF 23

NOTES Huss

H.C. Cordes

R.C. Van Puseen

Flag - Cox

DATE 6-18-97

WEATHER Cldy - Sprink.

TEMP. +67°F

ROUTE S.A. 582

COUNTY WOOD

TOWNSHIP MIDDLETON

SECTION 27

T 6 N R 10 E


TYPE MONUMENT (A) Sm RR Spk. (B) PK/W

~~CONCRETE~~ - BELOW Yes

~~PAV'T~~ - PAV'T

- TO - EDGE PAVEMENT

S.L.M. (A) 476+82 (B) 476+84

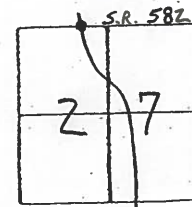


Records:

**9B**  
 (A) Small RR Spk  
 PI 110+89.9  
 Δ 0°-07' Lt

**9C**  
 (B) Fd. PK Shank  
 on section line  
 E.-W. on tangent  
 line of SR-64

Not Covered  
 8-2-04  
 MC

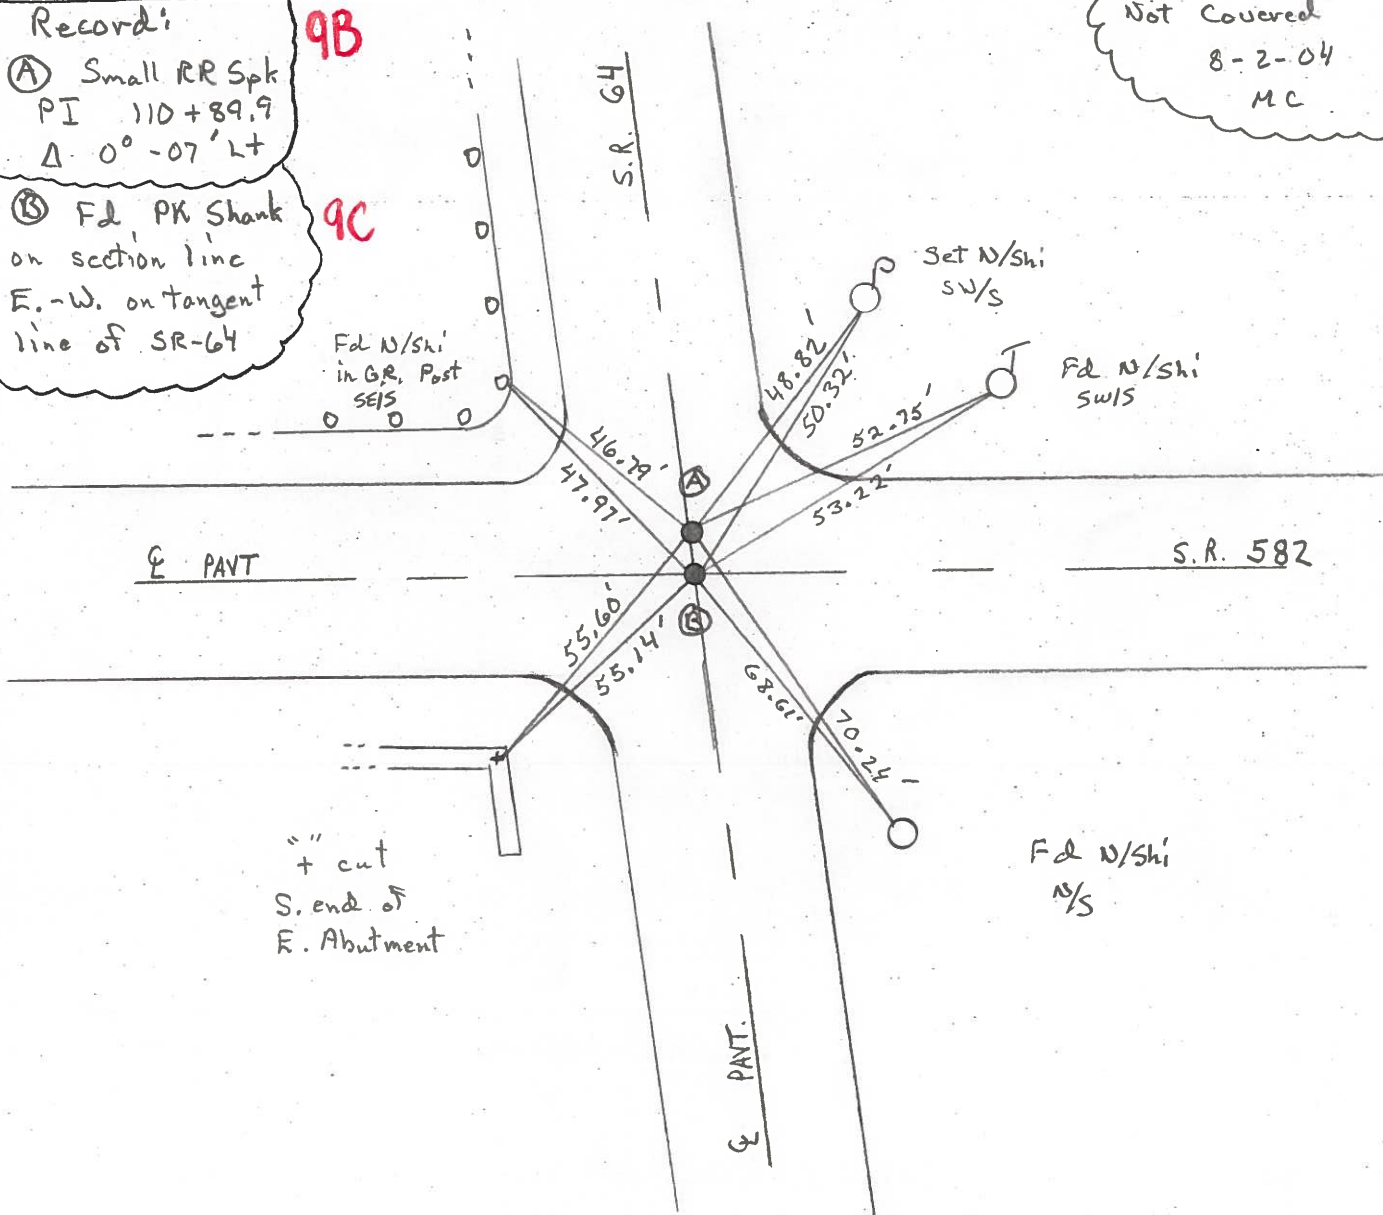

County WOOD S.R. 582 & 64

Date 6-1-84

Township MIDDLETON

Weather P. CLEAR

Section 27

Temp. +70°

TLN, R10E


Personnel NOFFMAN

LOETHRICE


HOUSEHOLDER R.C.

BARNHISEL H.C.

# 12

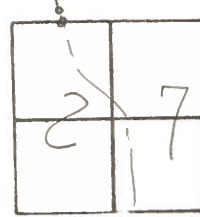

Pt. "B" Fd small spk @ surface  
 Record: P.I, STA. 110+89.9  
 $\Delta = 0^\circ - 07' 12''$

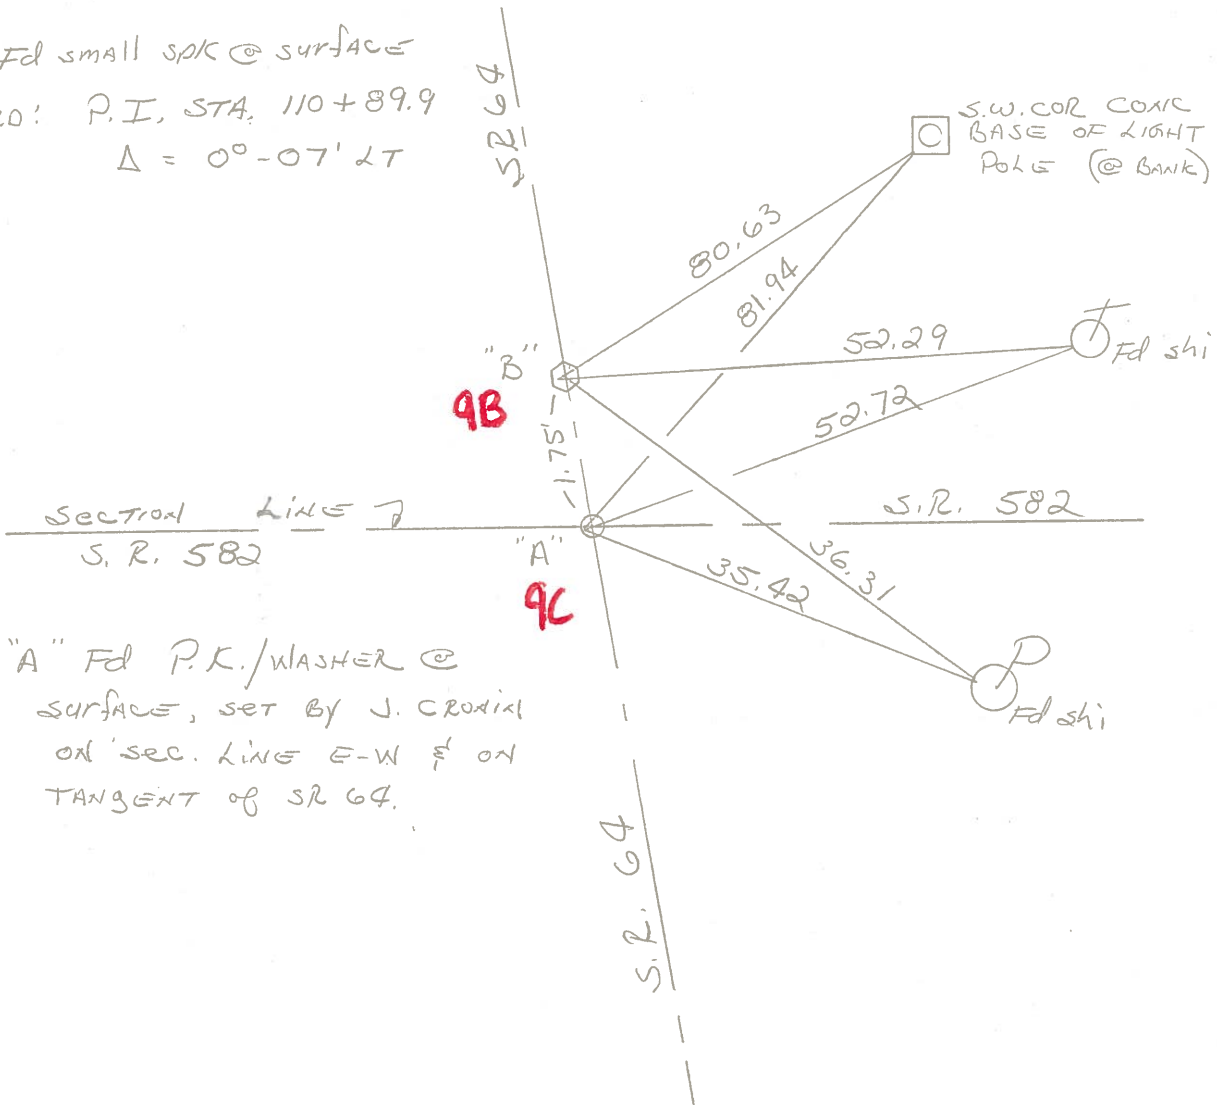

Pt. "A" Fd P.K./WASHER @  
 surface, set by J. CROXAL  
 on sec. line E-W & on  
 TANGENT of SR 64.